

U.S. PUBLIC LAND SURVEY MONUMENT RECORD

Index No. N-9


State of Wisconsin }
 County of Forest } ss.

I William B. Cochran, do hereby certify that on the 6th day of October, 1986, I found evidence of the Northeast Section corner of Section 20 Township 39, North, Range 14 East, Fourth Principal Meridian, as described hereon; and that from this evidence I established a new monument and accessories as described hereon to perpetuate the original location of this corner.

Resident witnesses:

Tony Tillman

State Plane Co-ordinates
 N- 252,641.0598
 E-2,316,506.5850

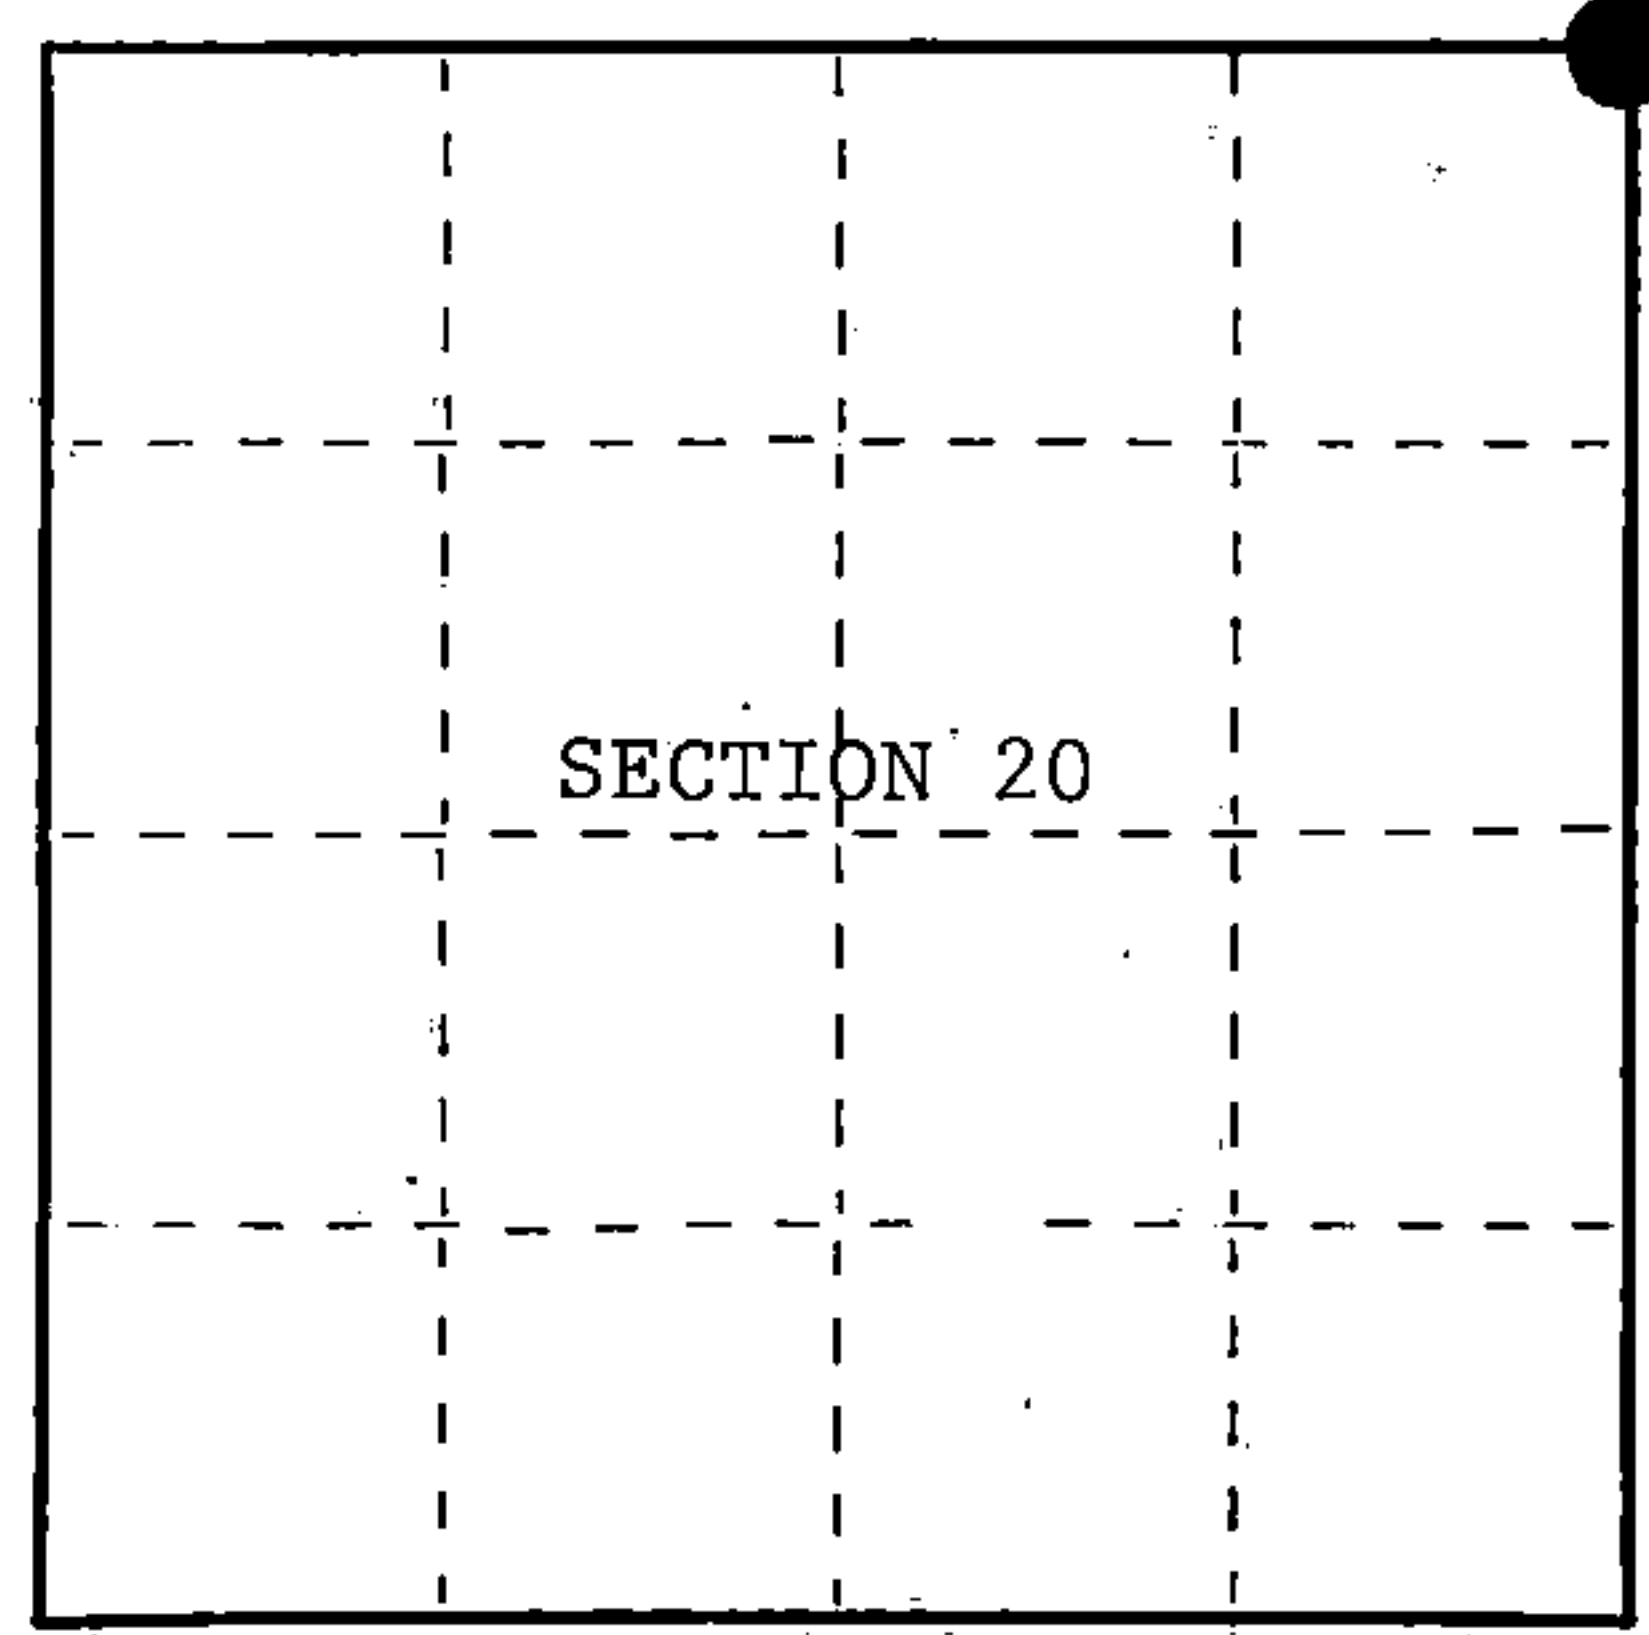

○ = Corner monument restored.

History of original corner establishment:

Original Government Survey in 1865 by William E. Daugherty and Alex McDill. North between Sections 20 and 21, at 80.00 chains, set Section Corner post to Sections 16, 17, 20 and 21, from which the following bear;

Birch	10"	S47°E	5 lks.
Aspen	12"	N25°W	37 lks.

Form #874, dated 3/20/35, states that corner position is in Center-Line of the road.

Description of corner evidence found:

No corner evidence was recovered.

The corner position is re-established at proportionate distance between the Southwest Section Corner of Section 17 and the Southwest Section Corner of Section 15, and in the Center-Line of F.R. #2168.

Description of monument and accessories I established to perpetuate the original location of this corner.

At the corner position, set a 2½ inch diameter aluminum pipe monument, 3 feet long, 4 feet in the ground (1 foot below road surface), with an aluminum cap stamped; T39N, R14E, S16, S17, S20, S21, 1986, S-1107. From which the following new blazed and scribed bearing trees bear;

R. Pine	18"	N37°E	38.08 feet
R. Pine	6"	S 6°E	39.33 feet
R. Pine	6"	S37°W	26.53 feet
Steel Sign Post		South	20.00 feet

Dated at Hiles, Wis., this 9th day of February, 1987

Signature William B. Cochran Title Land Surveyor Registration No. S-1107
 (County Surveyor, Registered Land Surveyor, or other duly authorized official)

Office of Register of Deeds, County of Forest, I hereby certify that the within instrument was filed in this office for record on the 11th day of March, 1987 at 3:30 clock P. M.

Paul Aschenbrenner
 (Register of Deeds)

By _____ Deputy

FORM NO. 985-A
 H.C. Miller Company
 Milwaukee, Wisconsin

Stock No. 26273

DOCUMENT NUMBER 132363

A3914170000

(e) Describe any material discrepancy between the location of the corner as restored or reestablished and the location of that corner as previously restored or reestablished by distance and direction. Show the discrepancy on the plan view drawing under (d), above. Show the distances between the corner as previously restored or reestablished and (1) the corner as restored or reestablished, and (2) to at least 2 of the witness monuments shown on the drawing in (d), above.

See drawing below.

(f) Was the corner restored through acceptance of (1) an obliterated evidence location, or, (2) a found perpetuated location?

(g&h) Was the corner reestablished through lost corner proportionate methods? If so, show the method, including the directions and distances to other public land survey corners used as evidence or used for proportioning in determining the corner location?
 This corner position was re-established using State Plane Co-ordinates computed from Aerial Photography and a Global Positioning Satellite Survey. The computed corner position was located in the field with a North Seeking Gyro, an Electronic Distance Meter, and/or a steel tape.

