

U.S. PUBLIC LAND SURVEY MONUMENT RECORD

Index No. V-17

State of Wisconsin }
 County of Forest } ss.

History of original corner establishment:

Original Government Survey in 1865 by William E. Daugherty and Alex McDill. North between Section 34 and 35, 80.00 chains, set Section Corner Post to Section 26, 27, 34 and 35, from which the following bear;

Tamarac	10"	S81°W	5 lks.
Tamarac	8"	N40°E	11 lks.

Description of corner evidence found:

Found Cedar Post Point, from which an East-West fence line bears East.

I accept the Cedar Post Point and fence line as the best available evidence for restoring the corner position.

No original corner evidence was recovered.

Description of monument and accessories I established to perpetuate the original location of this corner.

In place of Cedar Post Point, set a 2½" diameter aluminum pipe monument, 5 feet long, 4 feet in the ground, with an aluminum cap stamped: T39N, R14E, S26, S27, S34, S35, 1985, S-1107. From which the following new blazed and scribed bearing trees bear;


Spruce	4"	N18°E	31.52 feet
Spruce	6"	S45°E	41.27 feet
Spruce	4"	S30°W	27.40 feet
Spruce	5"	N39°W	37.93 feet
Steel Sign Post		NE	3.00 feet

I, William B. Cochran, do hereby certify that on the 4th day of September, 1985, I found evidence of the Northwest Section corner of Section 35 Township 39, North, Range 14 East, Fourth Principal Meridian, as described hereon; and that from this evidence I established a new monument and accessories as described hereon to perpetuate the original location of this corner.

Resident witnesses:

David Brownell

State Plane Co-ordinates
 N- 242,453.4257
 E-2,327,125.3360

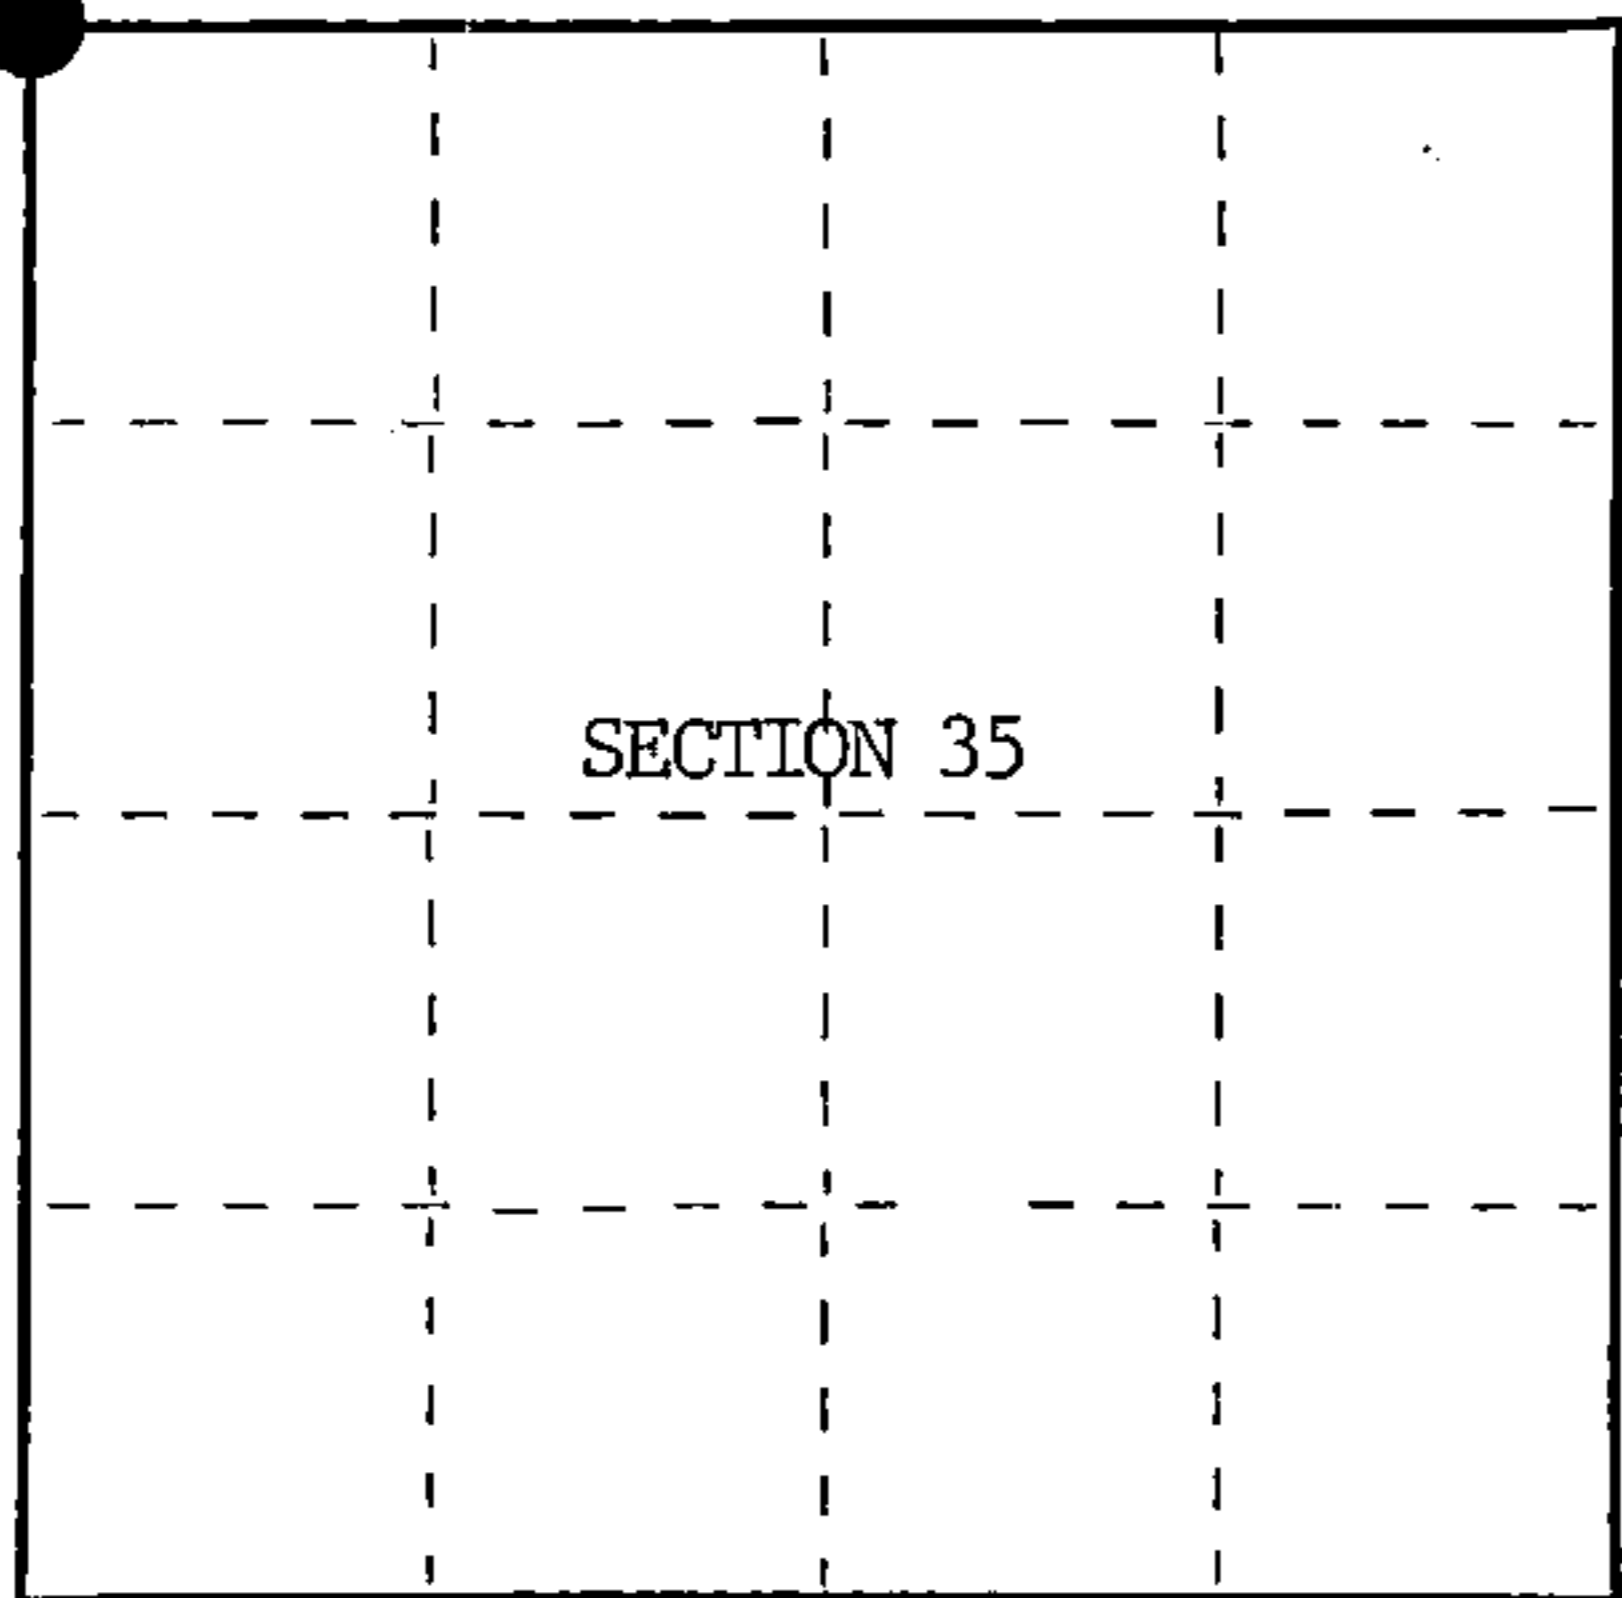

○ = Corner monument restored.

Dated at Hiles, Wis., this 27th day of January, 1986

Signature William B. Cochran Title Land Surveyor Registration No. S-1107
 (County Surveyor, Registered Land Surveyor, or other duly authorized official)

Office of Register of Deeds, County of Forest, I hereby certify that the within instrument was filed in this office for record on the 11th day of March, 1987 at 3:30 o'clock P. M.

Paul Aschenbrenner
 (Register of Deeds)

By _____ Deputy

FORM NO. 985-A

H.C. Miller Company

Stock No. 26273

DOCUMENT NUMBER 132393

43914270000


(e) Describe any material discrepancy between the location of the corner as restored or reestablished and the location of that corner as previously restored or reestablished by distance and direction. Show the discrepancy on the plan view drawing under (d), above. Show the distances between the corner as previously restored or reestablished and (1) the corner as restored or reestablished, and (2) to at least 2 of the witness monuments shown on the drawing in (d), above.

See drawing below.

(f) Was the corner restored through acceptance of (1) an obliterated evidence location, or, (2) a found perpetuated location?

Restored from accepted evidence.

(g&h) Was the corner reestablished through lost corner proportionate methods? If so, show the method, including the directions and distances to other public land survey corners used as evidence or used for proportioning in determining the corner location?

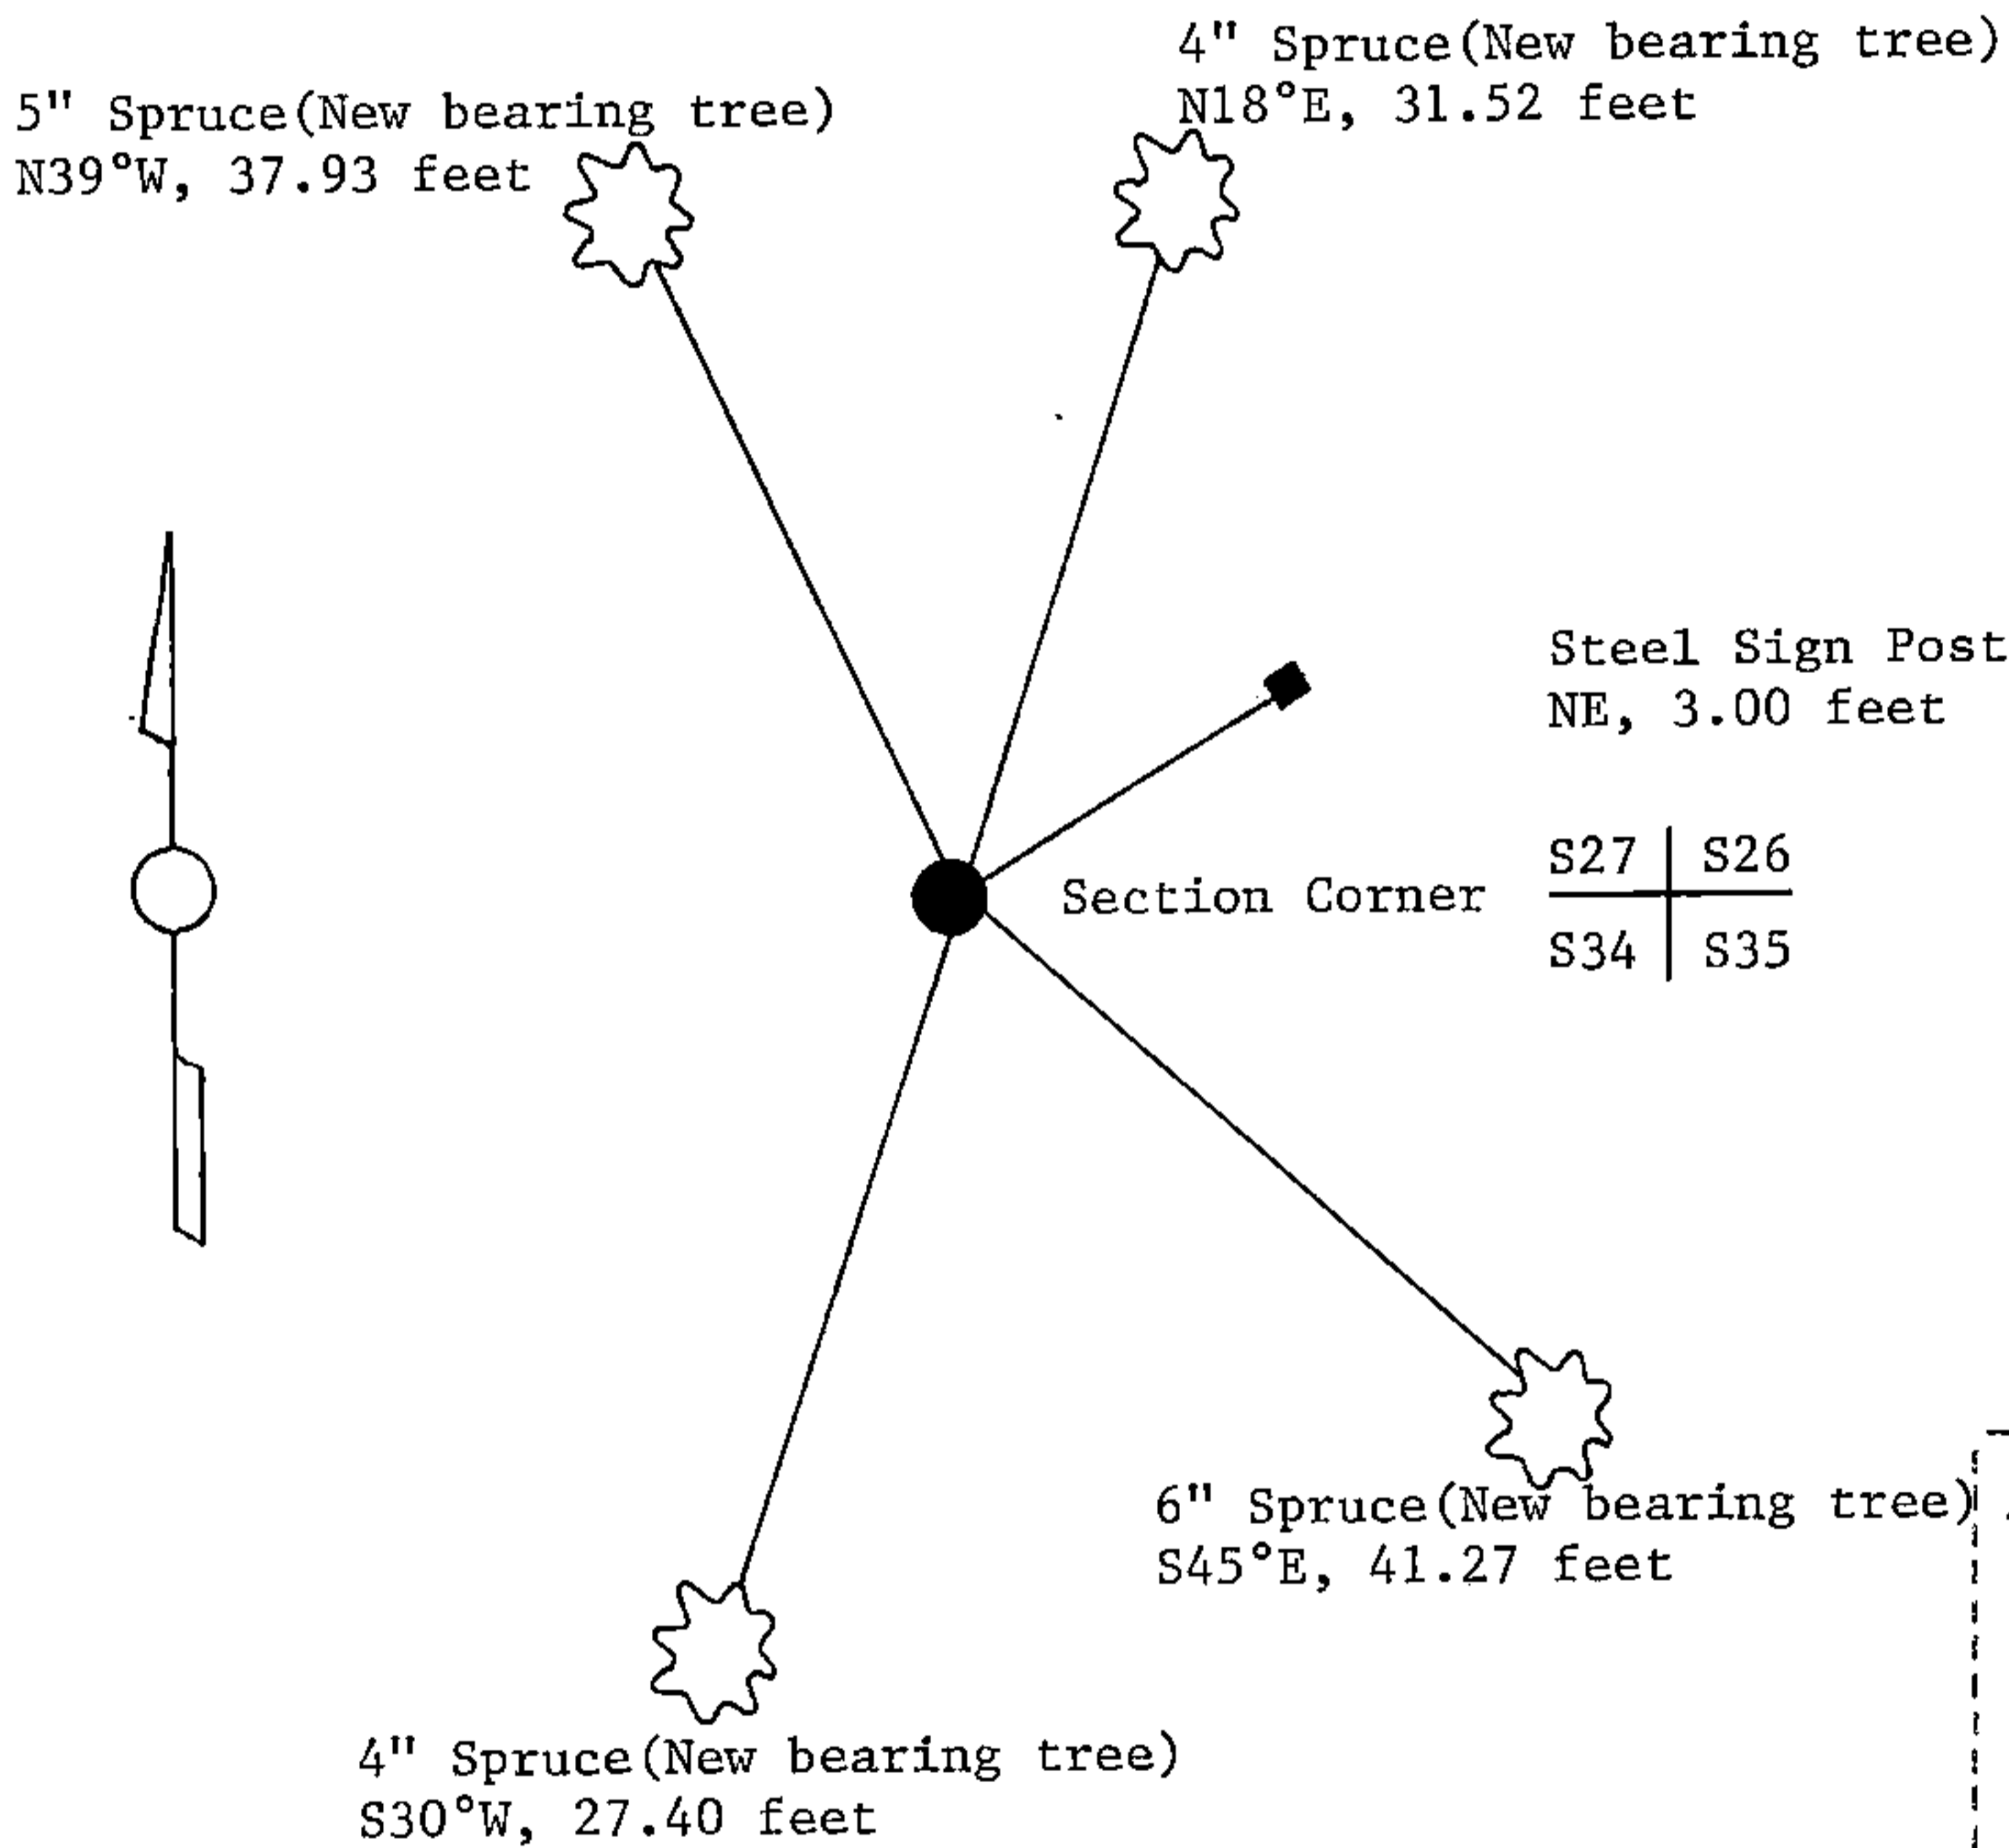

(i) I, William B. Cochrane
 (type or print name) certify that the corner location shown on this record was determined by me or under my direction and control and that this U.S. Public Land Survey Monument Record is correct and complete to the best of my knowledge and belief.

William B. Cochrane October 7, 1986
 Signature Date

Survey requested by: [Signature] 3-9-87
 District Ranger Date


U. S. PUBLIC LAND SURVEY MONUMENT RECORD

INSTRUCTIONS:

This record shall show the location of the corner and shall include all of the following nine elements (a through i).

- (a) Identify the corner by reference to the U.S. public land survey system.
- = Corner monument restored.

Section Corner to Sections 26, 27, 34, 35
T39N, R14E, Forest County, Wisconsin

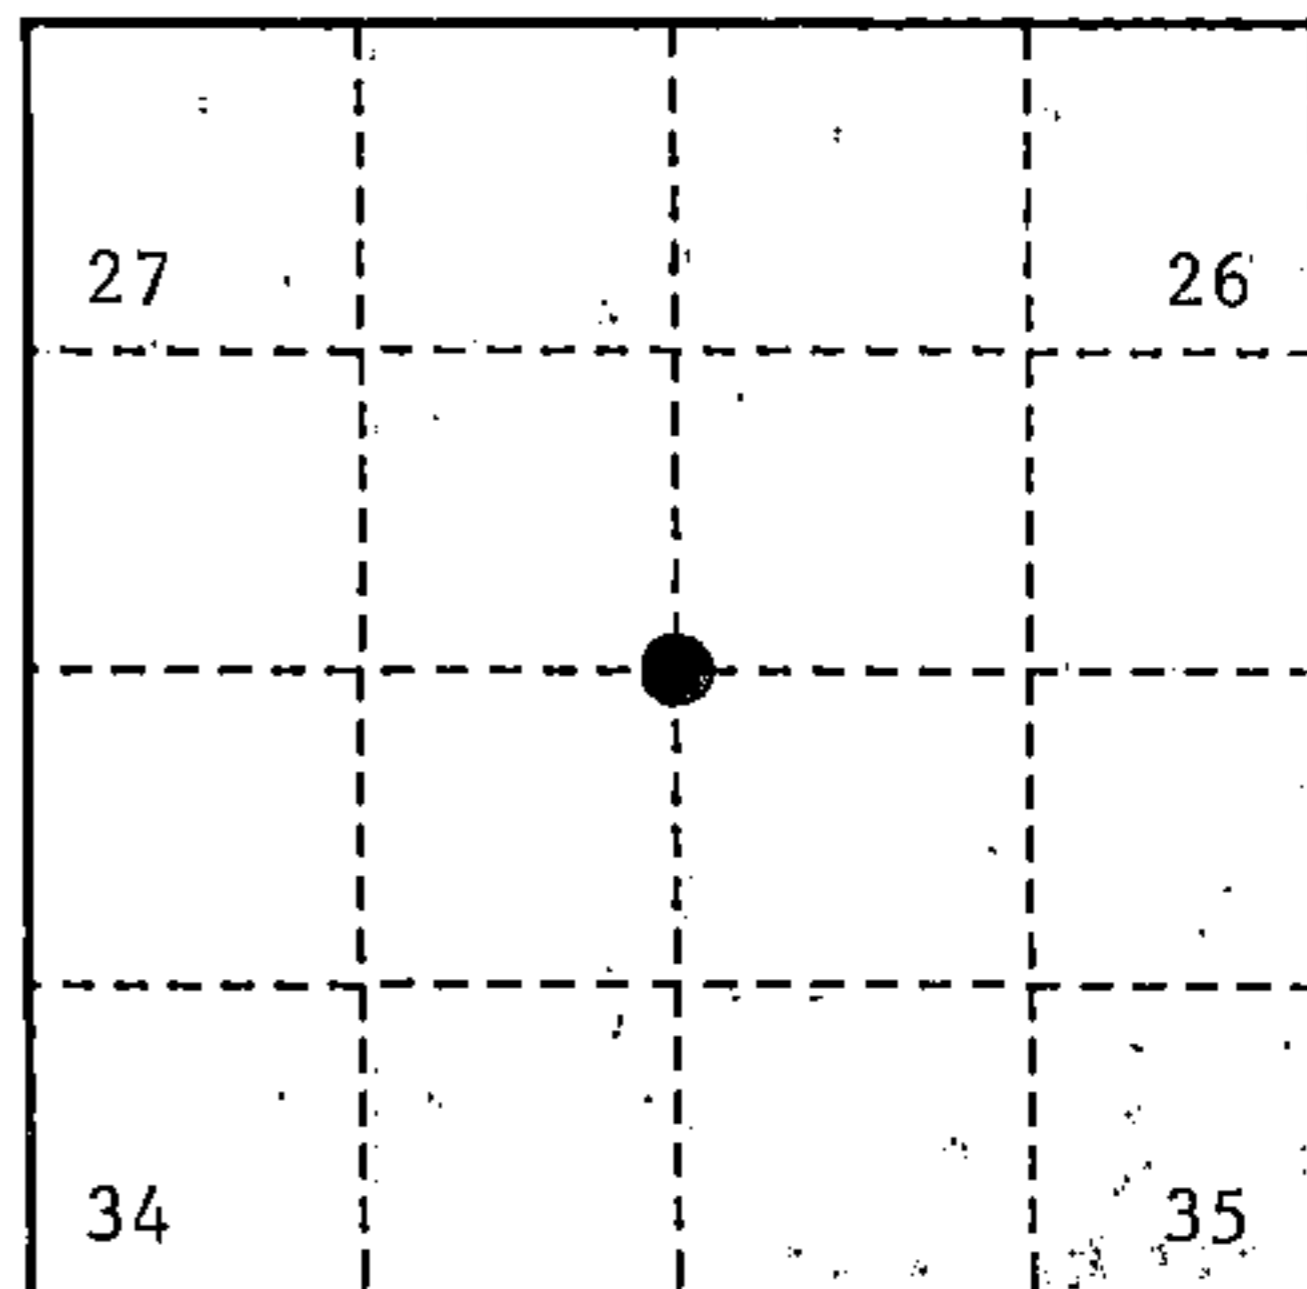

- (b) Describe any record evidence, monument evidence, occupational evidence, testimonial evidence or any other material evidence you considered, and whether the monument was found or placed.

Original Government Survey in 1865 by William E. Daugherty and Alex McDill.

In 1985, William B. Cochrane, a Land Surveyor with the U.S. Forest Service, restored the corner position from a found cedar post point and a fence line as the best available evidence for restoring the corner position. He set a 2½" diameter aluminum pipe monument, 5 feet long with an aluminum cap stamped as follows: T39N, R14E, S27, S26, S34, S35, 1985, S-1107, from which the following bear:

Spruce	4"	N 18°E	31.52 feet
Spruce	6"	S 45°E	41.27 feet
Spruce	4"	S 30°W	27.40 feet
Spruce	5"	N 39°W	37.93 feet
Steel sign post		Northeast	3.0 feet


On 8/5/99, Gary L. Pisoni RLS found above monument and assessories as described below.

See previous Land Corner Certificate dated March 11, 1987, Document Number 132393.

- (c) In the plan view drawing below, provide reference ties to at least 4 witness monuments, or, if the location is within a municipality, to at least 2 witness monuments. (witness monuments shall be made of concrete, natural stone, iron or other equally durable material.)

- (d) Show a plan view drawing depicting the relevant monuments and reference ties which is sufficient in detail to enable accurate relocation of the corner monument if the corner monument is disturbed. Indicate north.

1. Spruce, 5", N 18°E, 31.52 feet
2. Spruce, 7", S 45°E, 41.27 feet
3. Steel sign post, N 35°E, 3.0 feet
4. Balsam, 3", S 16°W, 14.57 feet (NBT)
5. Spruce, 7", N 43°W, 60.00 feet (NBT)

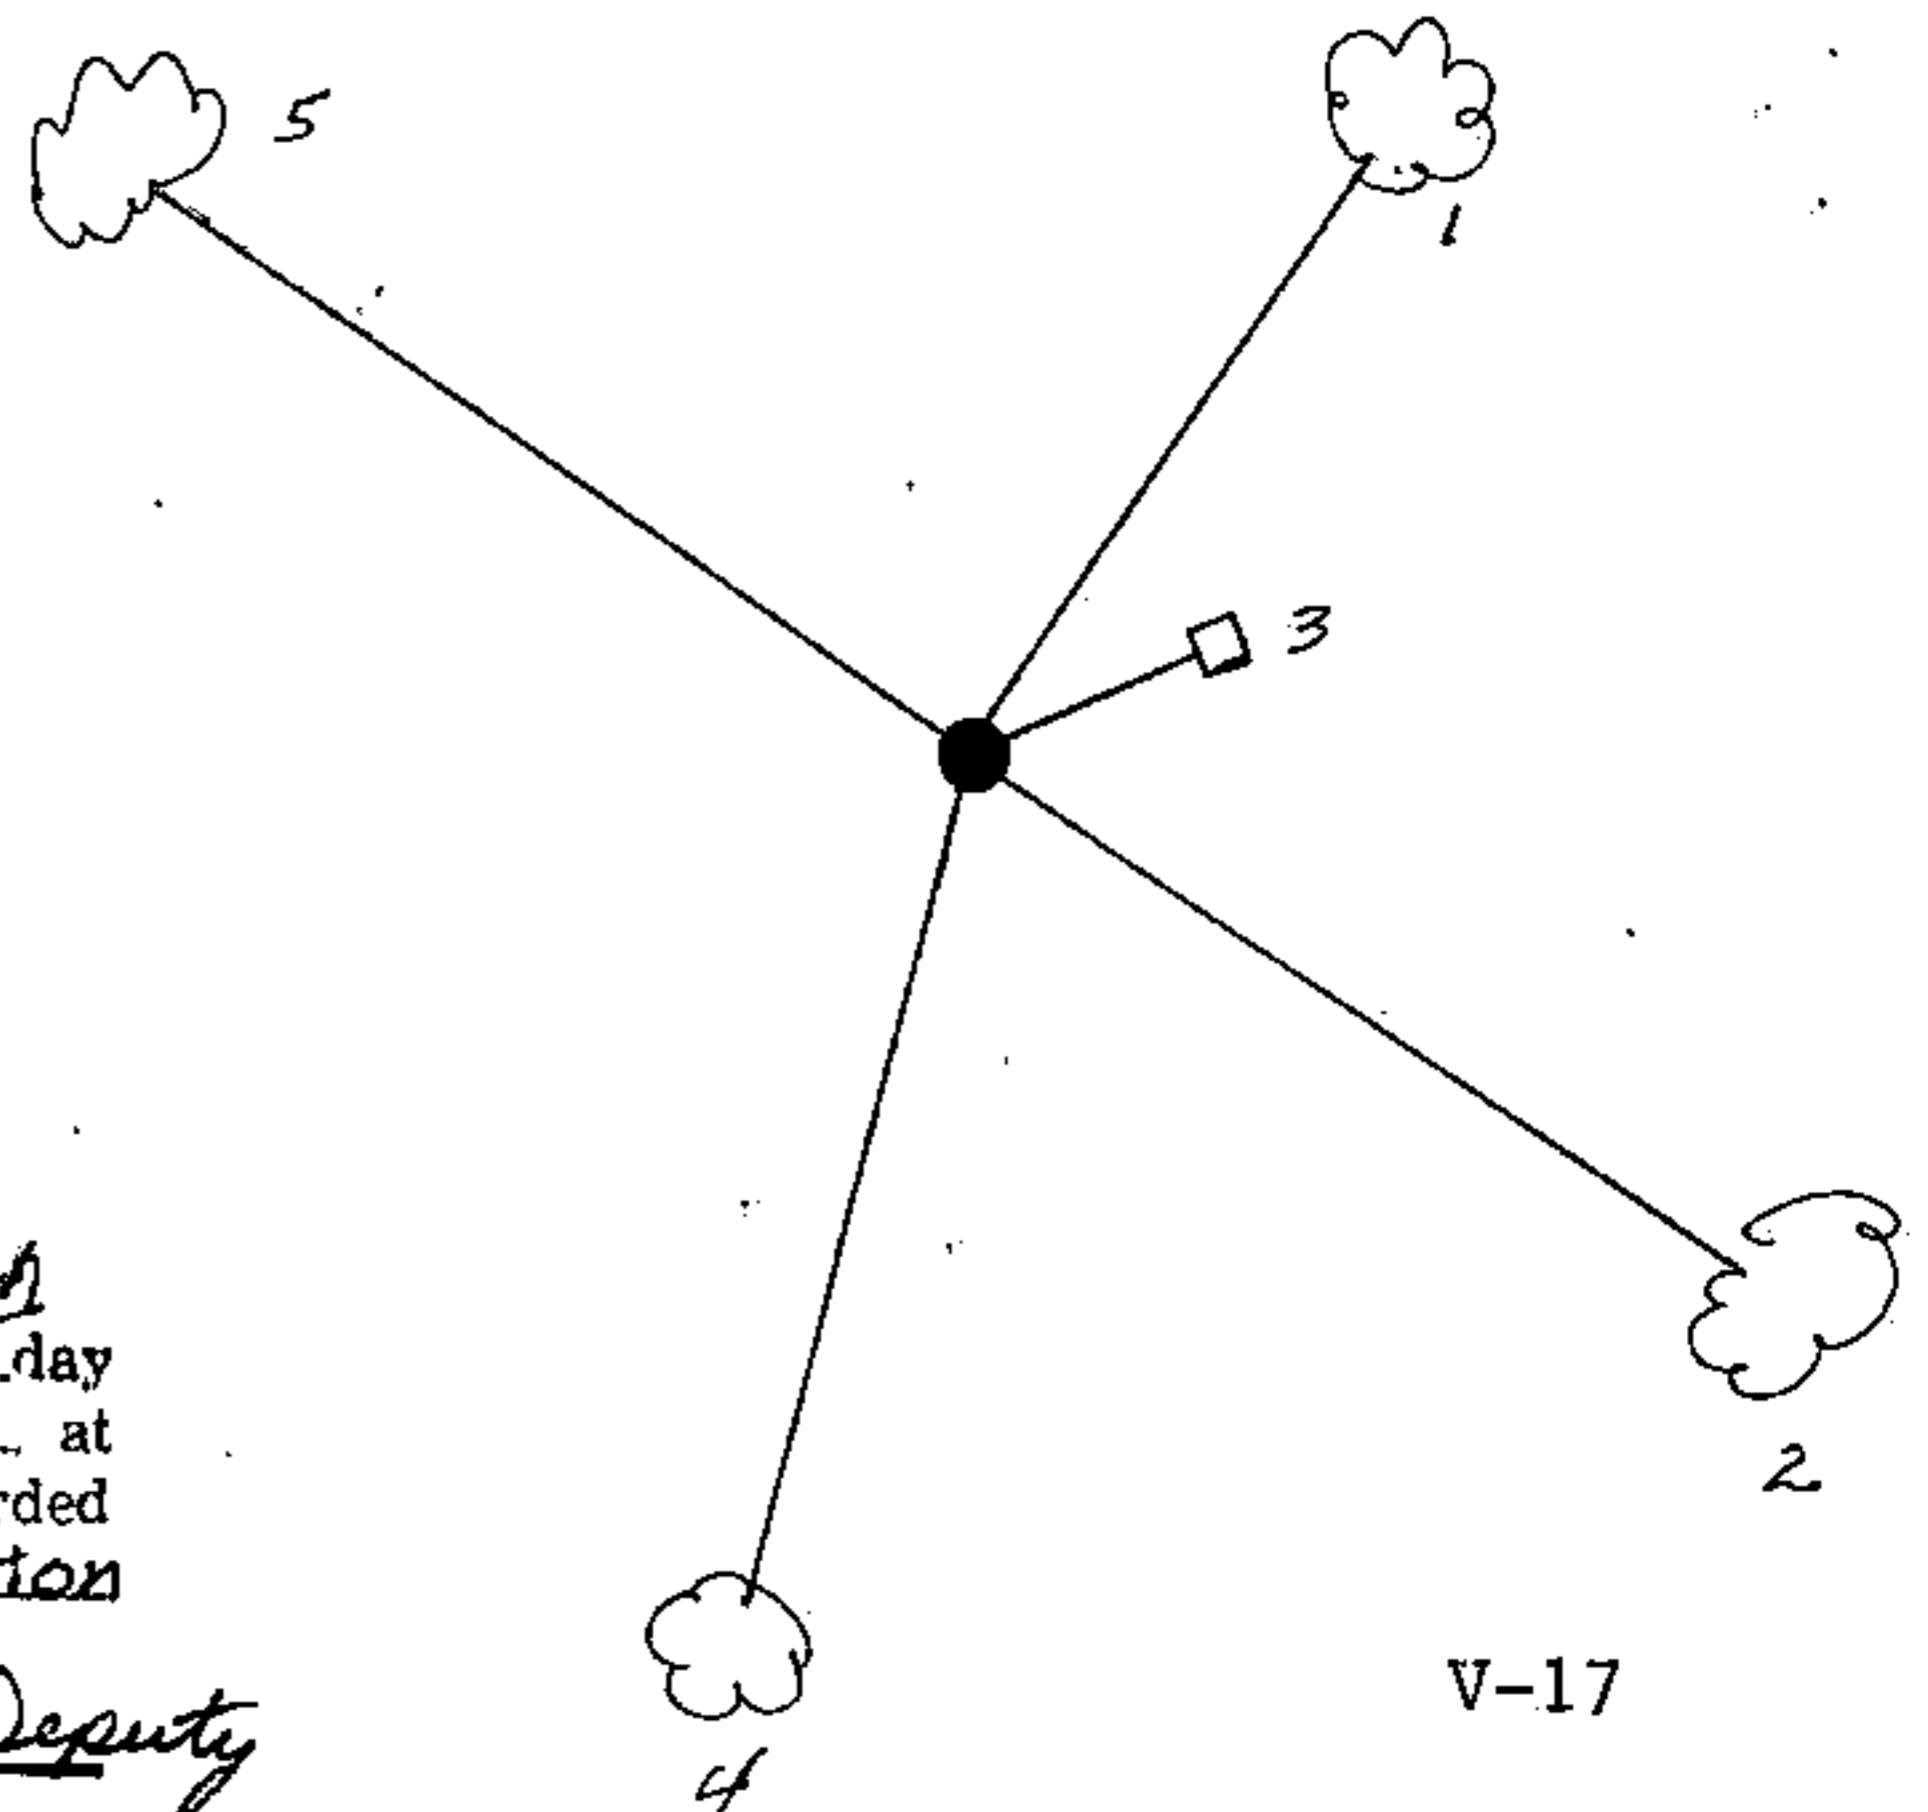

REGISTER'S OFFICE
Forest County, Wis.
Received for record this 27th day
of October A.D., 1999 at
10:05 o'clock A.M. and recorded
in Vol. Corner Restoration
page V-17

Kay Swanson, Deputy
Register of Deeds

V-17

43914 270000

V-17

(e) Describe any material discrepancy between the location of the corner as restored or reestablished and the location of that corner as previously restored or reestablished by distance and direction. Show the discrepancy on the plan view drawing under (d), above. Show the distances between the corner as previously restored or reestablished and (1) the corner as restored or reestablished, and (2) to at least 2 of the witness monuments shown on the drawing in (d), above.

None

(f) Was the corner restored through acceptance of (1) an obliterated evidence location, or, (2) a found perpetuated location ?

Restored from accepted evidence.

(g & h) Was the corner reestablished through lost corner proportionate methods? If so, show the method, including the directions and distances to other public land survey corners used as evidence or used for proportioning in determining the corner location?

(1) I, Gary L. Pisoni

(type or print name) certify that the corner location shown on this record was determined by me or under my direction and control and that this U.S. Public Land Survey Monument Record is correct and complete to the best of my knowledge and belief.

Gary L. Pisoni
Signature

10-1-99
Date

CERTIFICATE READY FOR FILING:

[Signature]
District Ranger



Stock No. 26273