

CERTIFIED LAND CORNER RESTORATION

State of Wisconsin }
County of Forest } ss.

I Jean F. Resvick, do hereby certify that on the 29th day of September, 1969, I found evidence of the East Quarter corner of Section 3 Township 40 North, Range 12 East, Fourth Principal Meridian, as described hereon; and that from this evidence I established a new monument and accessories as described hereon to perpetuate the original location of this corner:

Description of original monument and accessories and subsequent restorations:

Surveyed in 1859 by Wm. E. Daugherty
Dependent Resurvey in 1941 by Guy R. Veal
At proportionate distance set iron post 3 ft. long, 2 in. in diameter with brass cap marked 1/4, S3, S2, 1941. From which: Maple 5, bears, N47°30'E, 71 lks.
Maple 20, bears, S60°30'W, 183 lks.


Description of corner evidence found:

Monument found as described above.
Maple 7, bears N46E, 46.9 ft.
Maple blow down, S59W, 121 ft.

Description of monument and accessories I established to perpetuate the original location of this corner:

Blazed and scribed the following new bearing trees.
Spruce 10, S73E, 37.99 ft.
Spruce 6, S24W, 15.31 ft.

44012032000

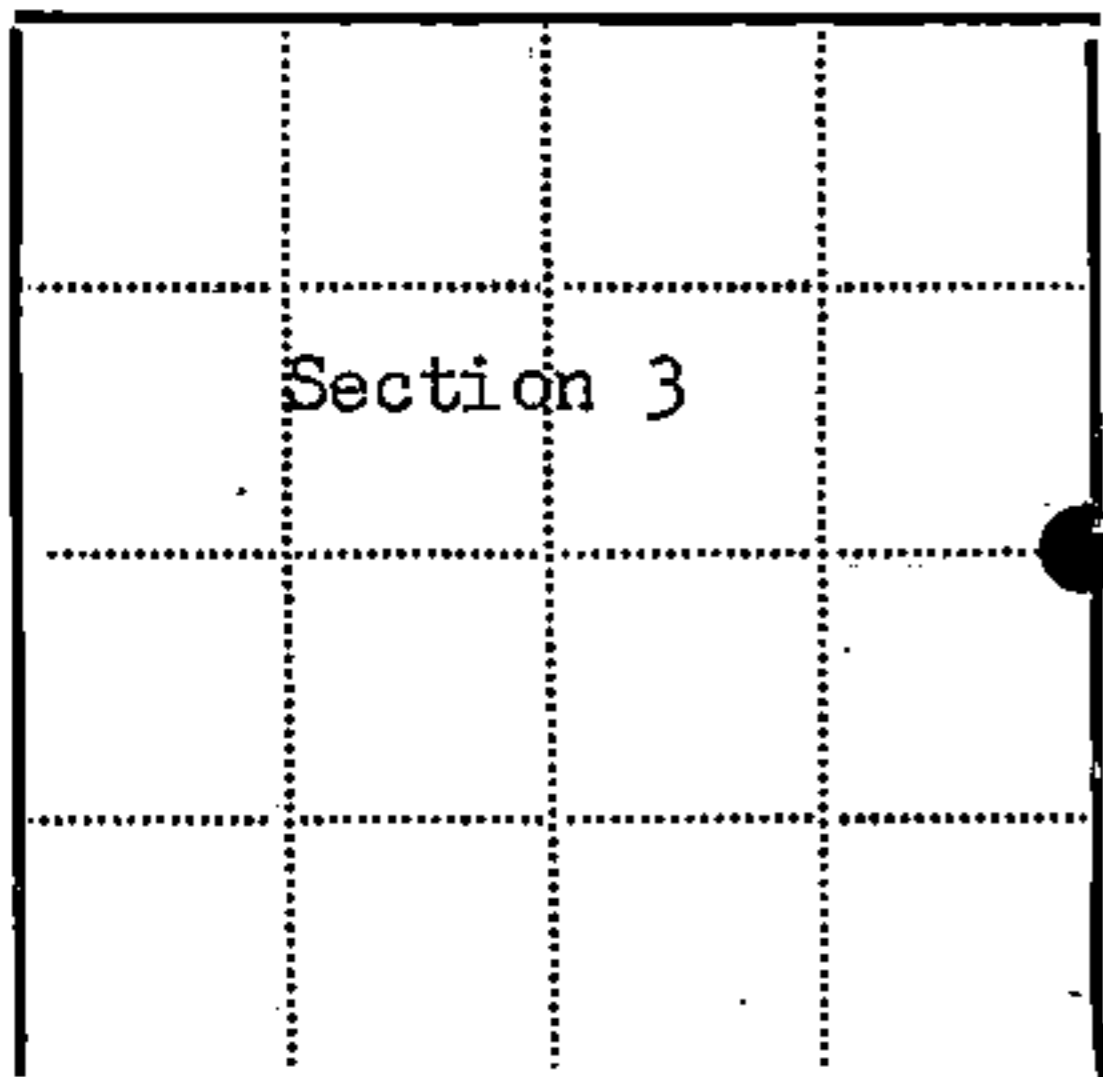

● = Corner monument restored
□ =

Resident witnesses.....

Dated at Rhinelander Wisconsin, this 29th day of September 1970.....

Signature *Jean F. Resvick* Title Cadastral Surveyor
(County Surveyor, Registered Land Surveyor, or other duly authorized official)

Surveyors Registration No. S-802 DOCUMENT No. 98063

Office of Register of Deeds County of Forest

I hereby certify that the within instrument was filed in this office for record on the 22nd day of May 1970, and was filed in Book No. Page No. C-17 of County Records.

Signature *Eugene Stutz* Title Register of Deeds

Township 40 North, Range 12 East, Section 3, Index No. C-17, Page No.

C 17