

CERTIFIED LAND CORNER RESTORATION

State of Wisconsin }
County of Forest } ss.

I Jean F. Resvick, do hereby certify that on the 21st day of October, 1969, I found evidence of the South One sixteenth corner of between section 3 and 4 Township 40 North, Range 12 East, Fourth Principal Meridian, as described hereon; and that from this evidence I established a new monument and accessories as described hereon to perpetuate the original location of this corner:

Description of original monument and accessories and subsequent restorations:

Established by Ripco when subdividing section 3. Corner marked by a 1 inch diameter iron pipe, with a 2 inch square brass plate welded on top stamped to identify corner. Blazed and scribed the following bearing trees:

- White pine 14, S45E, 72 1/4 lks.
- White pine 18, N34W, 33 lks.


Description of corner evidence found:

Found 1 inch outside diameter pipe with 2 inch square brass plate stamped to identify corner. From which the following scribed bearing trees bear. White pine 14, S45E, 47.7 ft. White pine 18, N34W, 21.8 ft.

Description of monument and accessories I established to perpetuate the original location of this corner:

The monument had frost heaved and was nearly out of the ground. I drove monument down and tamped the soil around it making it stable.

4401204 1000

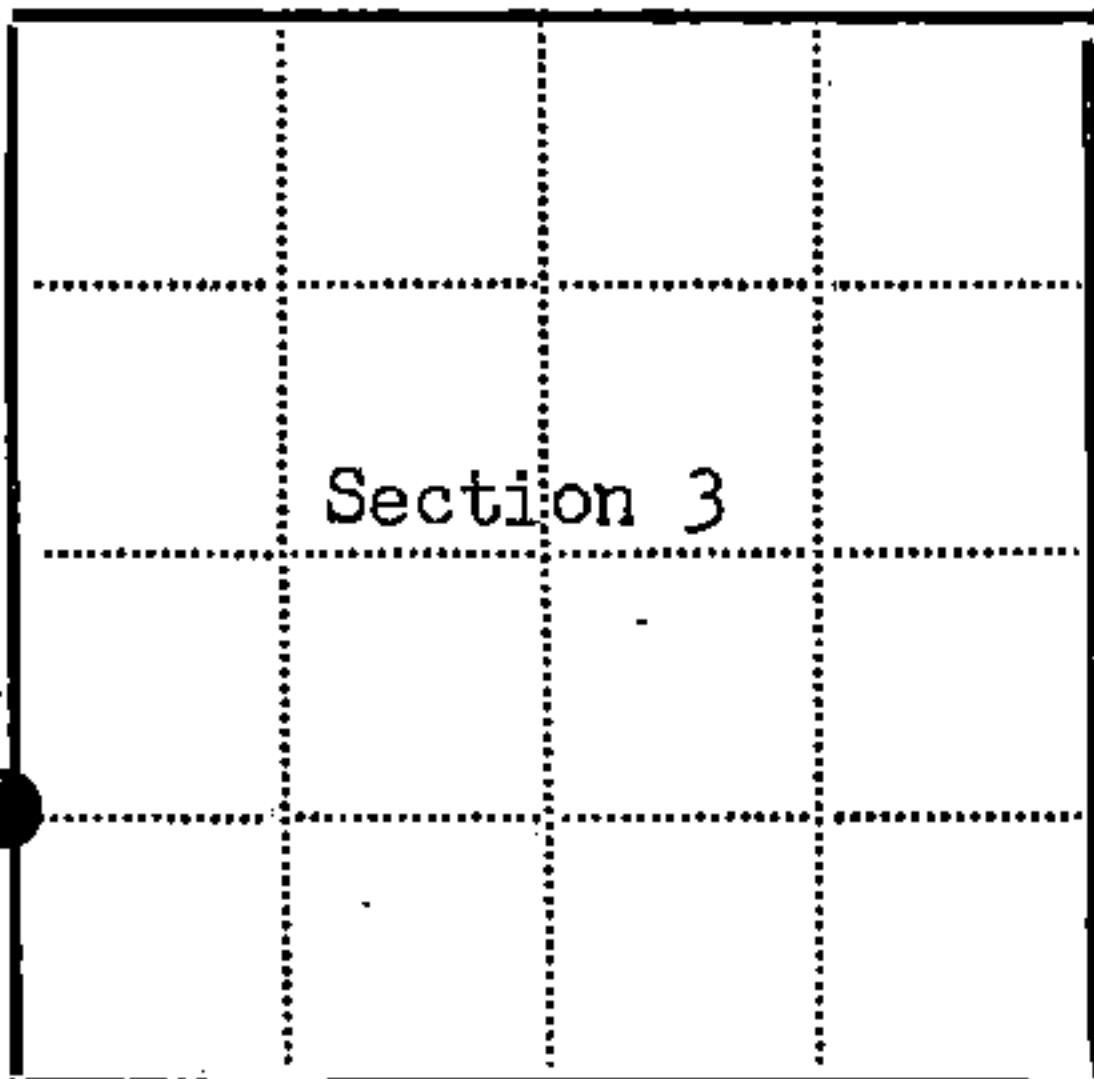

● = Corner monument restored
□ =

Resident witnesses.....

Dated at Rhinelander Wisconsin, this 23 day of January 1970

Signature Jean F. Resvick Title Cadastral Surveyor
(County Surveyor, Registered Land Surveyor, or other duly authorized official)

Surveyors Registration No. S-802 DOCUMENT NUMBER 98062

Office of Register of Deeds County of Forest

I hereby certify that the within instrument was filed in this office for record on the 22nd day of May 1970, and was filed in Book No. Page No. D-13 of County Records.

Signature Eugene Stutzman Title Register of Deeds

Township 40 North, Range 12 East, Section 3, Index No. D-13, Page No.

D 13