

CERTIFIED LAND CORNER RESTORATION


Index No. 91

State of Wisconsin }  
County of Forest } ss.

I Jean F. Resvick, do hereby certify that on the 9th day of May, 1963, I found evidence of the Section corner of Sections 8, 9, 16 and 17 Township 40, North, Range 12 East, Fourth Principal Meridian, as described hereon; and that from this evidence I established a new ~~monument and~~ accessories as described hereon to perpetuate the original location of this corner.

Resident witnesses:  
\_\_\_\_\_  
\_\_\_\_\_  
\_\_\_\_\_

FORM 985 H. G. MILLER CO., MILWAUKEE

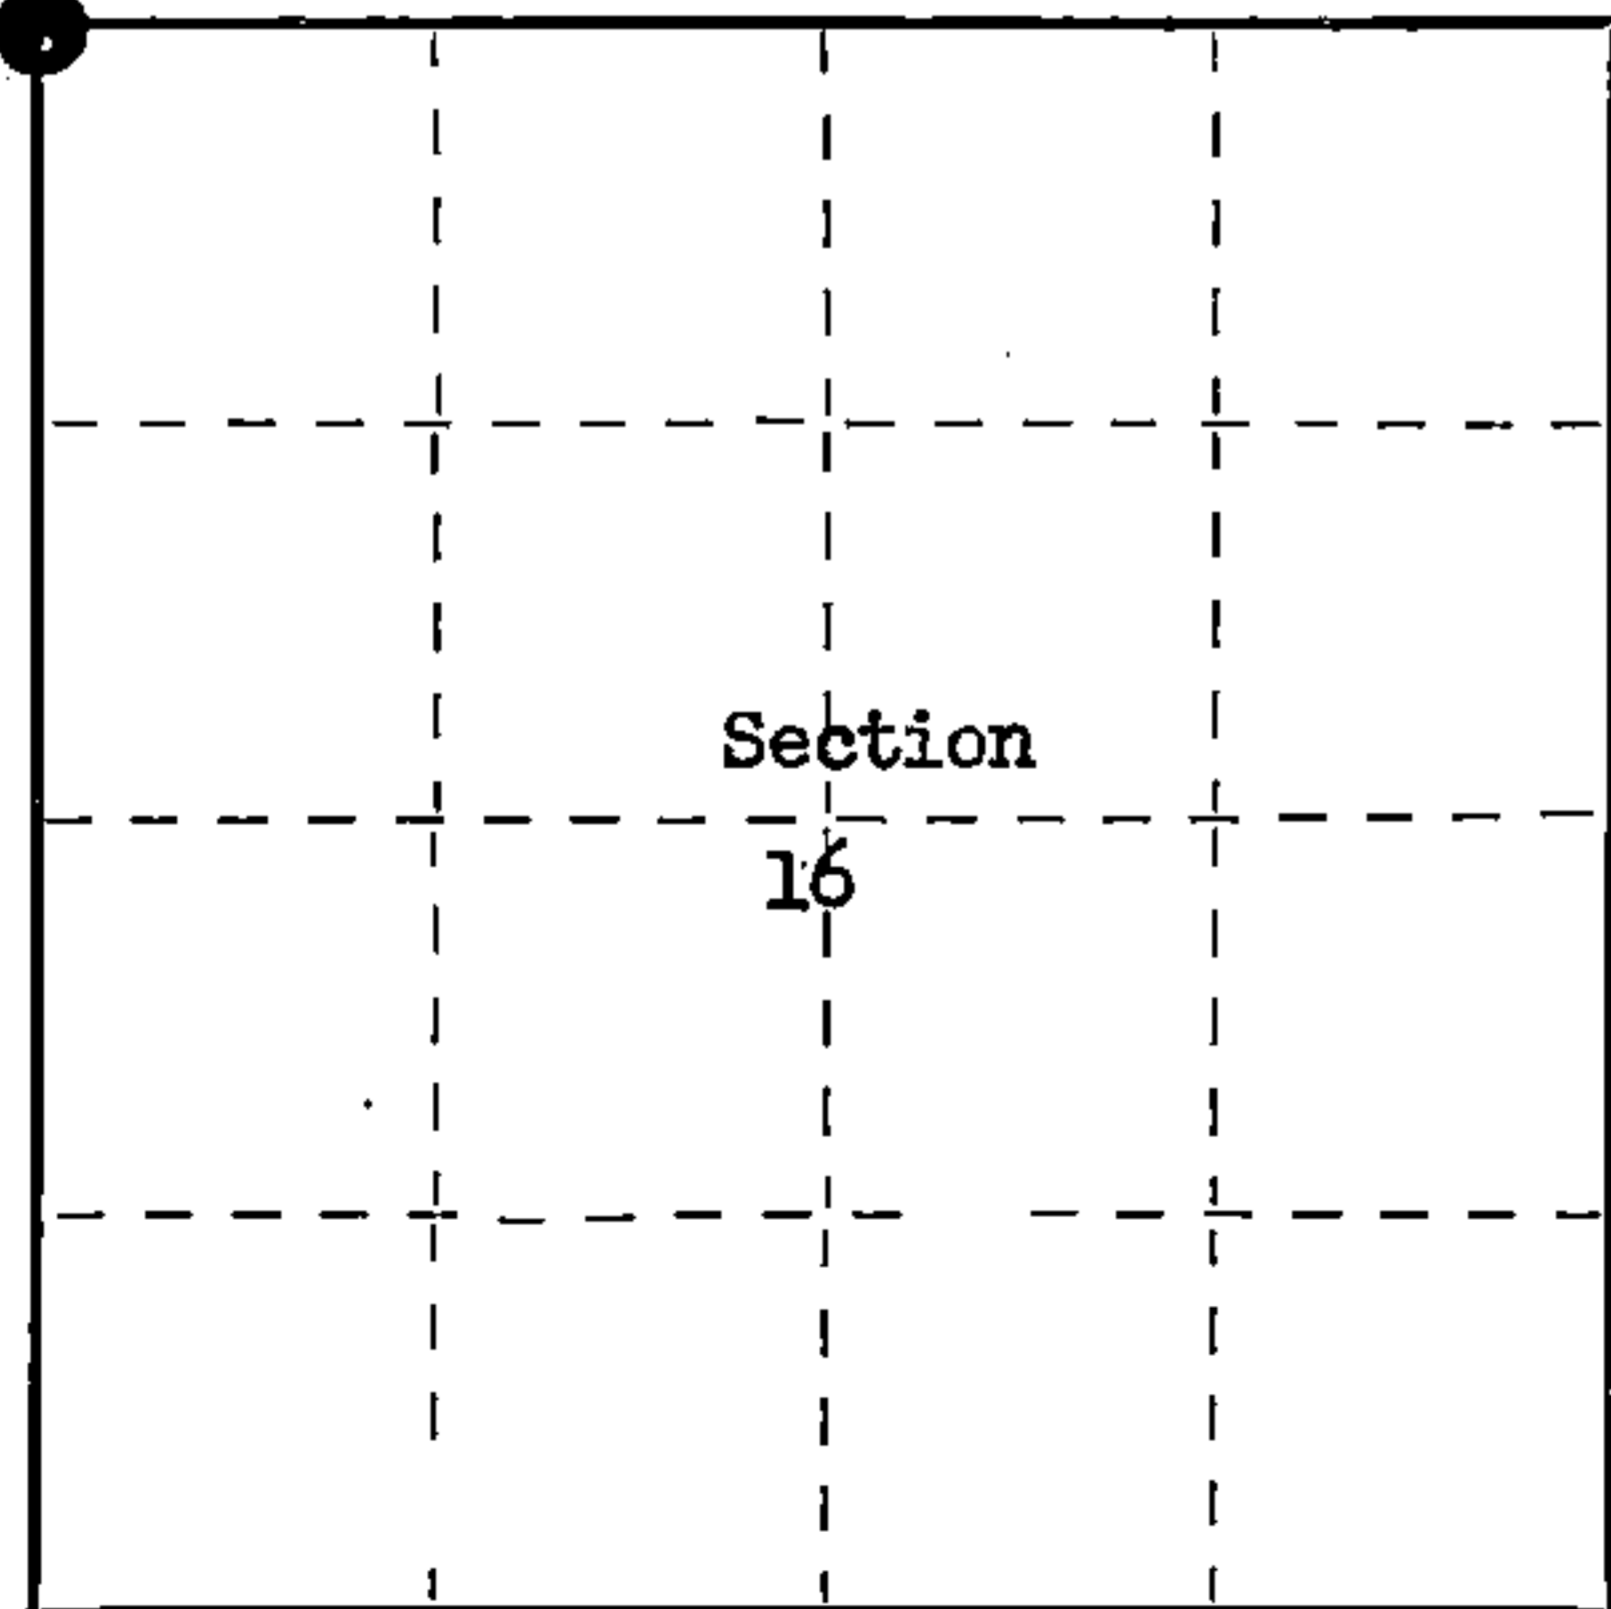

○ = Corner monument restored.

History of original corner establishment:

Surveyed in 1859 by Wm. E. Daugherty. Dependent Resurvey in 1941 by Guy R. Veal. At proportionate distance set concrete monument, 2 ft. long, 6 in. diam., with iron post, 22 in. long, 1 in. diam., encased therein with brass cap marked:



From which:  
Poplar 7", bears, N59°E, 63 lks.  
Poplar 7", bears, S60°E, 79 lks.  
Poplar 5", bears, S49°W, 49 lks.  
Poplar 5", bears, N67°W, 31½ lks.

Description of corner evidence found:

Monument as described:  
Poplar, snag 7", N59°E, 41.6 ft.  
Poplar, snag 8", S60°E, 52.1 ft.  
Poplar, fallen 5", S49°W, 32.3 ft.  
Poplar, snag 7", N67°W, 20.8 ft.

Description of ~~monument and~~ accessories I established to perpetuate the ~~original~~ location of this corner.

Blazed and scribed the following new bearing trees:  
W. pine 4", S82°W, 12.60 ft. (19.09 lks.)  
W. pine 4", N14°E, 17.10 ft. (25.91 lks.)  
W. pine 4", S75°E, 9.70 ft. (14.70 lks.)

Dated at Rhineland, Wis., this 16th day of August, 1963

Signature Jean F. Resvick Title Cadastral Surveyor Registration No. S-802  
(County Surveyor, Registered Land Surveyor, or other duly authorized official)

Office of Register of Deeds, County of Forest, I hereby certify that the within instrument was filed in this office for record on the 4 day of November, 1963 at 9:00 o'clock A. M.

Anna Peterson  
(Register of Deeds)

87830

By \_\_\_\_\_ Deputy

44012080000




(e) Describe any material discrepancy between the location of the corner as restored or reestablished and the location of that corner as previously restored or reestablished by distance and direction. Show the discrepancy on the plan view drawing under (d), above. Show the distances between the corner as previously restored or reestablished and (1) the corner as restored or reestablished, and (2) to at least 2 of the witness monuments shown on the drawing in (d), above.

See drawing below.

(f) Was the corner restored through acceptance of (1) an obliterated evidence location, or, (2) a found perpetuated location?

Found perpetuated location.

(g&h) Was the corner reestablished through lost corner proportionate methods? If so, show the method, including the directions and distances to other public land survey corners used as evidence or used for proportioning in determining the corner location?

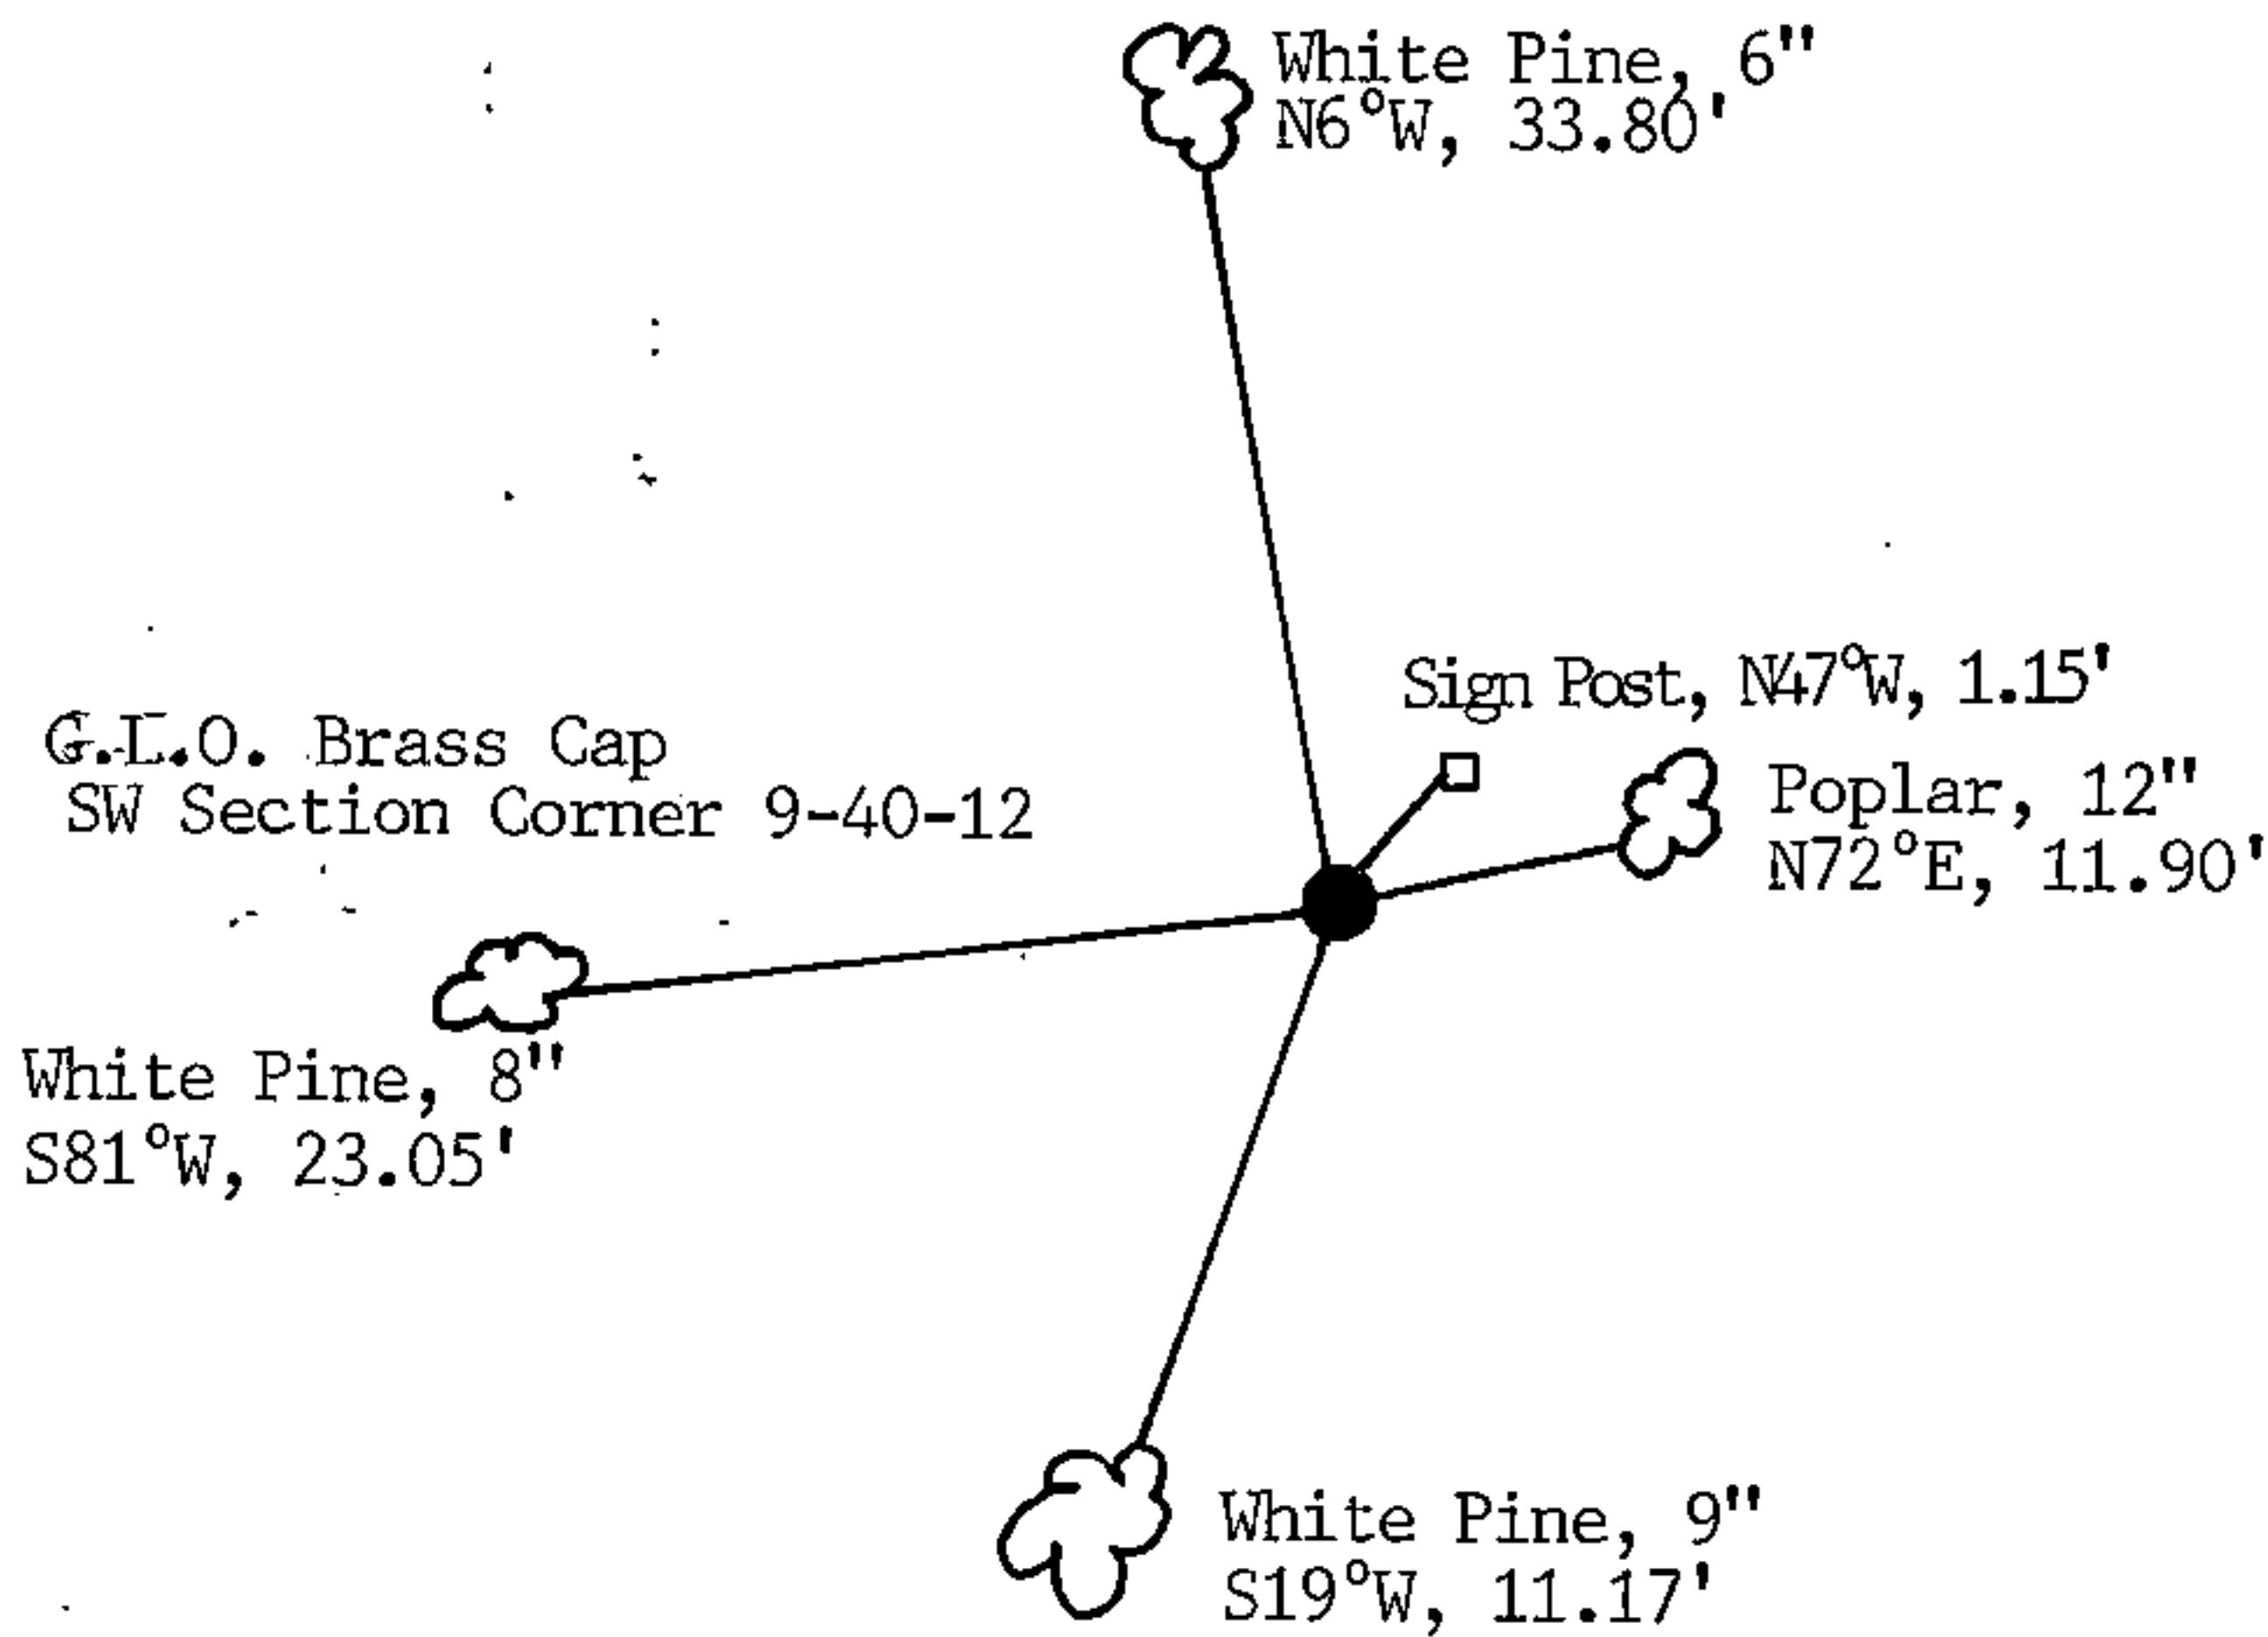

(i) I, Robert H. Winat  
 (type or print name) certify that the corner location shown on this record was determined by me or under my direction and control and that this U.S. Public Land Survey Monument Record is correct and complete to the best of my knowledge and belief.

Robert H. Winat                      4 June '85  
 Signature    Date