

CERTIFIED LAND CORNER RESTORATION

State of Wisconsin }
County of Forest } ss.

I Jean F. Resvick, do hereby certify that on the 2nd day of October, 1973, I found evidence of the south quarter corner of Section 8 Township 40 north, Range 12 east, Fourth Principal Meridian, as described hereon; and that from this evidence I established a new monument and accessories as described hereon to perpetuate the original location of this corner:

Description of original monument and accessories and subsequent restorations:



Original survey in 1859 by William Daugherty
Dependent Resurvey in 1941 by Guy R. Veal
Set iron pipe 36 inches long, 2 inch diameter with brass cap marked S8, 1/4, S17, 1941
Aspen 4, bears S23E, 16 1/2 lks.
Aspen 5, bears N17W, 26 1/2 lks.

Description of corner evidence found:

Monument as described above
Aspen stump bears S23E, 17.5 feet
Aspen stump bears N17W, 10.9 feet

Description of ~~monument and~~ accessories I established to perpetuate the location of this corner:

Blazed and scribed the following new bearing trees
White pine 5, bears N74E, 2.50 feet
White pine 6, bears S56E, 13.45 feet
Steel sign post set 1.0 foot Northwest of monument.

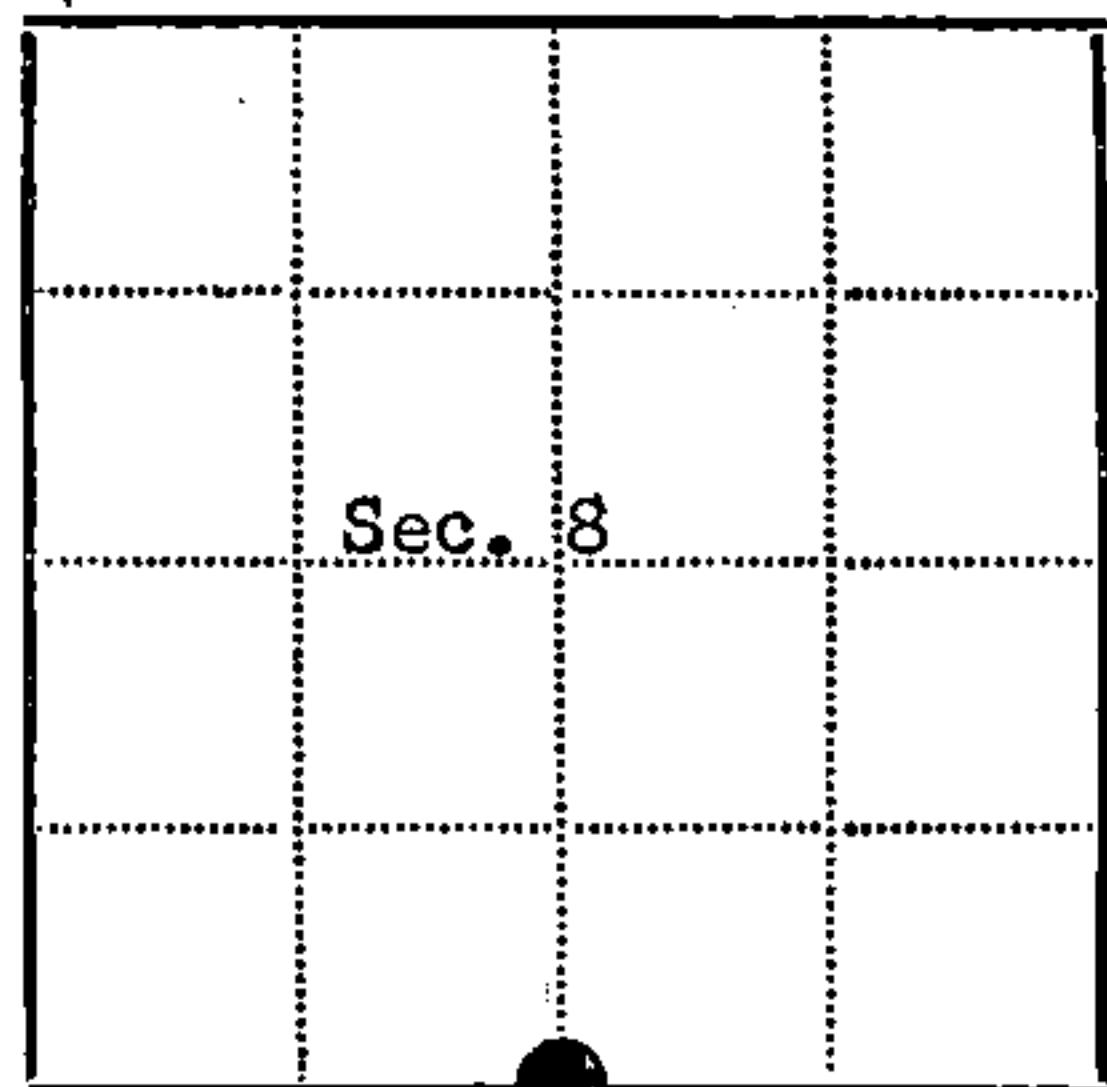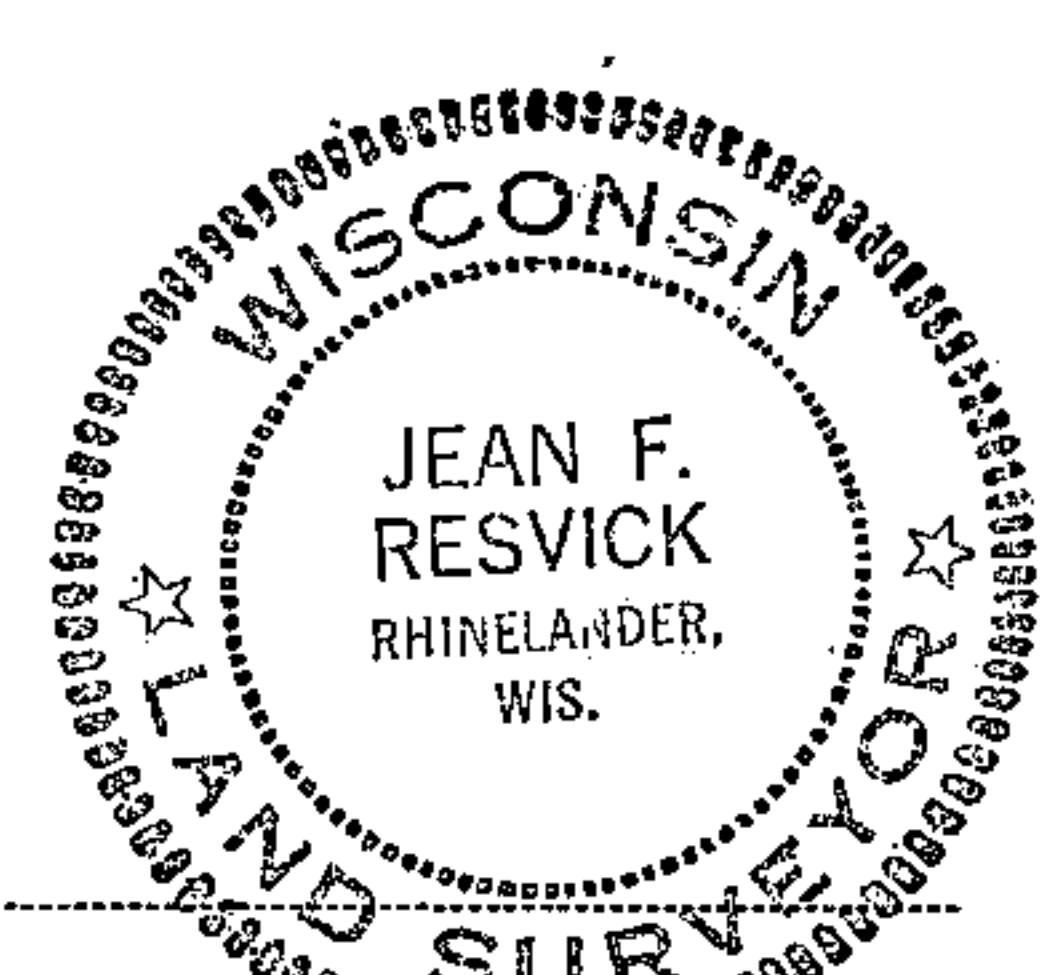

● = Corner monument restored
□ =

Resident witnesses _____

Dated at Rhinelander Wisconsin, this 30 day of May 1974.

Signature Jean F. Resvick Title Land Surveyor
(County Surveyor, Registered Land Surveyor, or other duly authorized official)

Surveyors Registration No. S-802 DOCUMENT NUMBER 105821

Office of Register of Deeds County of Forest

I hereby certify that the within instrument was filed in this office for record on the 8th day of August 1974, and was filed in Book No. Corner Restorations Page No. J-7 of County Records.

Signature Eugene Stalony Title _____

Township 40 north, Range 12 east, Section 8, Index No. J-7, Page No. _____

41012080020