

CERTIFIED LAND CORNER RESTORATION

State of Wisconsin }
County of Forest } ss.

I, Jean F. Resvick, do hereby certify that on the 4th day of April, 1973, I found evidence of the East quarter corner of Section 15 Township 40 North, Range 12 East, Fourth Principal Meridian, as described hereon; and that from this evidence I established a new monument and accessories as described hereon to perpetuate the original location of this corner:

Description of original monument and accessories and subsequent restorations:

Dependent resurvey by Guy R. Veal in 1941
The point for the 1/4 section corner as determined from an original bearing tree.
At the point for the 1/4 corner set an iron post, 3 feet long 2 inch diameter 27 inches in the ground, with brass cap marked, 1/4, S15, S14, 1941
Hemlock 10 inch diameter N77°45E 184 lks.
Hemlock 7 inch diameter S0°45'W 188 lks.

Description of corner evidence found:



Monument found as described above.

From which a Hemlock 16" N78E 122.44 feet
Hemlock snag 8" S1°W 124.08 feet scribing visible

Description of monument and accessories I established to perpetuate the original location of this corner:

Blazed and scribed the following new bearing tree
Maple 8" N70W 41.9 lks.
Set steel sign post and sign
Painted bearing trees

4401215 2000

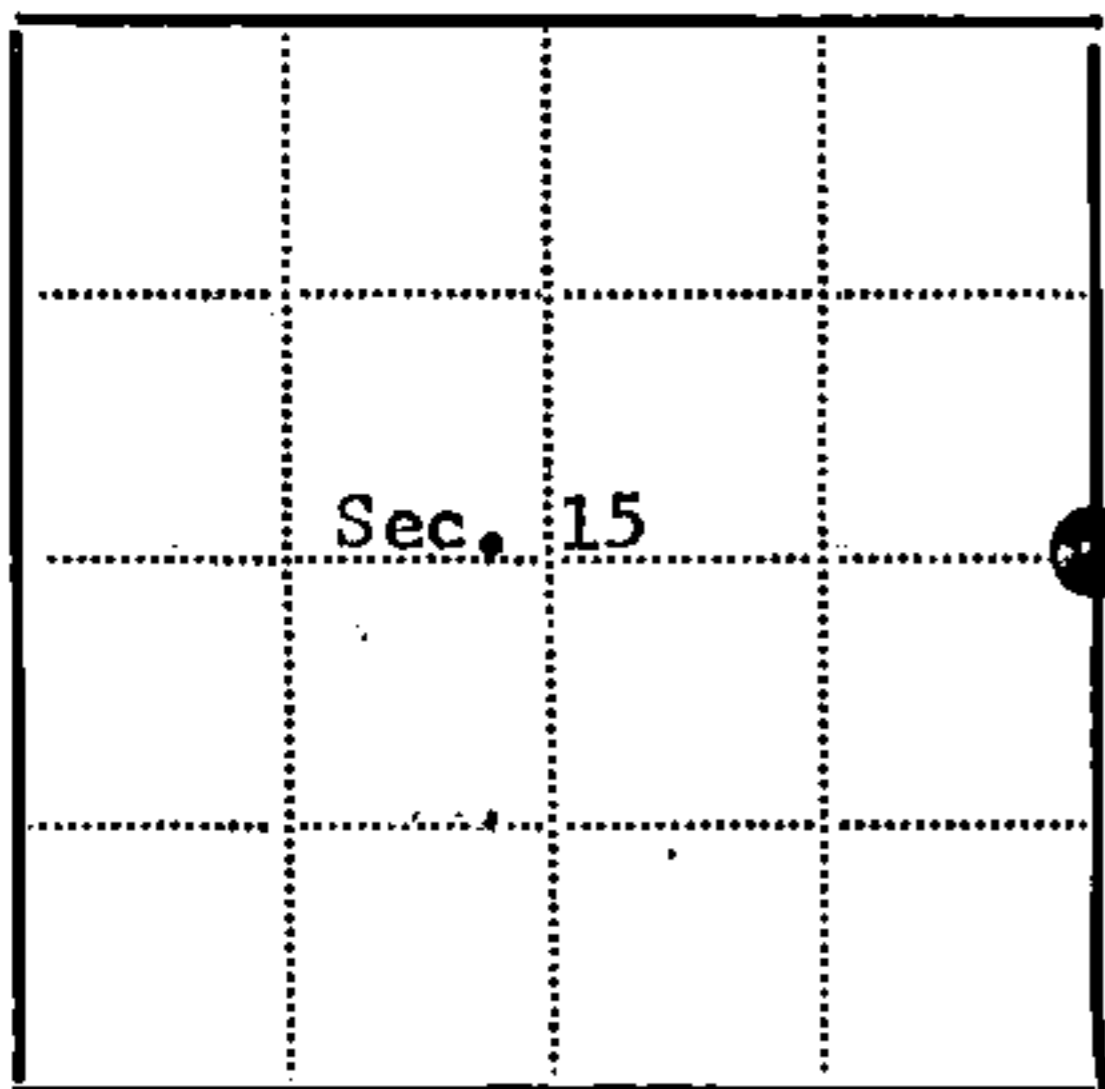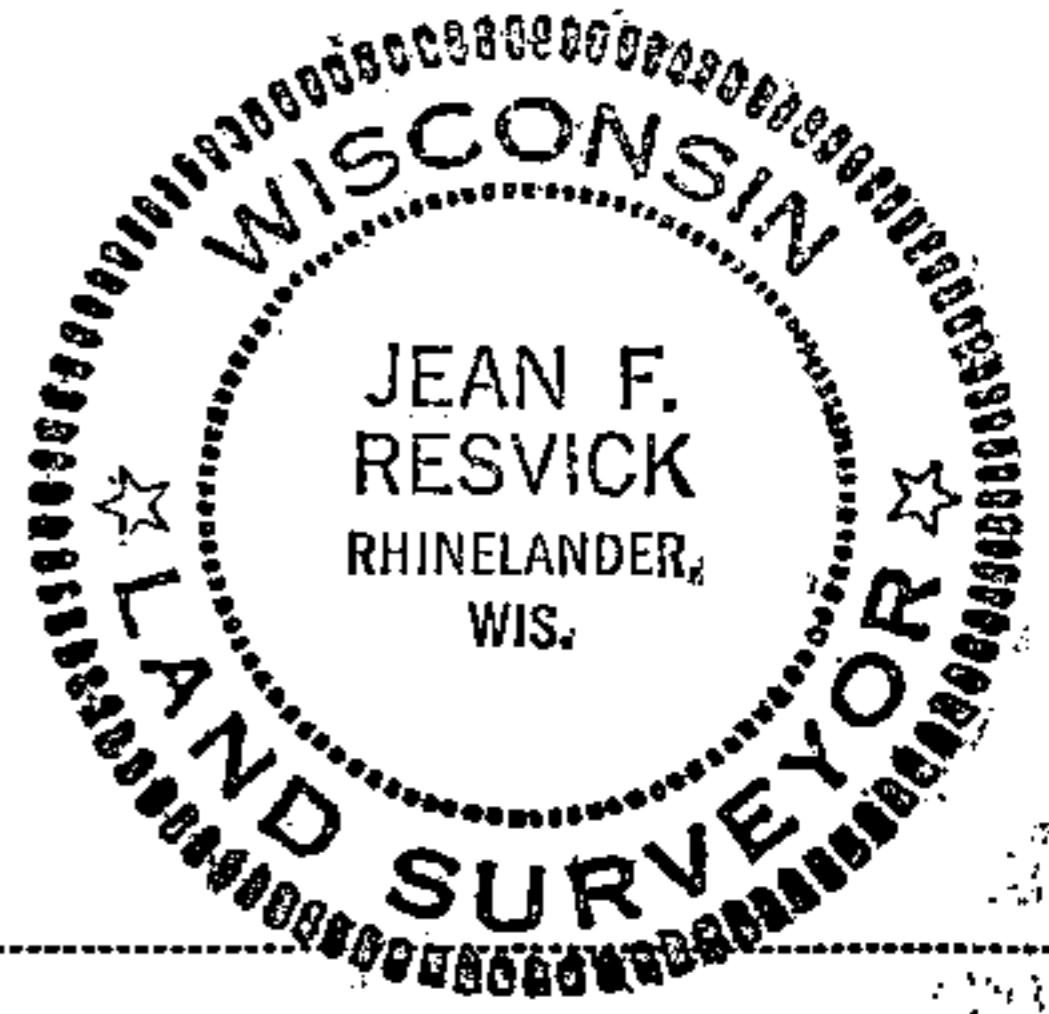

● = Corner monument restored
□ =

Resident witnesses.....
Dated at Rhinelander, Wisconsin, this 31st day of July 1973.
Signature Jean F. Resvick Title Land Surveyor
(County Surveyor, Registered Land Surveyor, or other duly authorized official)
Surveyors Registration No. S-802 DOCUMENT NUMBER 104451
Office of Register of Deeds County of Forest
I hereby certify that the within instrument was filed in this office for record on the 13th day of November 1973, and was filed in Book Corner Restorations No. L-17 of County Records.

Signature Eugene Stutzmy Title Register of Deeds

Township 40 North, Range 12 East, Section 15, Index No. L-17, Page No.