


CERTIFIED LAND CORNER RESTORATION

Index No. **N-13**  
**N13**

State of Wisconsin }  
County of Forest } ss.


I Jean F. Resvick, do hereby  
certify that on the 9th day  
of May, 1963, I found  
evidence of the Section  
corner of Sections 15, 16, 21 and 22  
Township 40, North, Range  
12 East, Fourth Principal Meridian,  
as described hereon; and that from this evidence  
I established a new ~~monument and~~ accessories  
as described hereon to perpetuate the original  
location of this corner.

Resident witnesses:  
\_\_\_\_\_  
\_\_\_\_\_  
\_\_\_\_\_

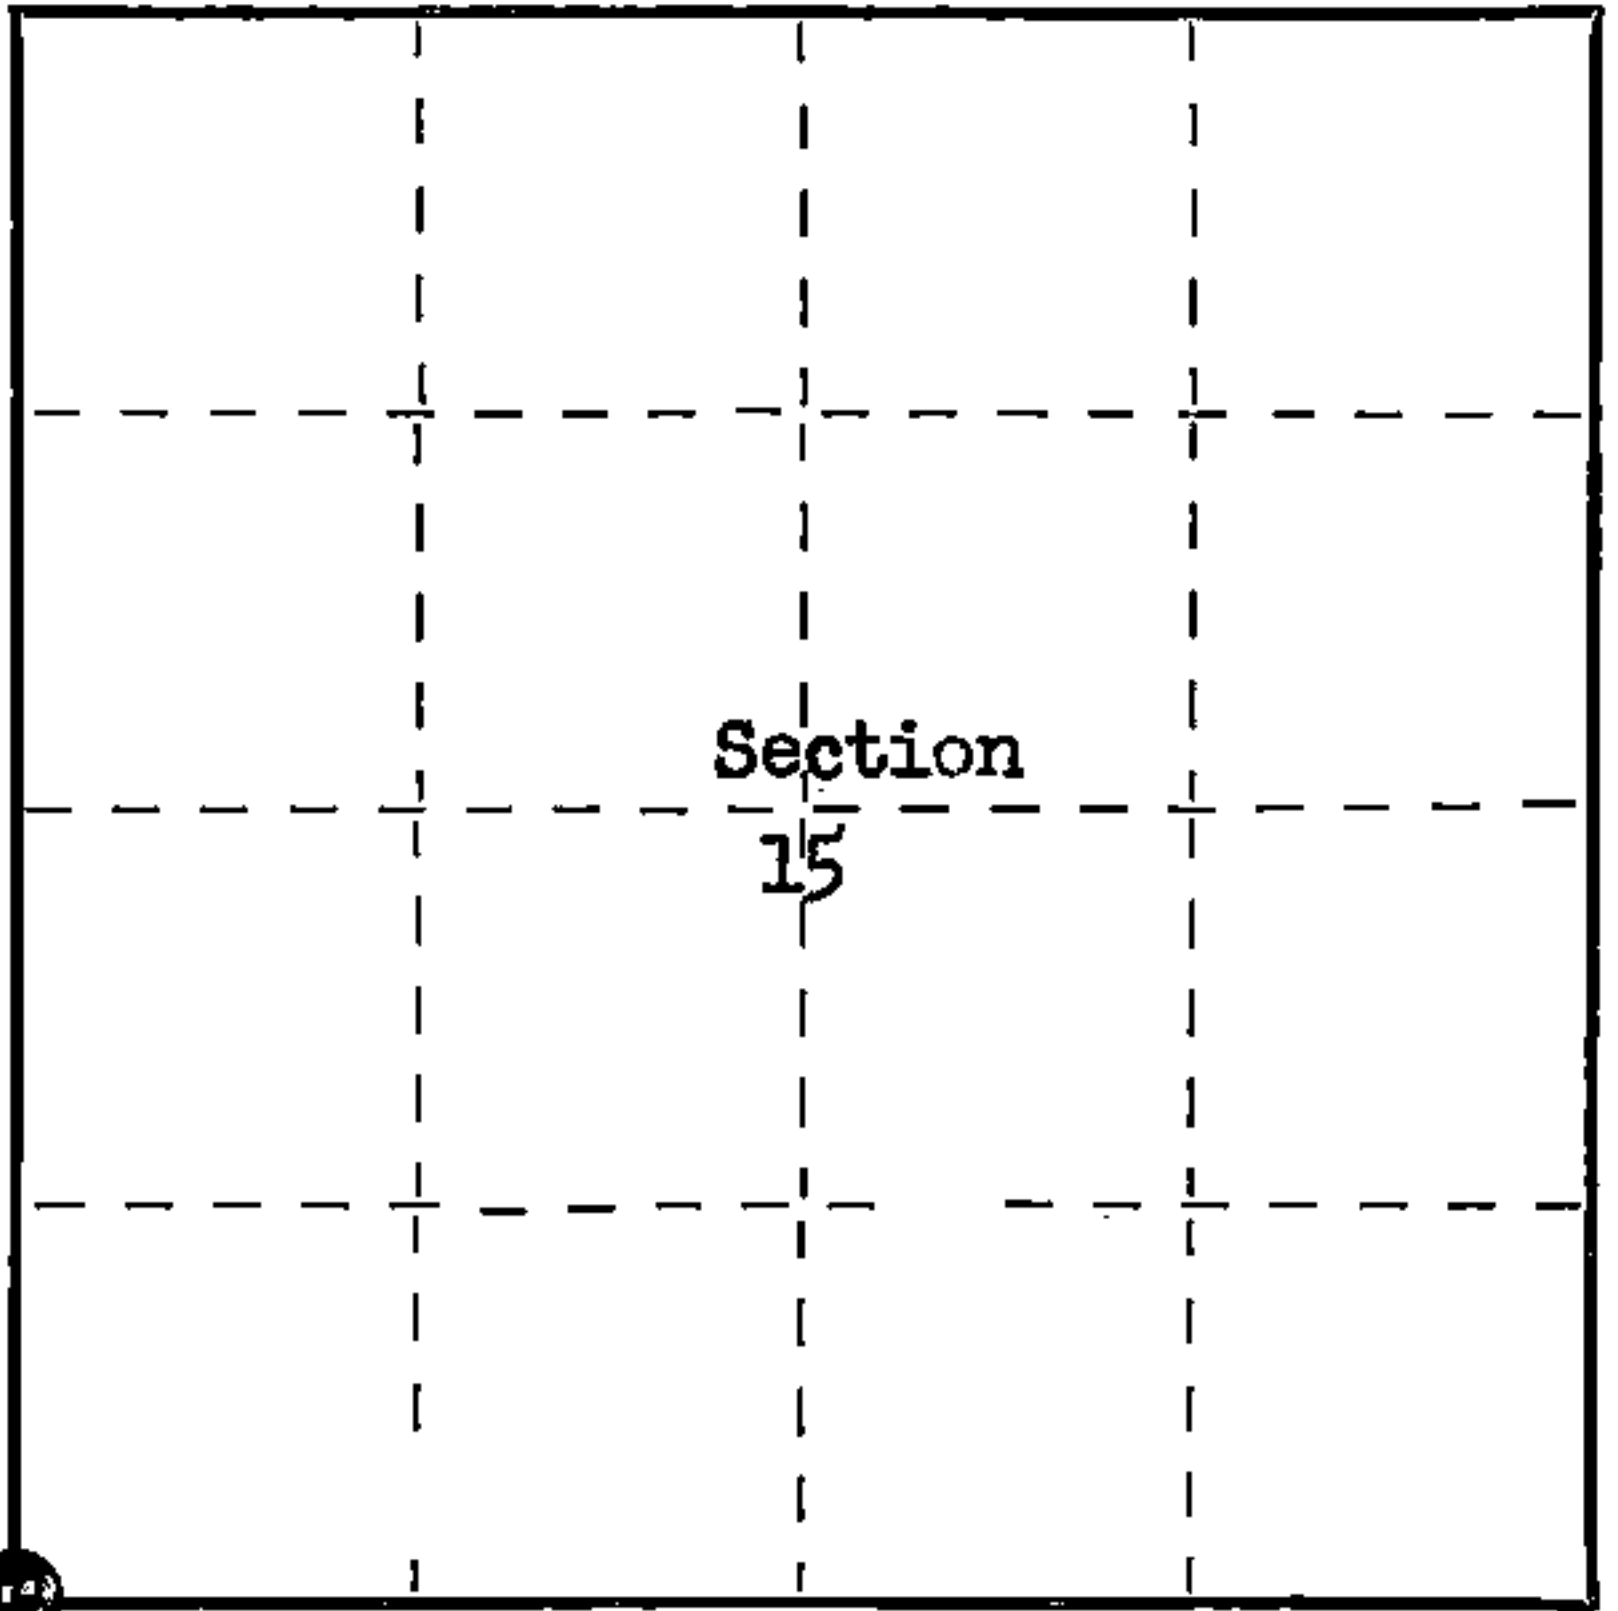

○ = Corner monument restored.

History of original corner establishment:  
Survey 1859 by Wm. E. Daugherty. Dependent Resurvey in 1941 by Guy R. Veal  
From remains of original bearing trees set concrete monument, 2 ft. long, 6 in. diam. with  
iron post, 22 in. long 1 in. diam., encased therein with brass cap marked:

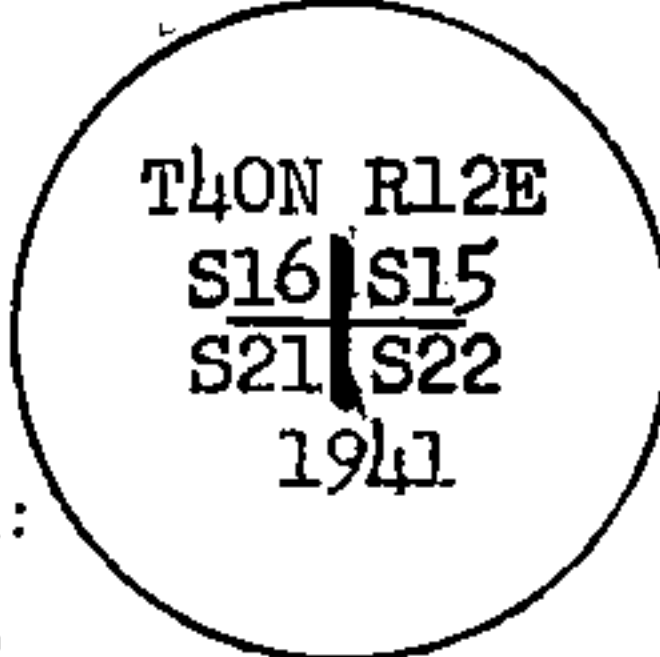

From which:  
Hemlock 10", bears, N3°45'E, 108 lks.  
Hemlock 10", bears, S19°15'E, 21 lks.  
Hemlock 15", bears, S25°15'W, 83 lks.  
Maple 10", bears, N24°W, 27½ lks.

Description of corner evidence found:  
Monument found as described:  
Hemlock 18" snag, N3°45'E, 71.6 ft.  
Hemlock 11" snag, S19°E, 14.2 ft.  
Hemlock 21", S25°15'W, 55.00 ft.  
Maple 17", N24°W, 18.00 ft.

Description of ~~monument and~~ accessories I established to perpetuate the original location of this corner.  
Blazed and scribed the following new bearing trees:

Maple 7", bears, N29°E, 11.40 ft. (17.27 lks.)  
Maple 8", S75°E, 17.50 ft. (26.52)

Dated at Rhineclander, Wis., this 16th day of August, 1963.

Signature Jean F. Resvick Title Cadastral Surveyor Registration No. S-802  
(County Surveyor, Registered Land Surveyor, or other duly authorized official)

Office of Register of Deeds, County of Forest, I hereby certify that the within  
instrument was filed in this office for record on the 4 day of November, 1963  
at 9:00 o'clock A M.

Anna Peterson  
(Register of Deeds)

87831

By \_\_\_\_\_ Deputy

FORM 985 H. G. MILLER CO., MILWAUKEE

44612160000