


CERTIFIED LAND CORNER RESTORATION

State of Wisconsin }  
County of Forest } ss.

I, Jean F. Resvick, do hereby certify that on the 8th day of March, 1967, I found evidence of the East quarter corner of Section 16 Township 40 North, Range 12 East, Fourth Principal Meridian, as described hereon; and that from this evidence I established a new monument and accessories as described hereon to perpetuate the original location of this corner:

Description of original monument and accessories and subsequent restorations:

Original survey in 1859. Dependent resurvey in 1941 by Guy R. Veal. Set concrete monument, 2 ft. long, 6 ins. diameter, with iron post 22 ins. long, 1 in. diameter encased therein, with brass cap marked:

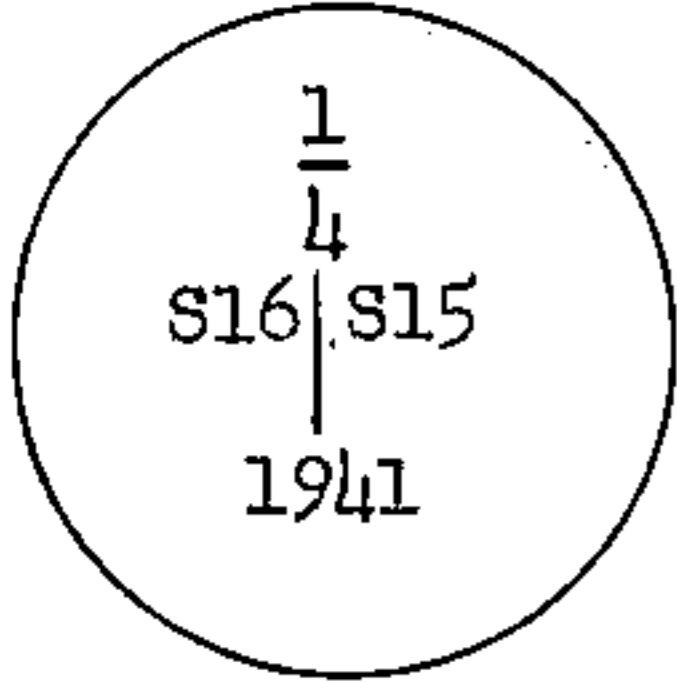

from which the following bear:


Maple 5 ins., N29°30' E, 31 lks.  
Maple 6 ins., N35°W, 47 lks.

Description of corner evidence found:


Monument found as described above.  
Maple 7 ins., bears N35°W, 31.02 feet.  
Other bearing tree would fall in power line clearing.

Description of ~~monument and~~ accessories I established to perpetuate the original location of this corner:

Blazed and scribed the following new bearing trees:  
White birch 6 ins., bears S80°E, 53.6 ft. or 81.2 lks.  
Power pole, number 4012-16E19, bears N29°E, 28.4 ft. or 43 lks.  
Set 4x4 cedar post one foot east of monument.

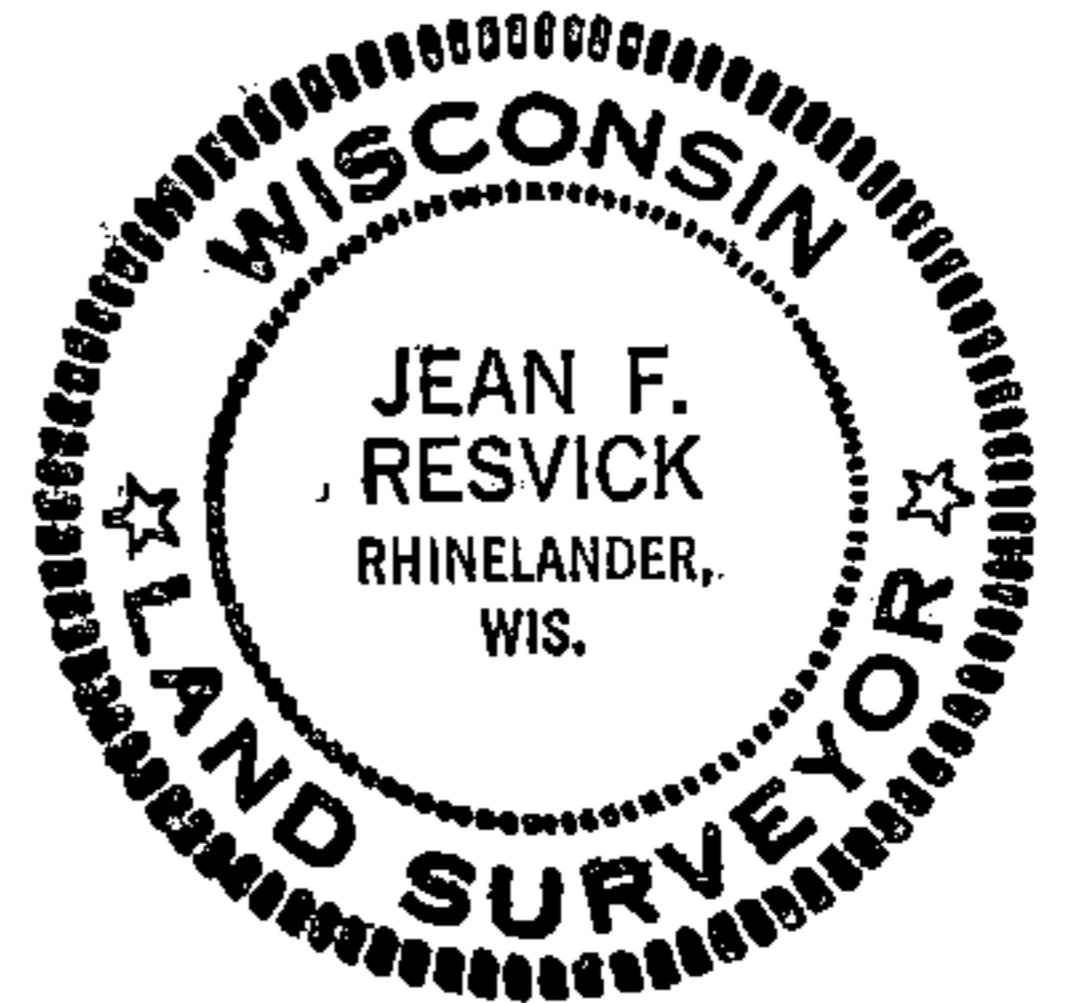

44012162000

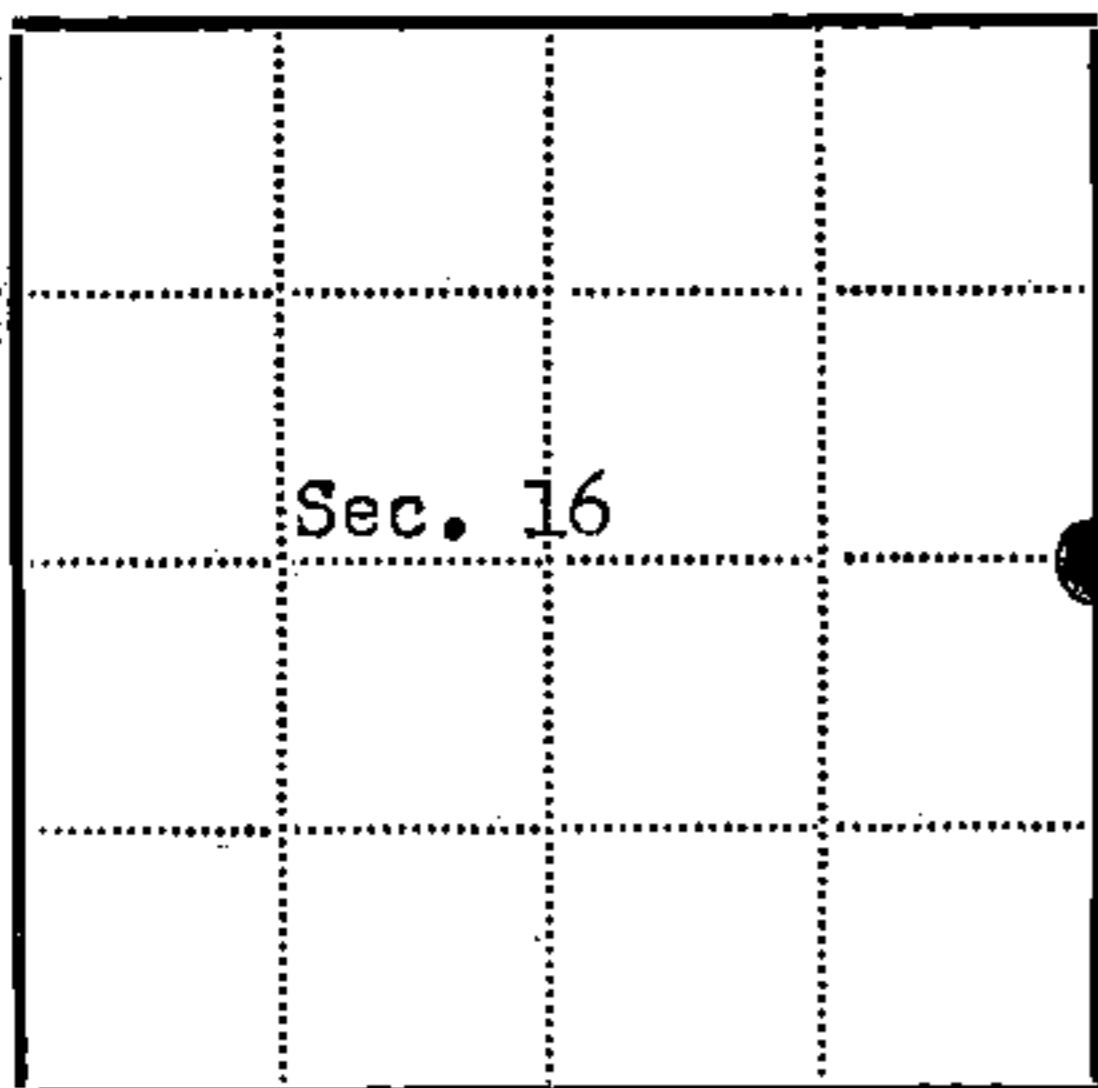

● = Corner monument restored  
□ =

Resident witnesses.....

Dated at Rhinelander, Wisconsin, this 21st day of March 1967....

Signature Jean F. Resvick Title Cadastral Surveyor  
(County Surveyor, Registered Land Surveyor, or other duly authorized official)

Surveyors Registration No. S-802 DOC.# 94216

Office of Register of Deeds County of Forest

I hereby certify that the within instrument was filed in this office for record on the 27th day of February 1968, and was filed in Book No. I Page No. of County Records.

Signature Eugene Staszynski Title Register of Deeds

Township 40 North, Range 12 East, Section 16, Index No. L-13, Page No.

113