

CERTIFIED LAND CORNER RESTORATION


Index No. L-9  
L 9

State of Wisconsin }  
County of Forest } ss.

I Jean F. Resvick, do hereby certify that on the 31st day of May, 1963, I found evidence of the quarter corner of Section 16 and 17 Township 40, North, Range 12 East, Fourth Principal Meridian, as described hereon; and that from this evidence I established a new monument and accessories as described hereon to perpetuate the original location of this corner.

Resident witnesses:


.....  
.....  
.....

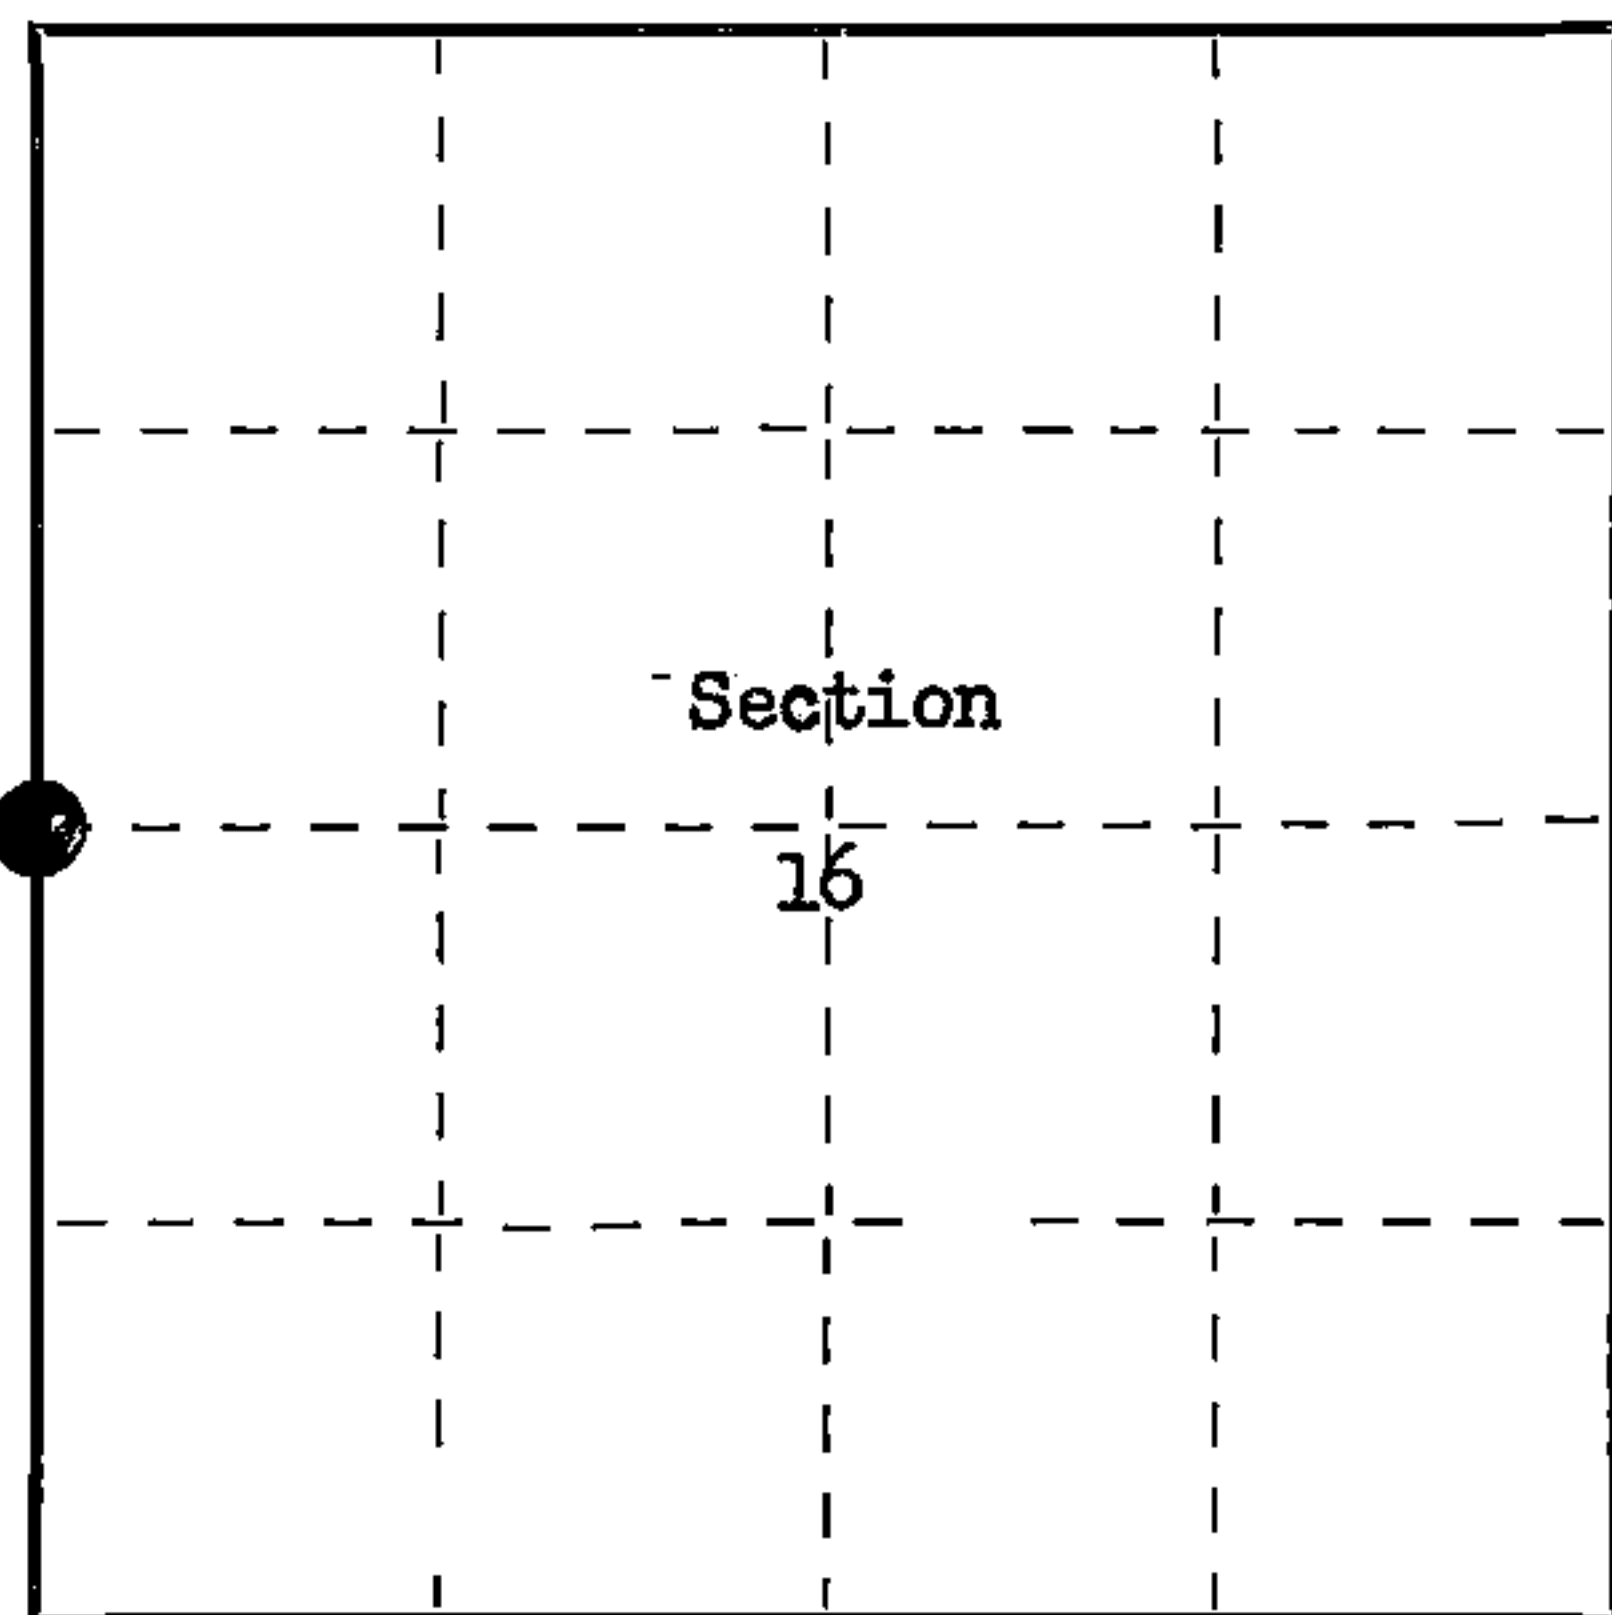

○ = Corner monument restored.

History of original corner establishment:

Surveyed in 1859 by Wm. E. Daugherty. Dependent Resurvey in 1941 by Guy R. Veal. Set Iron post, 3 ft. long, 2 in. diam., 27 in. in the ground, with brass cap marked:

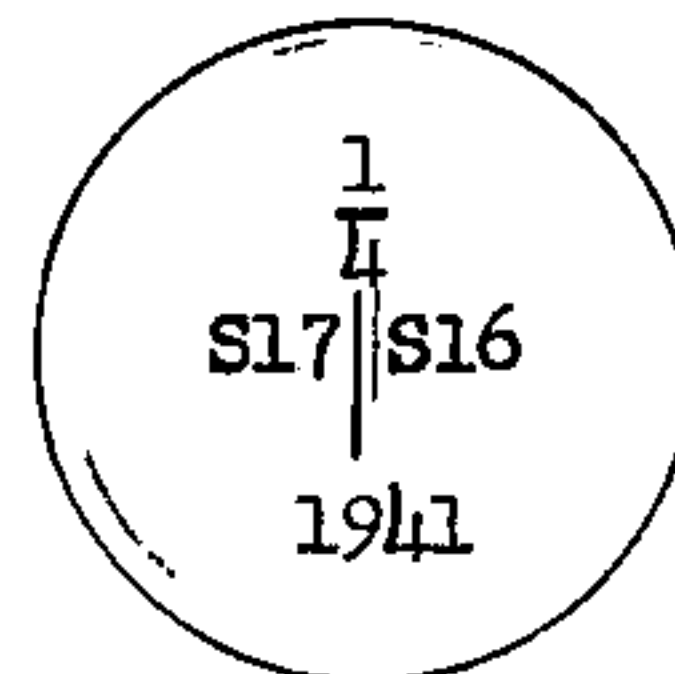

From which: poplar 6" bears S27°E, 93 1/2 lks.  
poplar 7" bears S84°W, 90 1/2 lks.

Description of corner evidence found:

Monument marked as described:

Poplar 9", S84°W, 59.45 ft.  
Poplar stump scribed B.T., S27°E, 61.71 ft.

Description of ~~monument~~ and accessories I established to perpetuate the ~~original~~ location of this corner.

Blazed and scribed the following new bearing trees:

W. pine 6", S11°E, 62.55 ft. (94.77 lks.)  
W. pine 7", N55°W, 30.20 ft. (45.76 lks.)

Dated at Rhineland, Wis., this 16th day of August, 1963.

Signature Jean F. Resvick Title Cadastral Surveyor Registration No. S-802  
(County Surveyor, Registered Land Surveyor, or other duly authorized official)

Office of Register of Deeds, County of Forest, I hereby certify that the within instrument was filed in this office for record on the 4 day of November, 1963 at 9:00 o'clock A. M.

Anna Peterson  
(Register of Deeds)

87832

By..... Deputy

FORM 985 H. C. MILLER CO., MILWAUKEE

440121720000