

CERTIFIED LAND CORNER RESTORATION

State of Wisconsin

County of Forest

ss.

I Jean F. Resvick, do hereby certify that on the 15 day of May, 1974, I found evidence of the East quarter corner of Section 18 Township 40 North, Range 12 East, Fourth Principal Meridian, as described hereon; and that from this evidence I established a new monument and accessories as described hereon to perpetuate the original location of this corner:

Description of original monument and accessories and subsequent restorations:



Original survey in 1859
Dependent resurvey in 1941 by Guy R. Veal
Proportionate position set iron post, 3 feet long, 2 inch diameter, with brass cap marked 1/4, S18, S17, 1941
Poplar 6, bears N63E, 23 1/2 lks.
Poplar 6, bears N82W, 12 lks.
County trunk "A" south 10.75 chains

Description of corner evidence found:

Monument as described above.
Aspen stump, scribed bears N63E, 23 1/2 lks.
Aspen stump, scribed bears N82W, 12 lks.
State Highway 70, south 10.75 chains

Description of ~~monument and~~ accessories I established to perpetuate the location of this corner:

Blazed and scribed the following new bearing trees
Maple 5, bears N75E, 8.66 feet
Maple 6, bears S1E, 18.06 feet
Seet steel sign post 0.5 feet north of monument.

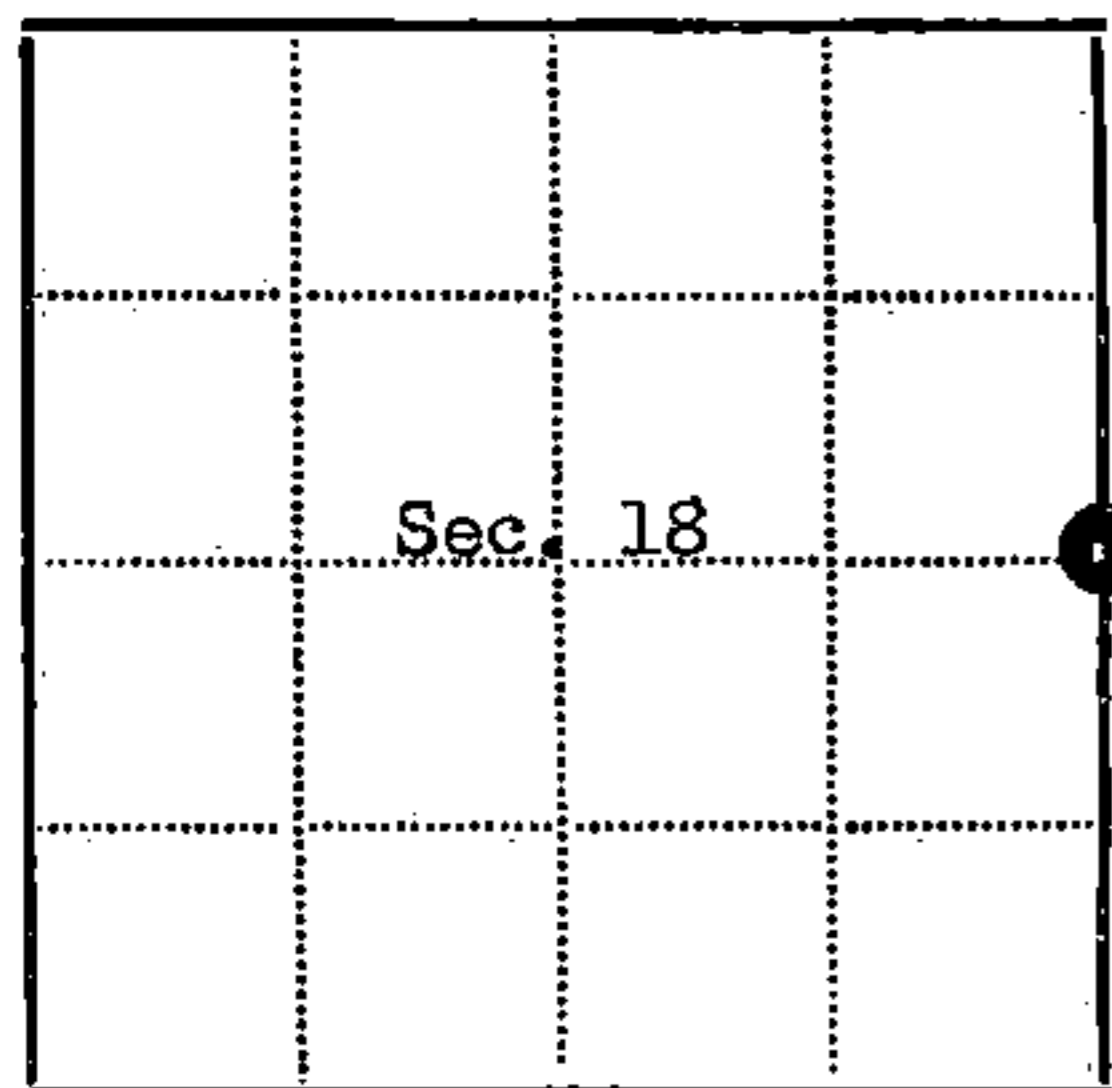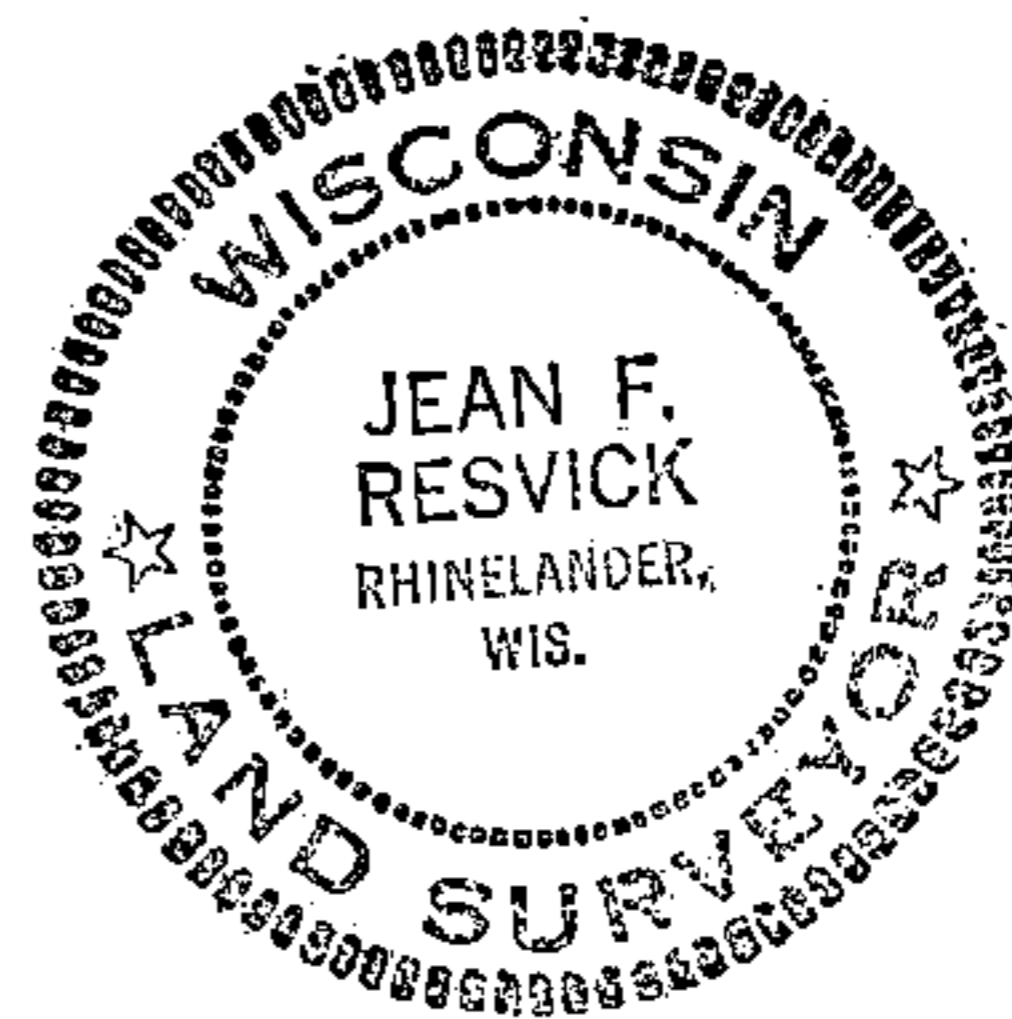

Legend: Circle with dot = Corner monument restored; Square =

Resident witnesses

Dated at Rhinelander Wisconsin, this 10 day of June 1974.

Signature Jean F. Resvick Title Land Surveyor
(County Surveyor, Registered Land Surveyor, or other duly authorized official)

Surveyors Registration No. 5-802 DOCUMENT NUMBER 105822

Office of Register of Deeds County of Forest

I hereby certify that the within instrument was filed in this office for record on the 8th day of August 1974, and was filed in Book No. Corner Restorations Page No. L-5 of County Records.

Signature Eugene Stegny Title

Township 40 North, Range 12 East, Section 18, Index No. L-5, Page No.

440121 82000

Handwritten number 5