

CERTIFIED LAND CORNER RESTORATION

State of Wisconsin }  
County of Forest } ss.

I Jean F. Resvick, do hereby certify that on the 21st day of April, 1971, I found evidence of the East Meander corner of Section 21 & Section 28 Township 40 North, Range 12 East, Fourth Principal Meridian, as described hereon; and that from this evidence I established a new monument and accessories as described hereon to perpetuate the original location of this corner:

Description of original monument and accessories and subsequent restorations:

Surveyed in 1859 by William E. Daugherty. East between Section 21 & 28, 62.36 chains, set M.C. post.

Fir 8, N60W, 6 lks.

Fir 6, S50W, 27 lks.

Dependent resurvey in 1941 by Guy R. Veal. S89°31'E, 22.85 chains from quarter between Section 21 & 28 to old shoreline of lake. Set iron post, 3 feet long, 2 inches in diameter, 27 inches in the ground, for meander corner of Section 21 & 28 with brass cap marked, T40N, S21, MC, S28, R12E, 1941 from which, A yellow birch, 14" diam., bears S39W, 23½ lks. Yellow birch, 5" diam., bears N27°45'W, 18 lks. A local meander post, which is a cedar post

Description of corner evidence found: 4" square, 4' long, set 1' in the ground, marked MC, bears S89°31'E, 98 lks. distance over low wet land to present lake shore.

Monument found as described.

Yellow Birch 18, bears S39W, 15.27 feet

Yellow Birch 8, dead, bears N27°45'W, 11.90 feet.

Description of monument and accessories I established to perpetuate the original location of this corner:


Blazed and scribed the following new bearing tree.

Black Ash 14, bears N84E, 13.88 feet

Set steel sign post 1 foot north of monument.



44012210008

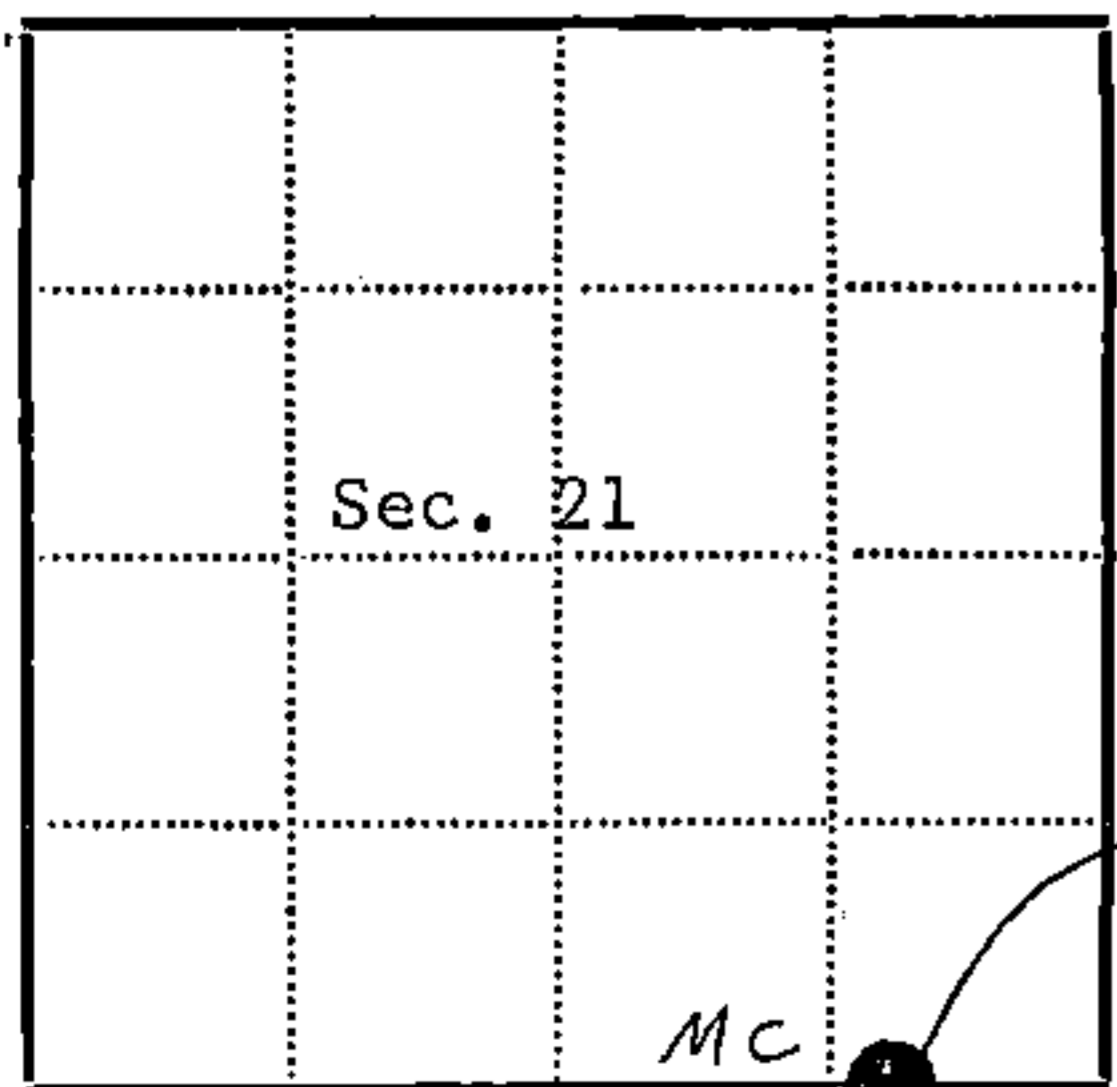

● = Corner monument restored  
□ =

Resident witnesses.....

Dated at Rhinelander Wisconsin, this 30th day of April 1971.....

Signature Jean F. Resvick Title Land Surveyor  
(County Surveyor, Registered Land Surveyor, or other duly authorized official)

Surveyors Registration No. S-802 DOCUMENT NUMBER 99718

Office of Register of Deeds County of Forest

I hereby certify that the within instrument was filed in this office for record on the 25th day of May 1971, and was filed in Book No. 1 Page No. R-12 of County Records.

Signature..... Title Register of Deeds

Township 40 North, Range 12 East, Section 21, Index No. R-12, 13, Page No.

R12, 13