

CERTIFIED LAND CORNER RESTORATION

State of Wisconsin

County of Forest

ss.

I Jean F. Resvick, do hereby certify that on the 3rd day of October, 1973, I found evidence of the North Quarter corner of Section 27 Township 40 North, Range 12 East, Fourth Principal Meridian, as described hereon; and that from this evidence I established a new monument and accessories as described hereon to perpetuate the original location of this corner:

Description of original monument and accessories and subsequent restorations:



Original survey in 1859 by William E. Daugherty
Dependent resurvey in 1941 by Guy R. Veal
At proportionate distance set iron post, 3 feet long, 2 inch diameter with brass cap marked S22, 1/4, S27, 1941
White Birch 7, S60E, 38 lks.
Yellow Birch 5, N46°30'W, 8 lks.
Meander Corner N85°12'E, 1.23 chains

Description of corner evidence found:

Monument as described above.
White birch 12, N55E, 18.0 feet, scribed
White Birch 9, S80E, 25.60 feet, scribed.
From a point located S83°W, 28 feet from monument as found, a White Birch bears S60°E, 38 lks. and a Yellow Birch bears N47°W, 8 lks.
These 2 trees had been blazed, no scribing was found.
Meander corner bears N85°12'E, 81.2 feet from monument.

Description of monument and accessories I established to perpetuate the location of this corner:

It is considered quite apparent that the quarter corner position was adjusted in the 1941 survey. The monument was moved and bearing tree cut out. New bearing trees were made at the new location but not recorded. The distance between meander corners and quarter corner checking. I accept the monument as found. Set steel sign post near monument.

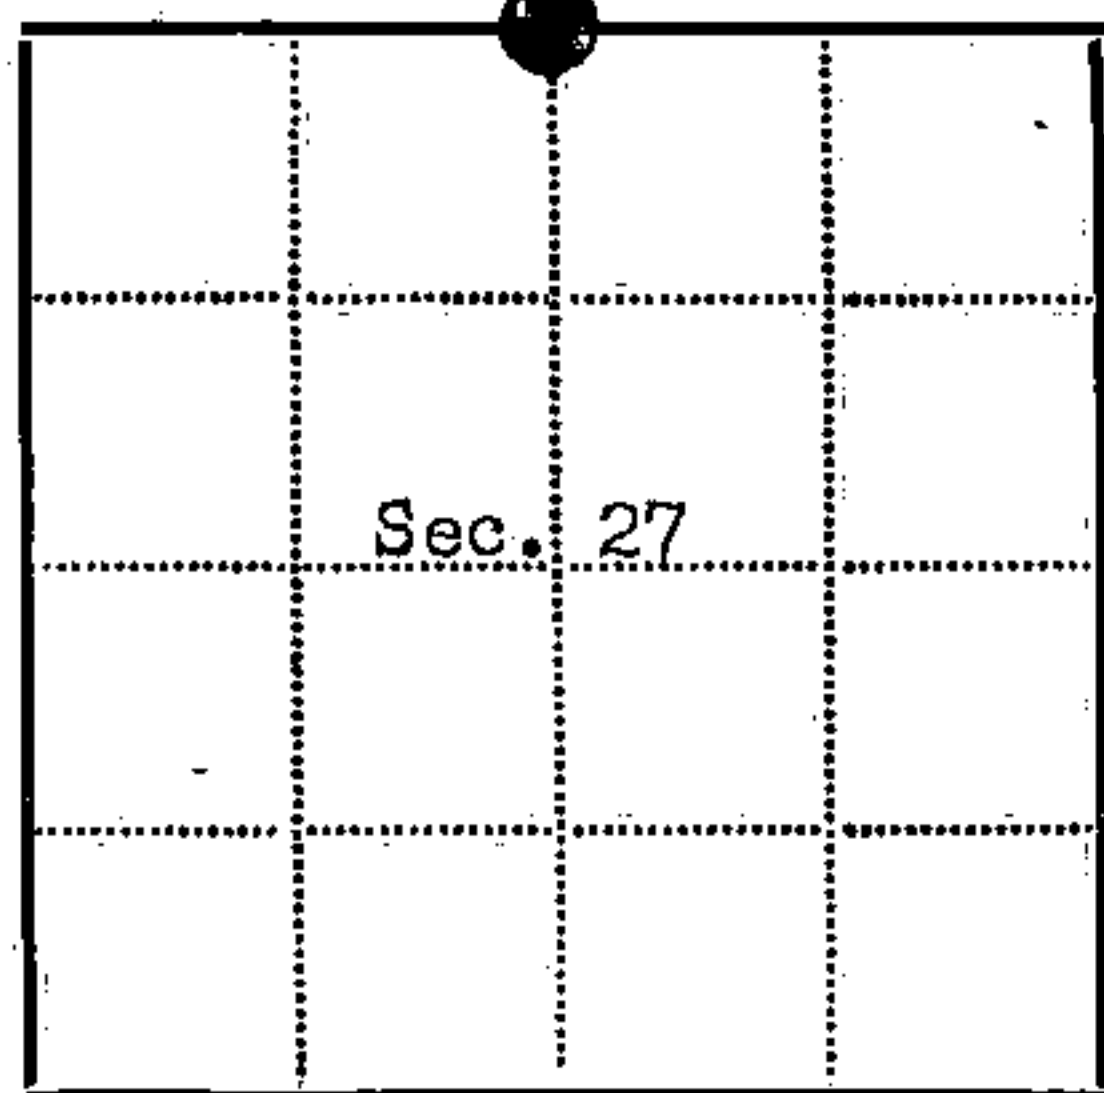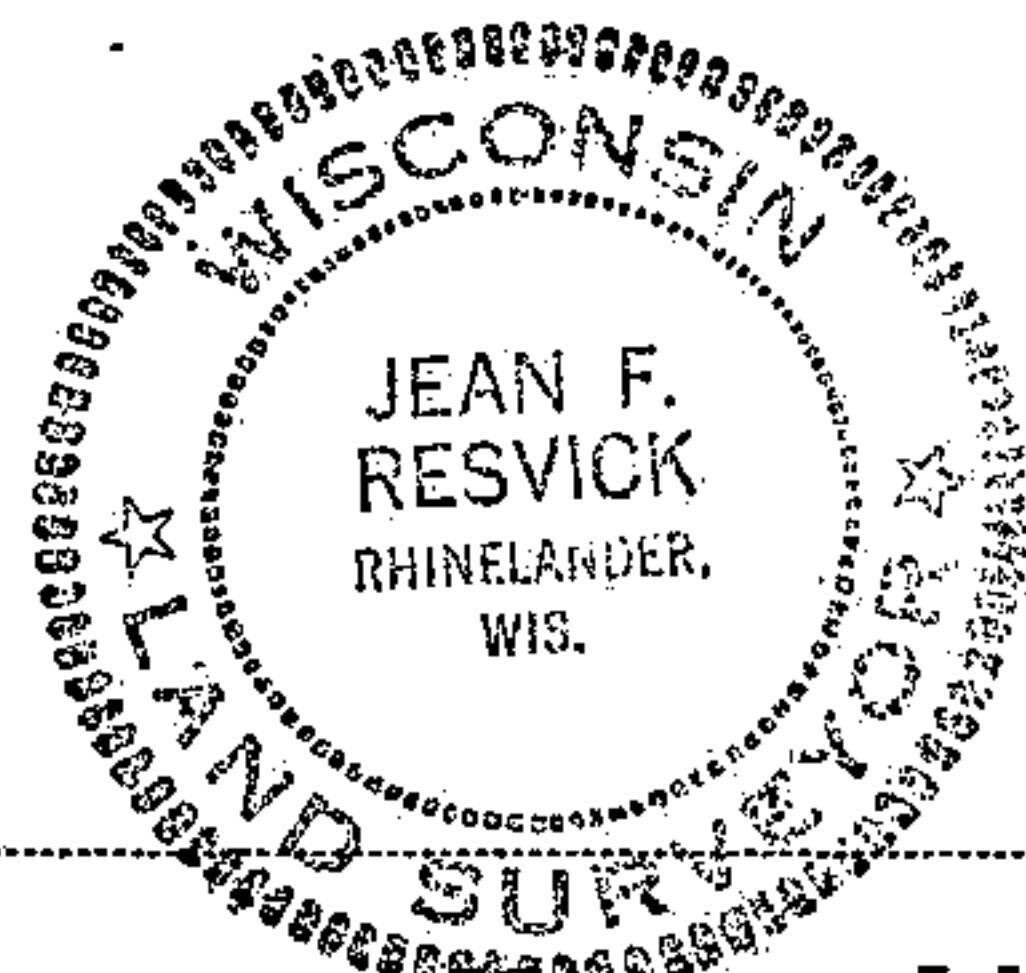

Legend:
● - Corner monument restored
□ -

Resident witnesses

Dated at Rhinelander Wisconsin, this 11 day of July 1974.

Signature Jean F. Resvick Title Land Surveyor
(County Surveyor, Registered Land Surveyor, or other duly authorized official)

Surveyors Registration No. S-802 DOCUMENT NUMBER 105823

Office of Register of Deeds County of Forest

I hereby certify that the within instrument was filed in this office for record on the 8th day of August 1974, and was filed in Book No. Corner Page No. R-15 of County Records. Restorations

Signature Eugene Staszny Title

Township 40 North, Range 12 East, Section 27, Index No. R-15, Page No.

44012220020

R15