

CERTIFIED LAND CORNER RESTORATION

State of Wisconsin

County of Forest

ss.

I, William B. Cochrane, do hereby certify that on the 7th day of May, 1975, I found evidence of the southeast section corner of Section 26 Township 40 North, Range 12 East, Fourth Principal Meridian, as described hereon; and that from this evidence I established a new monument and accessories as described hereon to perpetuate the original location of this corner:

Description of original monument and accessories and subsequent restorations:


Dependent resurvey of 1941 by Guy R. Veal. At proportionate distance, set a concrete monument, 2 feet long, 6 inches diameter, 20 inches in the ground, for corner of Sections 25, 26, 35 and 36 with a brass cap marked: T40N, R12E, S25, S26, S35, S36, 1941. From which the following bear: Hemlock, 5", N34°E, 43 lks. Maple, 7", S72°E, 128 lks. Maple, 24", S6°45'W, 149 lks. Maple, 6", N70°45'W, 117 lks.

Description of corner evidence found:


Found the monument as described and in place. No evidence of the hemlock. Maple, 13" stump, S68°E, 128 lks. overgrowth. Maple, 30" stump snag, S7°W, 149 lks. Maple, 12" tipout, N71°W, 117 lks. scribed.

Description of monument and accessories I established to perpetuate the location of this corner:

Blazed and scribed the following new bearing trees: Maple, 8", N34°W, 23.11 ft. Maple, 9", N66°E, 31.00 ft. Maple, 8", S38°E, 18.61 ft. Maple, 9", S56°W, 23.70 ft. Set a steel line post, southeast, 0.40 ft.

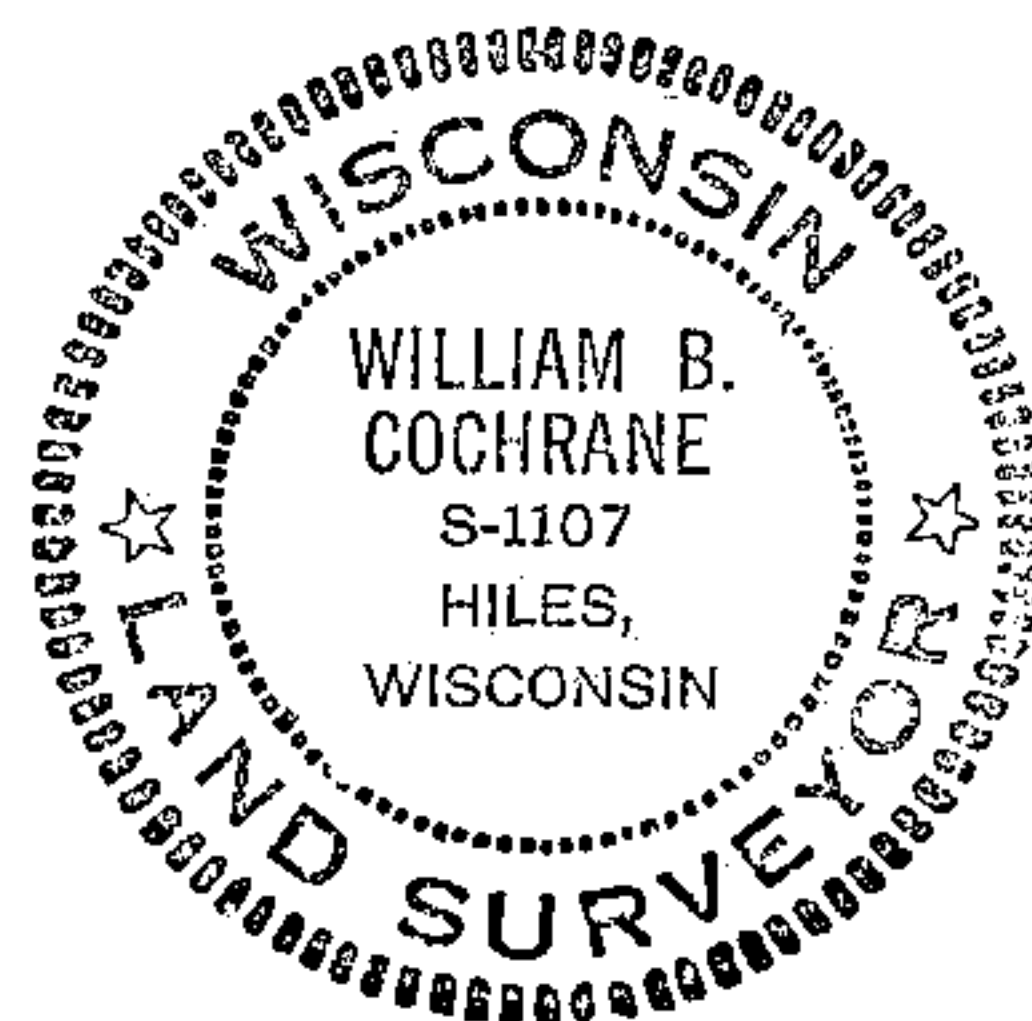

44012260007

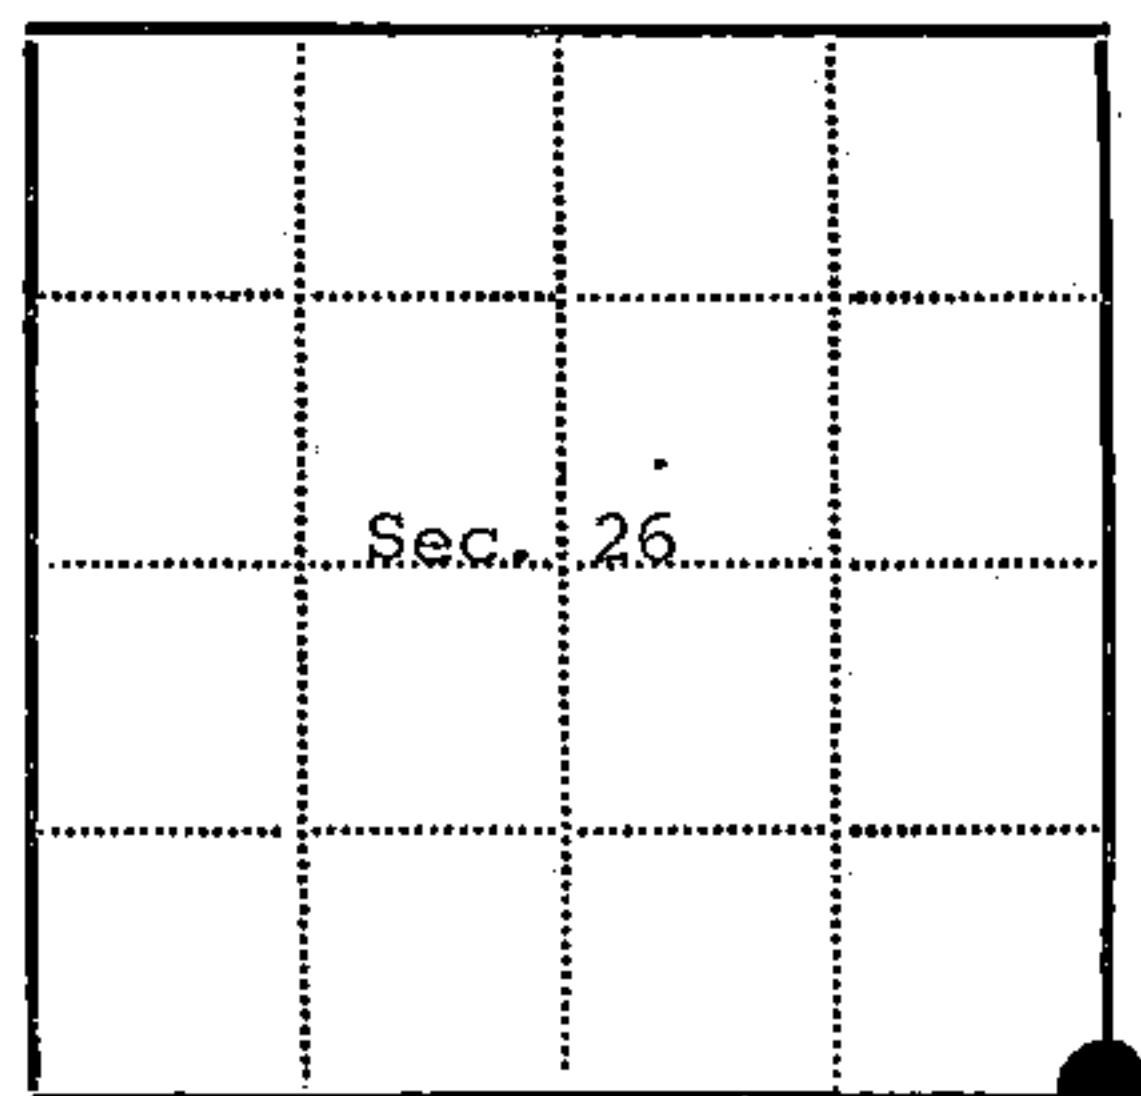

● = Corner monument restored □ =

Resident witnesses.....

Dated at Three Lakes Wisconsin, this 7th day of May 1975....

Signature William B. Cochrane Title Survey Technician (County Surveyor, Registered Land Surveyor, or other duly authorized official)

Surveyors Registration No. S-1107 DOCUMENT NUMBER 107238

Office of Register of Deeds County of Forest

I hereby certify that the within instrument was filed in this office for record on the 16th day of June 1975, and was filed in Book No. Page No. of County Records.

Signature Eugene Staszny Title Register of Deeds

Township 40 North, Range 12 East, Section 26, Index No. V-21, Page No.

V21