

CERTIFIED LAND CORNER RESTORATION

State of Wisconsin }
County of Forest } ss.

I, Jean F. Resvick, do hereby certify that on the 28 day of June, 1977, I found evidence of the Northeast Section corner of Section 1 Township 39 North Range 12 East, Fourth Principal Meridian, as described hereon; and that from this evidence I established a new monument and accessories as described hereon to perpetuate the original location of this corner:

Description of original monument and accessories and subsequent restorations:



Surveyed in 1858 by Alfred Millard
Dependent resurvey in 1941 by Guy R. Veal
From remains of original evidence which was a stump hole bearing N18E, 32 lks. and a 24 inch pine stump bears S62E, 26 lks.
Set a concrete monument 2 feet long 12 inches in diameter at bottom and 8 inches on top with brass cap marked T40N, R12E, R13E, S36, S31, S1, S6, T39N, 1941
Yellow birch 14, bears N61°15"E, 556 lks.
White pine 8, bears S49°45"E, 499 lks.
White pine stump, 30, bears S42°45"W, 22 lks.
White pine stump, 30, bears N9°15"W, 50 lks.

Description of corner evidence found:

Monument as described above.
White pine stump bears S62E, 17.2 ft.
Yellow birch 18, bears N61°15"E, 366.97 ft.
White pine stump and fallen tree, scribed bears S49°45"E, 329.3 ft.
White pine stump 30, scribed, bears S42°45"W, 14.5 ft.
White pine stump, 30, scribed bears N9°15"W, 33 ft.

Description of monument and accessories I established to perpetuate the location of this corner:

Blaze and scribed the following new bearing trees:
Red pine 9, N77E, 6.13 ft.
Red pine 10, S34E, 26.91 ft.
Red pine 10, N25W, 12.56 ft.
Set steel sign post 6 inches east of monument

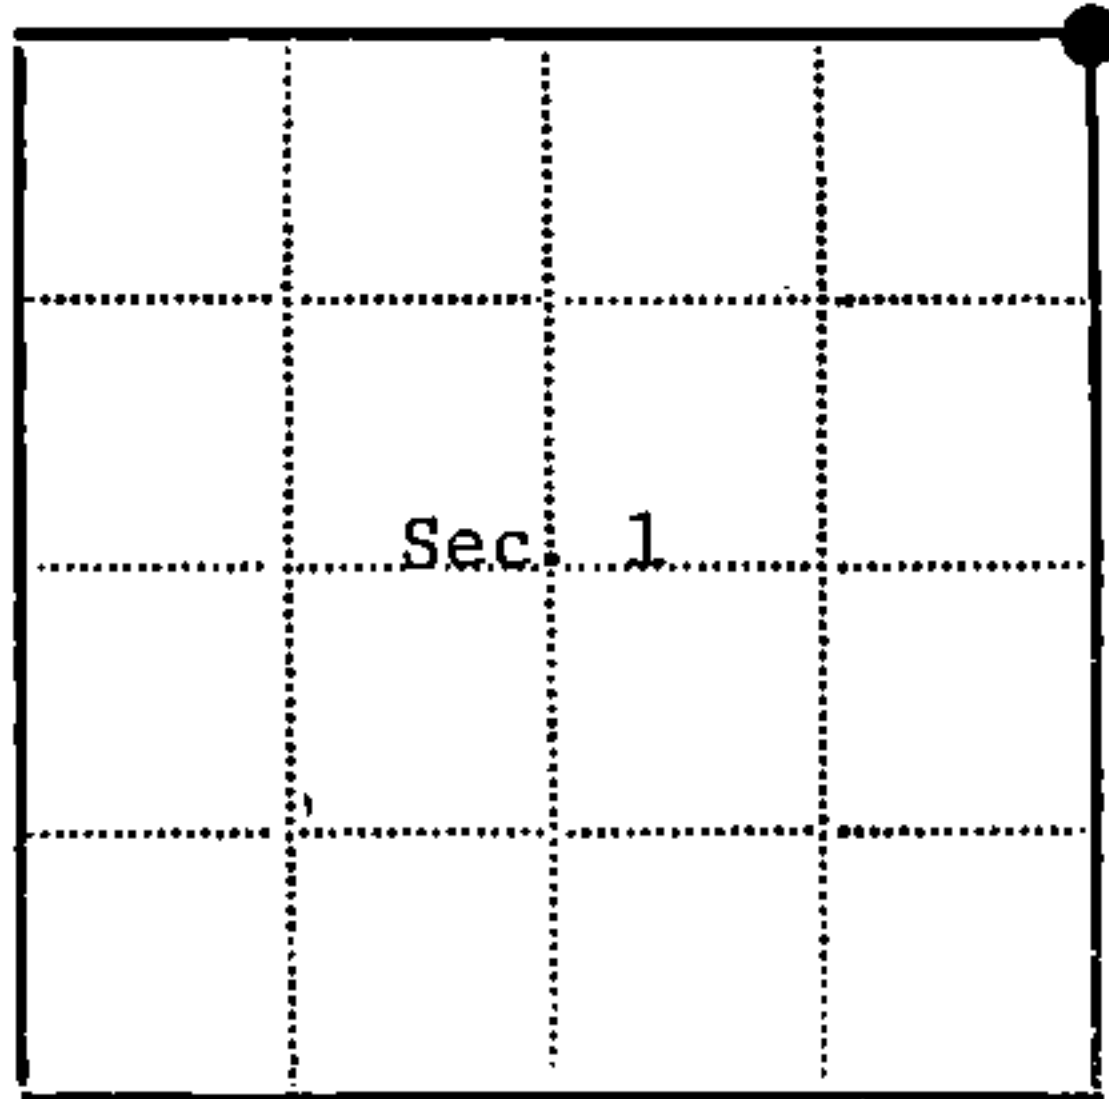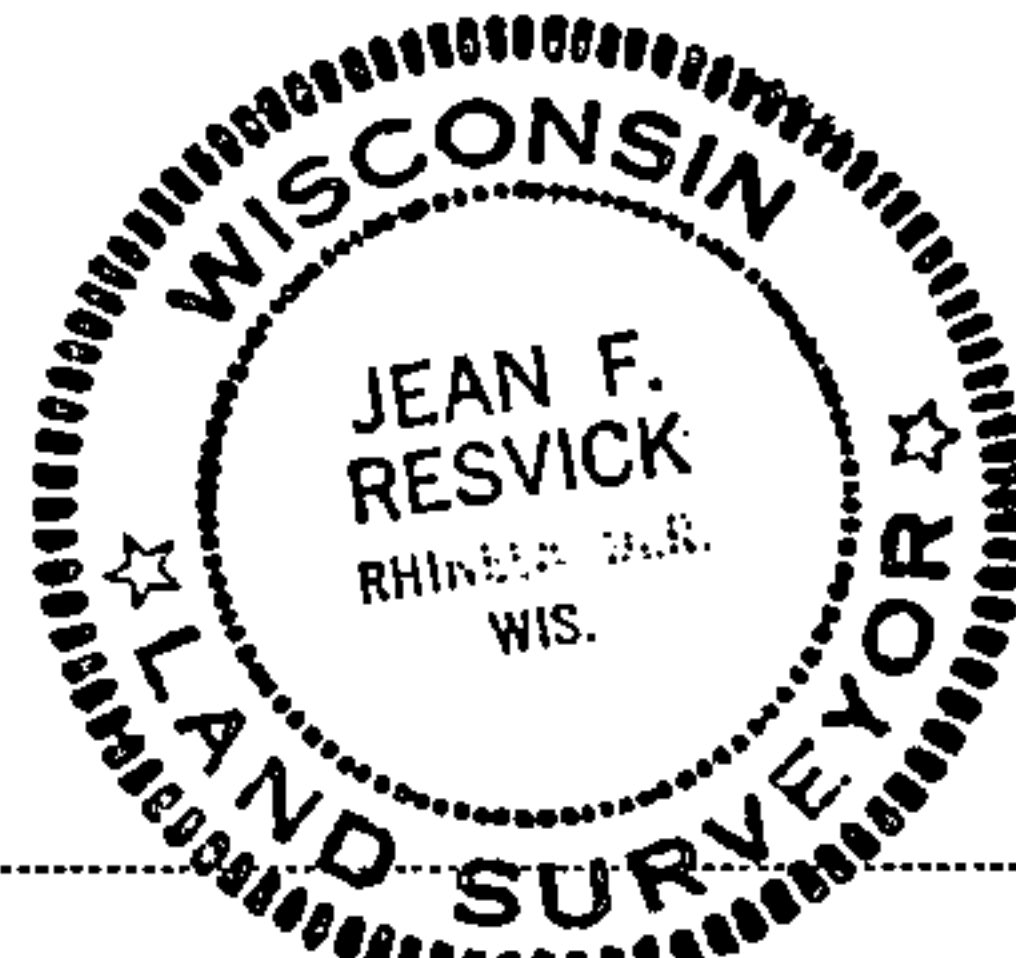

● - Corner monument restored
□ -

Resident witnesses.....

Dated at Rhinelander Wisconsin, this 21 day of July 1977.

Signature Jean F. Resvick Title Land Surveyor
(County Surveyor, Registered Land Surveyor, or other duly authorized official)

Surveyors Registration No. S-802 DOCUMENT NUMBER 113305

Office of Register of Deeds County of Forest

I hereby certify that the within instrument was filed in this office for record on the 13th day of February 1978, and was filed in Book No. Page No. of County Records.

Signature Eugene Stutzman Title Register of Deeds

Township 39 North Range 12 East Section 1 Index No. A-25 Page No.

44012360000

A 25