

U.S. PUBLIC LAND SURVEY MONUMENT RECORD

Index No. C-1

State of Wisconsin }
 County of Forest } ss.

I William B. Cochran, do hereby certify that on the 18th day of August, 1986, I found evidence of the West Quarter corner of Section 6 Township 40, North, Range 14 East, Fourth Principal Meridian, as described hereon; and that from this evidence I established a new monument and accessories as described hereon to perpetuate the original location of this corner.

Resident witnesses:

Tony Tillman

History of original corner establishment:

Original Government Survey in 1858 by Alfred Millard. Dependent Resurvey in 1945 by Hugh B. Crawford. North between Sections 1 and 6, 39.80 chains, found a rotted off Cedar Post. No evidence of original bearing trees was recovered. In place of post, set an iron post, 3 feet long, 27 inches in the ground, with a brass cap mkd; 1/4, S1, S6, 1945. From which the following bear;

Poplar	4"	N42°E	25 lks. (16.50 feet)
Poplar	4"	N44°W	30½ lks. (20.13 feet)


Description of corner evidence found:

Found monument as described and in place. No bearing tree evidence was recovered.

Description of monument and accessories I established to perpetuate the original location of this corner.

Blazed and scribed the following new bearing trees;

Maple	5"	S11°W	27.10 feet
Maple	5"	N42°W	36.40 feet
Steel Sign Post		SW	1.00 feet

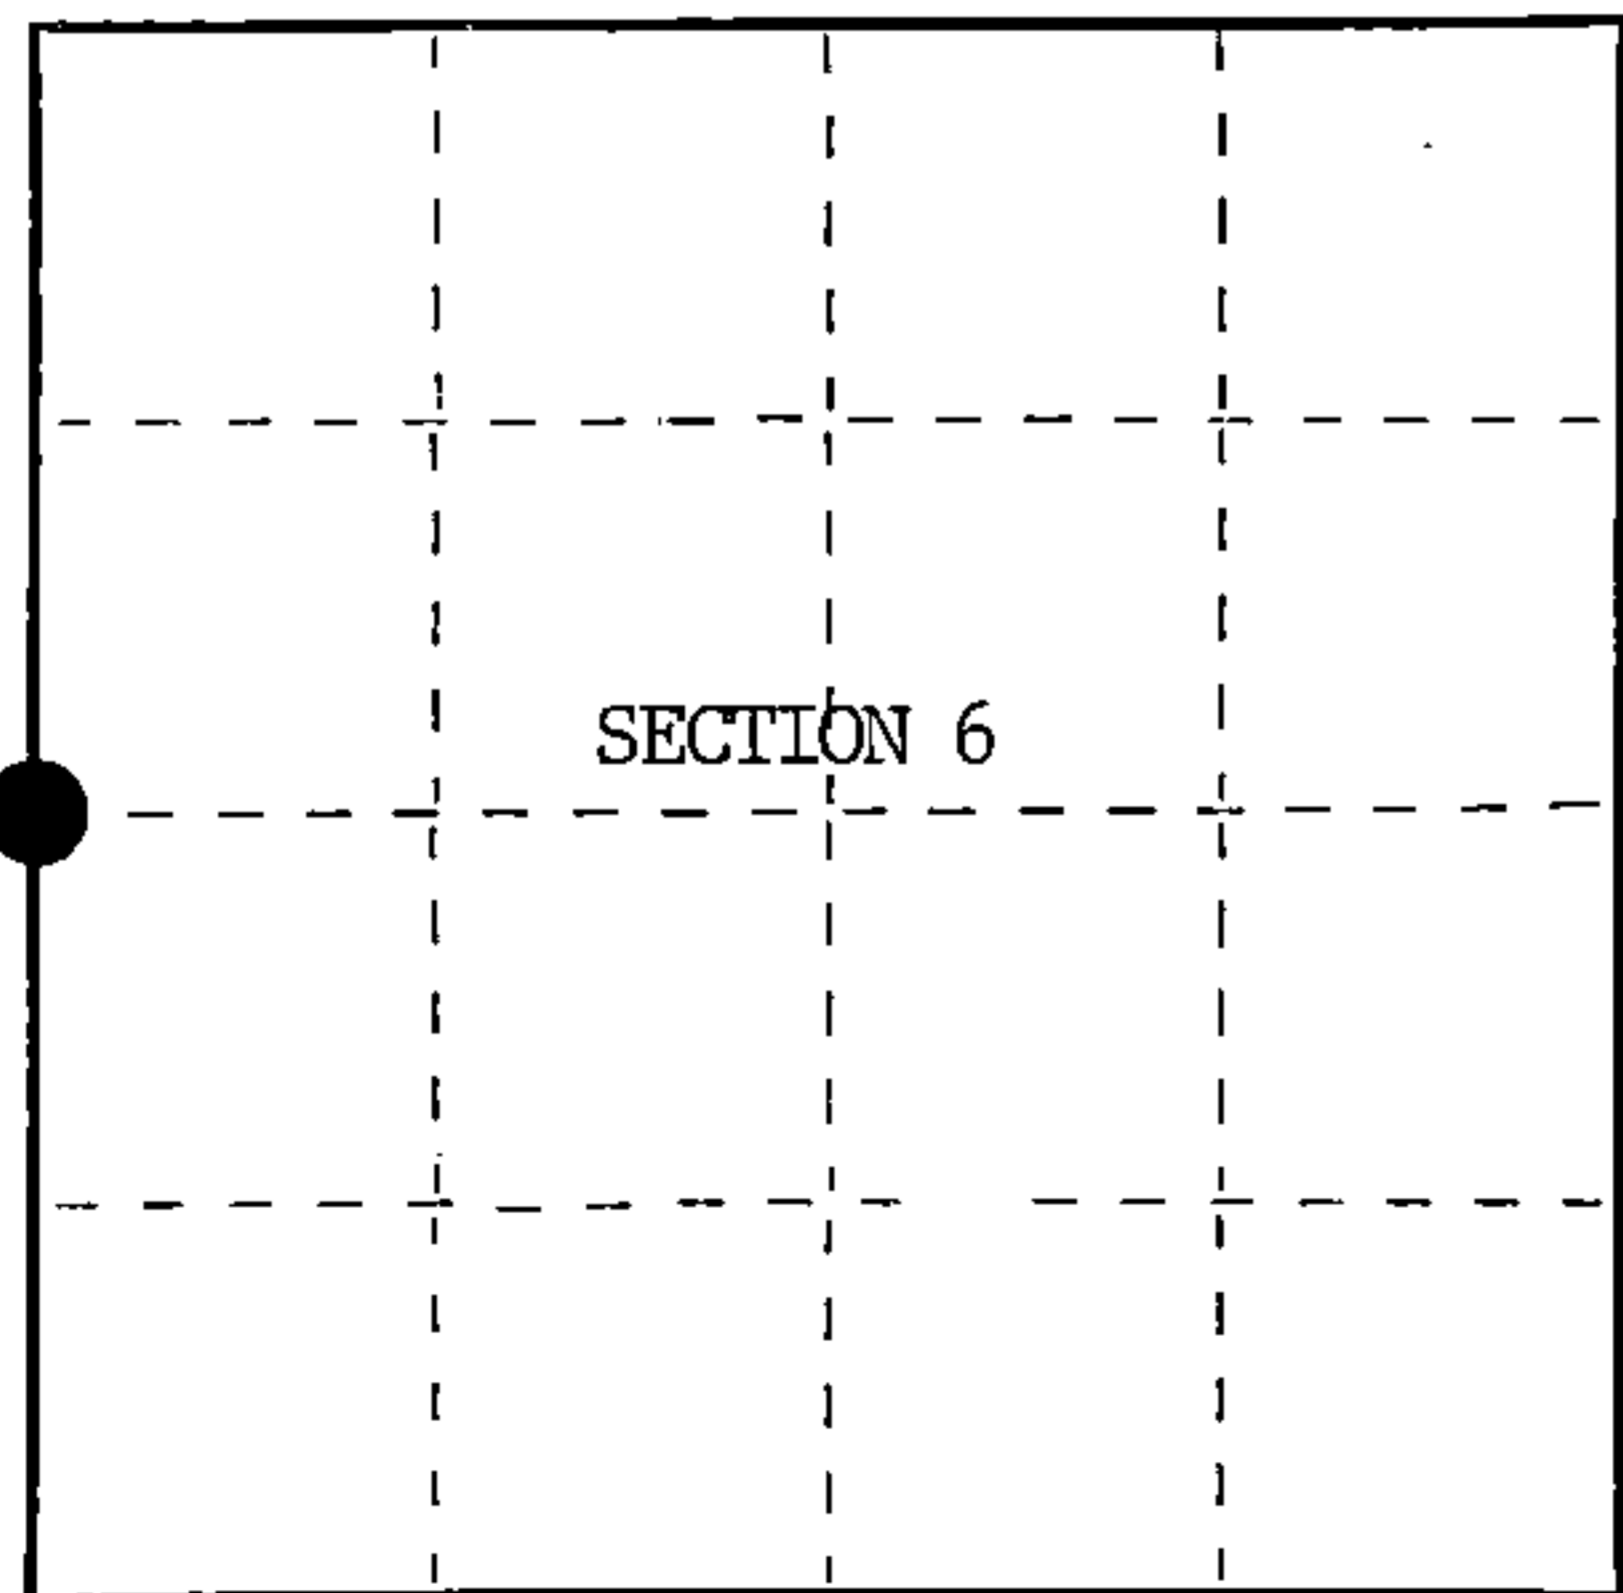

○ = Corner monument restored.

Dated at Hiles, Wis., this 25th day of September, 1986

Signature William B. Cochran Title Land Surveyor Registration No. S-1107
 (County Surveyor, Registered Land Surveyor, or other duly authorized official)

Office of Register of Deeds, County of Forest, I hereby certify that the within instrument was filed in this office for record on the 11th day of March, 1987 at 3:30 o'clock P. M.

Paul Aschenbrenner
 (Register of Deeds)

By.....Deputy

FORM NO. 985-A

H.C. Miller Company

Stock No. 26273

DOCUMENT NUMBER 132435

44813012000

(e) Describe any material discrepancy between the location of the corner as restored or reestablished and the location of that corner as previously restored or reestablished by distance and direction. Show the discrepancy on the plan view drawing under (d), above. Show the distances between the corner as previously restored or reestablished and (1) the corner as restored or reestablished, and (2) to at least 2 of the witness monuments shown on the drawing in (d), above.


See drawing below.

(f) Was the corner restored through acceptance of (1) an obliterated evidence location, or, (2) a found perpetuated location?

Restored through acceptance of a found perpetuated location.


(g&h) Was the corner reestablished through lost corner proportionate methods? If so, show the method, including the directions and distances to other public land survey corners used as evidence or used for proportioning in determining the corner location?

5" Maple
N42°W, 36.40 feet

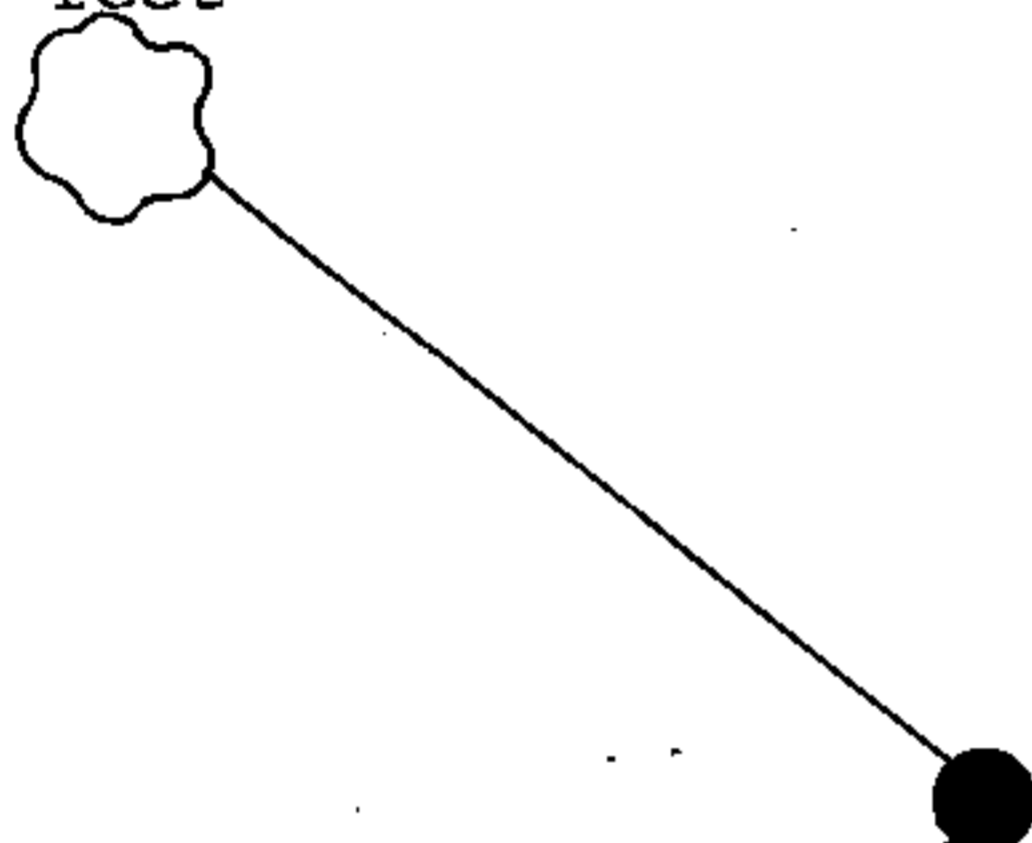

Steel Sign Post
SW, 1.00 feet

5" Maple
S11°W, 27.10 feet

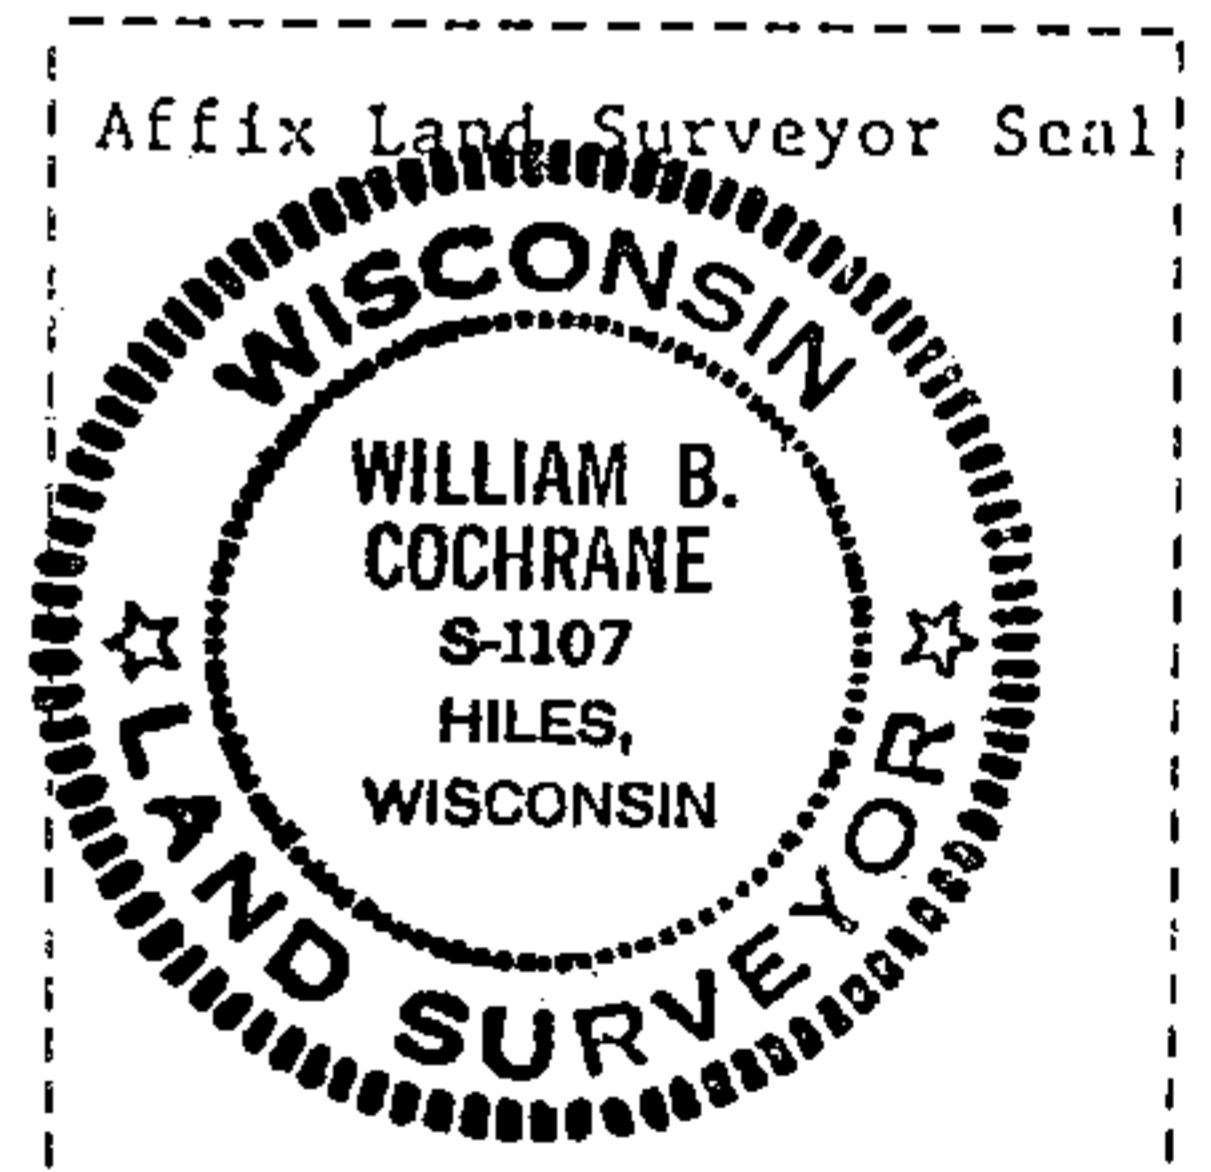

(i) I, William B. Cochrane
(type or print name) certify that the corner location shown on this record was determined by me or under my direction and control and that this U.S. Public Land Survey Monument Record is correct and complete to the best of my knowledge and belief.

William B. Cochrane October 14, 1986
Signature Date

Certificate ready for filing: [Signature] 3 9 87
District Ranger Date

U.S. PUBLIC LAND SURVEY MONUMENT RECORD


Index No. C-25

State of Wisconsin }
 County of Forest } ss.

I, William B. Cochrane, do hereby certify that on the 18th day of August, 1986, I found evidence of the East Quarter corner of Section 1 Township 40 North, Range 13 East, Fourth Principal Meridian, as described hereon; and that from this evidence I established a new monument and accessories as described hereon to perpetuate the original location of this corner.

Resident witnesses:

Tony Tillman

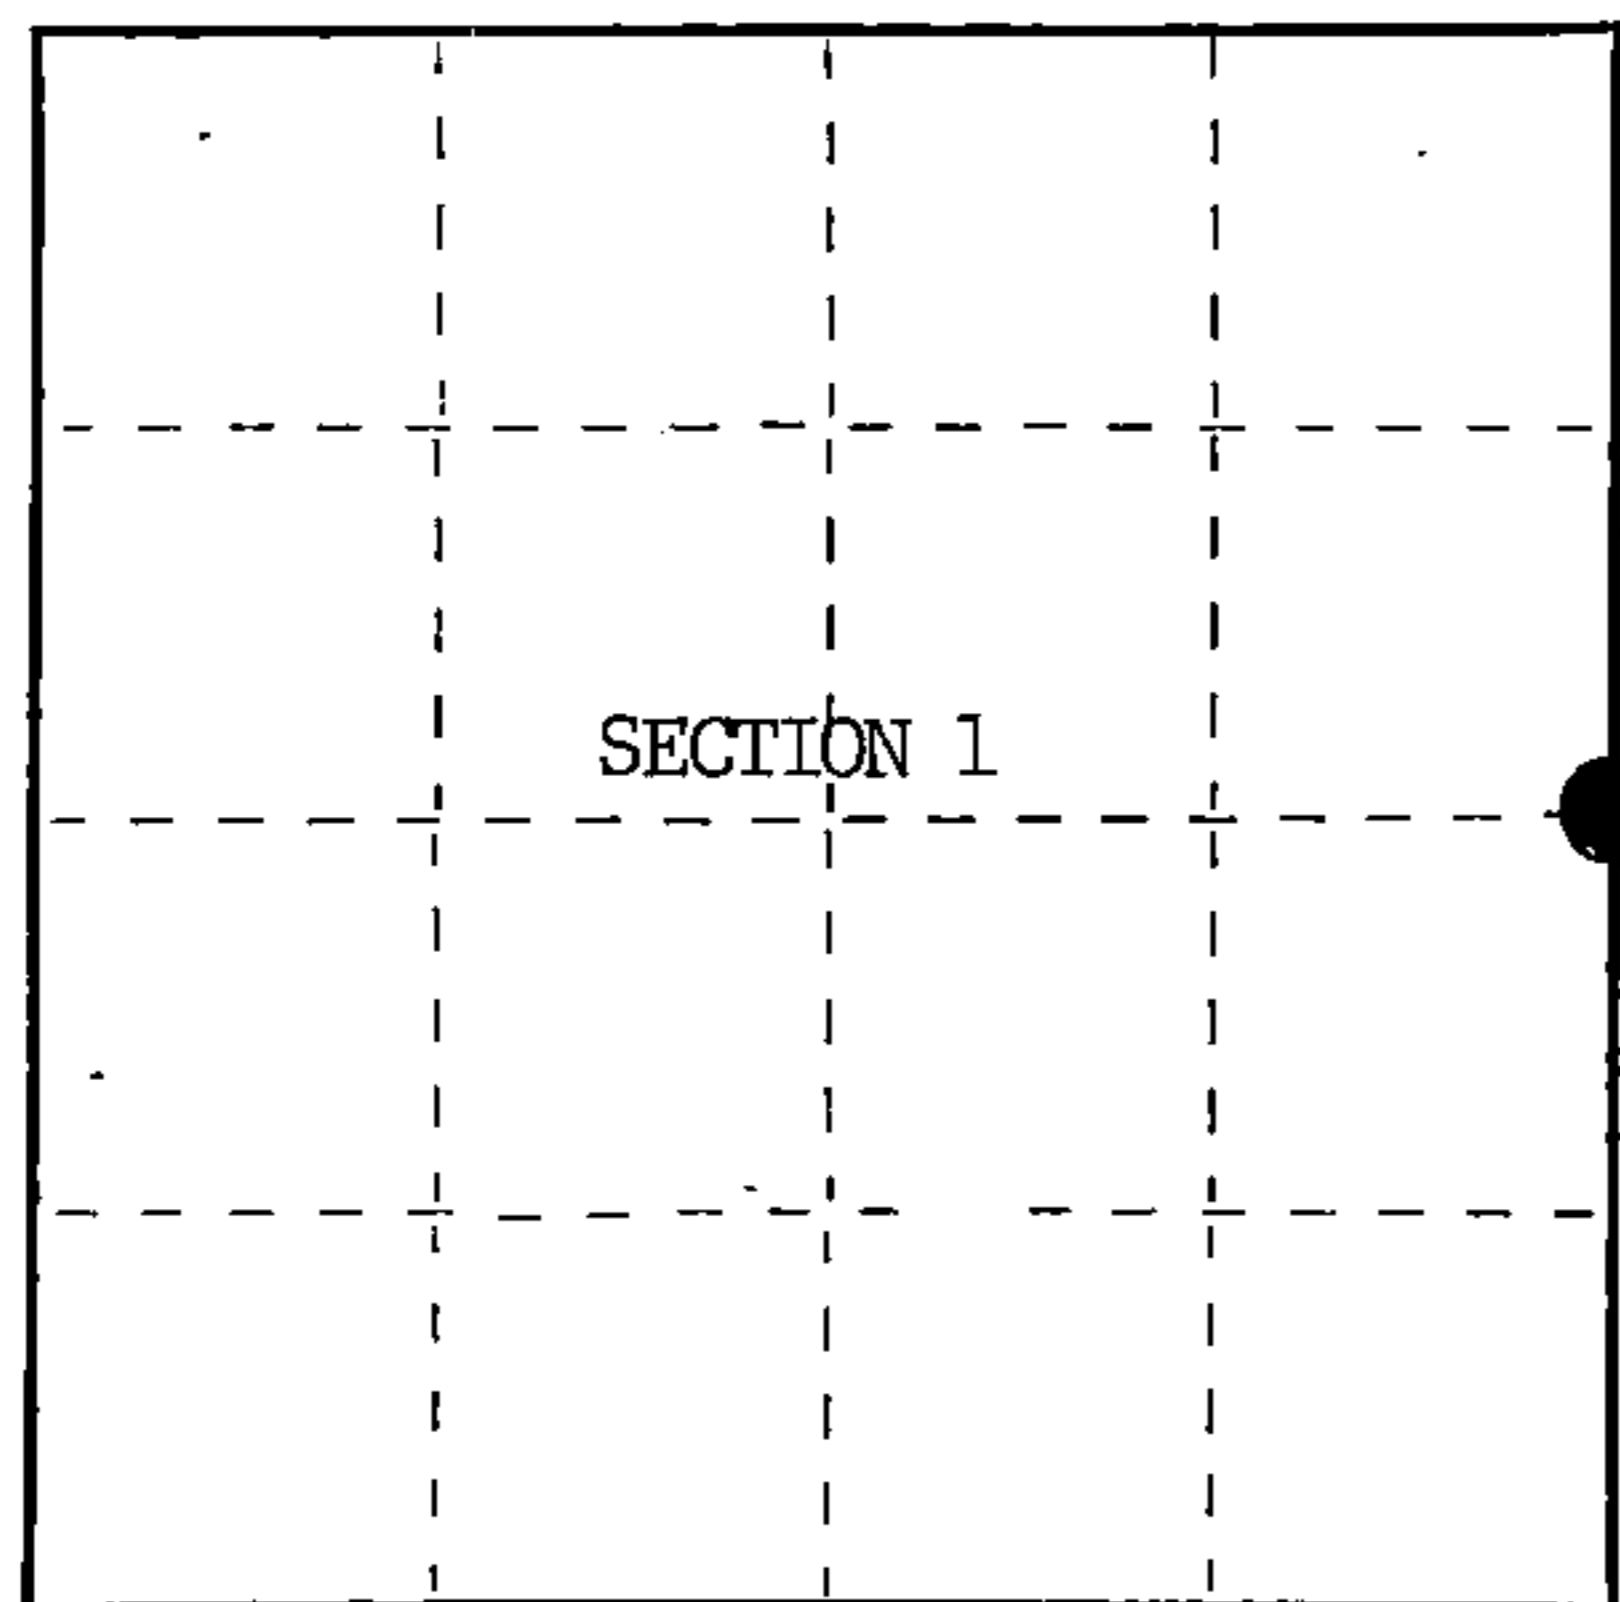

○ = Corner monument restored.

History of original corner establishment:

Original Government Survey in 1858 by Alfred Millard. Dependent Resurvey in 1945 by Hugh B. Crawford. North between Sections 1 and 6, 39.80 chains, found a rotted off Cedar Post. No evidence of original bearing trees was recovered. In place of post, set an iron post, 3 feet long, 27 inches in the ground, with a brass cap mkd; 1/4, S1, S6, 1945. From which the following bear;

Poplar	4"	N42°E	25 lks. (16.50 feet)
Poplar	4"	N44°W	30½ lks. (20.13 feet)

Description of corner evidence found:

Found monument as described and in place. No bearing tree evidence was recovered.

Description of monument and accessories I established to perpetuate the original location of this corner.

Blazed and scribed the following new bearing trees;

Maple	5"	S11°W	27.10 feet
Maple	5"	N42°W	36.40 feet
Steel Sign Post		SW	1.00 feet

Dated at Hiles, Wis., this 25th day of September, 1986

Signature *William B. Cochrane* Title Land Surveyor Registration No. S-1107
 (County Surveyor, Registered Land Surveyor, or other duly authorized official)

Office of Register of Deeds, County of Forest, I hereby certify that the within instrument was filed in this office for record on the 11th day of March, 1987 at 3:30 o'clock P. M.

Paul Asclendrenner
 (Register of Deeds)

By _____ Deputy

FORM NO. 985-A

H.C. Miller Company

Stock No. 26273

DOCUMENT NUMBER 132417

4-10-3012000

(e) Describe any material discrepancy between the location of the corner as restored or reestablished and the location of that corner as previously restored or reestablished by distance and direction. Show the discrepancy on the plan view drawing under (d), above. Show the distances between the corner as previously restored or reestablished and (1) the corner as restored or reestablished, and (2) to at least 2 of the witness monuments shown on the drawing in (d), above.

See drawing below.

(f) Was the corner restored through acceptance of (1) an obliterated evidence location, or, (2) a found perpetuated location?

Restored through acceptance of a found perpetuated location

(g&h) Was the corner reestablished through lost corner proportionate methods? If so, show the method, including the directions and distances to other public land survey corners used as evidence or used for proportioning in determining the corner location?

5" Maple
N42°W, 36.40 feet




Quarter Corner S1 | S6

R13E R14E

Steel Sign Post
SW, 1.00 feet



5" Maple
S11°W, 27.10 feet

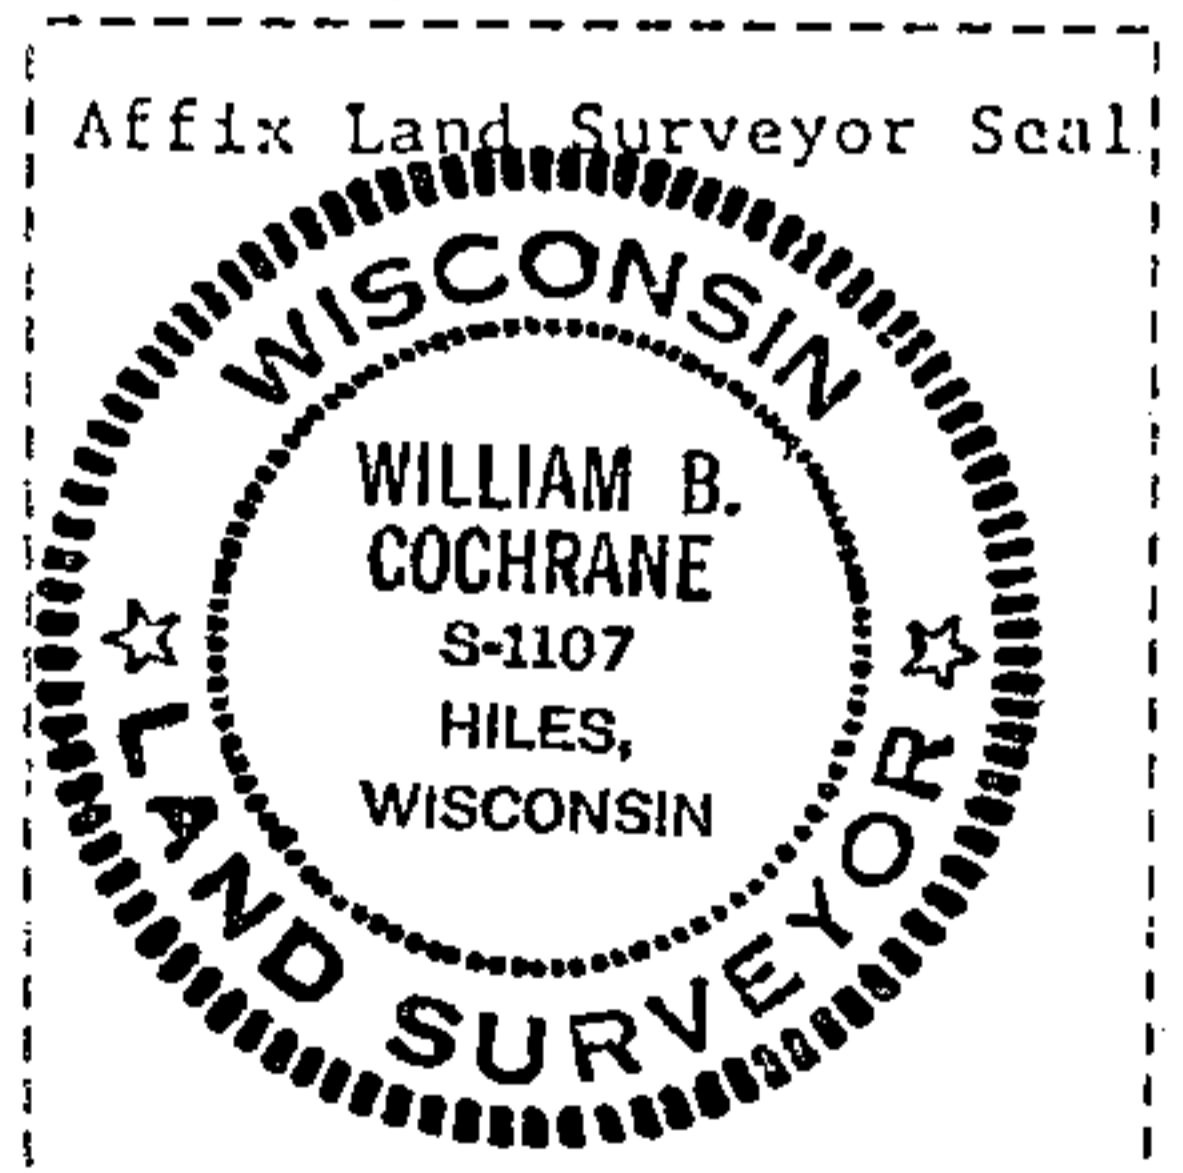

(i) I, William B. Cochrane
(type or print name) certify that the corner location shown on this record was determined by me or under my direction and control and that this U.S. Public Land Survey Monument Record is correct and complete to the best of my knowledge and belief.

William B. Cochrane
Signature

October 14, 1986
Date

Certificate ready for filing:

[Signature]
District Ranger

3-9-87
Date