

State of Wisconsin }
County of Forest } ss.

I Robert E. Badow, do hereby
certify that on the 10th day
of November, 1959, I found
evidence of the North Quarter
corner of Section 9
Township 40, North, Range
13 East, Fourth Principal Meridian,
as described hereon; and that from this evidence
I established a new monument and accessories
as described hereon to perpetuate the original
location of this corner.

Resident witnesses:



History of original corner establishment:

Original corner established in 1862-1865 by William E. Dougherty, Government
Deputy Surveyor.
Birch 8" N72°E 13 lks.
Aspen 8" S23°W 17 lks.

Description of corner evidence found:

4"x4" wood post on south side State Trunk Highway #70 scribed to identify corner.
Old bearing trees gone.

Description of monument and accessories I established to perpetuate the original location of this corner.

Set 2"x5' Galvanized iron pipe filled with concrete, capped with bronze cap and
stamped as follows:

T40N R13E
1/4 S4
S9
1959

RLS No. S-104

Blazed and scribed the following bearing trees: Cedar 8" S25°00'E 68.5 feet
Cedar 10" S25°30'W 47.2 feet
Maple 14" N24°30'W 75.6 feet

Genisot Engineering Company


Dated at Rhineland, Wis., this 30th day of November, 1959.

Signature Robert E. Badow Title Registered Land Surveyor Registration No. S-104
(County Surveyor, Registered Land Surveyor, or other duly authorized official)

Office of Register of Deeds, County of Forest, I hereby certify that the within
instrument was filed in this office for record on the 21st day of March, 1960
at 9:00 o'clock A. M.

Anna Peterson
(Register of Deeds)

By _____ Deputy

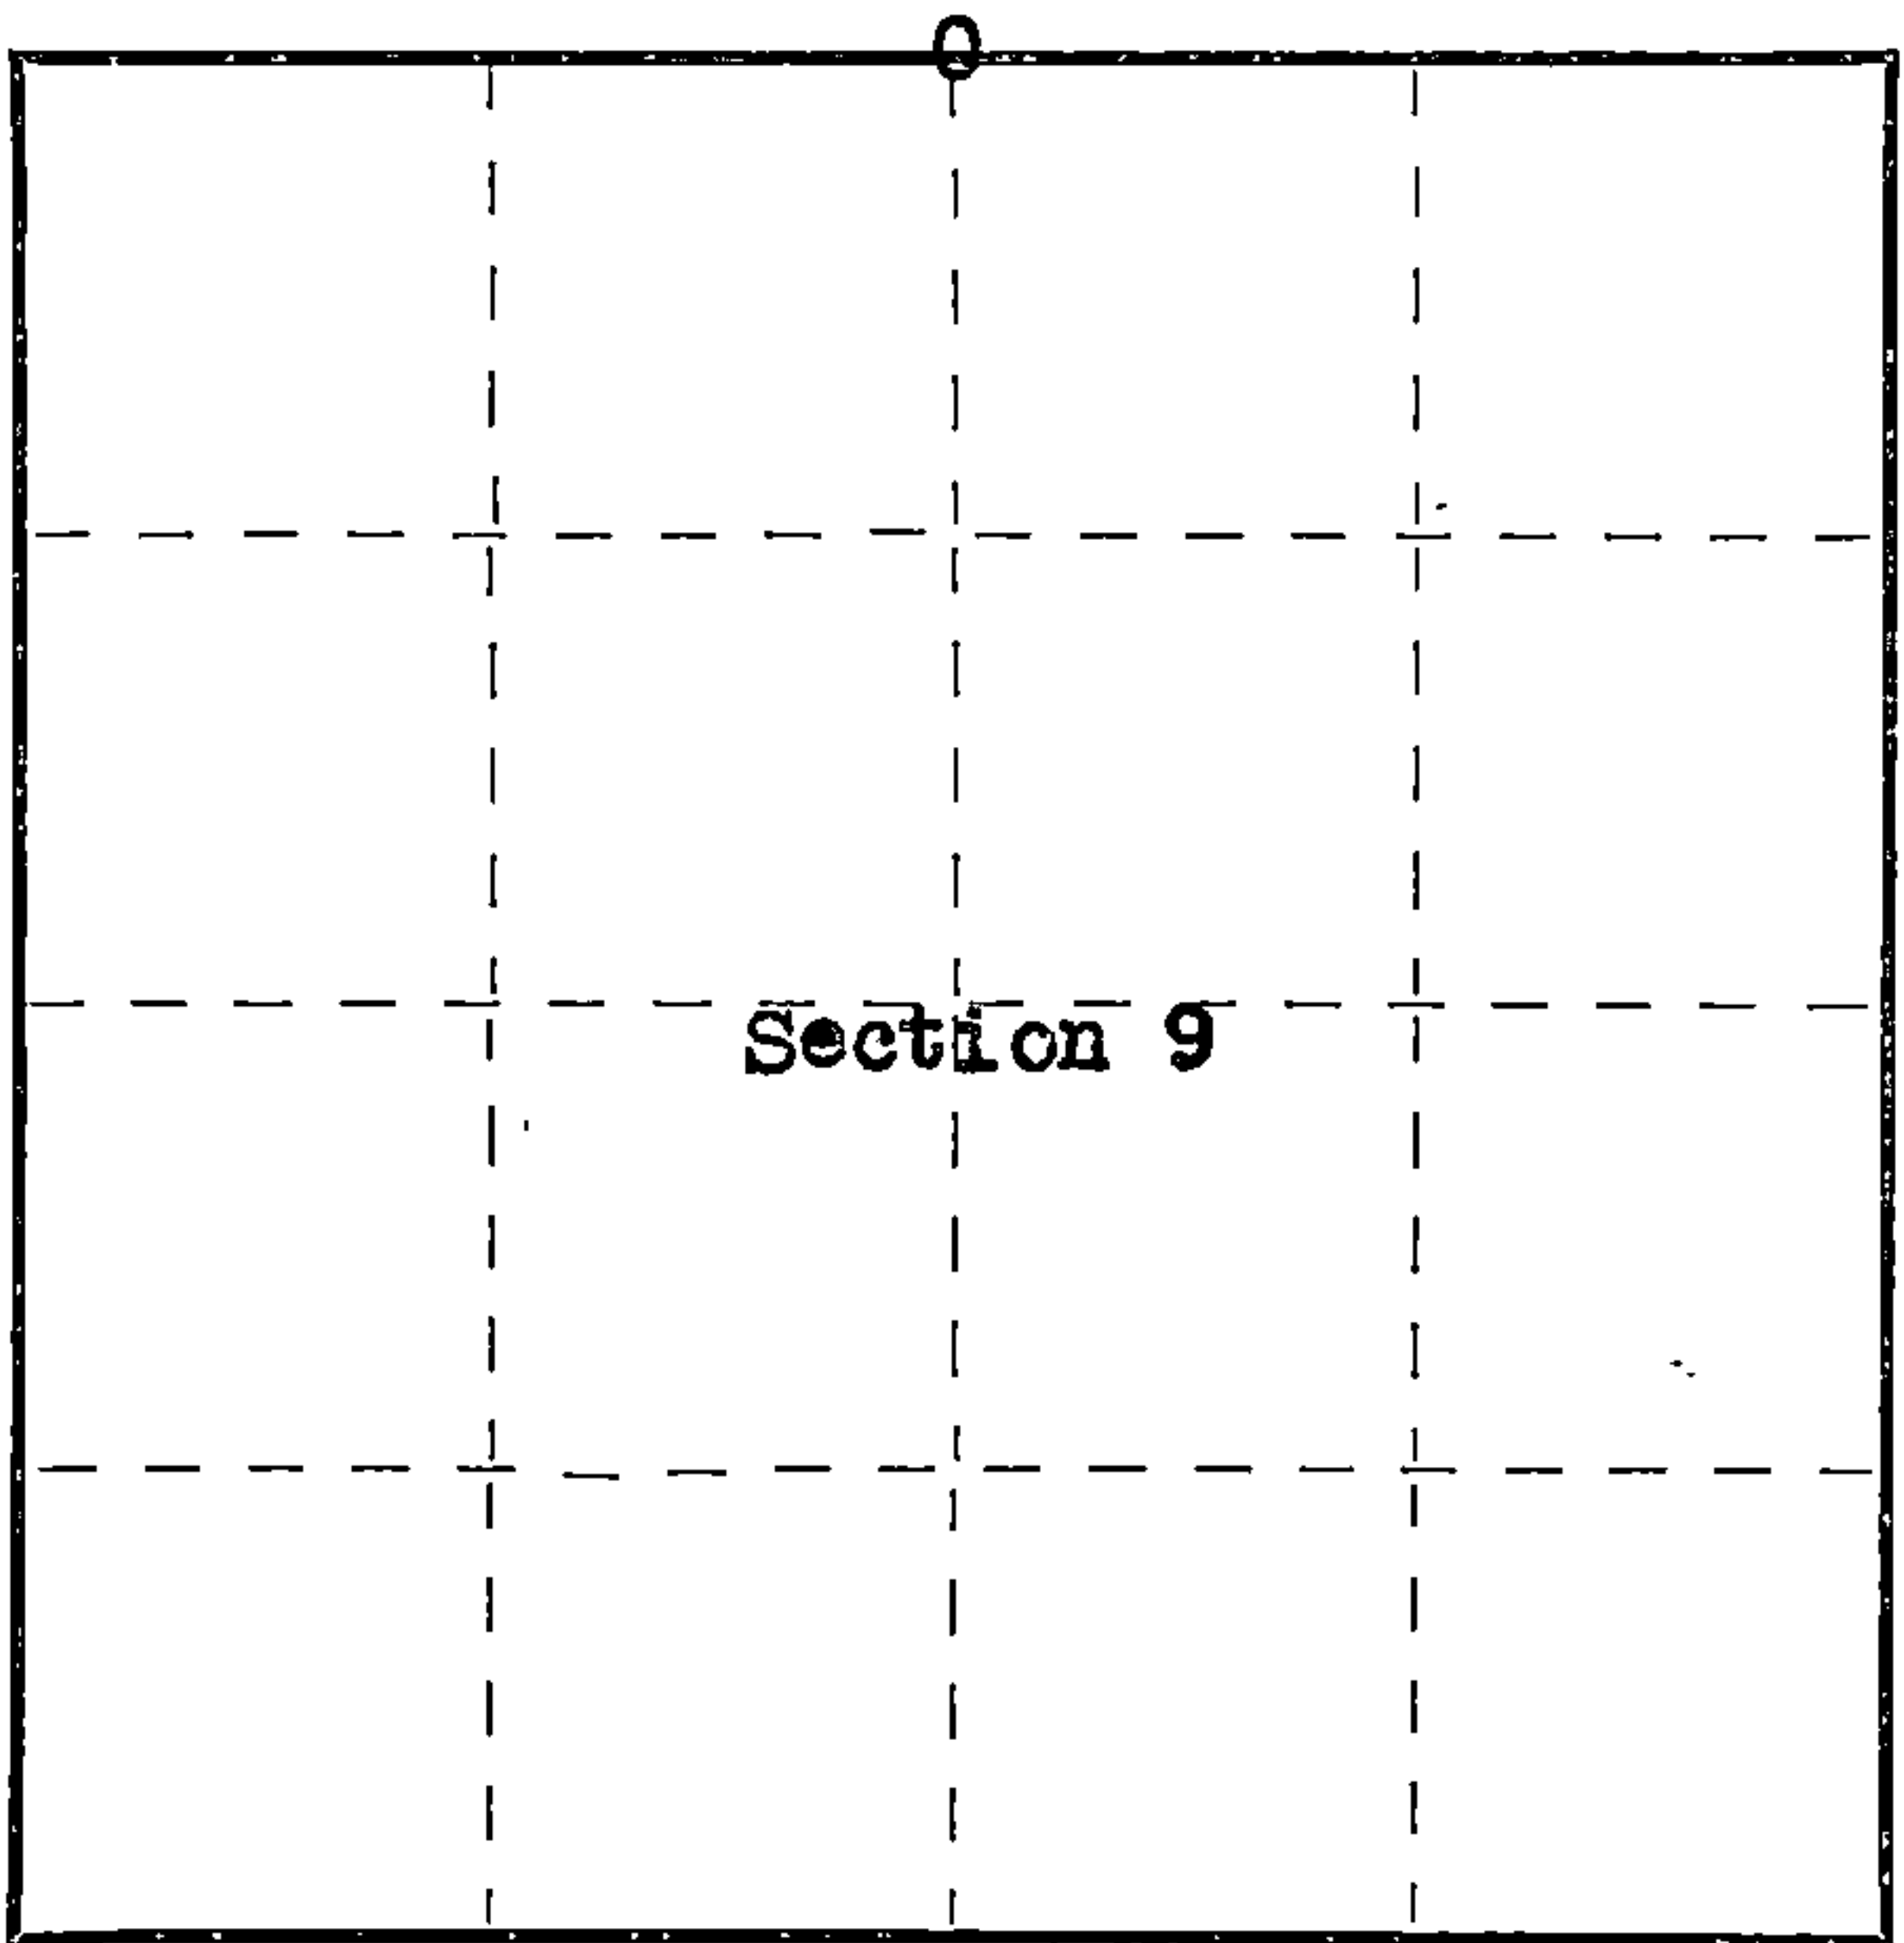

○ = Corner monument restored.

Subscribed and sworn to before me this 10th day of
November 1959. Joseph E. Hilly Notary Public,
Oneida Co., Wis.
My Commission expires May 1, 1960

44013040020

Stock No. 26273
DOCUMENT NUMBER
145351

U.S. PUBLIC LAND SURVEY MONUMENT RECORD


Index No. E-11

State of Wisconsin }
County of Forest } ss.

I, William B. Cochran, do hereby
certify that on the 11th day
of September, 1991, I found
evidence of the North Quarter
corner of Section 9
Township 40, North, Range
13 East, Fourth Principal Meridian,
as described hereon; and that from this evidence
I established a new monument and accessories
as described hereon to perpetuate the original
location of this corner.

Resident witnesses:

.....
.....
.....

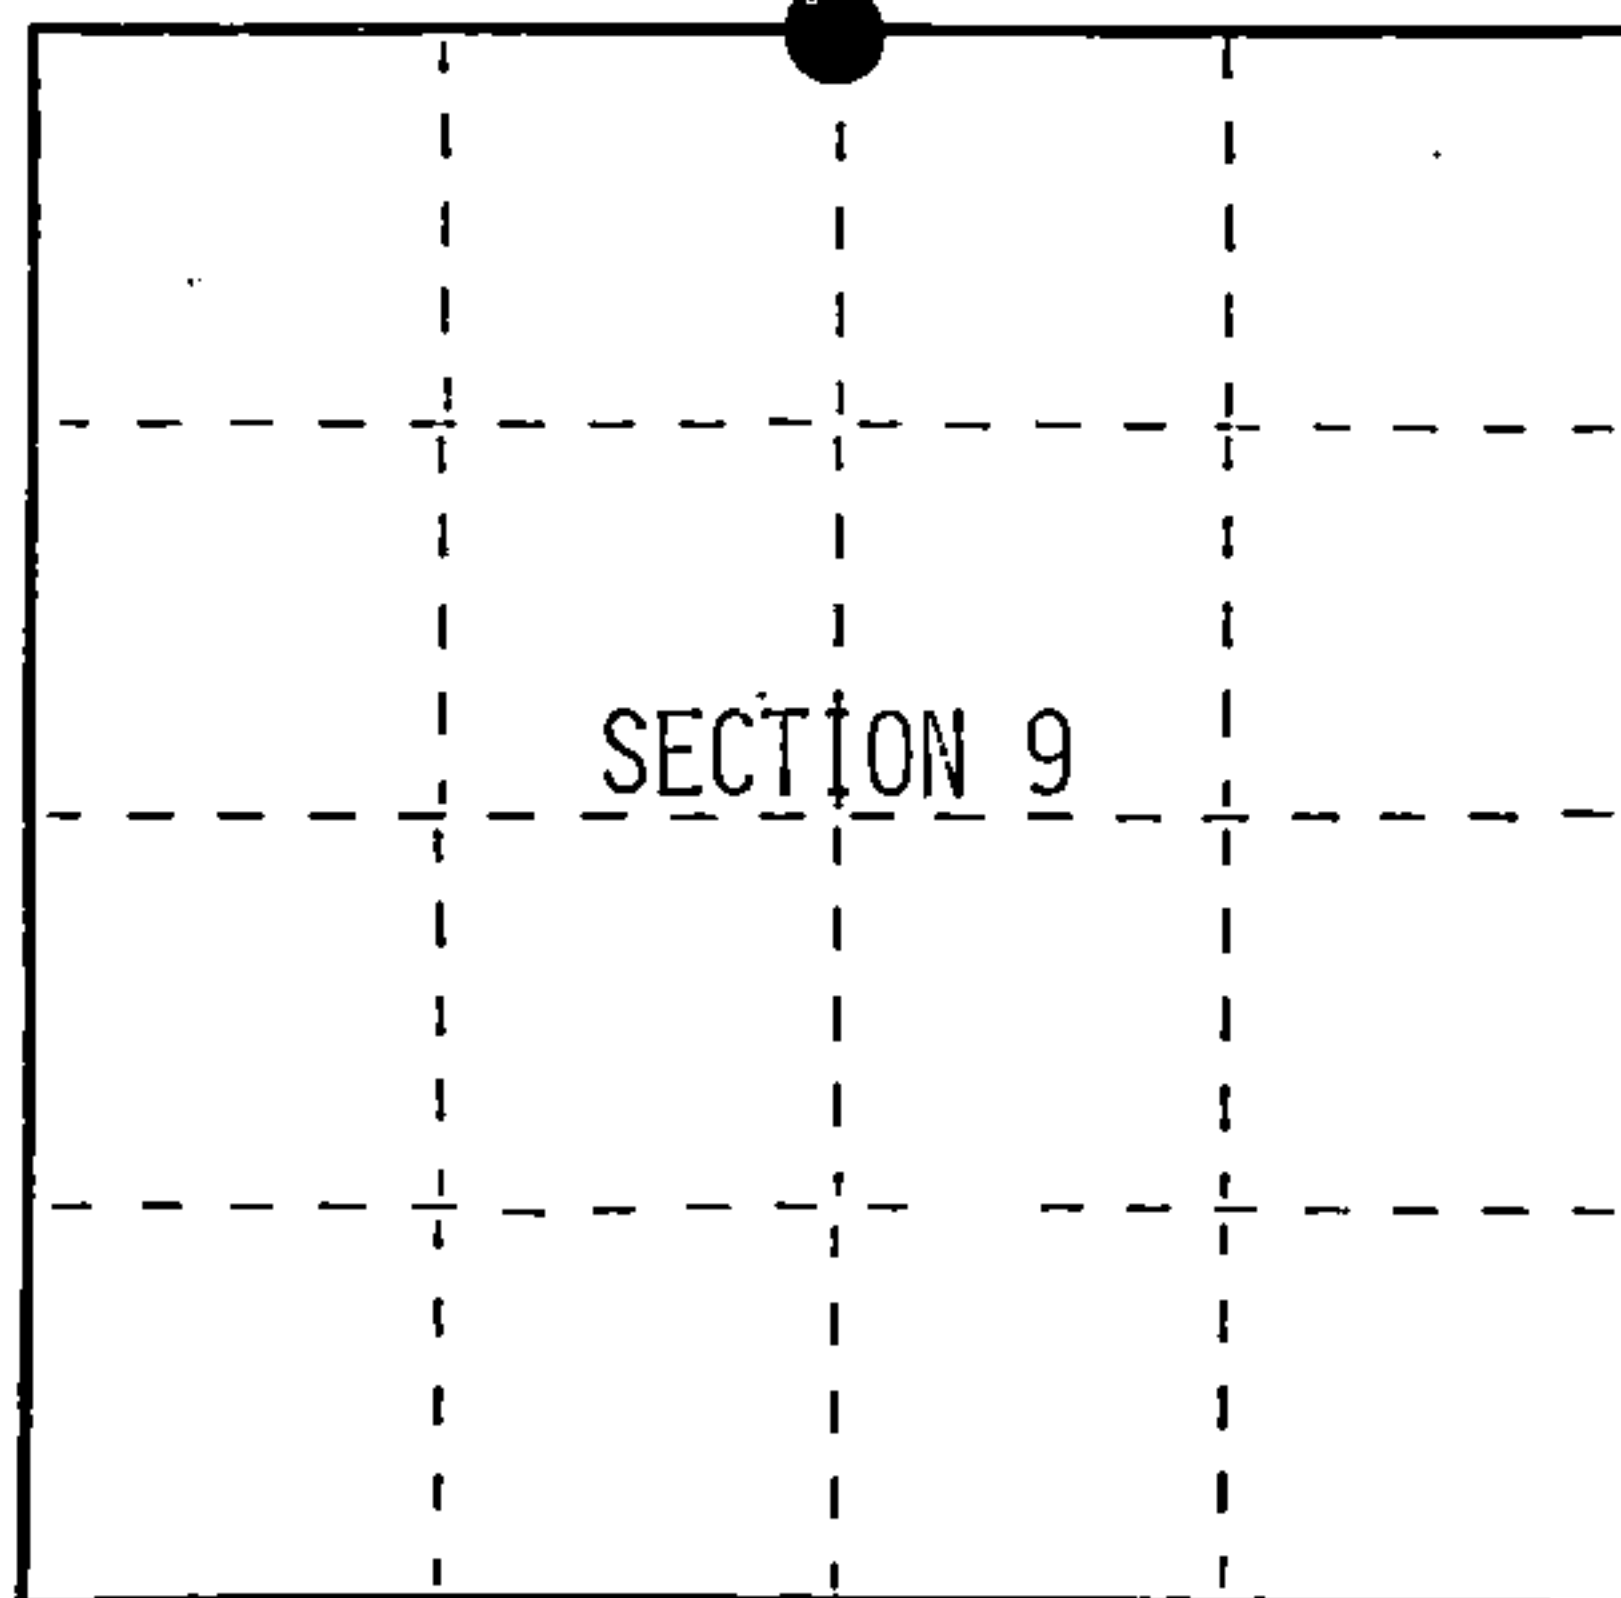

○ = Corner monument restored.

History of original corner establishment:

Original Government Survey in 1865 by William E. Daugherty.

In 1959, Robert Bandow found a 4"x4" scribed wood post. In place of post, he set
a 2"x5' galvanized iron pipe with a bronze cap stamped; T40N R13E, 1/4, S4, S9,
1959, S-104. From which the following bear;

Cedar	8'	S25°00'E	68.50 feet
Cedar	10"	S25°30'W	47.20 feet
Maple	14"	N24°30'W	75.60 feet

See Land Corner Restoration Certificate.

Description of corner evidence found:

Monument was taken out by the Eagle River Road Engineering Crew for construction
of a new Hwy 70. I replaced monument with a monument as described below.

Found the following bearing trees;

Cedar	12"	S25°00'E	68.50 feet
Cedar	14"	S25°30'W	47.20 feet

Description of monument and accessories I established to perpetuate the original location of this corner.

In place of old monument, set a 2½ inch diameter aluminum pipe monument, 3 feet long,
3 feet in the ground, (flush with ground), with an aluminum cap stamped; T40N R13E,
1/4, S4, S9, 1991, S1107.

Re-painted existing bearing trees.

Set Steel Sign Post, South, 19.00 feet

Dated at Hiles, Wis., this 18th day of February, 1992

Signature William B. Cochran Title Land Surveyor Registration No. S-1107
(County Surveyor, Registered Land Surveyor, or other duly authorized official)

Office of Register of Deeds, County of Forest, I hereby certify that the within
instrument was filed in this office for record on the 31st day of August, 1992
at 10:15 o'clock P. M.

Paul Aschenbrenner
(Register of Deeds)

By _____ Deputy



44013040020

(e) Describe any material discrepancy between the location of the corner as restored or reestablished and the location of that corner as previously restored or reestablished by distance and direction. Show the discrepancy on the plan view drawing under (d), above. Show the distances between the corner as previously restored or reestablished and (1) the corner as restored or reestablished, and (2) to at least 2 of the witness monuments shown on the drawing in (d), above.

(f) Was the corner restored through acceptance of (1) an obliterated evidence location, or, (2) a found perpetuated location?

Restored through acceptance of a found perpetuated location.

(g&h) Was the corner reestablished through lost corner proportionate methods? If so, show the method, including the directions and distances to other public land survey corners used as evidence or used for proportioning in determining the corner location?

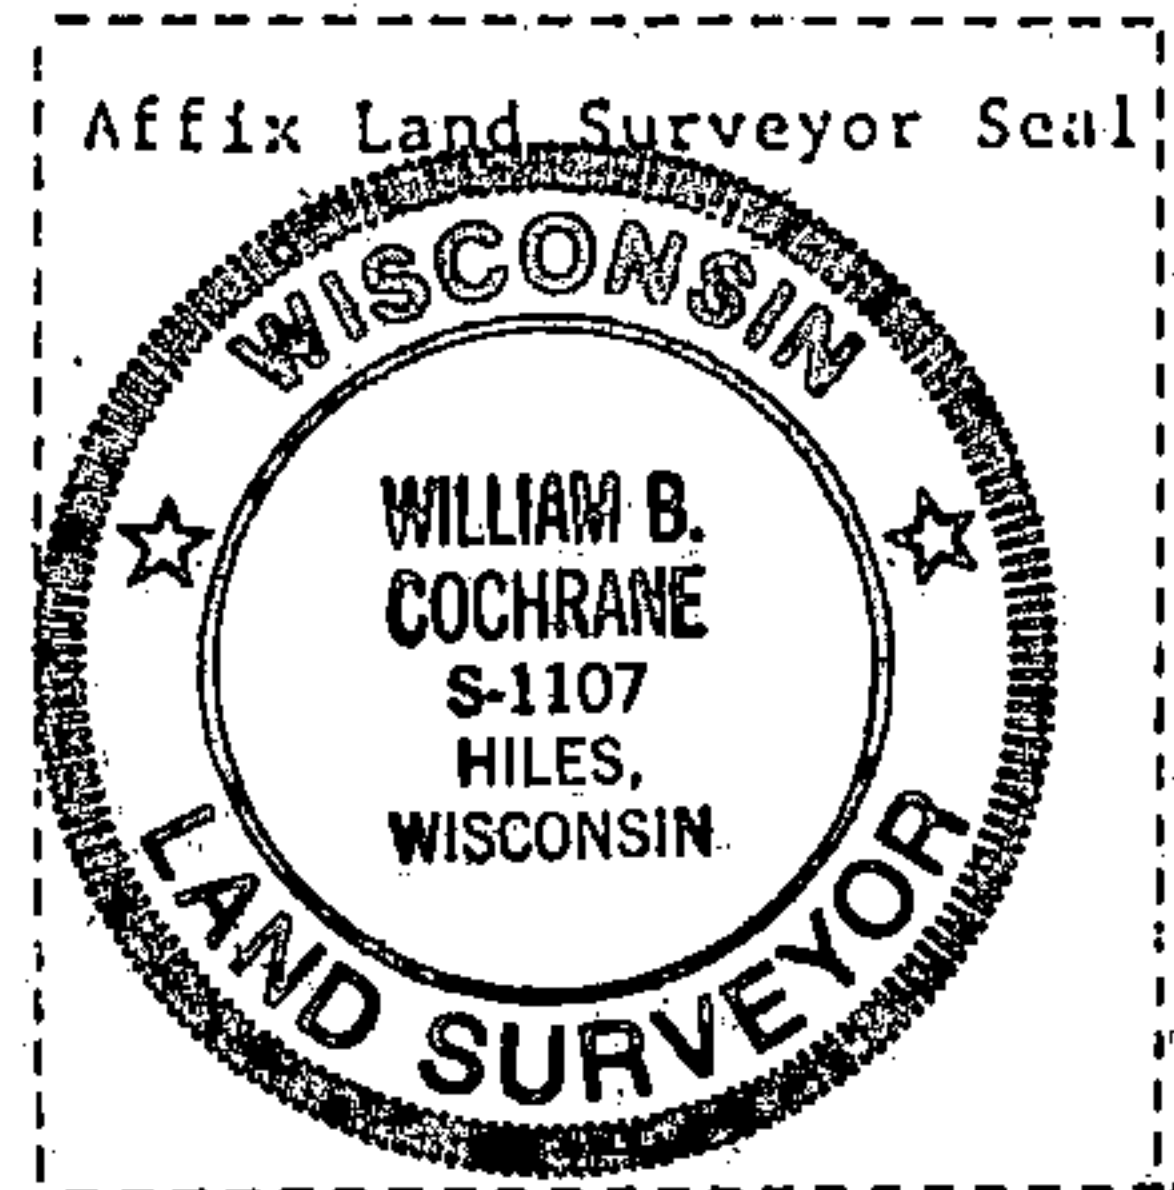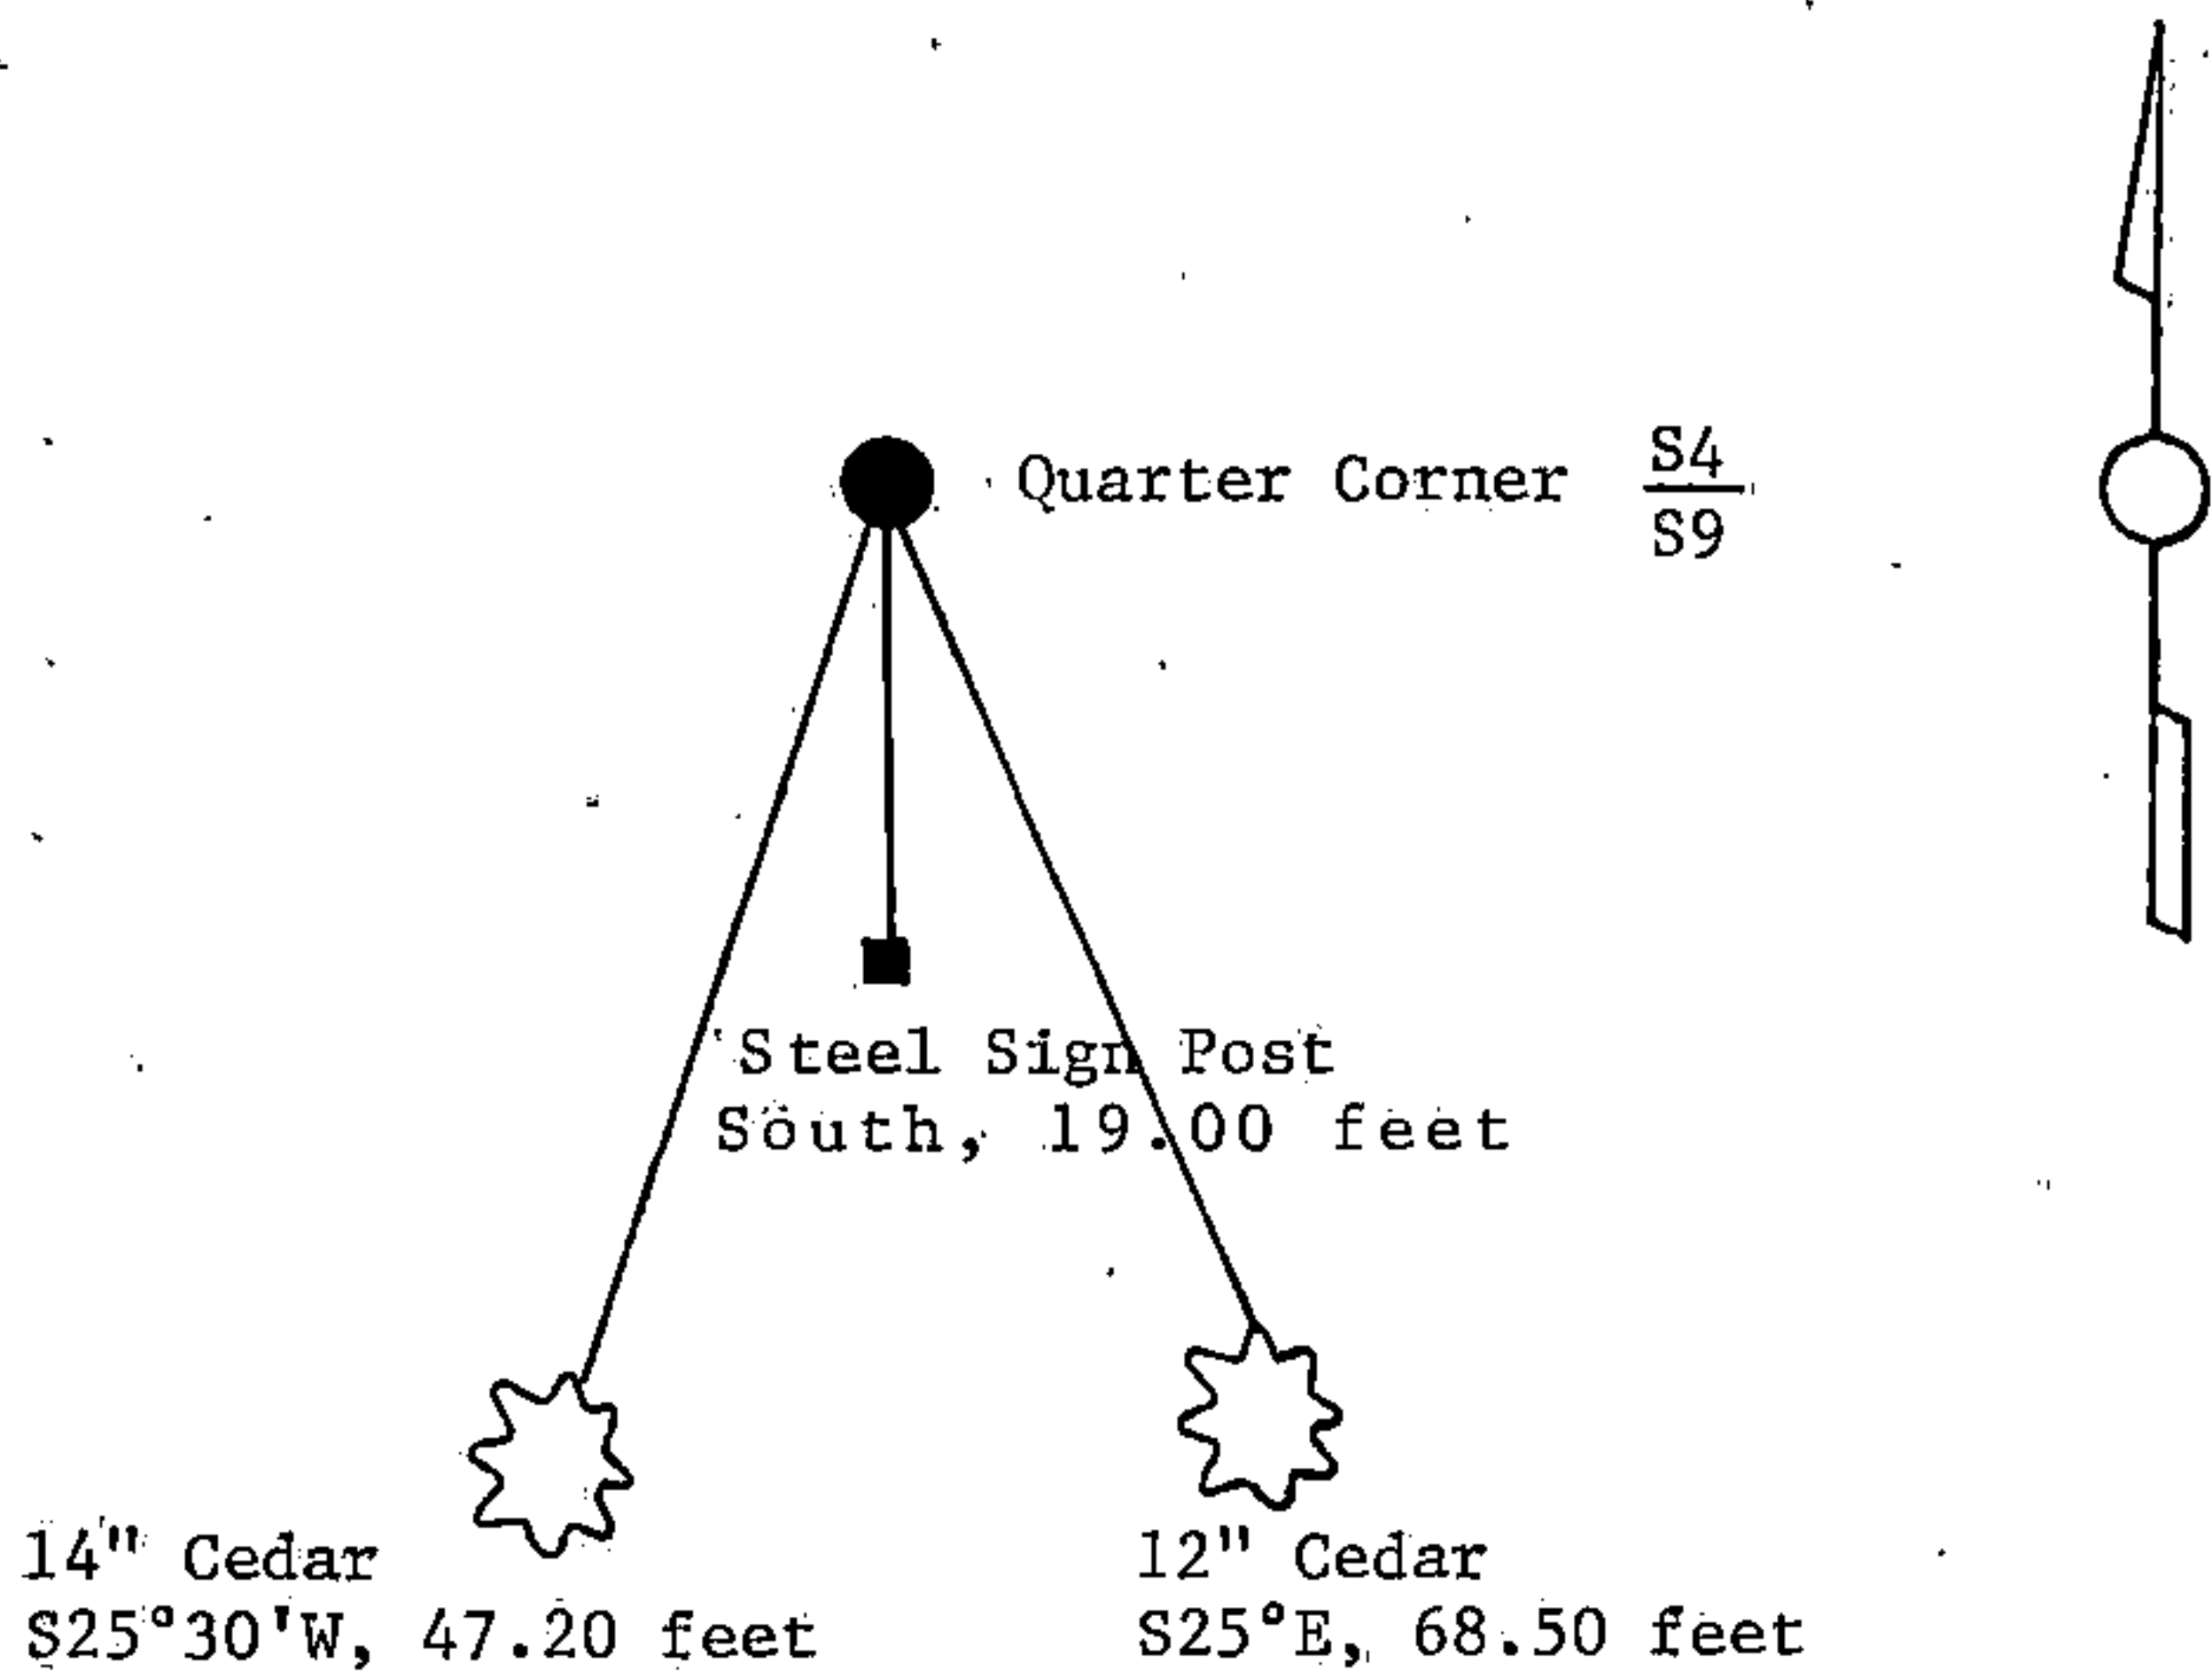

(i) I, William B. Cochrane
(type or print name) certify that the corner location shown on this record was determined by me or under my direction and control and that this U.S. Public Land Survey Monument Record is correct and complete to the best of my knowledge and belief.

William B. Cochrane March 25, 1992
Signature Date

Survey requested by; Sam Gorkin 3/23/92
District Ranger Date