

CERTIFIED LAND CORNER RESTORATION

83248

Index


U 17
17

State of Wisconsin }
County of Forest } ss.

I, Robert E. Bandow, do hereby certify that on the 12th day of November, 19 59, I found evidence of the South-East corner of Section 10 Township 40, North, Range 13 East, Fourth Principal Meridian, as described hereon; and that from this evidence I established a new monument and accessories as described hereon to perpetuate the original location of this corner.

Resident witnesses:

.....
.....
.....

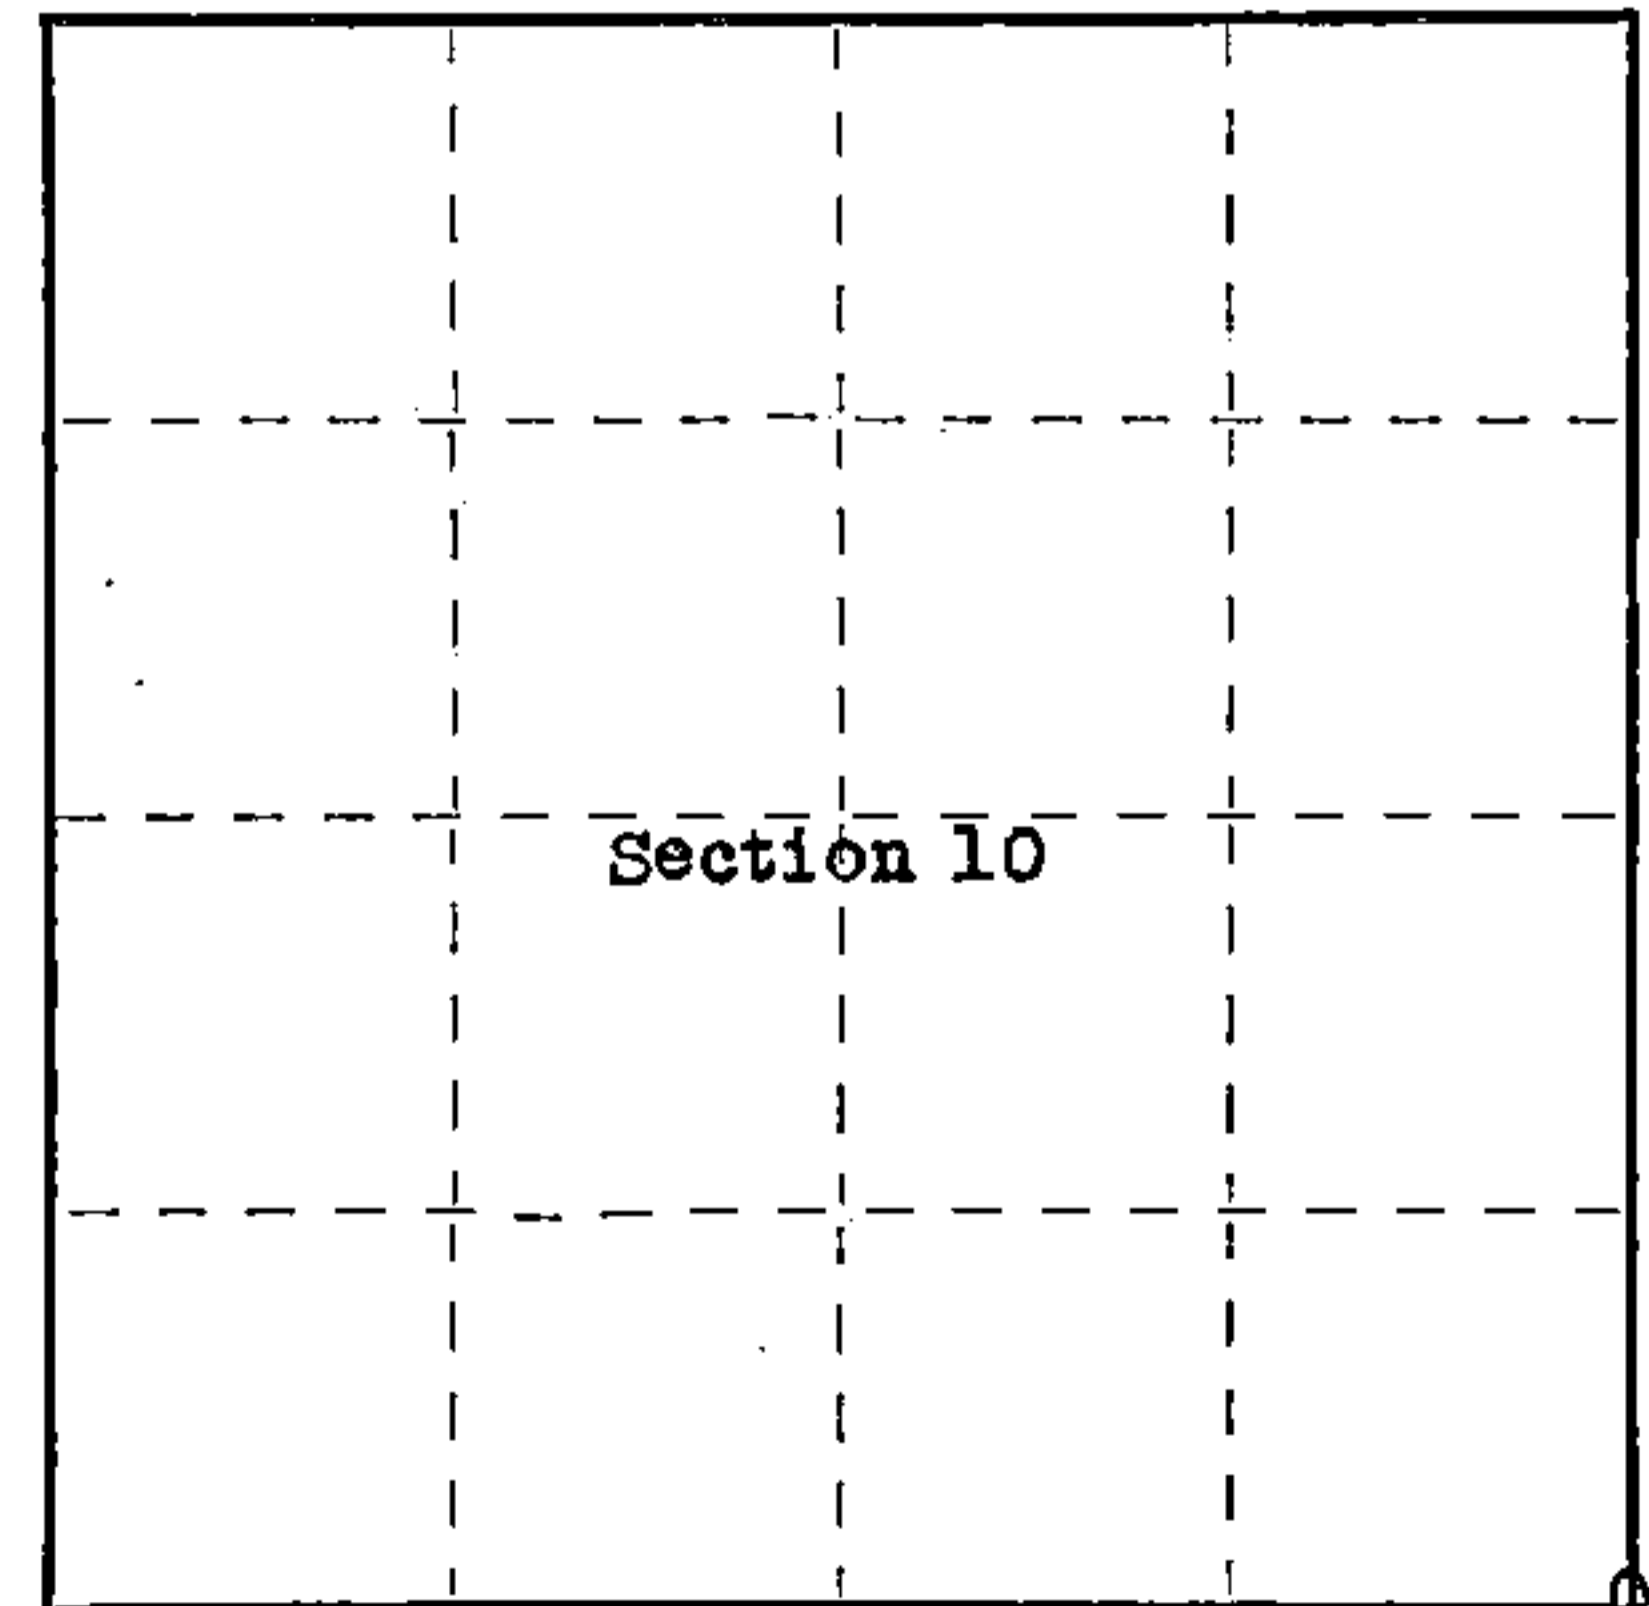

○ = Corner monument restored.

History of original corner establishment:

Original corner established in 1862-1865 by William E. Dougherty, Government Deputy Surveyor.

Original bearing trees: Sugar 10" N31°W 10 lks.
Sugar 20" S18°E 15 lks.

Description of corner evidence found:

3"x3" scribed wood post.

Post is a birch with plain scribing. Corner marker tags carry initials and dates of parties using corner, earliest date on tag being 8/18/33, and latest date being 1/15/59. All evidence of original bearing trees is now gone, however stump hole of 20" Sugar S 18E 15 links is visible.

Description of monument and accessories I established to perpetuate the original location of this corner: Set 2"x5" galvanized iron pipe filled with concrete, capped with bronze cap and stamped as follows:

T40N R13E
S10|S11
S15|S14
1959

RLS No. S-104

Blazed and scribed the following bearing trees: Maple 13" N24°30'W 8.4 feet
Hemlock 14" S21°30'E 9.9 feet
Hemlock 16" S44°W 23.9 feet

Genisot Engineering Co.


Dated at Rhineland, Wis., this 30th day of November, 19 59

Signature Robert E. Bandow Title Registered Land Surveyor Registration No. S-104
(County Surveyor, Registered Land Surveyor, or other duly authorized official)

Office of Register of Deeds, County of Forest, I hereby certify that the within instrument was filed in this office for record on the 21st day of March, 19 60 at 9:00 o'clock A. M.

Anna Peterson
(Register of Deeds)

By.....Deputy

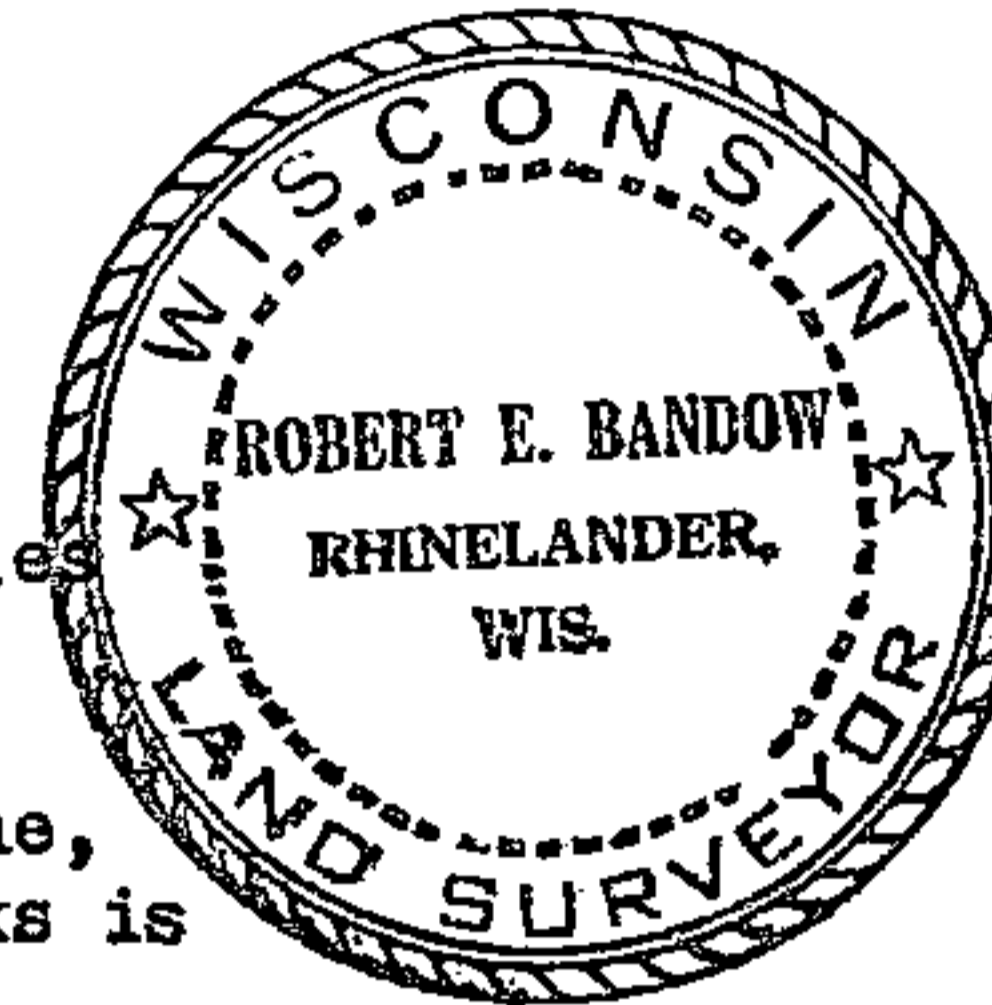

Subscribed and sworn to before me this 4th day of December, 1959. Joseph C. Healy Notary Public, Oneida Co., Wis.
My Commission expires May 1, 1960

FORM 985 M. C. MILLER CO., MILWAUKEE

4401310 0000