

U.S. PUBLIC LAND SURVEY MONUMENT RECORD

Index No. J-23

State of Wisconsin }
County of Forest } ss.

I, William B. Cochrane, do hereby certify that on the 12th day of August, 1991, I found evidence of the North Quarter corner of Section 13 Township 40 North, Range 13 East, Fourth Principal Meridian, as described hereon; and that from this evidence I established a new monument and accessories as described hereon to perpetuate the original location of this corner.

Resident witnesses:

.....
.....
.....

History of original corner establishment:

Original Government Survey in 1865 by William E. Daugherty. West corrected between Sections 12 and 13, at 40.06 chains, set Quarter Section Post, from which the following bear;

Tamarack	8"	N41°E	11 lks.
Tamarack	10"	S13°W	20 lks.

Description of corner evidence found:

No corner evidence was recovered.

I re-established the corner position at proportionate distance and on line between the Northeast and Northwest Section Corners of Section 13.

Description of monument and accessories I established to perpetuate the original location of this corner.

At the corner position set a 2½ inch diameter aluminum pipe monument, 3 feet long, 2½ feet in the ground, with an aluminum cap stamped; T40N R13E, 1/4, S12, S13, 1991, S-1107. From which the following new blazed and scribed bearing trees bear;

Cedar	11"	S60°W	14.20 feet
Cedar	12"	N50°W	21.41 feet
Set- Steel Sign Post		NW	0.50 feet


Dated at Hiles, Wis., this 19th day of February, 1992

Signature: William B. Cochrane Title: Land Surveyor Registration No. S-1107
(County Surveyor, Registered Land Surveyor, or other duly authorized official)

Office of Register of Deeds, County of Forest, I hereby certify that the within instrument was filed in this office for record on the 31st day of August, 1992 at 10:15 o'clock A.M.

Paul Aschenbrenner
(Register of Deeds)

By.....Deputy

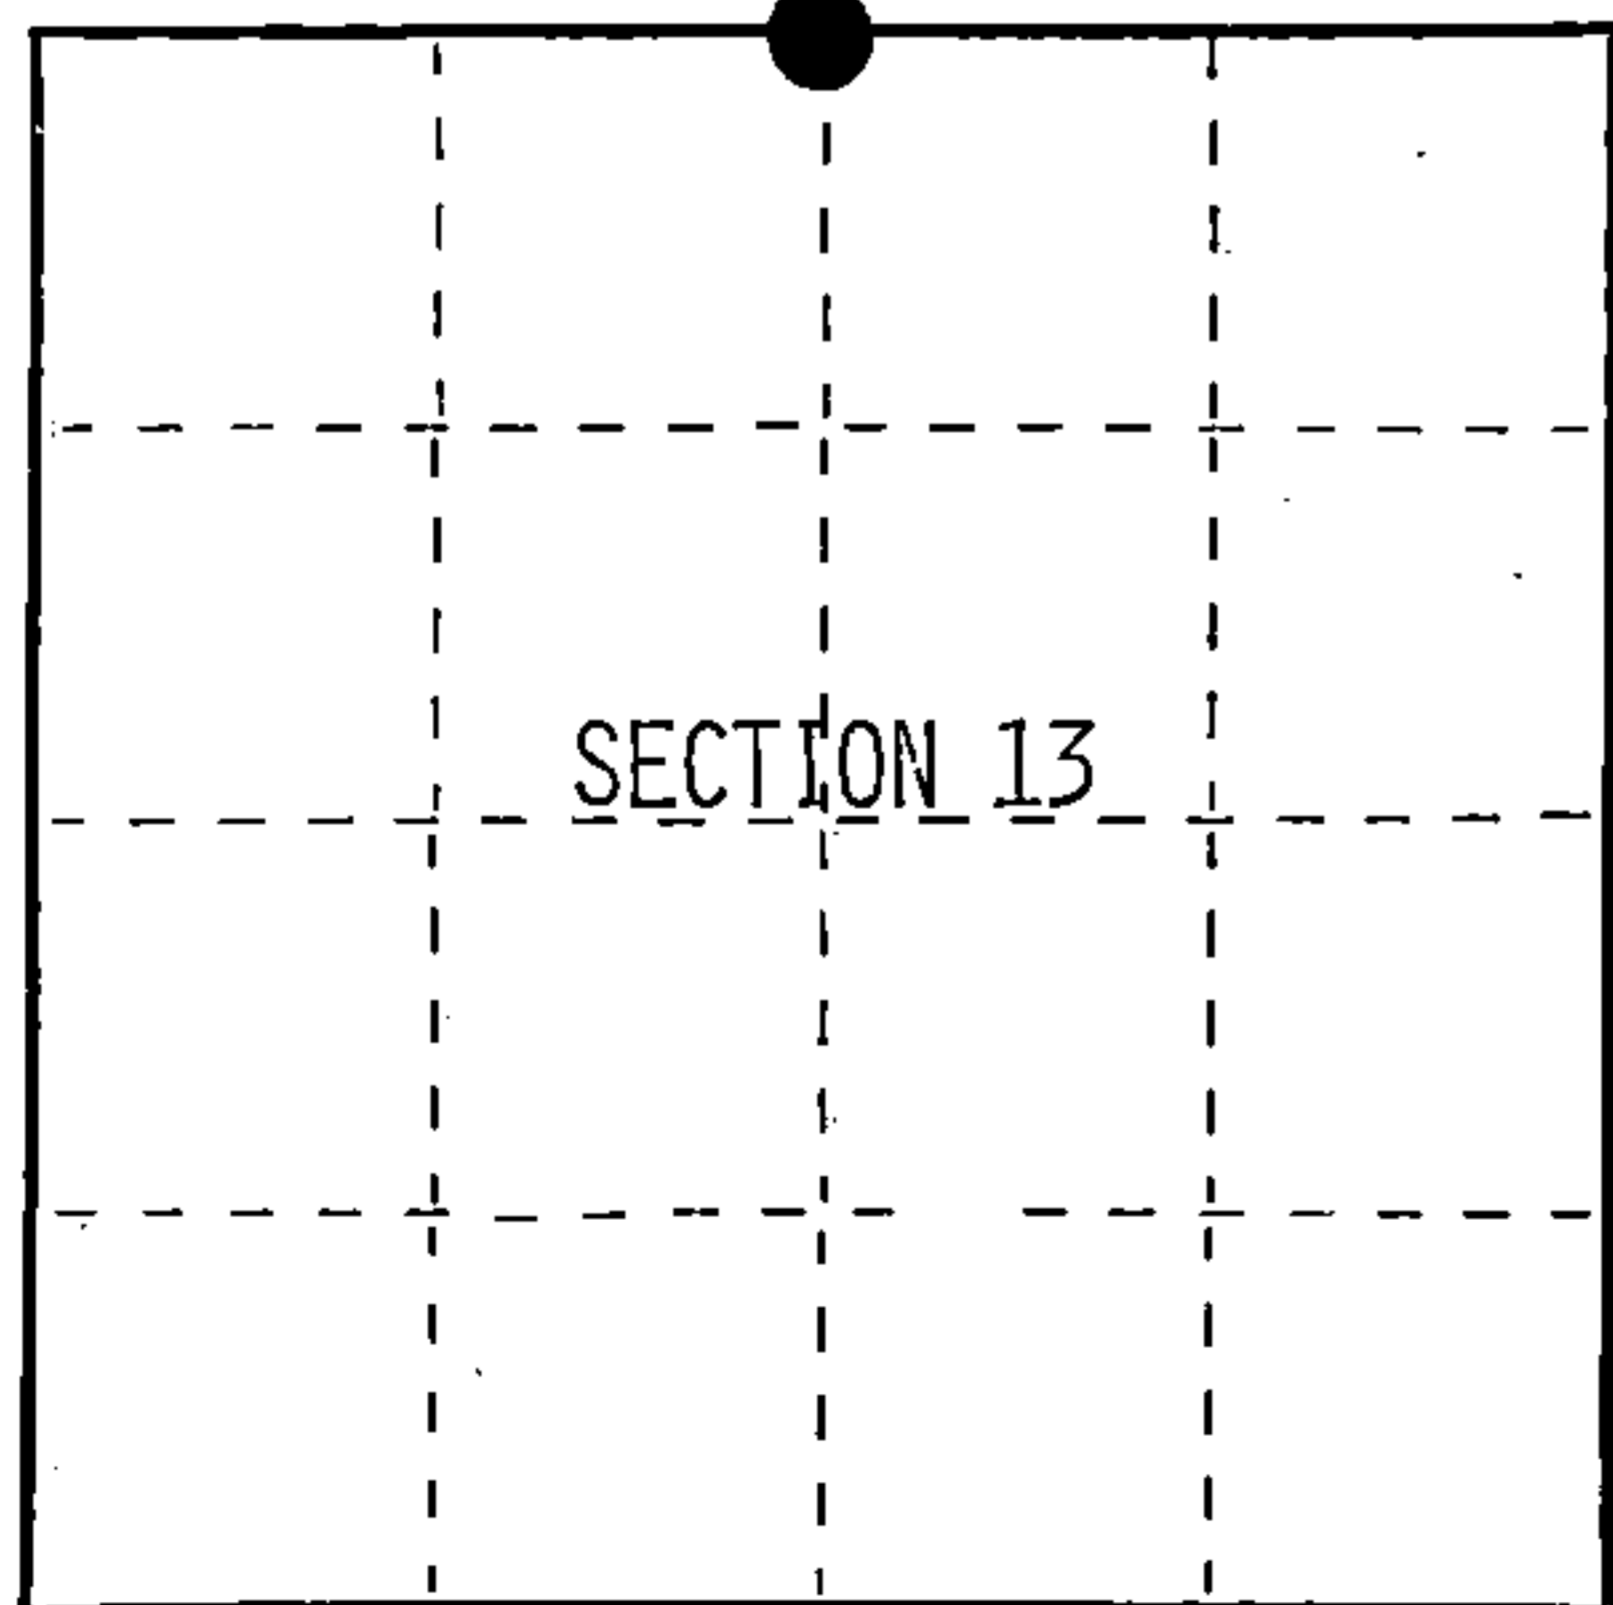

○ = Corner monument restored.

FORM NO. 985-A

H.C. Miller Company

Stock No. 26273

DOCUMENT NUMBER

145359

4401312-0020

