

CERTIFIED LAND CORNER RESTORATION

State of Wisconsin }
County of Forest } ss.

I Jean F. Resvick, do hereby certify that on the 14th day of January, 1975, I found evidence of the northeast section corner of Section 22 Township 40 North, Range 13 East, Fourth Principal Meridian, as described hereon; and that from this evidence I established a new monument and accessories as described hereon to perpetuate the original location of this corner:

Description of original monument and accessories and subsequent restorations:



Surveyed in 1865 by William E. Daugherty
80.00 chains north between sections 22 and 23, set post
Cedar 12, S89°W, 13 lks
Birch 18, N52°E, 19 lks
3.50 chains north, creek 50 lks wide runs east
4.52 chains east, creek 50 lks wide run SE

Description of corner evidence found:

3x3x16 squared cedar post
Large yellow birch stump remains
Fallen cedar with over growth
At bearing and distance from yellow birch stump, uncovered evidence of original post point
Distance north and east check to creek
3x3 post found does not check

Description of monument and accessories I established to perpetuate the location of this corner:

Replaced original post point with a 2 inch diameter galvanized iron pipe, 3 feet long, filled with concrete, with brass cap stamped T40N, R13E, S15, S14, S22, S23, 1975, S-802
Blazed and scribed the following new bearing trees:
Maple 8, bears N74E, 12.32 feet
Maple 8, bears S12E, 23.57 feet
Maple 10, bears S72W, 8.63 feet
Set steel sign post 0.5 feet SW of monument

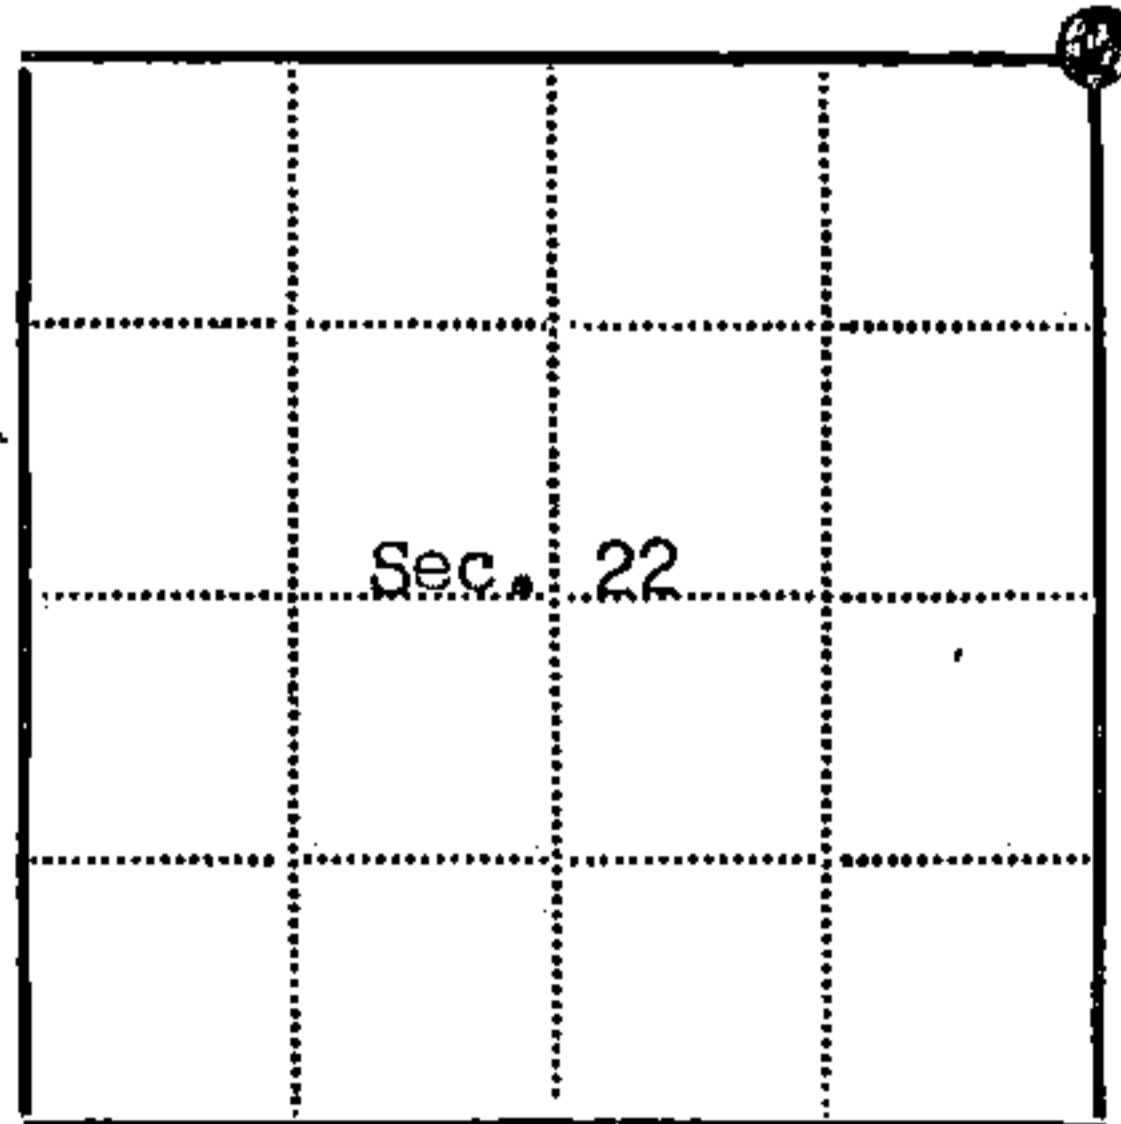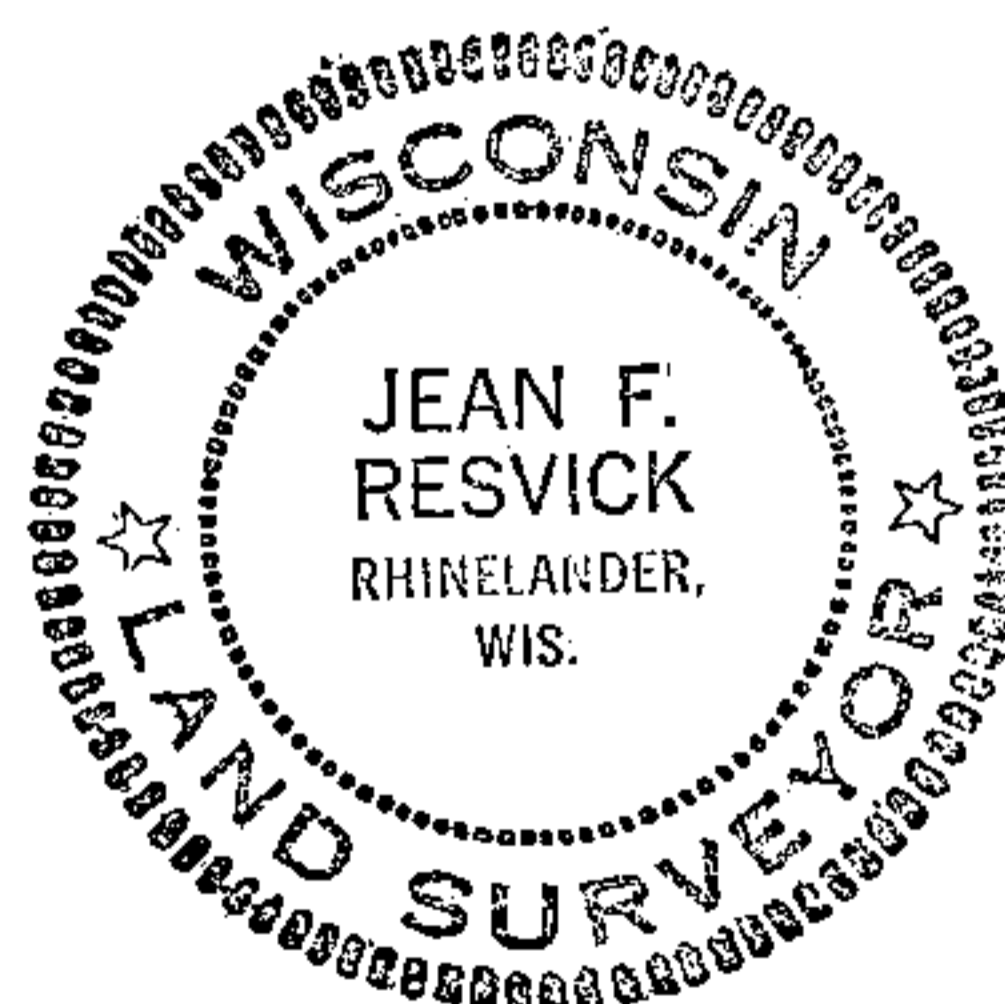

● - Corner monument restored
□ -

Resident witnesses.....

Dated at Rhinelander Wisconsin, this 20 day of March 1975.

Signature *Jean F. Resvick* Title Land Surveyor
(County Surveyor, Registered Land Surveyor, or other duly authorized official)

Surveyors Registration No. S-802 Document Number 106881

Office of Register of Deeds County of Forest

I hereby certify that the within instrument was filed in this office for record on the 31st day of March 1975, and was filed in Book No. Restoration Page No. N-17 of County Records.

Signature *Eugene Stutzman* Title Register of Deeds

Township 40 North, Range 13 East, Section 22, Index No. N-17, Page No.