

U.S. PUBLIC LAND SURVEY MONUMENT RECORD

Index No. N-15

State of Wisconsin }
County of Forest } ss.

I William B. Cochrane, do hereby certify that on the 20th day of July, 1991, I found evidence of the North Quarter corner of Section 22 Township 40, North, Range 13 East, Fourth Principal Meridian, as described hereon; and that from this evidence I established a new monument and accessories as described hereon to perpetuate the original location of this corner.

Resident witnesses:

History of original corner establishment:

Original Government Survey in 1865 by William E. Daugherty. West corrected between Sections 15 and 22, at 40.18 chains, set Quarter Section Post to Sections 15 and 22, from which the following bear;

Hemlock	10"	N37°W	27 lks.
Hemlock	20"	S46°E	23 lks.

Description of corner evidence found:

Found 2½ inch diameter iron pipe with a wood post alongside. This evidence was also found on 2-21-39 as noted on form 874.

I accept the iron pipe and wood post as the best available evidence for restoring the corner position..

Description of monument and accessories I established to perpetuate the original location of this corner.

In place of pipe, set a 2½ inch diameter aluminum pipe monument, 3 feet long, 2½ feet in the ground, with an aluminum cap stamped; T40N R13E, 1/4, S15, S22, 1990, S-1107. From which the following new blazed and scribed bearing trees bear;

Hemlock	12"	South	28.78 feet
Spruce	10"	N65°W	10.74 feet
Set- Steel Sign Post		East	0.50 feet


Dated at Hiles, Wis., this 18th day of February, 1992

Signature William B. Cochrane Title Land Surveyor Registration No S-1107
(County Surveyor, Registered Land Surveyor, or other duly authorized official)

Office of Register of Deeds, County of Forest, I hereby certify that the within instrument was filed in this office for record on the 31st day of August, 1992 at 10:15 o'clock A. M.

Paul Aschenbrenner
(Register of Deeds)

By _____ Deputy

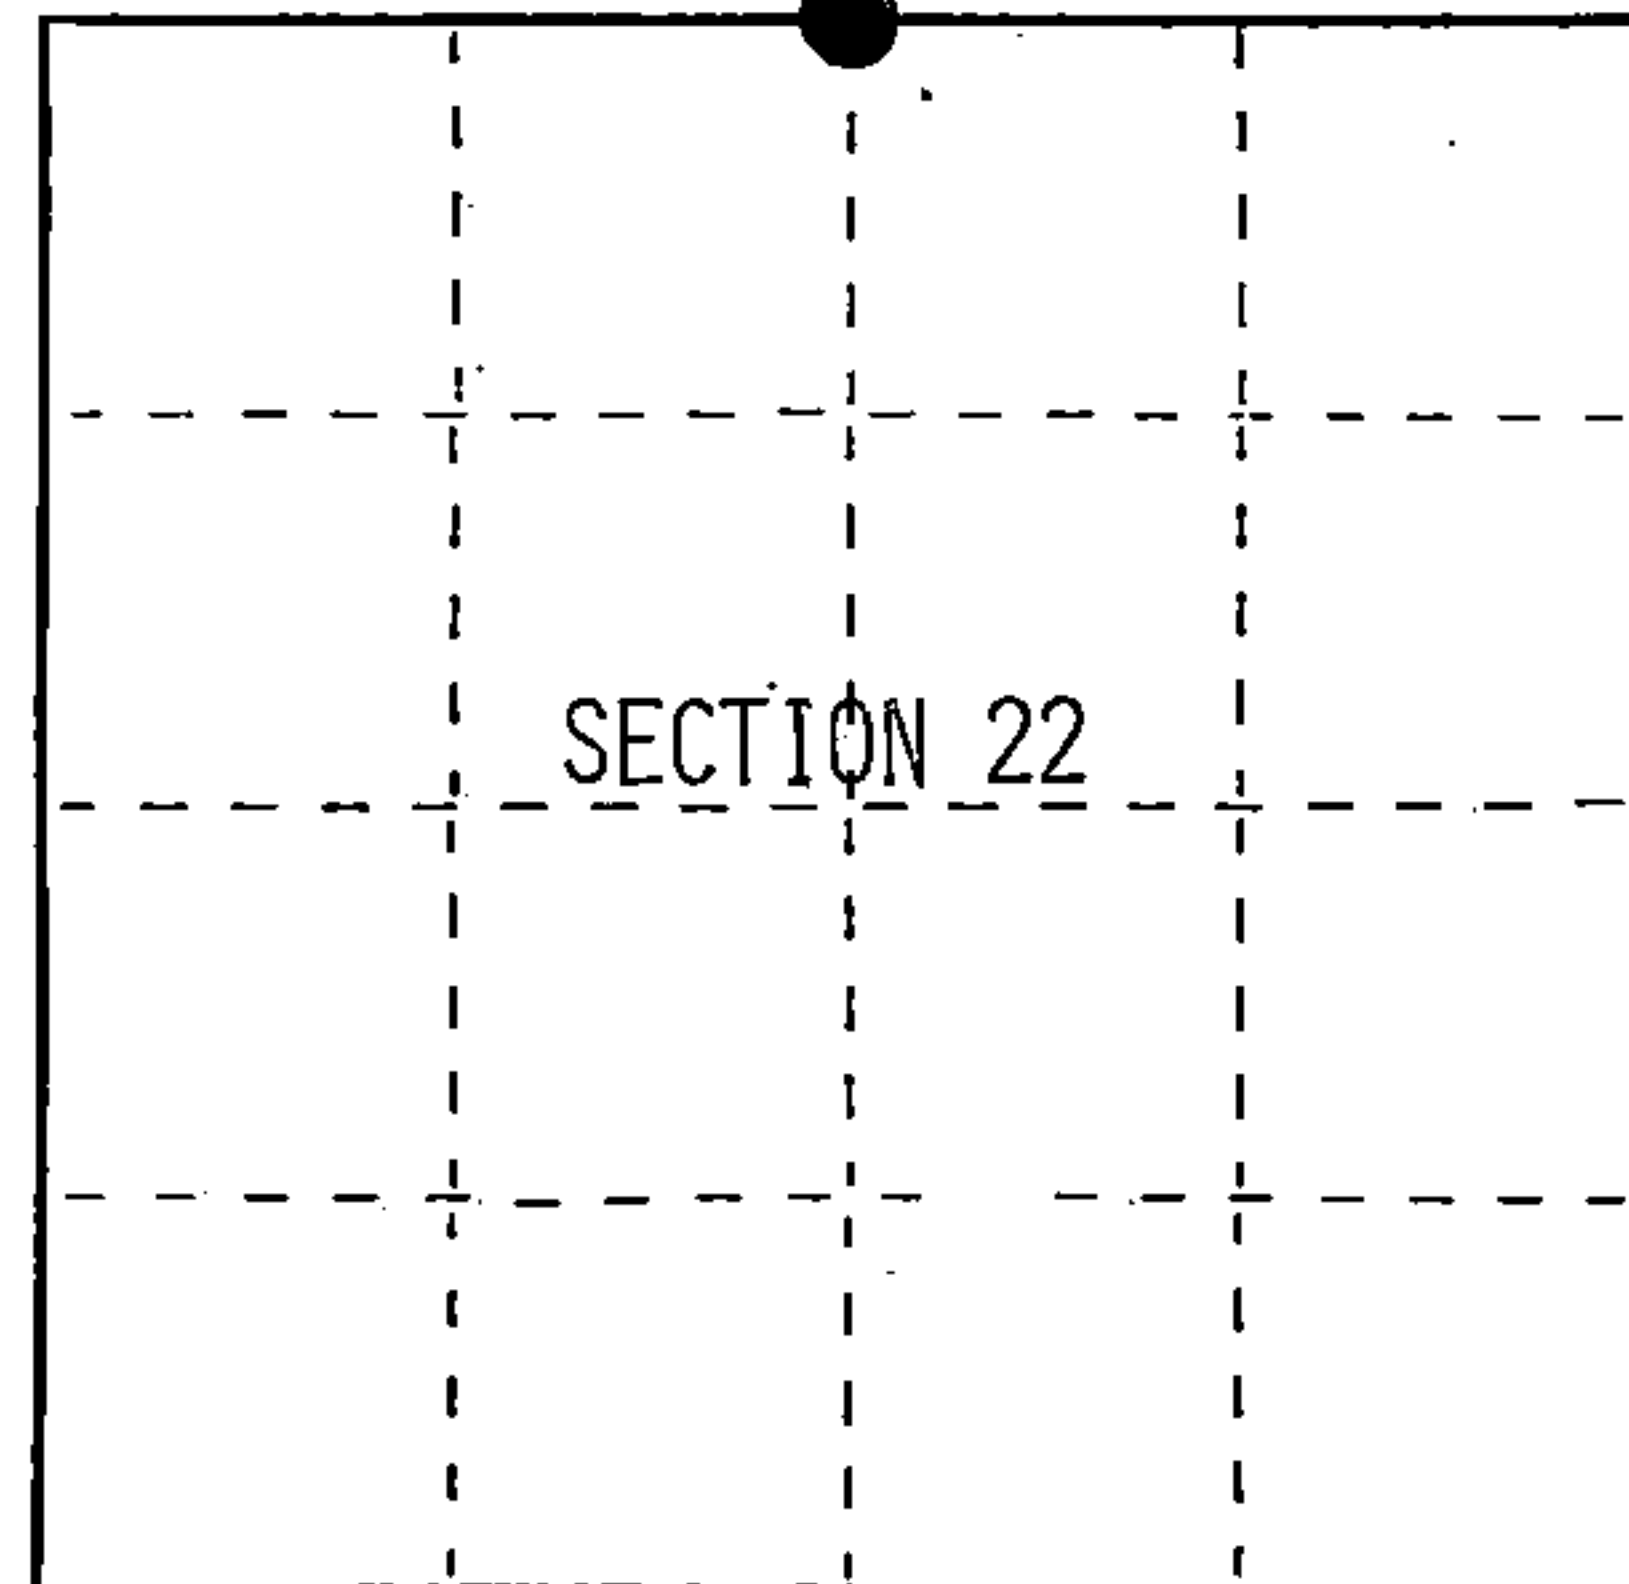

○ = Corner monument restored.

FORM NO. 985-A

H.C. Miller Company
Milwaukee, Wisconsin

Stock No. 26273
DOCUMENT NUMBER
145365

4401315 0020

(e) Describe any material discrepancy between the location of the corner as restored or reestablished and the location of that corner as previously restored or reestablished by distance and direction. Show the discrepancy on the plan view drawing under (d), above. Show the distances between the corner as previously restored or reestablished and (1) the corner as restored or reestablished, and (2) to at least 2 of the witness monuments shown on the drawing in (d), above.

(f) Was the corner restored through acceptance of (1) an obliterated evidence location, or, (2) a found perpetuated location?

Restored from accepted evidence.

(g&h) Was the corner reestablished through lost corner proportionate methods? If so, show the method, including the directions and distances to other public land survey corners used as evidence or used for proportioning in determining the corner location?

10" Spruce(New BT)
N65°W, 10.74 feet



Quarter Corner $\frac{S15}{S22}$



Steel Sign Post
East; 0.50 feet



12" Hemlock(New BT)
South, 28.78 feet



(i) William B. Cochrane
(Type or print name) certify that the corner location shown on this record was determined by me or under my direction and control and that this U.S. Public Land Survey Monument Record is correct and complete to the best of my knowledge and belief.



William B. Cochrane March 25, 1992
Signature Date

Survey requested by; Pam Gardner 3/23/92
District Ranger Date