


U.S. PUBLIC LAND SURVEY MONUMENT RECORD

Index No. R-23

State of Wisconsin }
County of Forest } ss.

I, William B. Cochrane, do hereby certify that on the 24th day of June, 1991, I found evidence of the North Quarter corner of Section 25 Township 40 North, Range 13 East, Fourth Principal Meridian, as described hereon; and that from this evidence I established a new monument and accessories as described hereon to perpetuate the original location of this corner.

Resident witnesses:

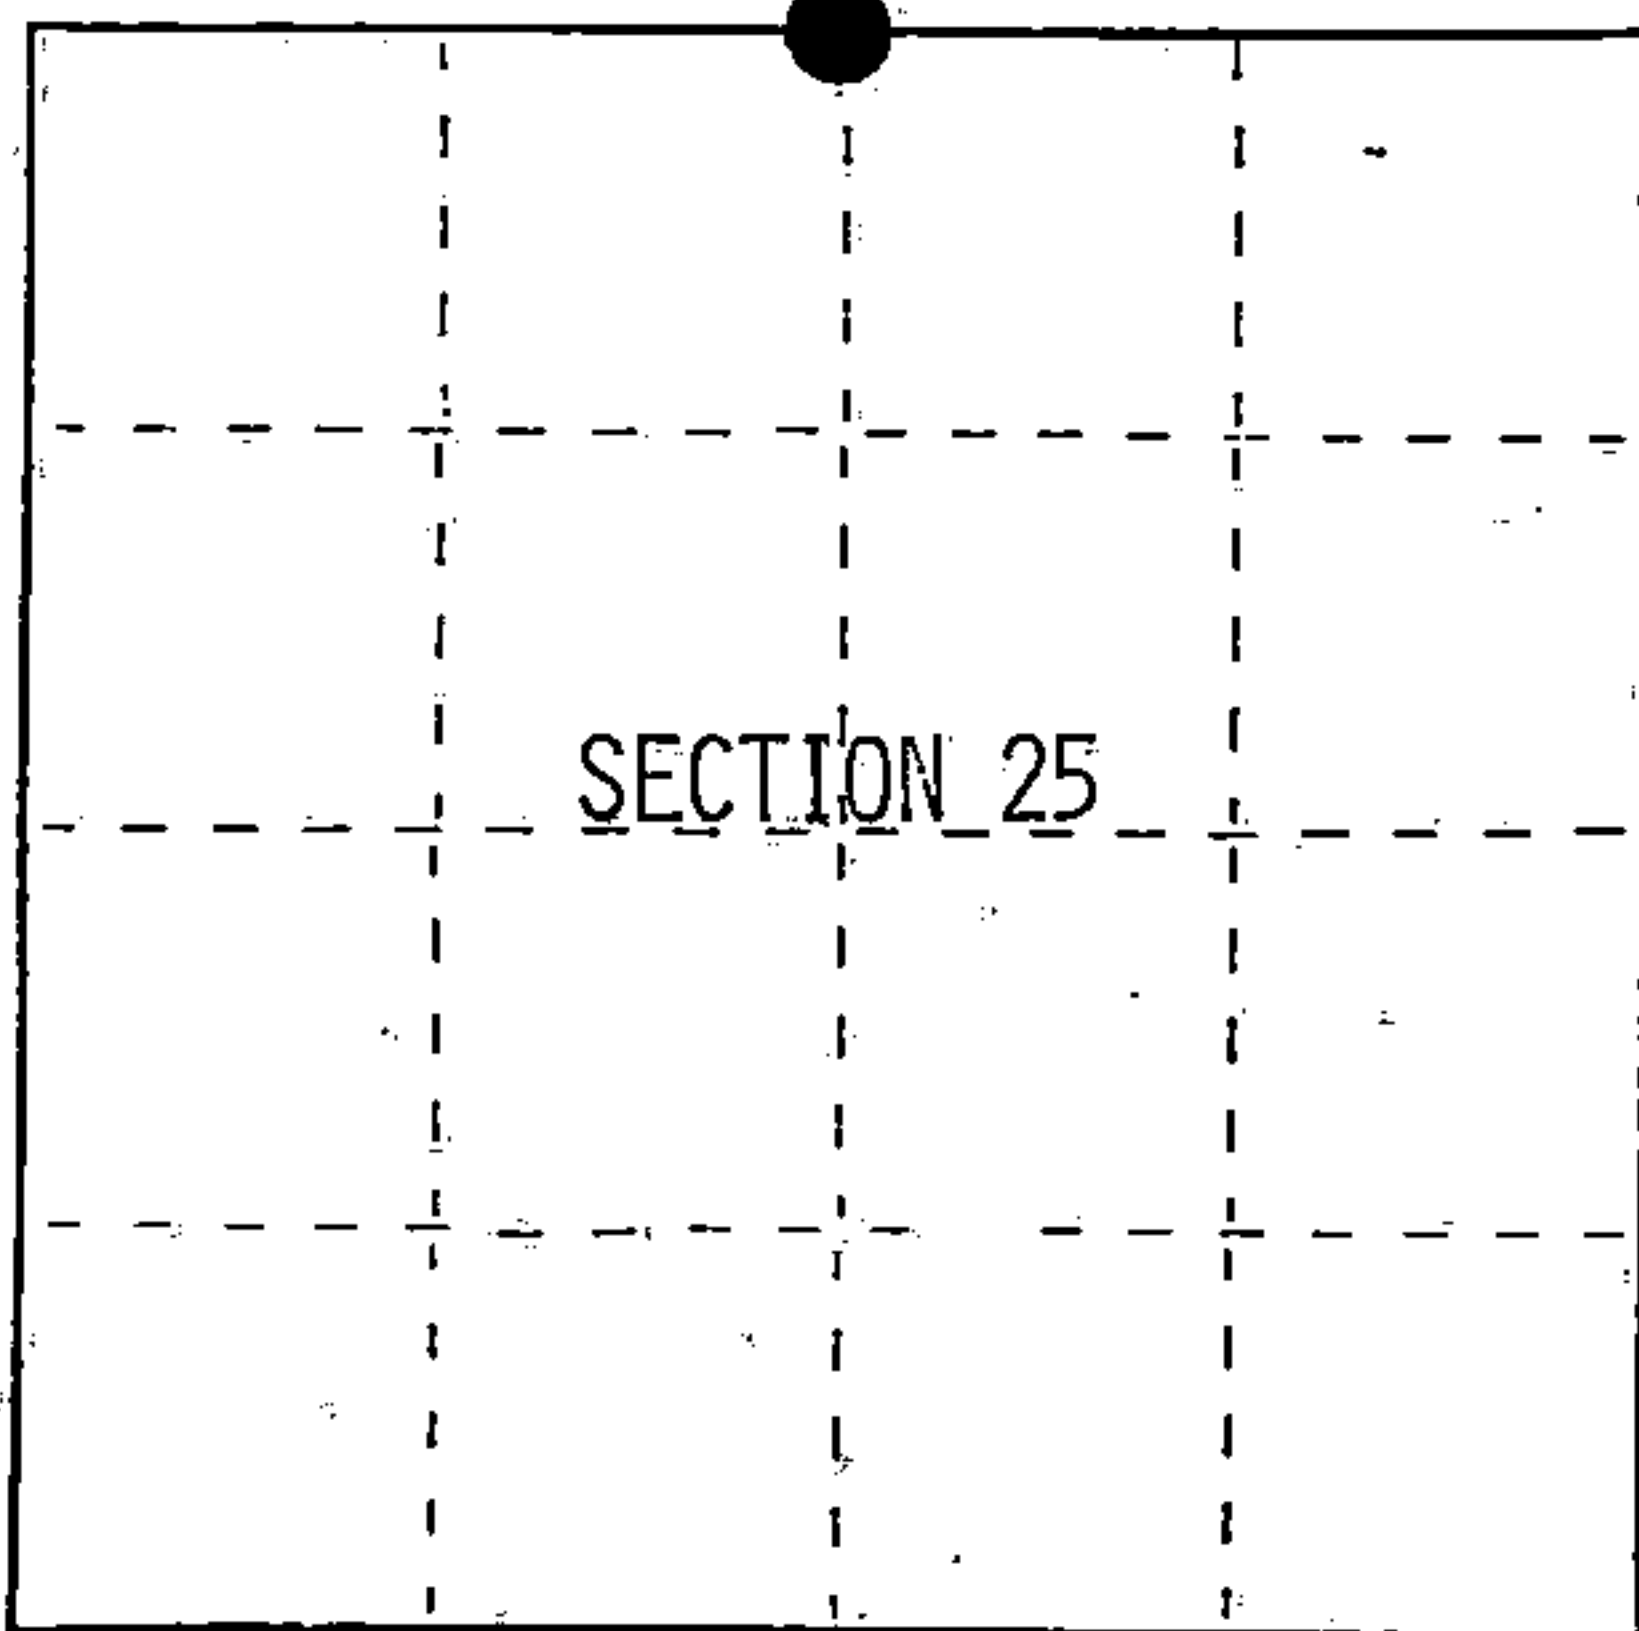

● = Corner monument restored.

History of original corner establishment:

Original Government Survey in 1865 by William E. Daugherty. West corrected between Sections 24 and 25, at 40.19 chains, set Quarter Section Post, from which the following bear;

Cedar	12"	N08°E	31 lks.
Cedar	10"	S55°W	21 lks.

Description of corner evidence found:

No corner evidence was recovered.

I re-established the corner position at mid-point and on line between the Northeast and Northwest Section Corners of Section 25.

Description of monument and accessories I established to perpetuate the original location of this corner. At the corner position, set a 2½ inch diameter aluminum pipe monument, 3 feet long, 2½ feet in the ground, with an aluminum cap stamped; T40N R13E, 1/4, S24, S25, 1991, S-1107. From which the following new blazed and scribed bearing trees bear;

Aspen	3"	N62°E	7.84 feet
Aspen	7"	N02°W	10.31 feet
Set- Steel Sign Post		SW	0.75 feet

Dated at Hiles, Wis., this 19th day of February, 1992


Signature *William B. Cochrane* Title Land Surveyor Registration No. S-1107
(County Surveyor, Registered Land Surveyor, or other duly authorized official)

Office of Register of Deeds, County of Forest, I hereby certify that the within instrument was filed in this office for record on the 31st day of August, 1992 at 10:15 o'clock A.M.

Paul A. Schreiber
(Register of Deeds)

By _____ Deputy

FORM NO. 985-A

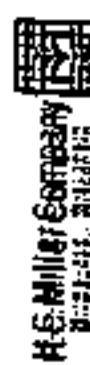

Stock No. 26273
DOCUMENT NUMBER
145378

44013240020

