

CERTIFIED LAND CORNER RESTORATION

State of Wisconsin }
County of Forest } ss.

I Jean F. Resvick, do hereby certify that on the 10 day of September, 1976, I found evidence of the Southeast Section corner of Section 33 Township 40 North Range 13 East, Fourth Principal Meridian, as described hereon; and that from this evidence I established a new monument and accessories as described hereon to perpetuate the original location of this corner:

Description of original monument and accessories and subsequent restorations:


Surveyed in 1858 by Alfred Millard.
West between sections 3 and 24. 80.0 chains set post corner to sections 3,4,33 and 34.
Cedar, 7, N25°E, 11 lks.
Tamarack, 14, S80°E, 2 lks
Spruce, 7, S45°W, 21 lks.
Cedar, 12, N80°W, 12 lks.

Description of corner evidence found:

4"x4" fallen and very rotten wood post and old post point
From the post point: Tamarack stump, bears S80°E, 2 lks.
Cedar stump, bears N25°E, 11 lks.
Cedar stump, bears N80°W, 12 lks.
No evidence of the spruce

Description of monument and accessories I established to perpetuate the location of this corner:

Replaced the post point with a 2 inch inside diameter, galvanized pipe, 5 feet long, filled with concrete, with a brass cap stamped:
T40N R13E, S33, S34, T39N, S3, S4, 1977, S-802
From which the following bear:
Cedar, 7", N47°E, 6.63 feet
Cedar 7", S66°E, 6.70 feet
Cedar, 12", S52°W, 13.64 feet
Cedar 7", N61°W, 17.70 feet
Set a steel sign post, NW, 0.50 ft.

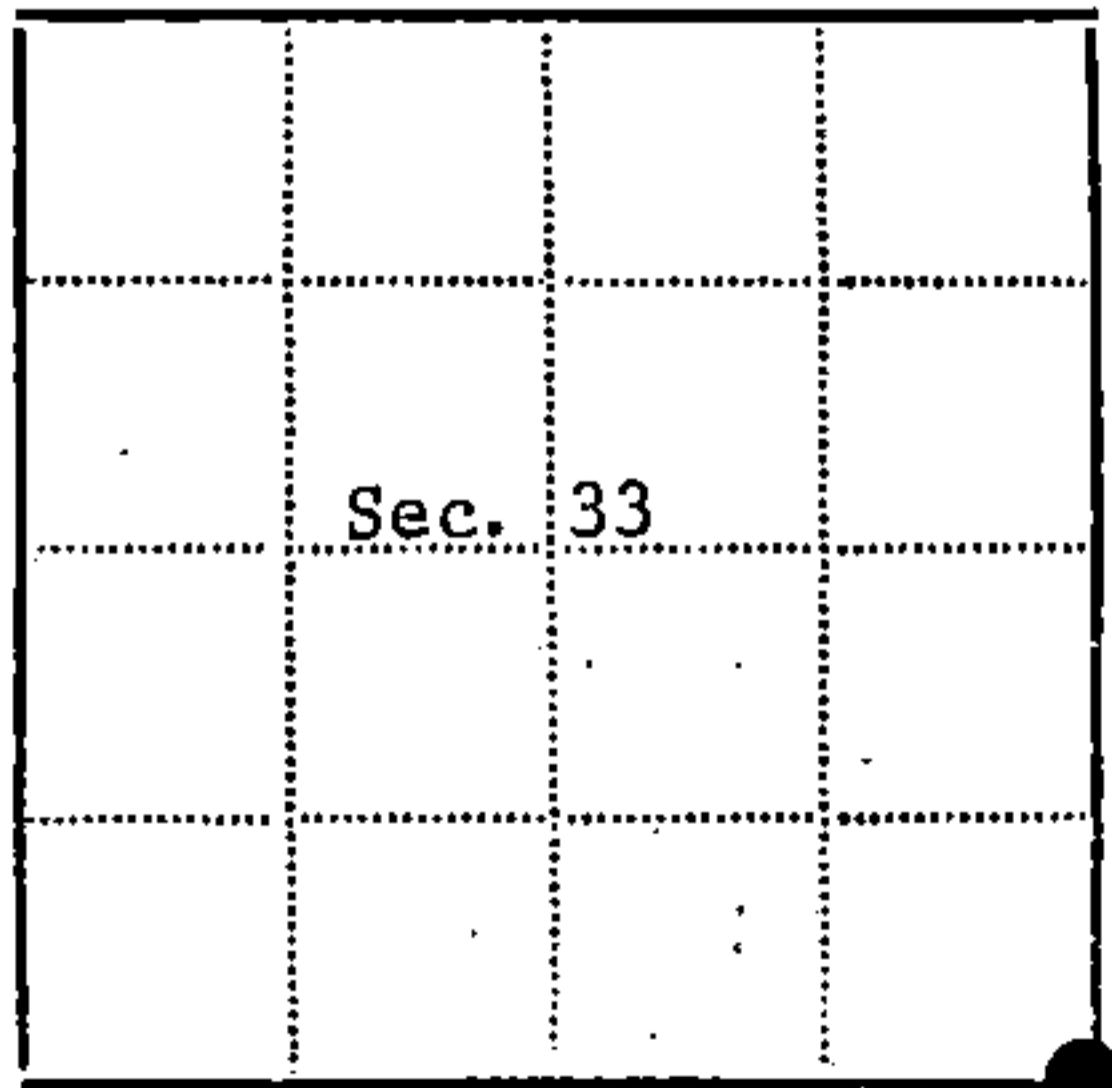

● - Corner monument restored
□ -

Resident witnesses.....

Dated at Rhinelander Wisconsin, this 20 day of July 1977.

Signature *Jean F. Resvick* Title Land Surveyor
(County Surveyor, Registered Land Surveyor, or other duly authorized official)

Surveyors Registration No. S-802 DOCUMENT NUMBER 113312

Office of Register of Deeds County of Forest

I hereby certify that the within instrument was filed in this office for record on the 13th day of February 1978, and was filed in Book No. Page No. of County Records.

Signature *Eugene Staszny* Title Register of Deeds

Township 40 North Range 13 East Section 33 Index No. Z-13 Page No.

213