

U.S. PUBLIC LAND SURVEY MONUMENT RECORD


Index No. X-17

State of Wisconsin }
 County of Forest } ss.

I, William B. Cochrane, do hereby certify that on the 21st day of October, 1991, I found evidence of the West Quarter corner of Section 35 Township 40, North, Range 13 East, Fourth Principal Meridian, as described hereon; and that from this evidence I established a new monument and accessories as described hereon to perpetuate the original location of this corner.

Resident witnesses:

.....

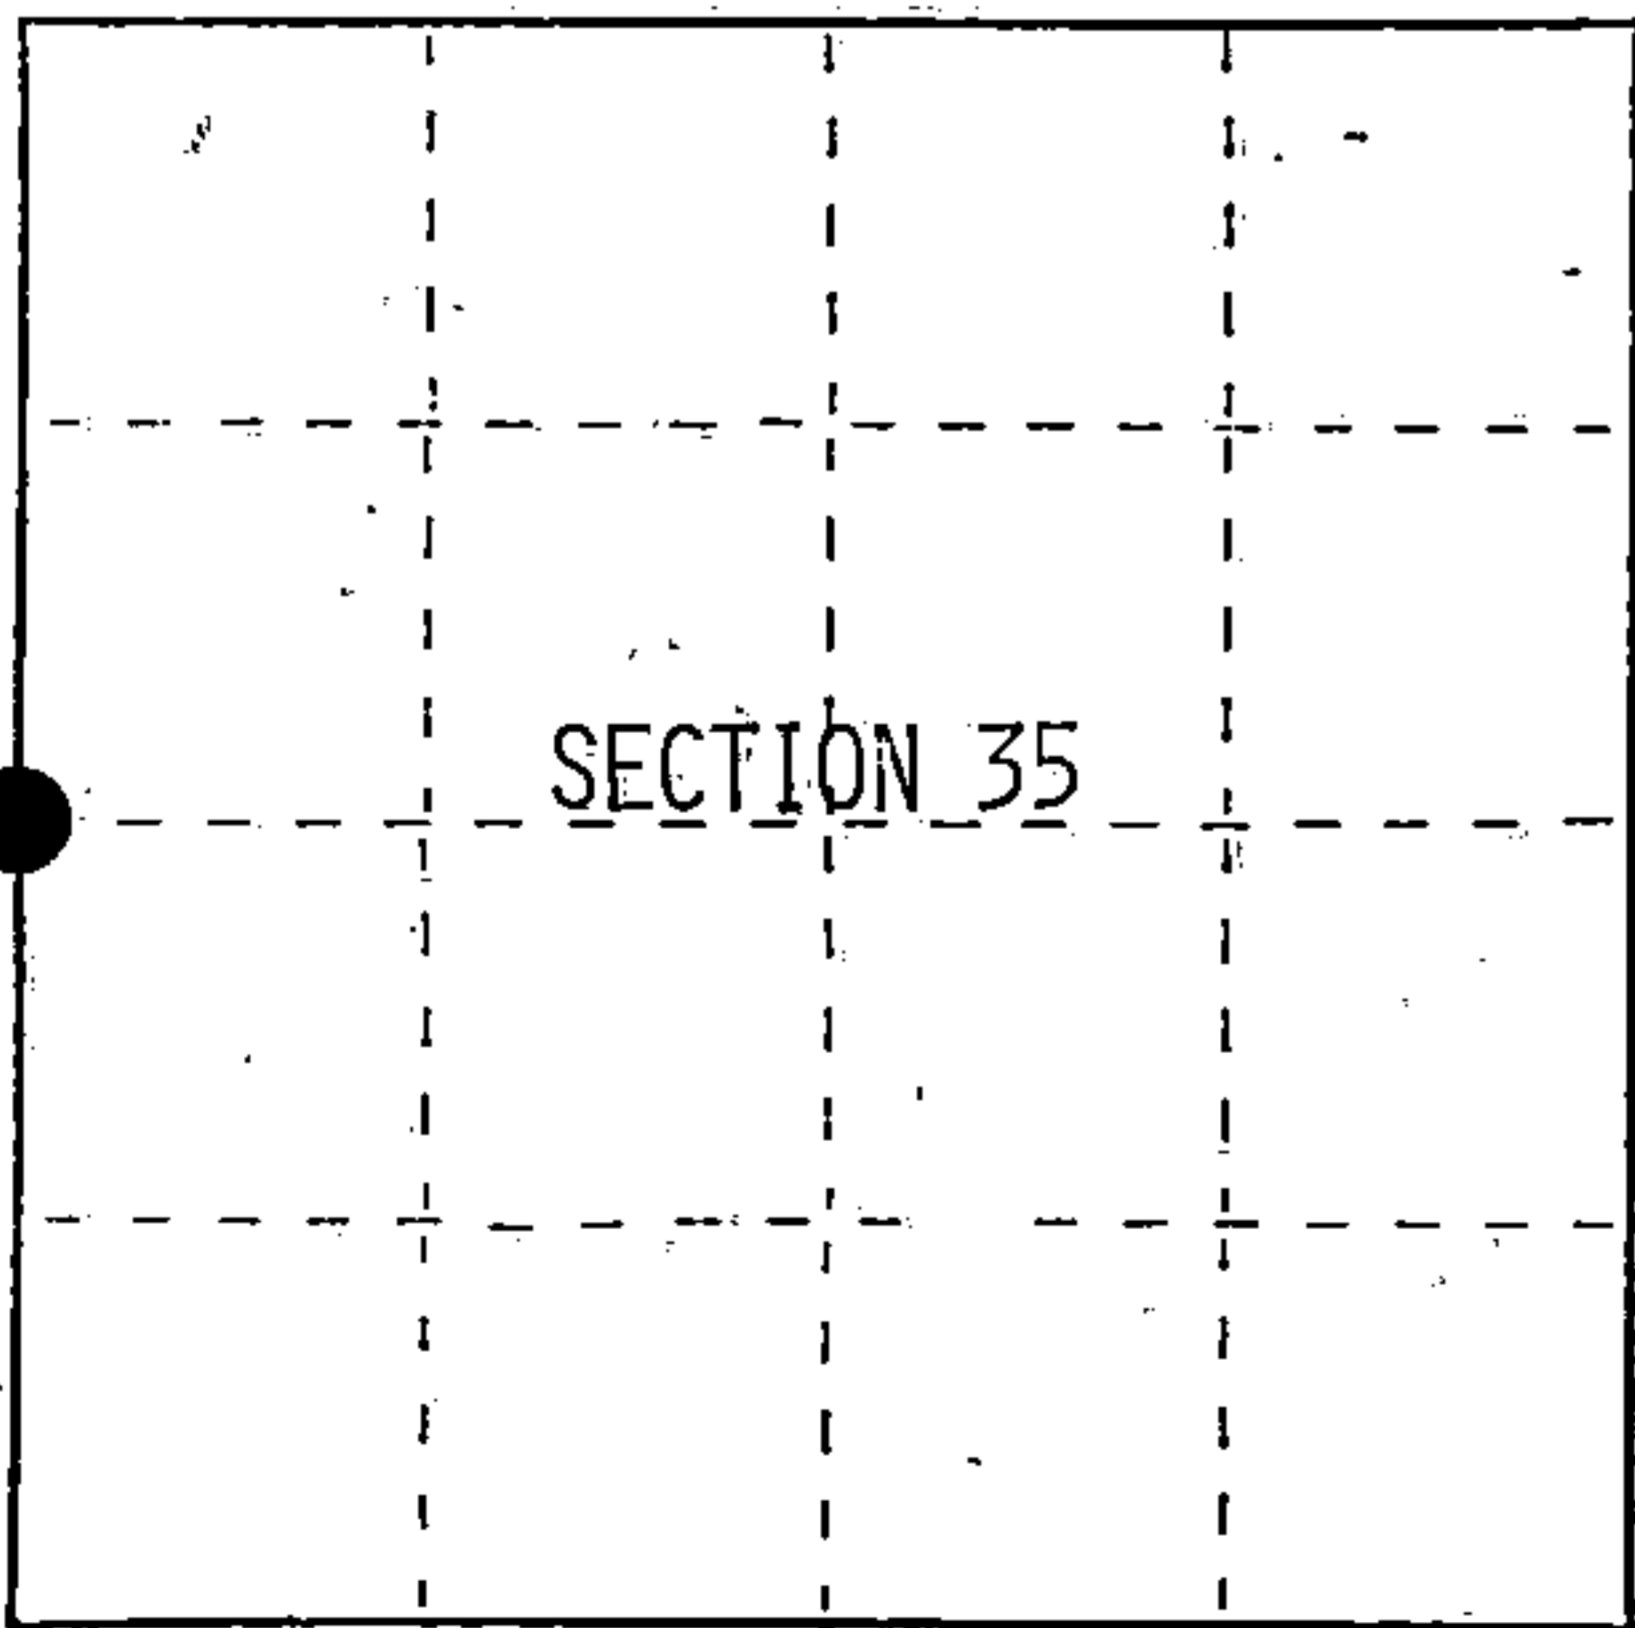

● = Corner monument restored.

History of original corner establishment:

Original Government Survey in 1865 by William E. Daugherty. North between Sections 34 and 35, at 40.00 chains, set Quarter Section Post, from which the following bear;

Cedar	6"	S18°E	62 lks.
Cedar	5"	N71°W	17 lks.

Description of corner evidence found:

No corner evidence was recovered.

I re-established the corner position at mid-point and on line between the Northwest and Southwest Section Corners of Section 35.

Description of monument and accessories I established to perpetuate the original location of this corner.

At the corner position, set a 2½ inch diameter aluminum pipe monument, 3 feet long, 2½ feet in the ground, with an aluminum cap stamped; T40N R13E, 1/4, S34, S35, 1991, S-1107. From which the following new blazed and scribed bearing trees bear;

Cedar	9"	S14°E	33.87 feet
Cedar	9"	S54°W	18.36 feet
Steel Sign Post		Southeast	0.75 feet

Dated at Hiles, Wis., this 19th day of February, 1992

Signature William B. Cochrane Title Land Surveyor Registration No. S-1107
 (County Surveyor, Registered Land Surveyor, or other duly authorized official)

Office of Register of Deeds, County of Forest, I hereby certify that the within instrument was filed in this office for record on the 31st day of August, 1992 at 10:15 o'clock A. M.

Paul Aschenbrenner
 (Register of Deeds)

By.....Deputy

FORM NO. 985-A
 Requiring Correct Filing

Stock No. 26273
 DOCUMENT NUMBER
 145387

44013342000

