

U.S. PUBLIC LAND SURVEY MONUMENT RECORD

Index No. A-21

State of Wisconsin }
County of Forest } ss.

I, William B. Cochran, do hereby certify that on the 27th day of August, 1984, I found evidence of the Northwest Closing Corner corner of Section 1 Township 40 North, Range 14 East, Fourth Principal Meridian, as described hereon; and that from this evidence I established a new monument and accessories as described hereon to perpetuate the original location of this corner.

Resident witnesses:

Tony Tillman

History of original corner establishment:

Original Government Survey in 1865 by William E. Daugherty. North between Sections 1 and 2, 79.41 chains, set Section Corner Post to Sections 1 and 2, from which the following bear;

Birch 14" S16°E 159 lks.
Fir 4" S36°W 84 lks.

Intersect correction line 37.27 chains East of Corner to Sections 35 and 36, T41N R14E.

Description of corner evidence found:


No corner evidence was recovered.

The corner position was re-established at proportionate distance and on line between the Standard Quarter Corner of Section 36, and the Standard Section Corner common to Sections 35 and 36, T41N R14E.

Description of monument and accessories I established to perpetuate the original location of this corner.

At the re-established corner position, set a 2½" diameter aluminum pipe monument, 5 feet long, 4 feet in the ground, with an aluminum cap stamped; T41N R14E, S1, S2, T40N, 1984, S-1107. From which the following new blazed and scribed bearing trees bear;

Aspen 6" N40°E 105.80 feet
Aspen 9" North 91.30 feet
Steel Sign Post NW 1.60 feet

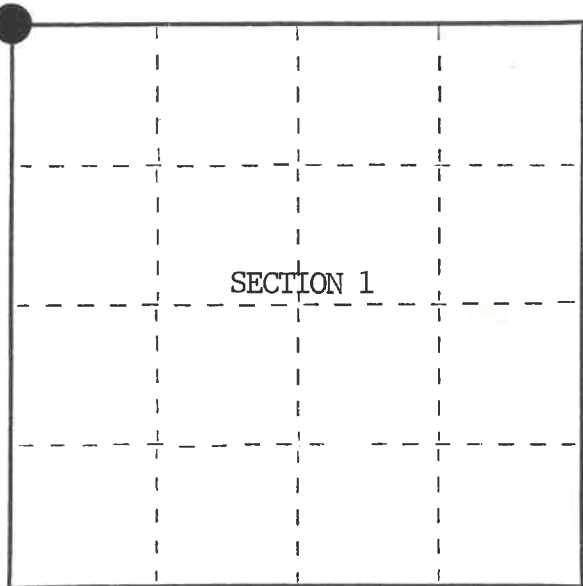

○ = Corner monument restored.

Dated at Hiles, Wis., this 23rd day of December, 1985.

Signature: William B. Cochran, Title: Land Surveyor, Registration No. S-1107
(County Surveyor, Registered Land Surveyor, or other duly authorized official)

Office of Register of Deeds, County of Forest, I hereby certify that the within instrument was filed in this office for record on the 11th day of March, 1987 at 3:30 o'clock P.M.

Paul Aschenbrenner
(Register of Deeds)

By _____ Deputy

FORM NO. 985-A

H.C. Miller Company
MILWAUKEE, WISCONSIN

Stock No. 26273

DOCUMENT NUMBER 132432

44014024000

