

U.S. PUBLIC LAND SURVEY MONUMENT RECORD

Index No. C-17

State of Wisconsin }  
County of Forest } ss.

I, William B. Cochrane, do hereby certify that on the 28th day of August, 1984, I found evidence of the West Quarter corner of Section 2 Township 40 North, Range 14 East, Fourth Principal Meridian, as described hereon; and that from this evidence I established a new monument and accessories as described hereon to perpetuate the original location of this corner.

Resident witnesses:

Tony Tillman

History of original corner establishment:

Original Government Survey in 1865 by William E. Daugherty. Dependent Resurvey in 1944 by Hugh Crawford. North between Sections 2 and 3, 39.32 chains, corner position falls at the Northeast corner of a property line fence. No monument set or bearing trees made.

Description of corner evidence found:

Metal fence post lying alongside a 4"x4" Wood Post.


I accept the metal fence post alongside the Wood Post as the best available evidence for restoring the corner position.

No original corner evidence was recovered.

Description of monument and accessories I established to perpetuate the original location of this corner.

At the restored corner position, set a 2 1/2" diameter aluminum pipe monument, 3 feet long, 2 1/2 feet in the ground, with an aluminum cap stamped; T40N R14E, 1/4, S2, S3, 1984, S-1107. From which the following new blazed and scribed bearing trees bear;

Spruce	9"	N70°E	41.32 feet
Aspen	11"	S38°E	21.88 feet
Steel Sign Post		SW	0.50 feet

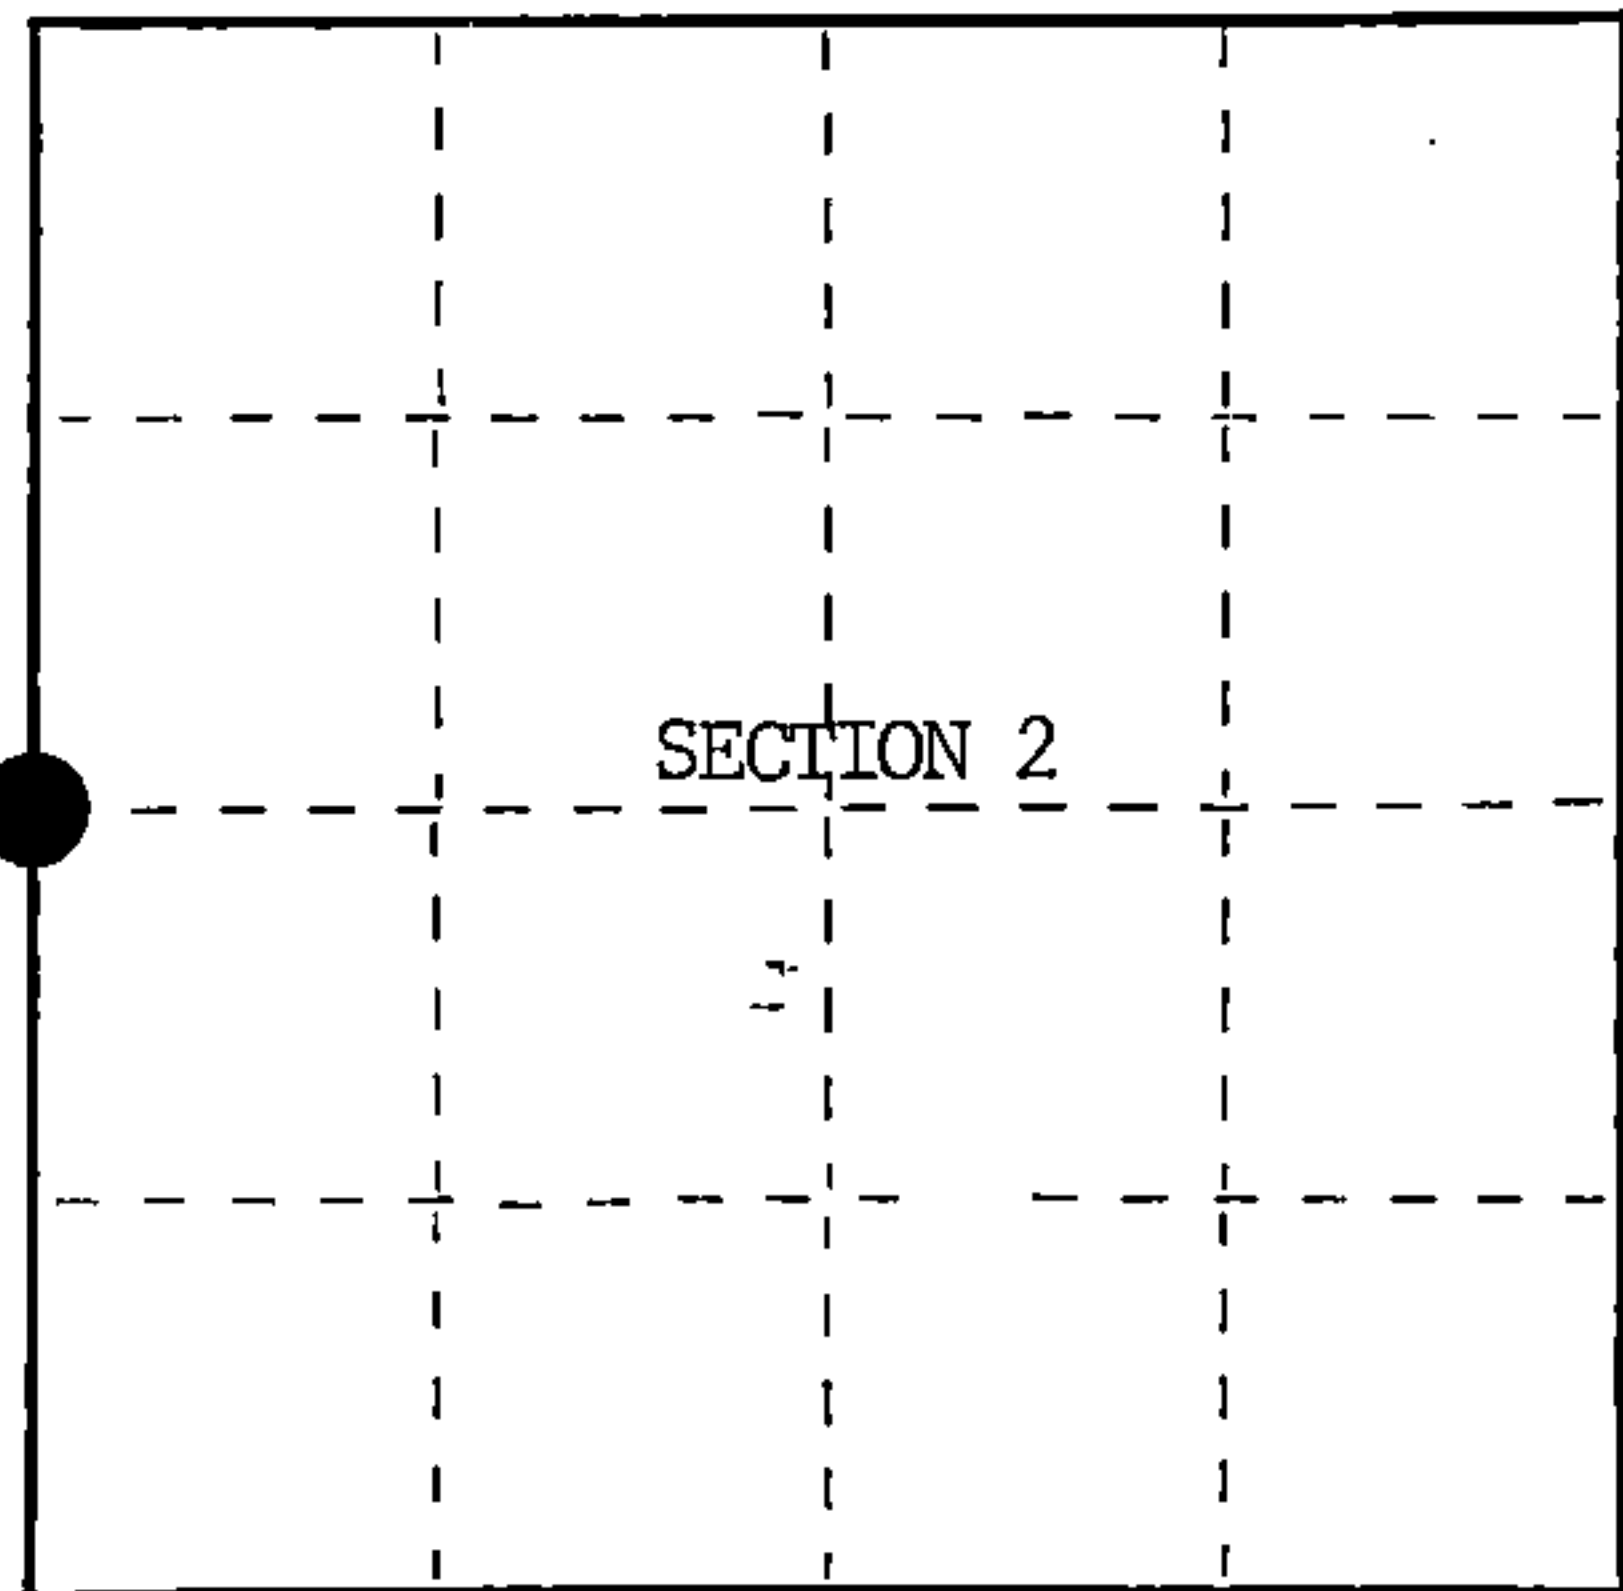

○ = Corner monument restored.

Dated at Hiles, Wis., this 23rd day of December, 1985.


Signature: *William B. Cochrane* Title: Land Surveyor Registration No. S-1107  
(County Surveyor, Registered Land Surveyor, or other duly authorized official)

Office of Register of Deeds, County of Forest, I hereby certify that the within instrument was filed in this office for record on the 11th day of March, 1987 at 3:30 o'clock P.M.

*Paul Aschenbrenner*  
(Register of Deeds)

By \_\_\_\_\_ Deputy

FORM NO. 985-A

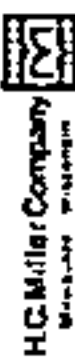

Stock No. 26273

DOCUMENT NUMBER 132439

44014032000

