

U.S. PUBLIC LAND SURVEY MONUMENT RECORD

Index No. A-5

State of Wisconsin }
 County of Forest } ss.

I, William B. Cochrane, do hereby certify that on the 23rd day of July, 1986, I found evidence of the Northwest Closing Section corner of Section 5 Township 40, North, Range 14 East, Fourth Principal Meridian, as described hereon; and that from this evidence I established a new monument and accessories as described hereon to perpetuate the original location of this corner.

Resident witnesses:

David Brownell

Tony Tillman

History of original corner establishment:

Original Government Survey in 1865 by William E. Daugherty. North between Sections 5 and 6, at 81.10 chains, intersect 4th Correction Line 289 links West of the Standard Quarter Section Corner of Section 31, T41N R14E. At the corner position set a Wood Post, from which the following bear;

Birch	14"	S49°E	40 lks.
Birch	8"	S14°W	35 lks.

Description of corner evidence found:


No corner evidence was recovered.

The corner position is re-established at proportionate distance and on line between the Standard Section Corner common to Sections 31 and 32, and the Standard Quarter Section Corner of Section 32.

Description of monument and accessories I established to perpetuate the original location of this corner.

At the corner position, set a 2½ inch diameter aluminum pipe monument, 3 feet long, 2½ feet in the ground, with an aluminum cap stamped; T41N R14E, S32, S5, S6, CC, T40N, 1986, S-1107. From which the following new blazed and scribed bearing trees bear;

Spruce	6"	N63°E	22.21 feet
Spruce	7"	N62°W	12.45 feet
Steel Sign Post		NE	1.00 feet

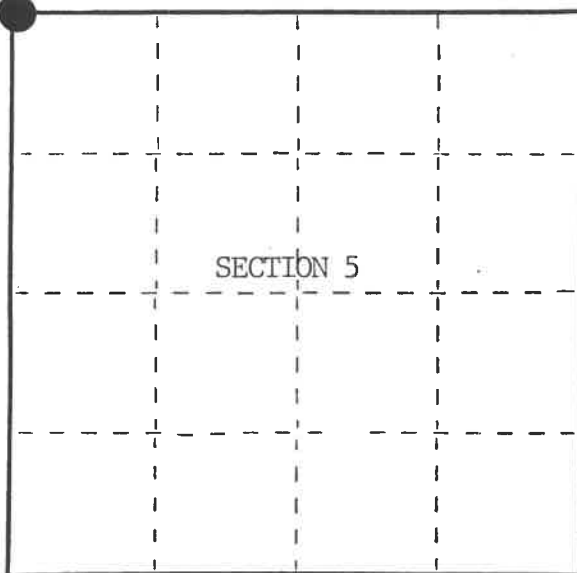

○ = Corner monument restored.

Dated at Hiles, Wis., this 28th day of October, 1986

Signature William B. Cochrane Title Land Surveyor Registration No. S-1107
 (County Surveyor, Registered Land Surveyor, or other duly authorized official)

Office of Register of Deeds, County of Forest, I hereby certify that the within instrument was filed in this office for record on the 11th day of March, 1987 at 3:30 o'clock P. M.

Paul Aschenbrenner
 (Register of Deeds)

By.....Deputy

FORM NO. 985-A



Stock No. 26273

DOCUMENT NUMBER 132426

44014064000

