


U.S. PUBLIC LAND SURVEY MONUMENT RECORD

Index No. L-5

State of Wisconsin }
County of Forest } ss.

I Gary L. Pisoni, do hereby
certify that on the 9th day
of September, 1989, I found
evidence of the East quarter
corner of: Section 18
Township 40, North, Range
14 East, Fourth Principal Meridian,
as described hereon; and that from this evidence
I established a new monument and accessories
as described hereon to perpetuate the original
location of this corner.

Resident witnesses:

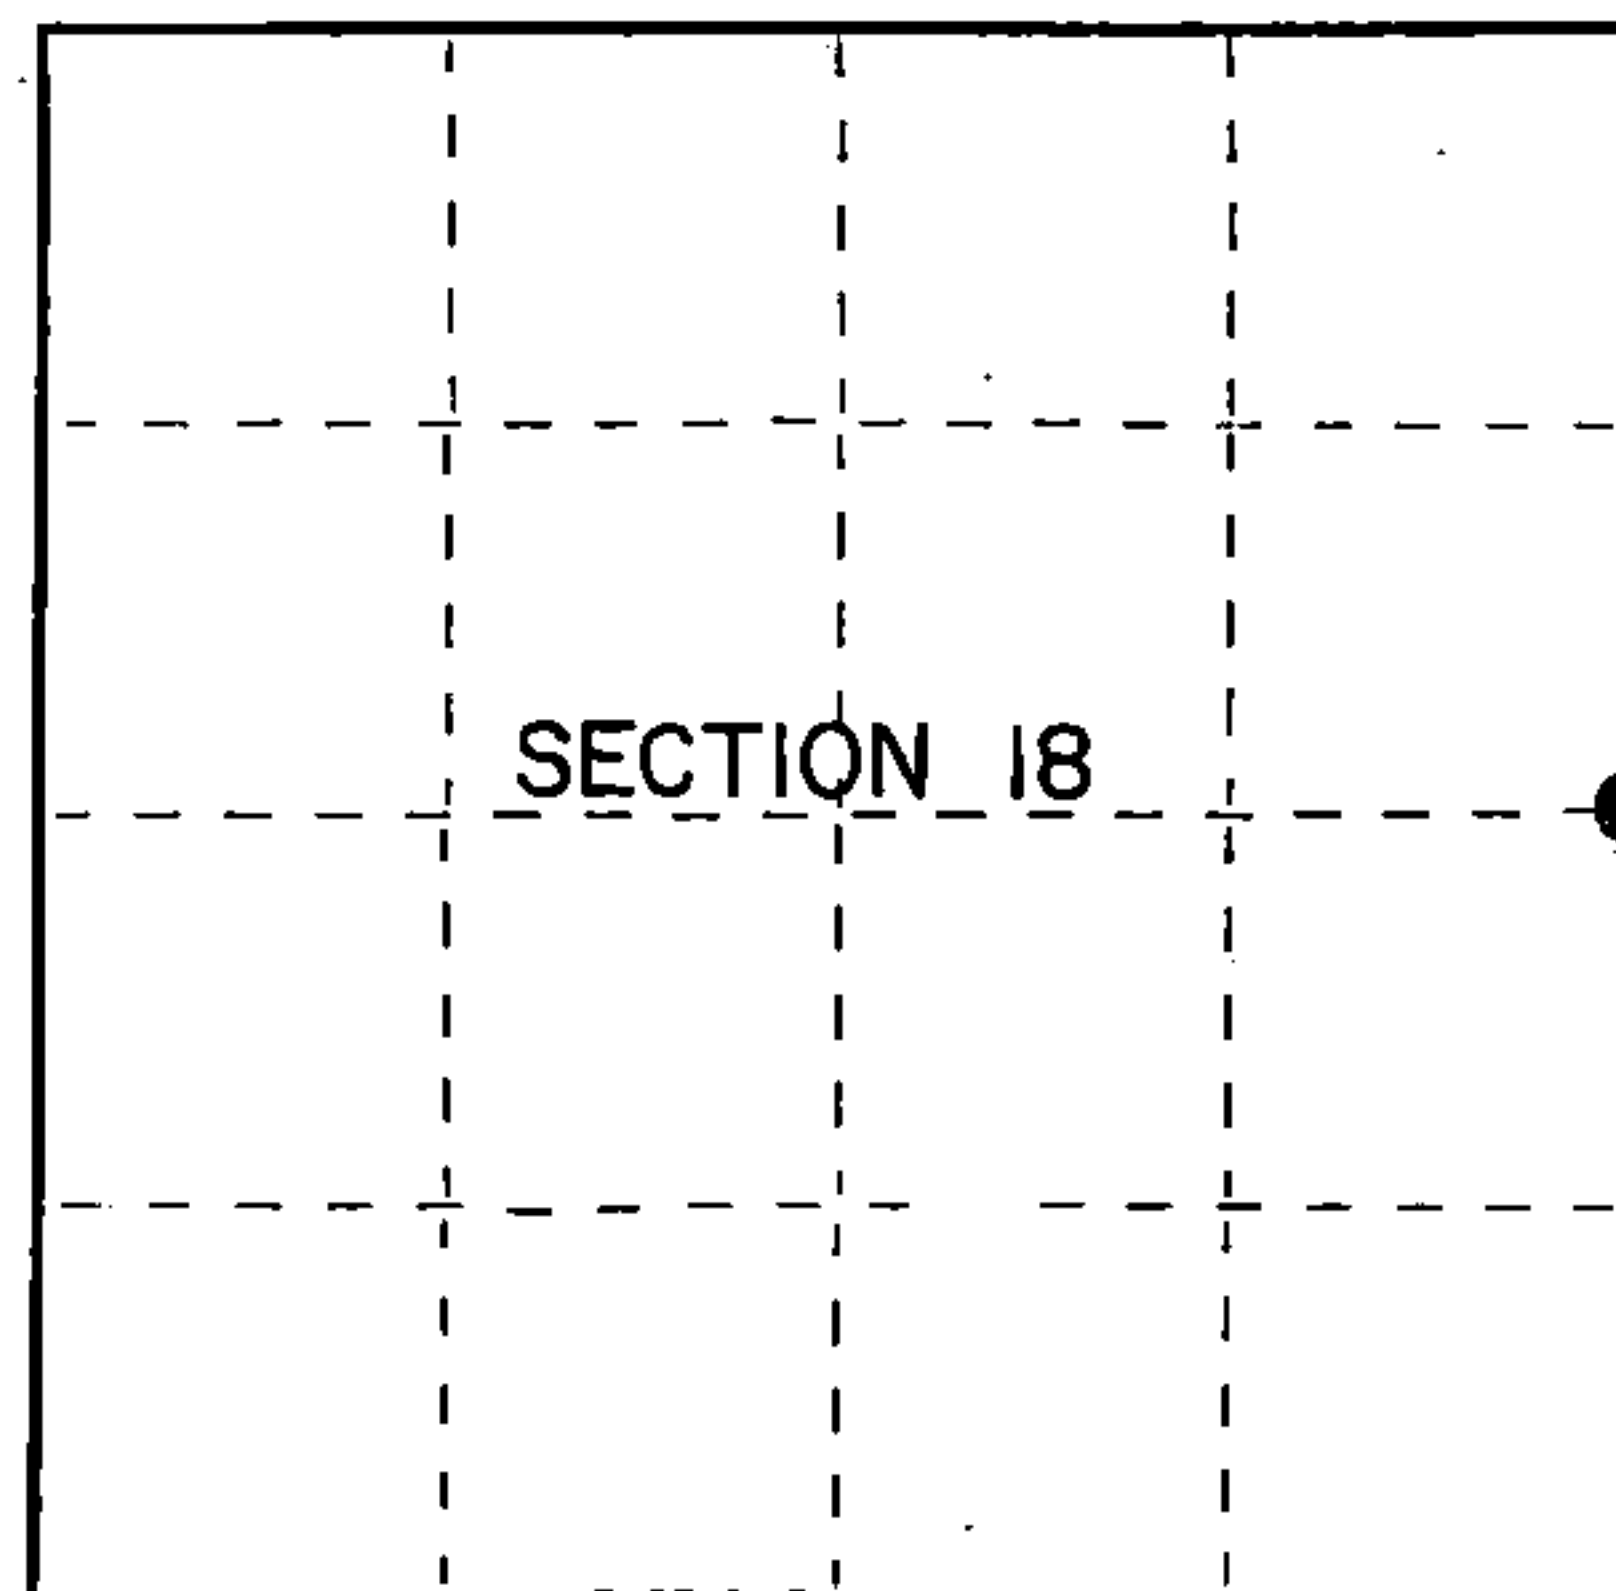

○ = Corner monument restored.

History of original corner establishment:

Original Government Survey in 1865 by William E. Daugherty.

In 1970-71, Jean F. Resvick, Land Surveyor for the U.S.F.S. restored this corner position with a 6" diameter by 3' long concrete post with a 3" diameter brass tablet embedded in concrete, corner restored at record distances from recovered meander corner on South shore of Animush Lake in accordance with the GLO 1925 supplemental plat of Sections 7-8, from which the following bear:

Jack Pine	9"	N 63° E	75.4 feet	Elm	7"	West	41.4 feet
Red Pine	6"	S 63° E	45.3 feet	Cedar sign post	East	20 feet	

Description of corner evidence found:

Found the monument as described above, from which the following bear:

Jack Pine	11"	N 63° E	75.4 feet
Red Pine	11"	S 63° E	45.3 feet
Cedar Sign post		East	20 feet

The monument was damaged, so I replaced it with the monument described below.

Description of monument and accessories I established to perpetuate the original location of this corner.

In place of damaged monument, set a 2½ inch diameter aluminum pipe monument, 3 feet long, 8 inches below roadbed surface with an aluminum capped stamped: T40N, R14E, 1/4, S-18, S-17, 1989, S-1634, from which the following new blazed and scribed referenced objects bear (all measurements taken to a nail in side of tree)

Basswood (clump)	12"	N 70° W	50.34 feet
------------------	-----	---------	------------

Dated at Iron River, MI, Wis., this 9th day of December, 1989

Signature Gary L. Pisoni Title Land Surveyor Registration No. S-1634
(County Surveyor, Registered Land Surveyor, or other duly authorized official)

Office of Register of Deeds, County of Forest, I hereby certify that the within instrument was filed in this office for record on the 20th day of September, 1990 at 10:45 o'clock A M.

(Register of Deeds)

By Paul Clithro Deputy

FORM NO. 985-A

H.C. Miller Company

Stock No. 26273

DOCUMENT NUMBER

140471

44047182000


- (e) Describe any material discrepancy between the location of the corner as restored or reestablished and the location of that corner as previously restored or reestablished by distance and direction. Show the discrepancy on the plan view drawing under (d), above. Show the distances between the corner as previously restored or reestablished and (1) the corner as restored or reestablished, and (2) to at least 2 of the witness monuments shown on the drawing in (d), above.

See drawing below

- (f) Was the corner restored through acceptance of (1) an obliterated evidence location, or, (2) a found perpetuated location?

Restored through acceptance of a found perpetuated location.

- (g&h) Was the corner reestablished through lost corner proportionate methods? If so, show the method, including the directions and distances to other public land survey corners used as evidence or used for proportioning in determining the corner location?

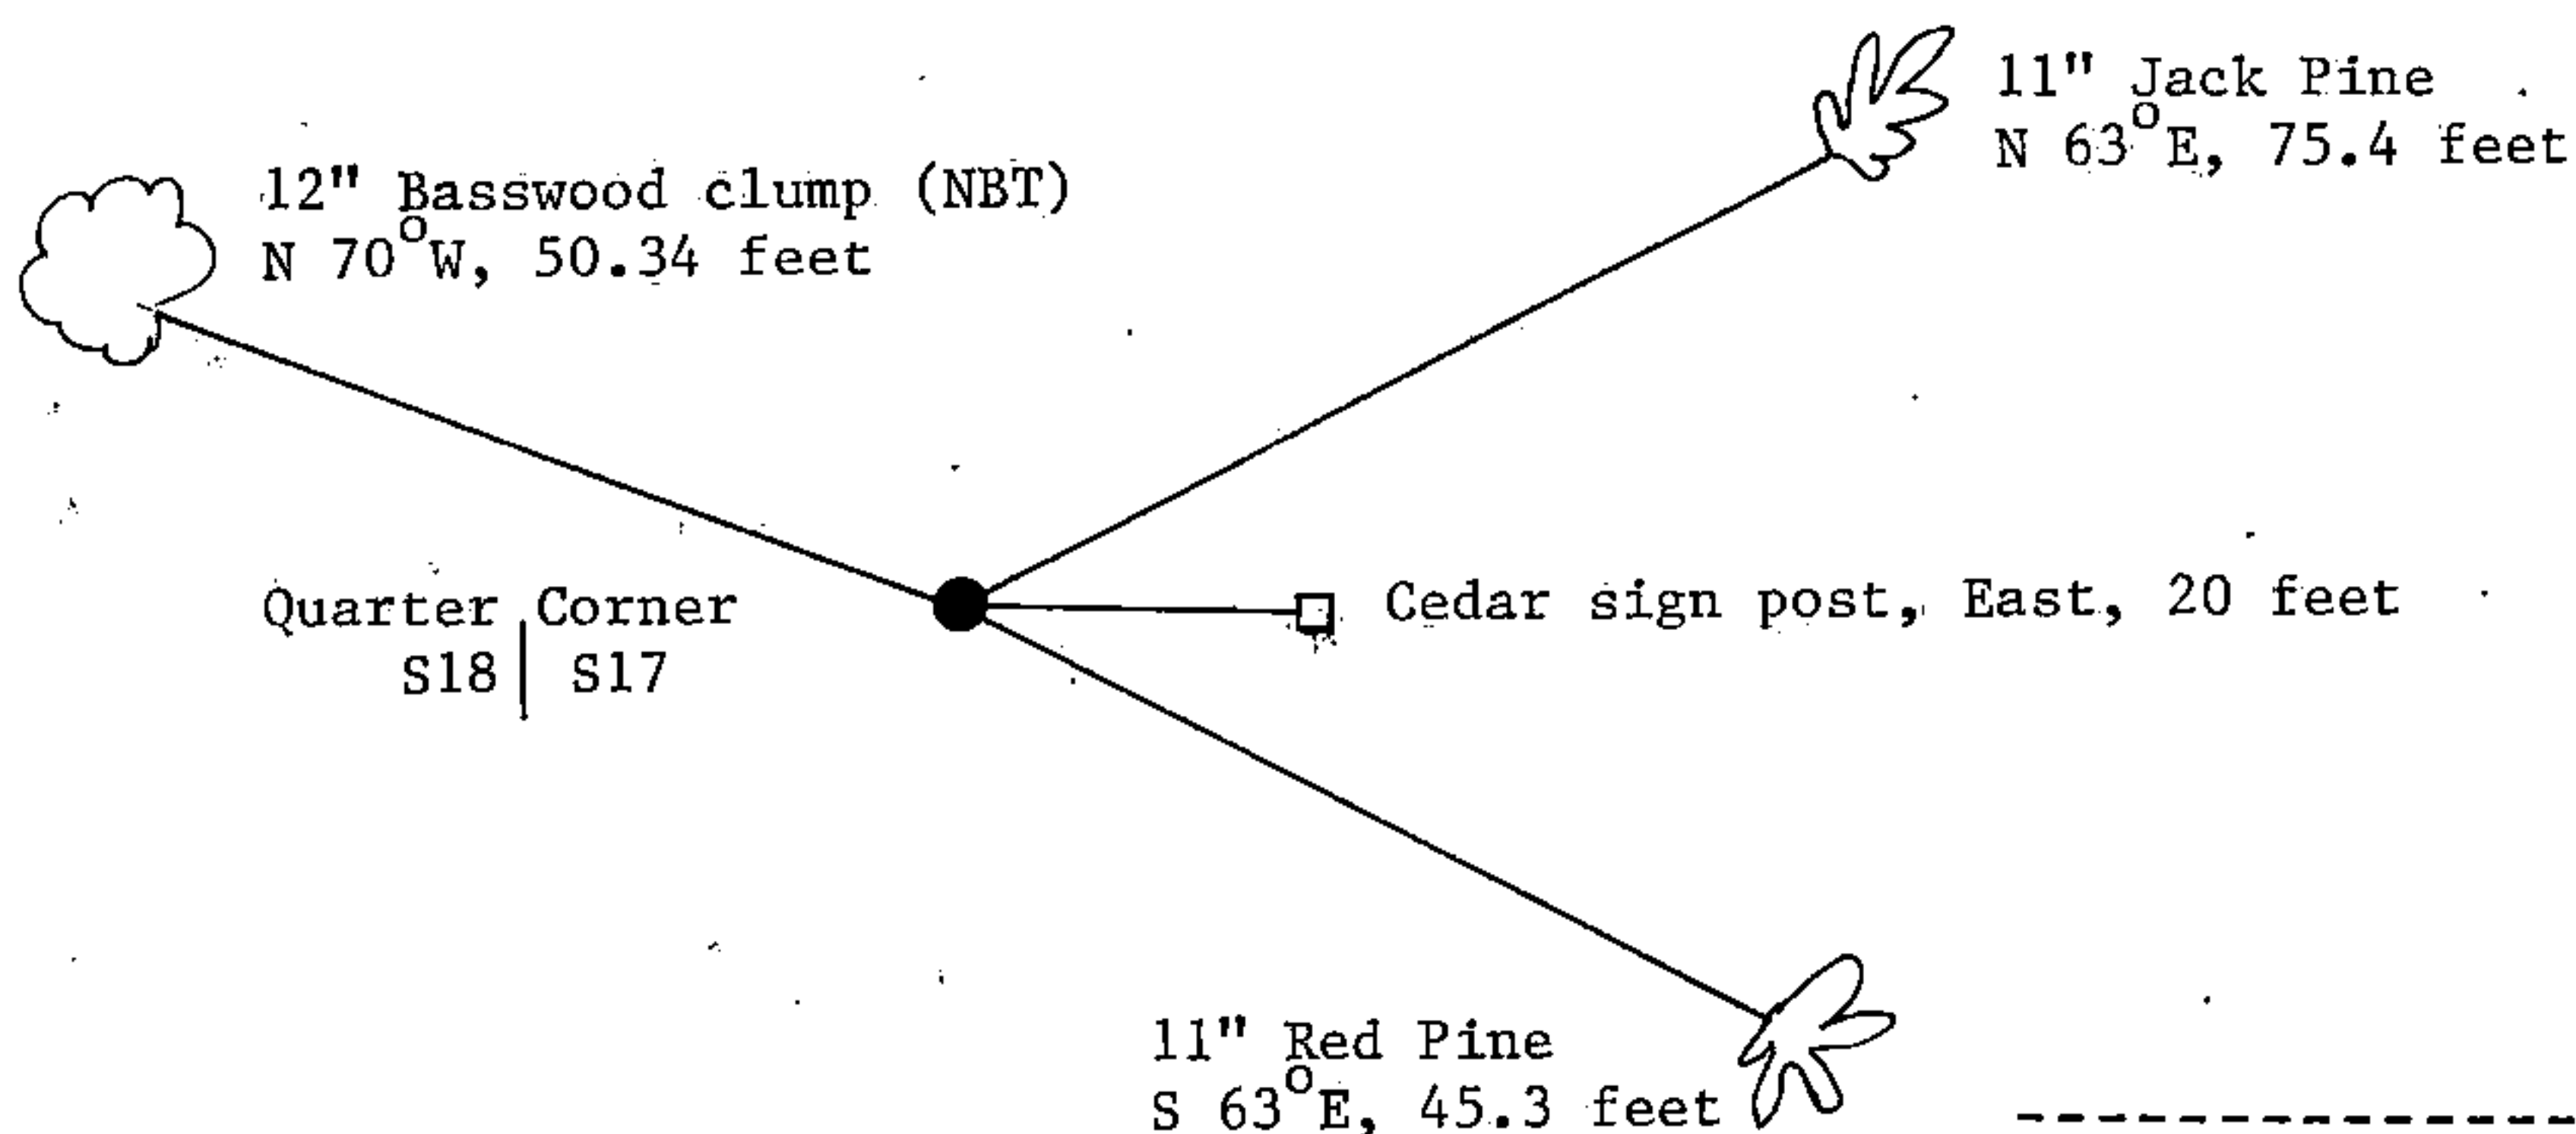

Gary L. Pisoni

- (i) I, Gary L. Pisoni (type or print name) certify that the corner location shown on this record was determined by me or under my direction and control and that this U.S. Public Land Survey Monument Record is correct and complete to the best of my knowledge and belief.



Signature

Date

Survey requested by:

District Ranger

Date