


U.S. PUBLIC LAND SURVEY MONUMENT RECORD

Index No. T-25

State of Wisconsin }
County of Forest } ss.

I Gary L. Pisoni, do hereby
certify that on the 29th day
of December, 19 89, I found
evidence of the East quarter
corner of Section 25
Township 40, North, Range
14 East, Fourth Principal Meridian,
as described hereon; and that from this evidence
I established a new monument and accessories
as described hereon to perpetuate the original
location of this corner.

Resident witnesses:

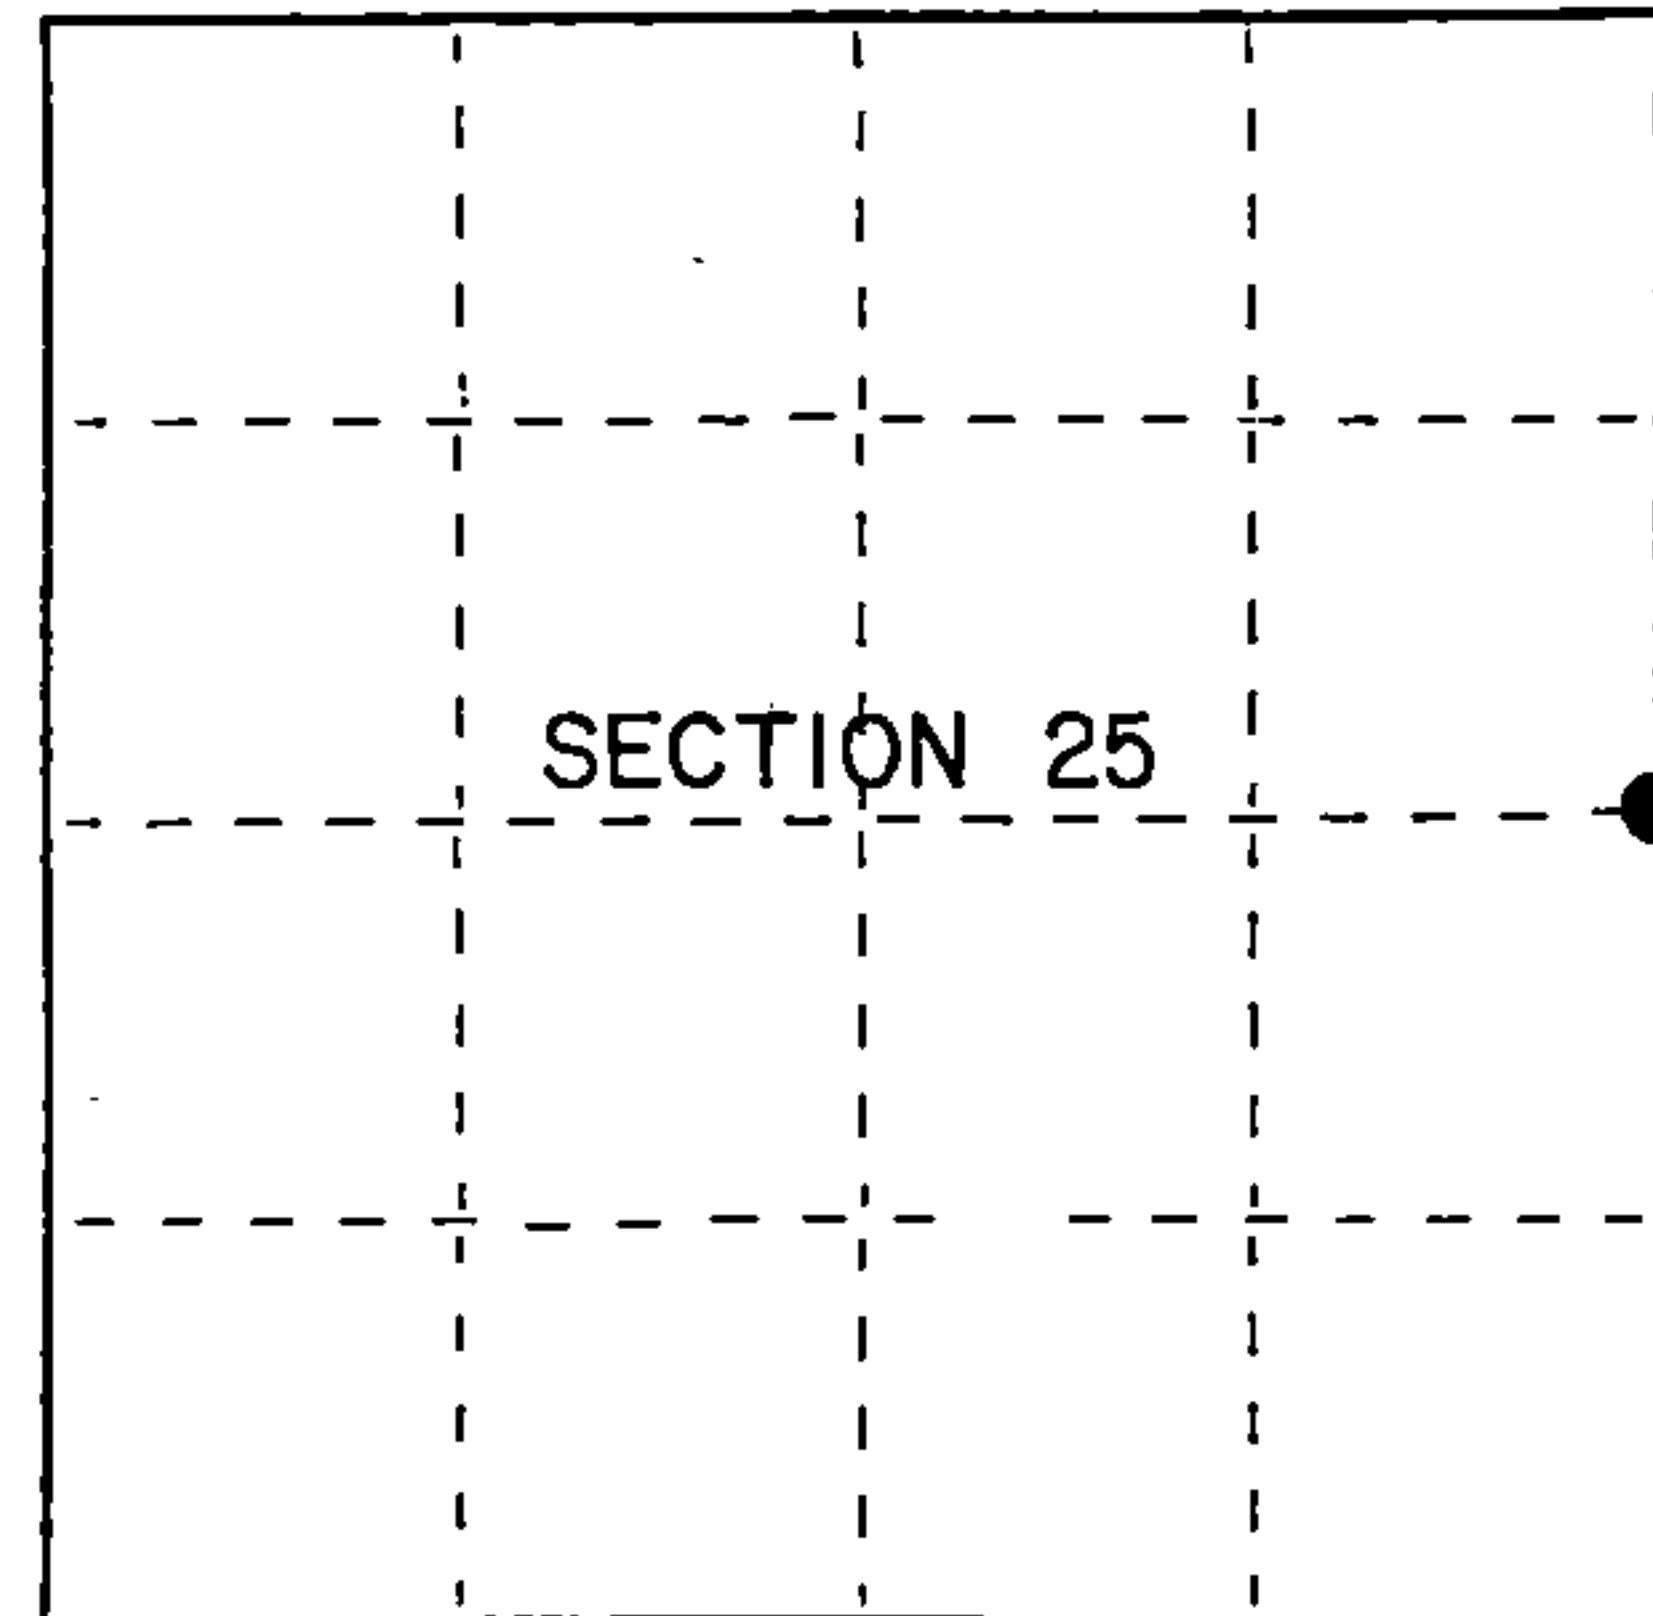

● = Corner monument restored.

History of original corner establishment:

Dependent resurvey in 1945 by Hugh B. Crawford; N 0°38'E between Sections 25 and 30, 39.72 chains, corner determined from the remains of original bearing trees, at the corner position set an iron post 3' long, 2" in diameter, 27" in the ground with brass cap marked: T40N, R14E, R15E, 1/4, S-25, S-30, 1945, from which the following bear:

Elm	12"	N 57½° E	42 links
Hemlock	16"	West	57 links

Description of corner evidence found:

Found monument as described above, 1945 bearing trees are all missing.

Description of monument and accessories I established to perpetuate the original location of this corner.

Blazed and scribed the following new bearing trees: (measurement taken to a nail in side of tree).

Ash	9"	N 07° W	27.41 feet
Ash	8"	N 55° E	6.98 feet
Ash	8"	S 54° W	10.88 feet
Steel sign post		N 61° W	0.9 feet

Dated at Iron River, MI, this 30th day of December, 19 89.

Signature Gary L. Pisoni Title Land Surveyor Registration No. S-1634
(County Surveyor, Registered Land Surveyor, or other duly authorized official)

Office of Register of Deeds, County of Forest. I hereby certify that the within instrument was filed in this office for record on the 20th day of September, 19 90 at 10:45 o'clock A. M.

(Register of Deeds)

By Shel Chitto Deputy

440142520000



- (d) Describe any material discrepancy between the location of the corner as restored or reestablished and the location of that corner as previously restored or reestablished by distance and direction. Show the discrepancy on the plan view drawing under (d), above. Show the distances between the corner as previously restored or reestablished and (1) the corner as restored or reestablished, and (2) to at least 2 of the witness monuments shown on the drawing in (d), above.

See drawing below

- (f) Was the corner restored through acceptance of (1) an obliterated evidence location, or, (2) a found perpetuated location?

Restored through acceptance of a found perpetuated location.

- (g&h) Was the corner reestablished through lost corner proportionate methods? If so, show the method, including the directions and distances to other public land survey corners used as evidence or used for proportioning in determining the corner location?

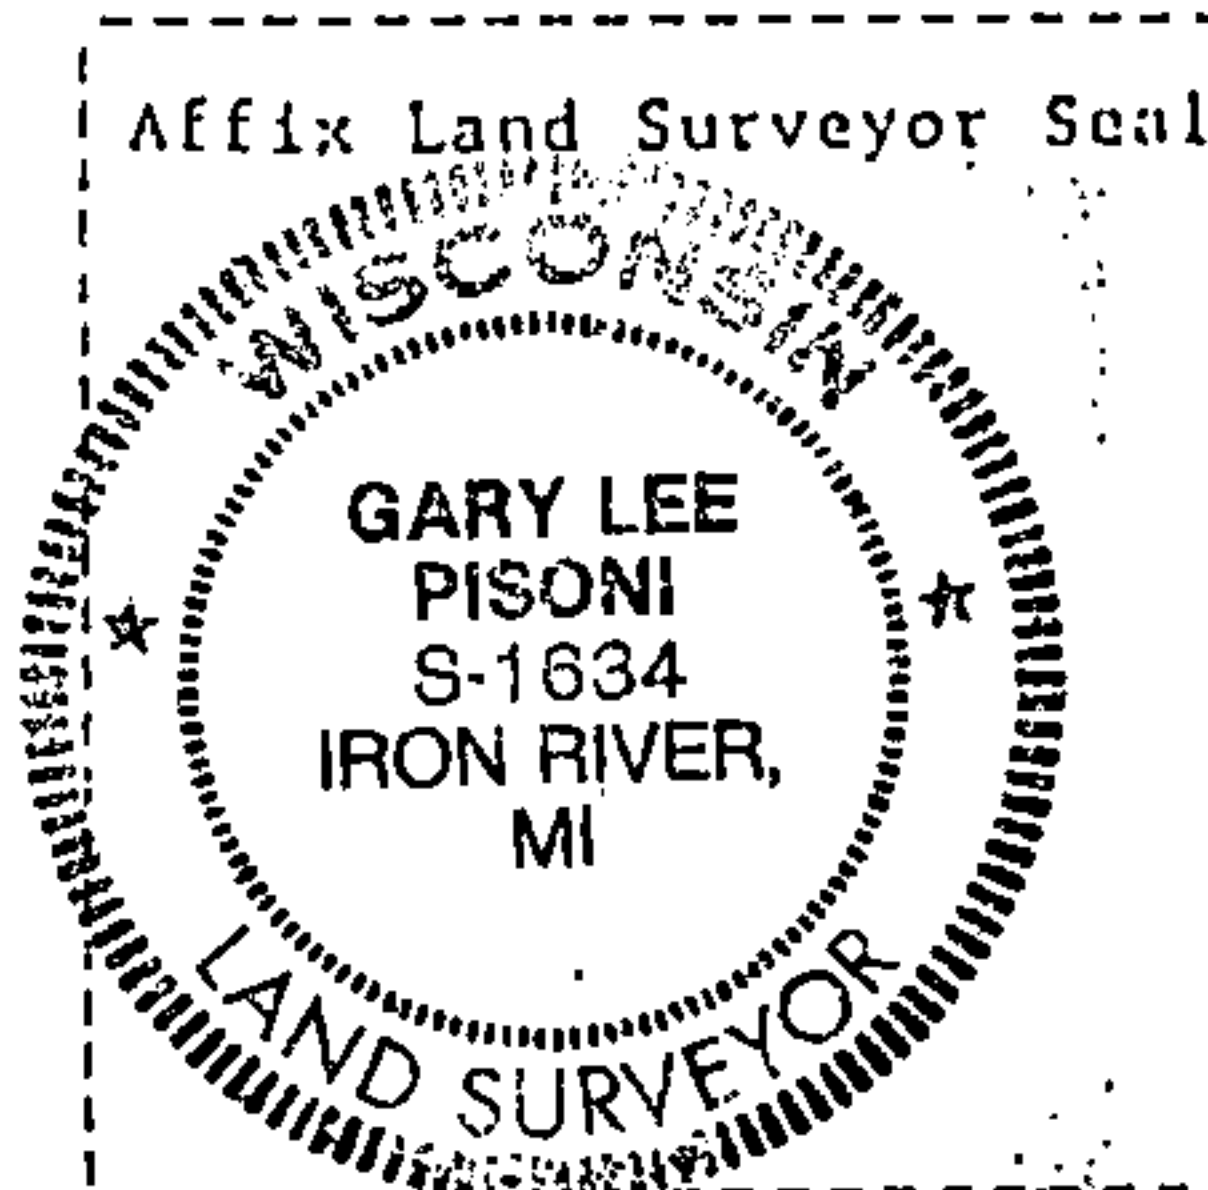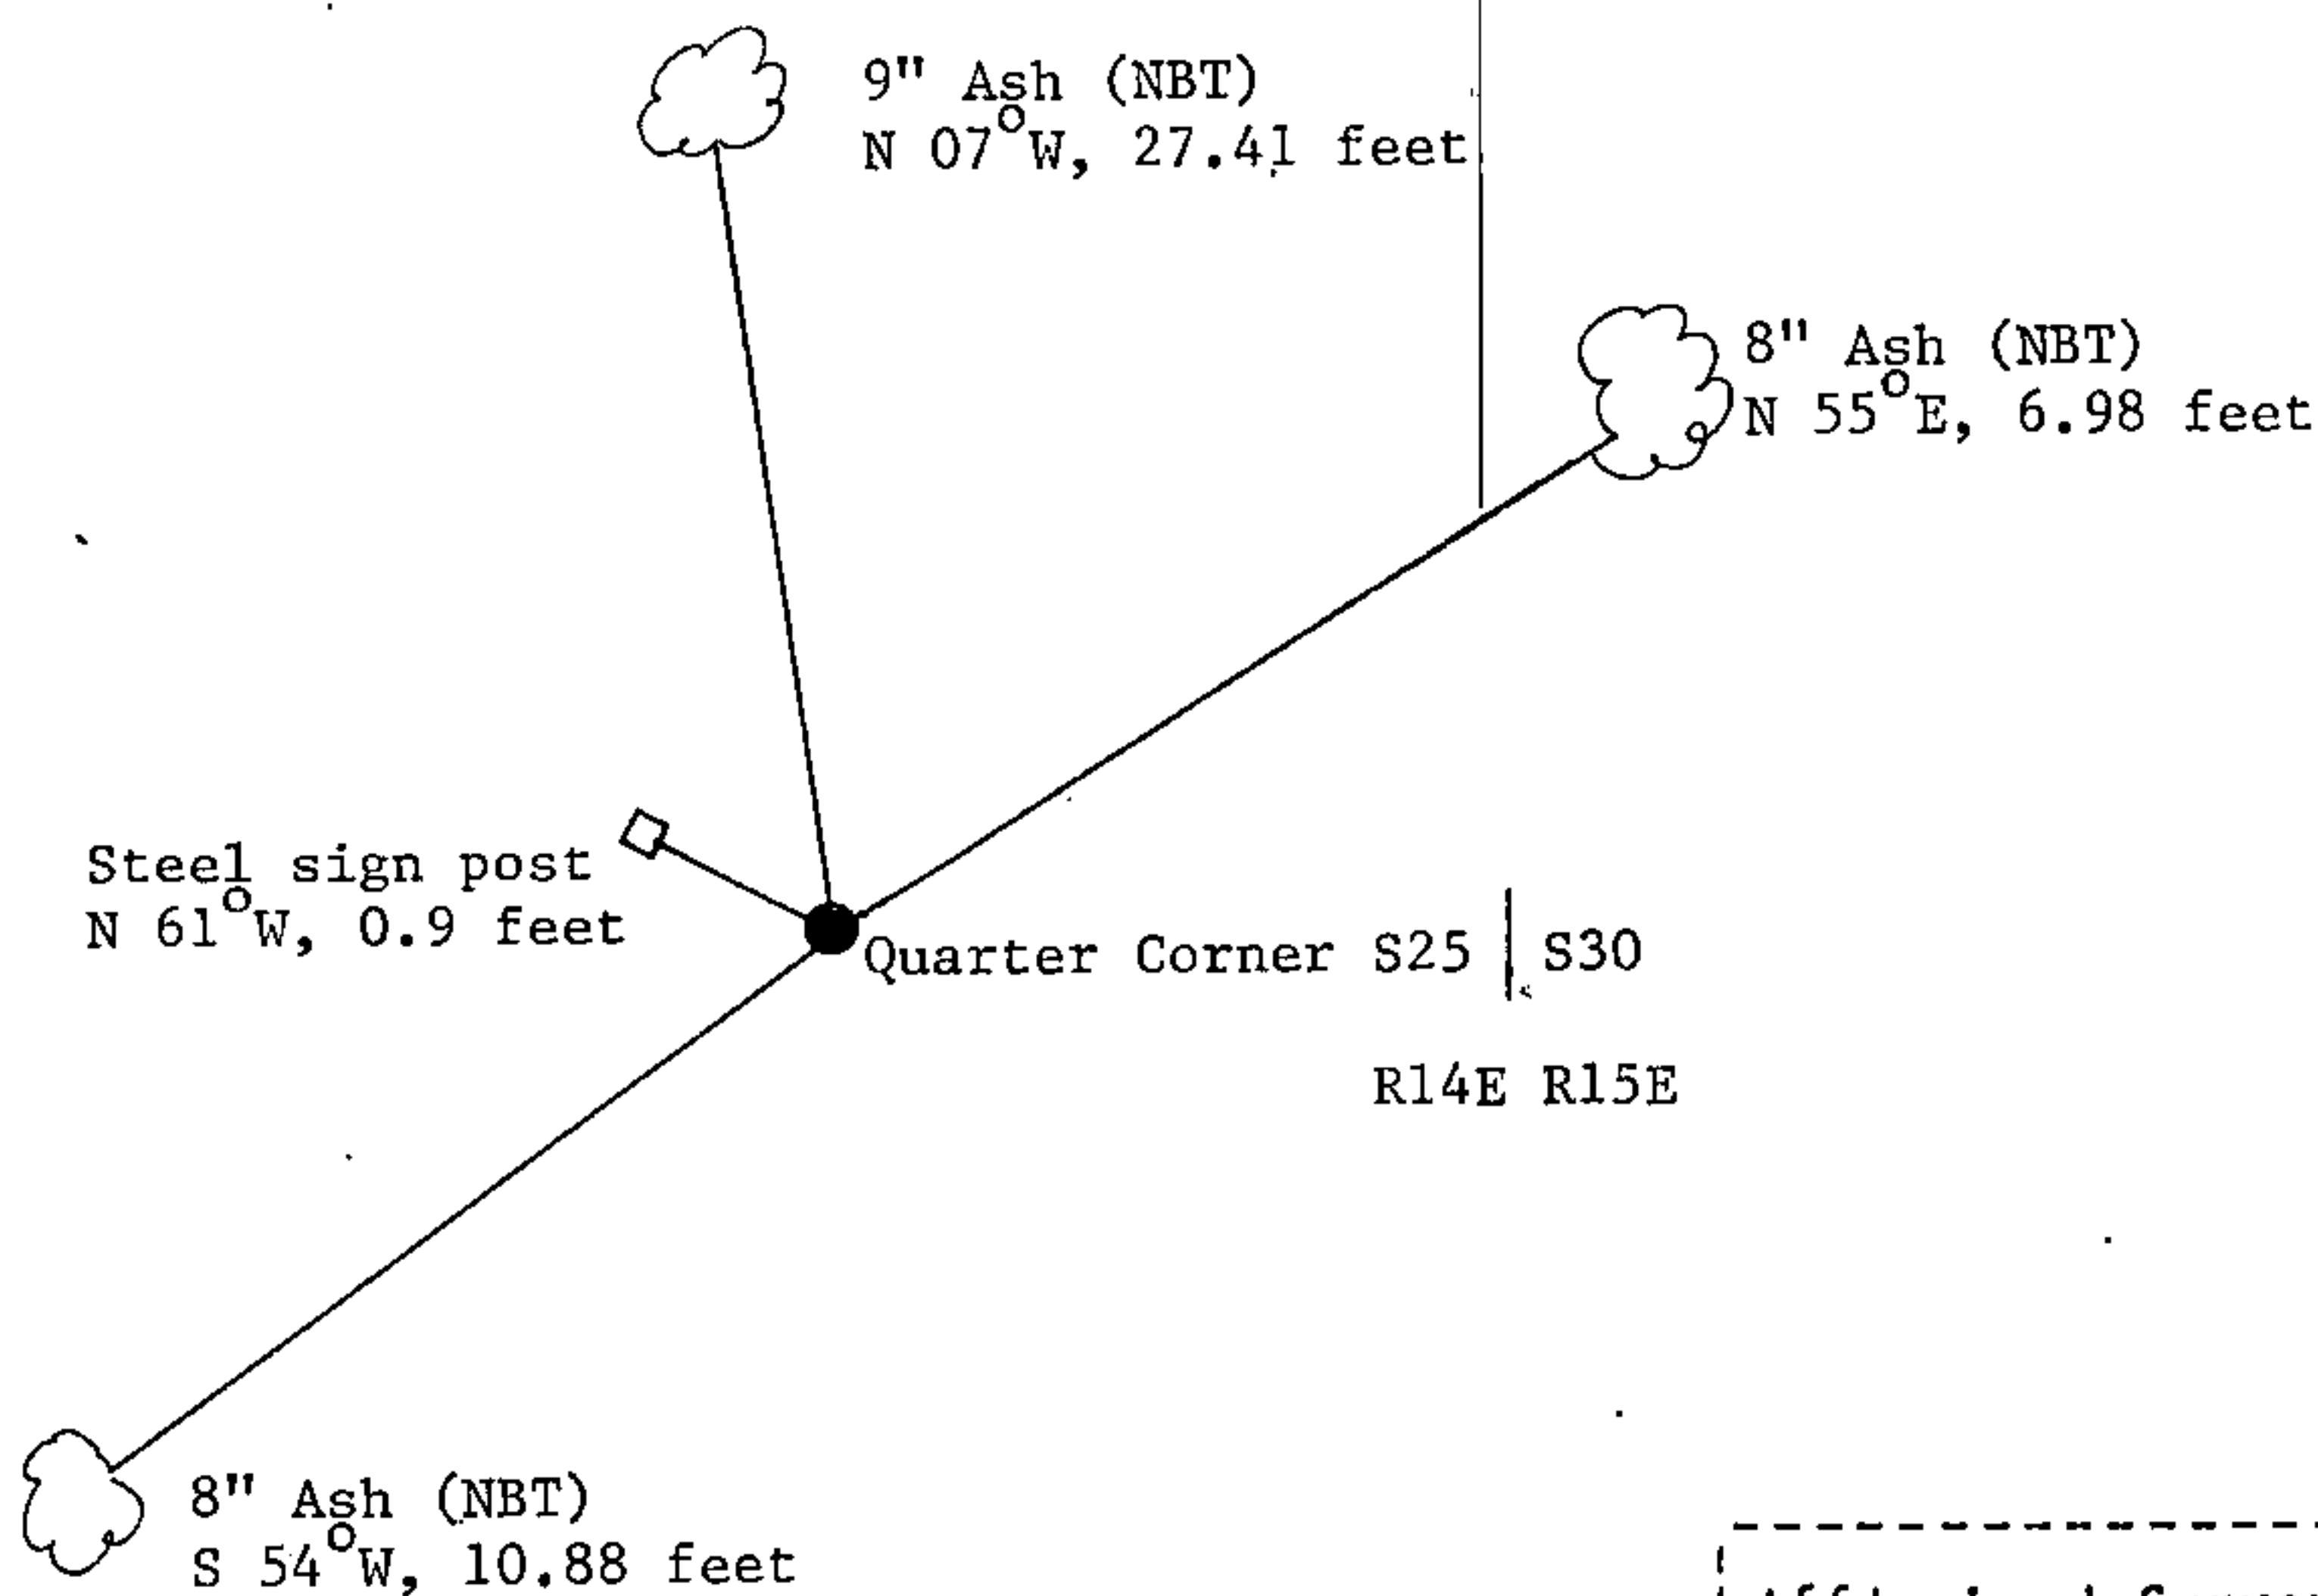

- (i) I, Gary L. Pisoni
(Type or print name) certify that the corner location shown on this record was determined by me or under my direction and control and that this U.S. Public Land Survey Monument Record is correct and complete to the best of my knowledge and belief.

Signature Gary L. Pisoni Date Jan 12 1990

Survey requested by: Edward J. Gager Date 9-18-90
District Ranger