

CERTIFIED LAND CORNER RESTORATION

State of Wisconsin

County of Forest

ss.

I, Jean F. Resvick, do hereby certify that on the 2nd day of October, 19 74, I found evidence of the south quarter corner of Section 26 Township 40 North, Range 14 East, Fourth Principal Meridian, as described hereon; and that from this evidence I established a new monument and accessories as described hereon to perpetuate the original location of this corner:

Description of original monument and accessories and subsequent restorations:


Surveyed in 1865 by W. E. Daugherty
 Dependent Resurvey in 1950 by H. B. Crawford
 Set iron post, 30 inches long, 2½ inch diameter, 18 inches in ground with brass cap marked: T40N, S26, ¼, MC, S35, R14E, 1950
 White pine 10, N78E, 59 lks
 Tamarack 5, S14E, 37.5 lks

Description of corner evidence found:


Monument as described above
 White pine snap, scribed, N78E, 38.9 feet
 Tamarack, dead, scribed, S12E, 24.45 feet

Description of ~~monument and~~ accessories I established to perpetuate the location of this corner:

Blazed and scribed the following new bearing trees:
 Tamarack 4, S54E, 43.05 feet
 White birch 11, N70W, 27.90 feet
 Set steel sign post 0.5 feet SW of monument

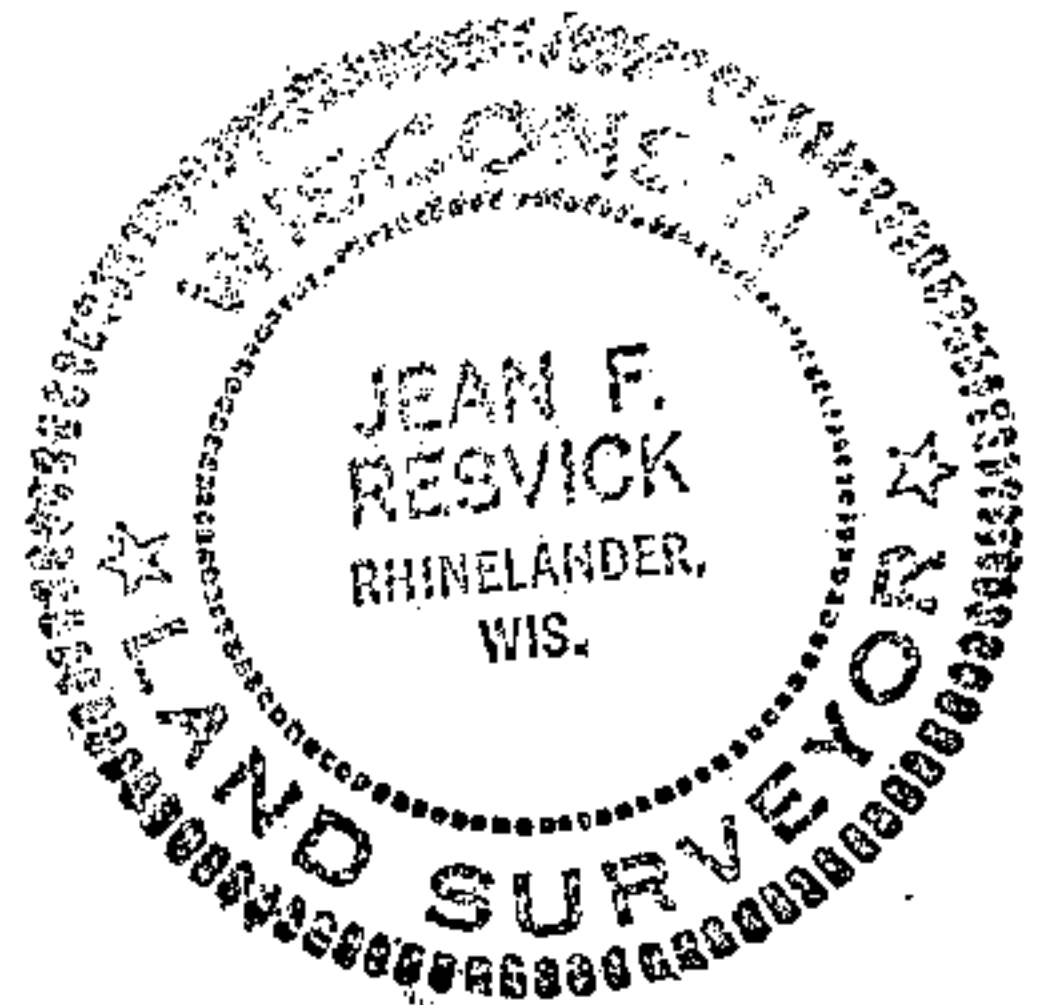

44014260020

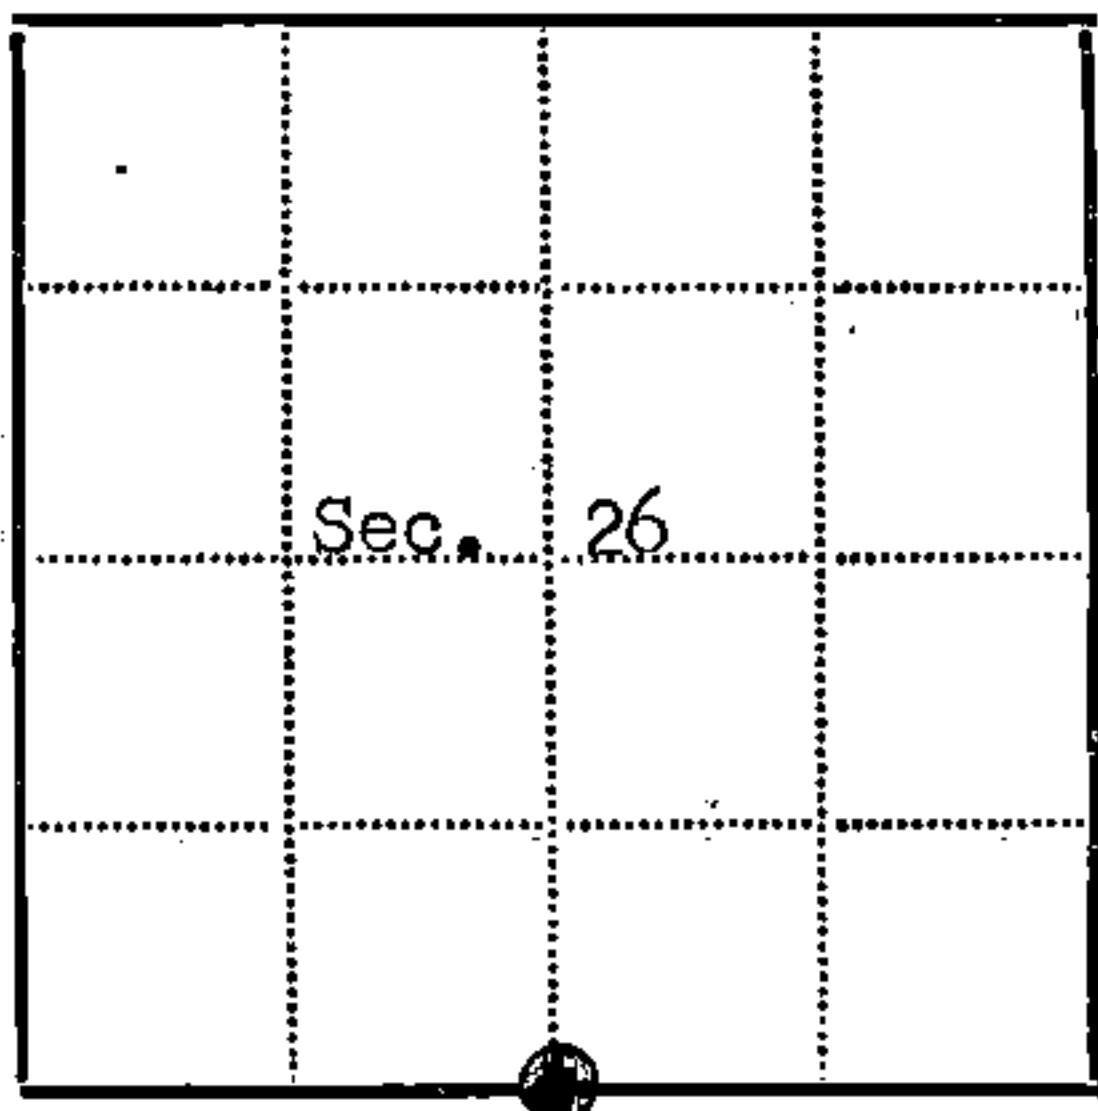

● - Corner monument restored

□ -

Resident witnesses

Dated at Rhineland Wisconsin, this 30 day of March, 19 75.

Signature Jean F. Resvick Title Land Surveyor
 (County Surveyor, Registered Land Surveyor, or other duly authorized official)

Surveyors Registration No. S-802 Document Number 106889

Office of Register of Deeds County of Forest

I hereby certify that the within instrument was filed in this office for record on the 31st. day of March, 19 75, and was filed in Book No. Corner Page No. V-19 of County Records.
 Restorations

Signature Eugene Stetson Title Register of Deeds

Township 40 North, Range 14 East, Section 26, Index No. V-19, Page No. V19