

## CERTIFIED LAND CORNER RESTORATION

State of Wisconsin

County of Forest

ss.

I, Jean F. Resvick, do hereby certify that on the 8th day of June, 1966, I found evidence of the Northeast section corner of Section 34 Township 40 North, Range 14 East, Fourth Principal Meridian, as described hereon; and that from this evidence I established a new monument and accessories as described hereon to perpetuate the original location of this corner:

## Description of original monument and accessories and subsequent restorations:

Original survey in 1865.

Dependent resurvey in 1950 by Hugh B. Crawford.

Set iron post, 30 ins. long, 2½ ins. diameter, 24 ins., in ground with brass cap marked:

T40N R14E

S27 | S26

S34 | S35

1950

from which the following bear:

White pine 10 ins., N10° 45'E, 80 lks.

Spruce 10 ins., S31° 30'E, 114½ lks.

Maple 14 ins., S84° 45'W, 75½ lks.

White pine 12 ins., N27° 30'W, 150 lks.

## Description of corner evidence found:

Monument found as described above.

White pine 17 ins., N13° 30'E, 53 ft.

Spruce 19 in. stump, S28° 30'E, 75.20 ft.


Maple 19 ins., S87° 15'W, 49.90 ft.

White pine 20 ins., N25°W, 99.20 ft.


Bearings do not agree with recorded. Recorded bearings believed to be magnetic bearings with no declination.

Description of ~~monument and~~ accessories I established to perpetuate the original location of this corner:

Place bearing tree shields on bearing trees, set 4x4 cedar post by monument.

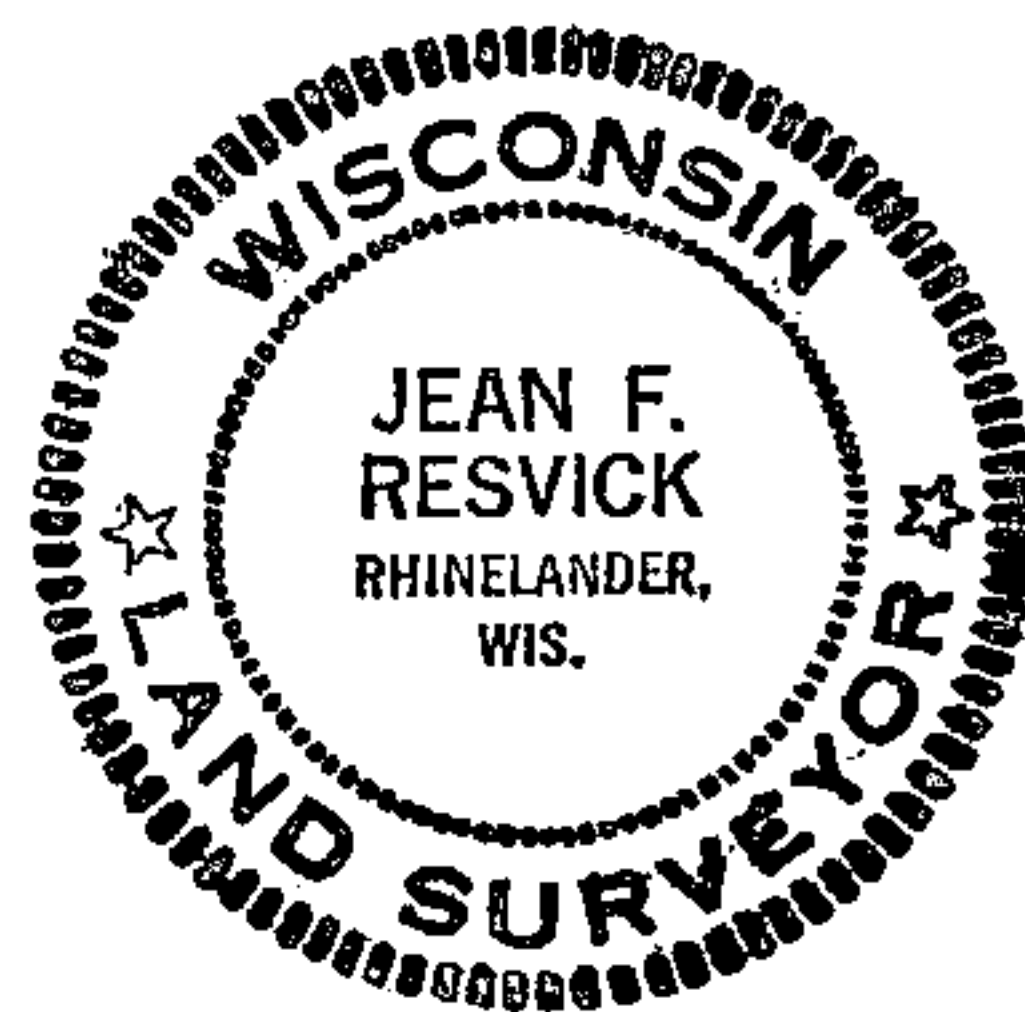

44014 270000

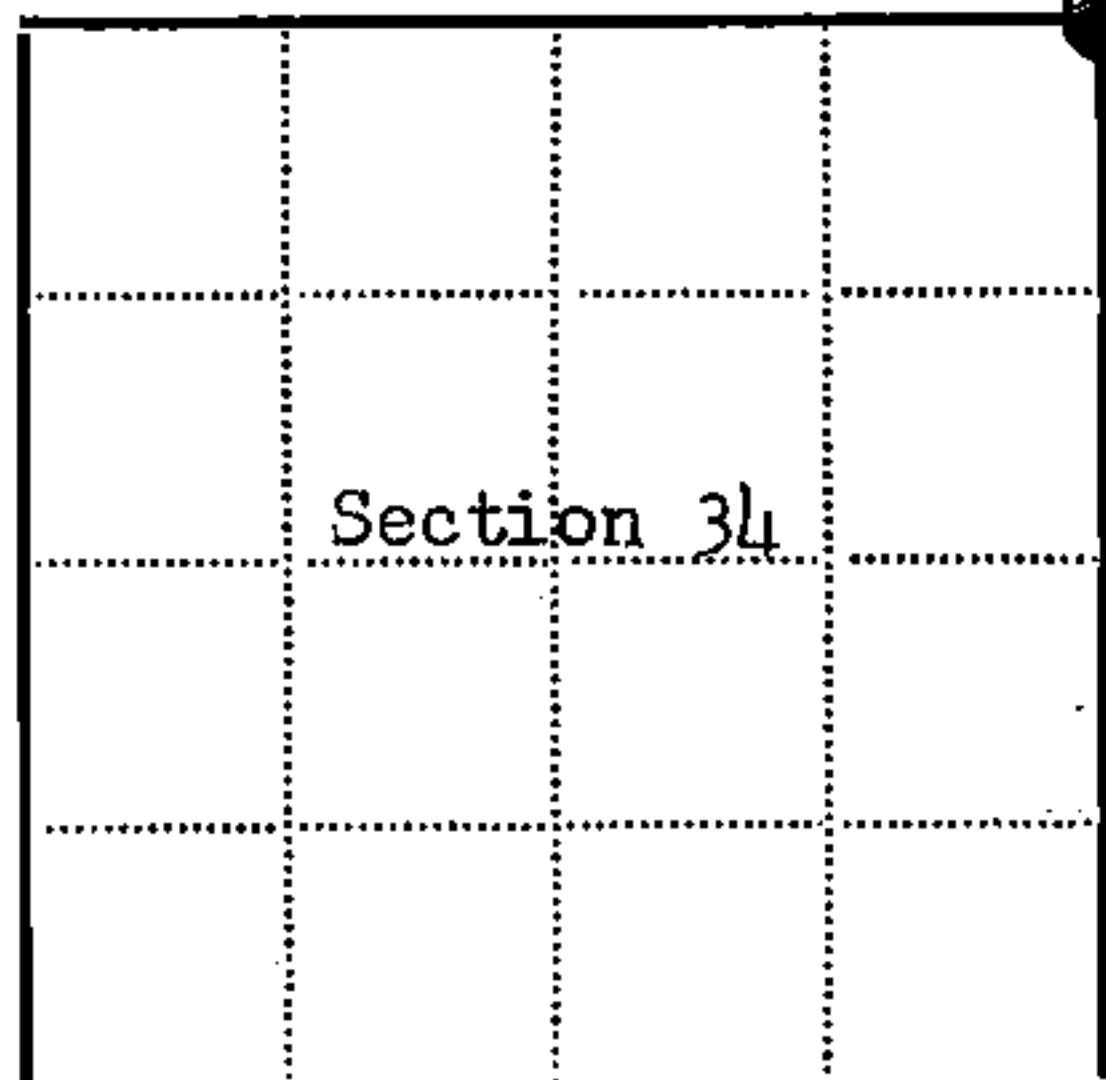

● = Corner monument restored

□ =

Resident witnesses.....

Dated at Rhineland Wisconsin, this 21st day of March 1967.Signature Jean F. Resvick Title Cadastral Surveyor  
(County Surveyor, Registered Land Surveyor, or other duly authorized official)Surveyors Registration No. S-802 DOC. NO. 94239Office of Register of Deeds County of ForestI hereby certify that the within instrument was filed in this office for record on the 27th day of February 1968, and was filed in Book No. I Page No.  of County Records.Signature Eugene Staszny Title RecordsTownship 40 North, Range 14 East, Section 34, Index No. V-17, Page No. 

V17