

## CERTIFIED LAND CORNER RESTORATION

State of Wisconsin

County of Forest


ss.

DOCUMENT NUMBER

**99462**

I Jean F. Resvick, do hereby certify that on the 16th day of September, 1970, I found evidence of the East Quarter corner of Section 7 Township 41 North, Range 13 East, Fourth Principal Meridian, as described hereon; and that from this evidence I established a new ~~monument~~ accessories as described hereon to perpetuate the ~~original~~ location of this corner:

## Description of original monument and accessories and subsequent restorations:

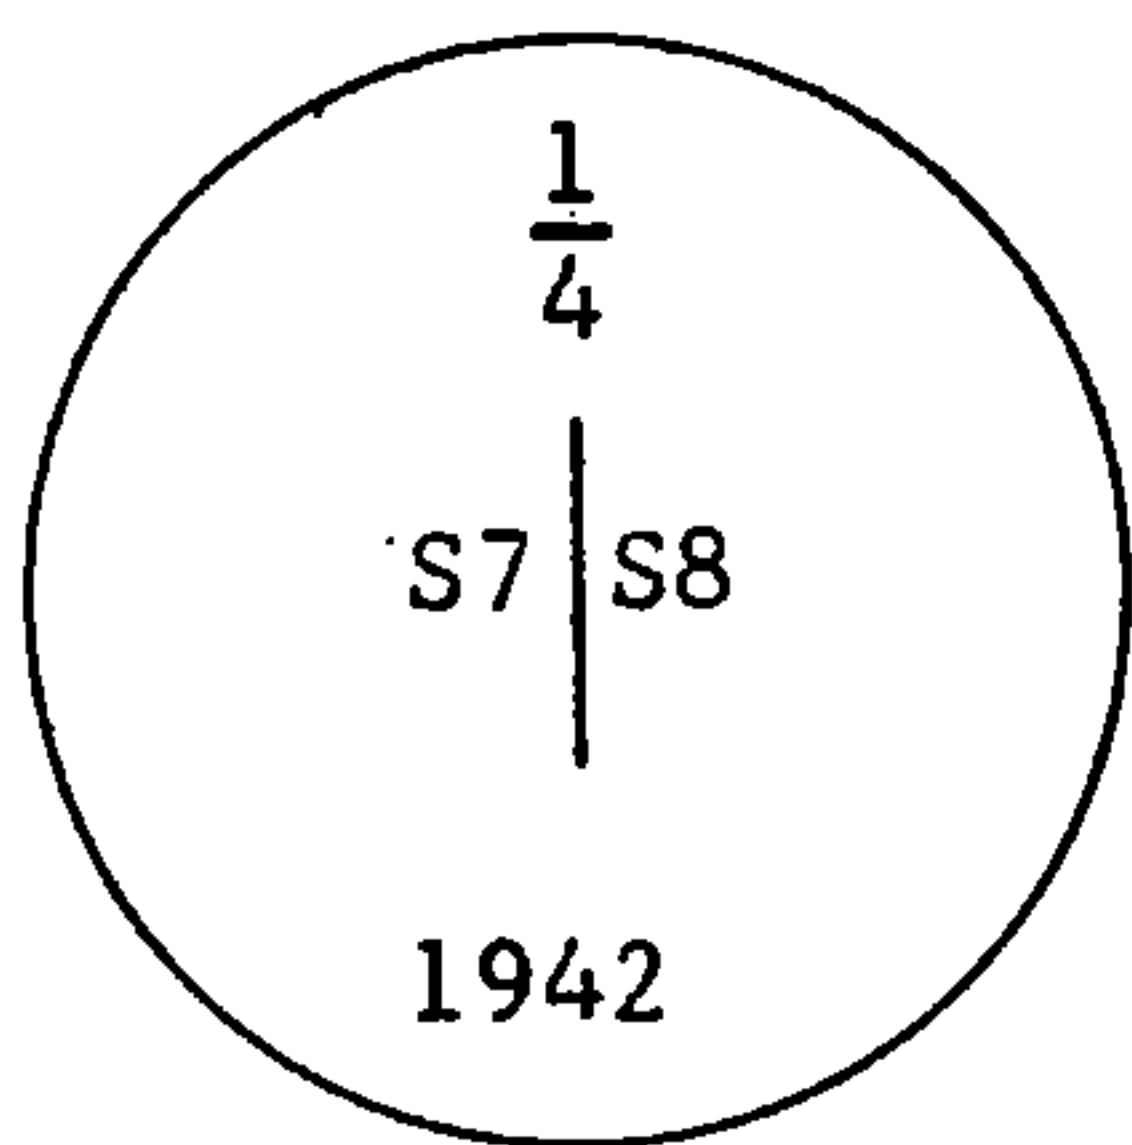

Surveyed by Wm. E. Daugherty in 1865. Dependent resurvey in 1942 by Guy R. Veal. At proportionate distance set an iron post, 3 feet long, 2 inch diameter 27 inches in the ground with a brass cap marked.

From which:

A Hemlock 11" diameter, bears N69°15'E 3.50 lks.

A Hemlock 7" diameter, bears N 1°30'W 16.50 lks.

## Description of corner evidence found:

## Monument as described

Fallen Hemlock 11" N69°15'E 3.50 lks.


Hemlock (Dead), 9" N 1°30'W 16.50 lks.

Description of monument and accessories I established to perpetuate the ~~original~~ location of this corner:

Blazed and scribed the following new bearing trees:

A maple 17" diameter S47E, 41.54 feet

A maple 12" diameter N31W, 26.76 feet

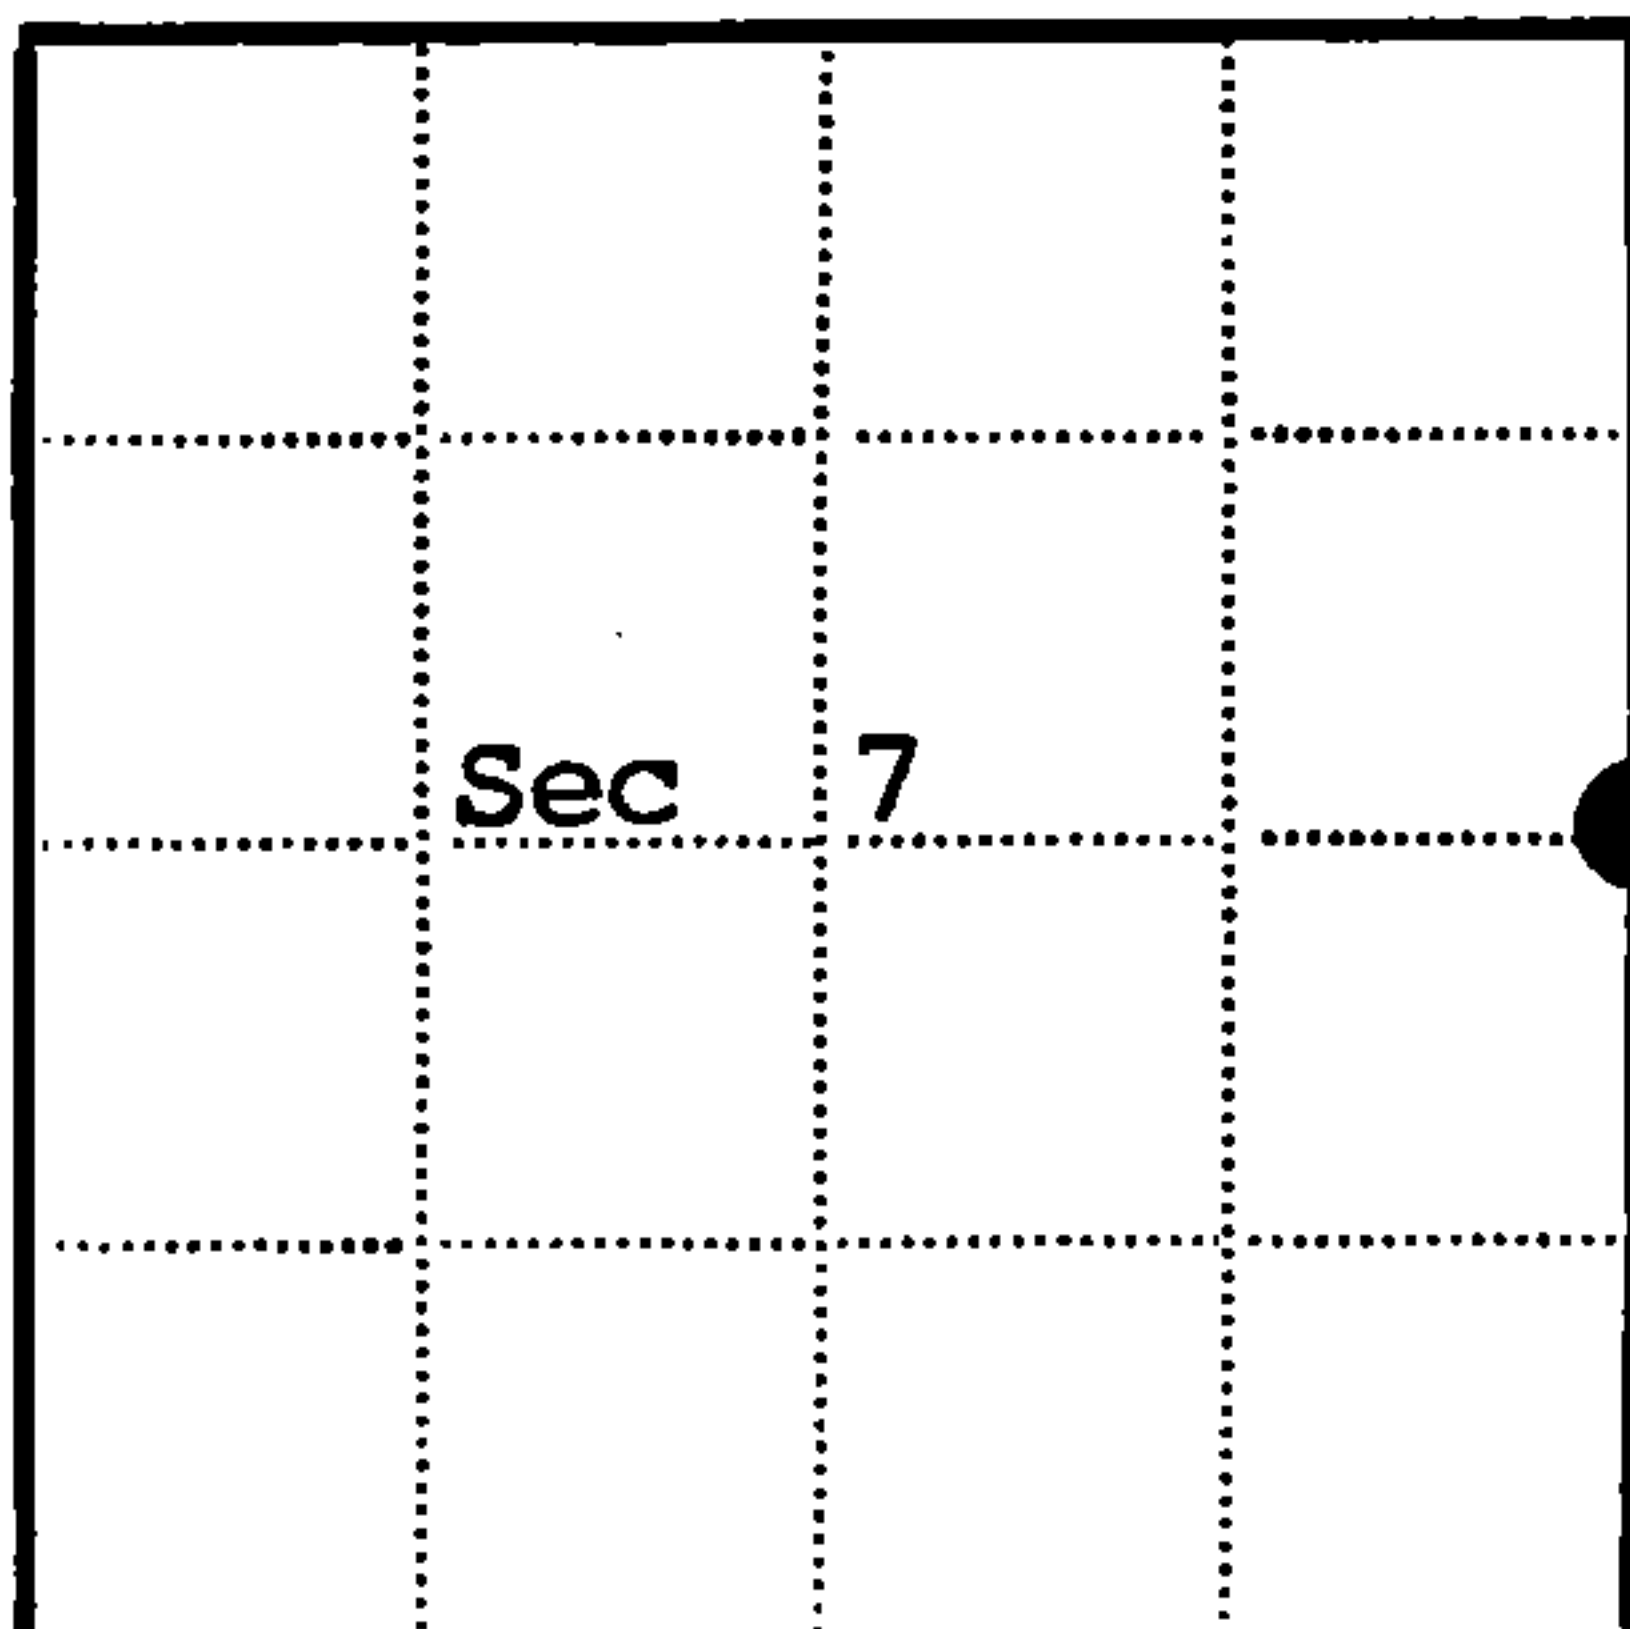

● = Corner monument restored

□ =

Resident witnesses.....

Dated at Rhineland Wisconsin, this 2nd day of Nov, 1970.Signature Jean F. Resvick Title Cadastral Surveyor  
(County Surveyor, Registered Land Surveyor, or other duly authorized official)Surveyors Registration No. S-802Office of Register of Deeds County of ForestI hereby certify that the within instrument was filed in this office for record on the 16th day of March, 1971, and was filed in Book No. 1 Page No. G-5 of County Records.Signature Eugene Stutzman Title Register of DeedsTownship 41 North, Range 13 East, Section 7, Index No. G-5, Page No. ....

44113072000

G  
5