

CERTIFIED LAND CORNER RESTORATION

State of Wisconsin

County of Forest

ss.

DOCUMENT NUMBER

104382

I Jean F. Resvick, do hereby certify that on the 4 day of October, 1973, I found evidence of the North quarter corner of Section 23 Township 41 north, Range 13 east, Fourth Principal Meridian, as described hereon; and that from this evidence I established a new monument and accessories as described hereon to perpetuate the original location of this corner:

Description of original monument and accessories and subsequent restorations: Original survey by Dougherty and McDill in 1865. Dependent resurvey by Guy R. Veal in 1942. The point for the 1/4 cor., in center of County Trunk "D" (now County Trunk "A") for position in latitude and in line with fence N. of road for position in longitude. This is the preserved position of the original 1/4 sec. cor. according to statements of citizens. At point for corner, deposited a concrete monument, 12 ins. long, 6 ins. diam., 20 ins. in the ground, for 1/4 sec. cor., no marks. At a point south, 40 lks. distance set a concrete monument, 20 ins. long, 6 ins. diam., 20 ins. in the ground, for witness 1/4 sec. cor., with brass cap marked: WC, 1/4, S14, S23, 1942 from which White Birch, 6 ins. diam. bears N16 1/4°W, 166 lks. White Pine stump, 10 ins. diam. bears S2 1/4°W, 68 lks. NW section corner of section 23 bears S89° 49'W, 39.56 chains from 1/4 corner. NE section corner of section 23 bears S89° 59'E, 39.48 chains from 1/4 corner. Description of corner evidence found:


Found witness corner monument as described above. White Birch bears N16 1/4°W, 166 lks. from monument.

No evidence found of White Pine stump. Dug in road and found no evidence of concrete corner. Old fence north down, evidence of corner post and brace poles found. Post holes evident. The Fence further north has been replaced. The northwest sec. corner of sec. 23 was recovered and the northeast section corner was established from evidence found. The position for the north quarter corner of section 23 was located at a point north, 26.40 feet from witness corner recovered and N89° 49'E, 2610.82 feet from the north west corner of section 23 and N89° 59'W, 2605.58 feet from the northeast corner of section 23.

Description of monument and accessories I established to perpetuate the location of this corner:

In the center of County Trunk "A" at a point north 26.40 feet from witness corner, drove a 1 inch square iron bar, 2 feet long for 1/4 section corner. At a point north, 33 feet from 1/4 section corner, set a 2 inch inside diameter galvanized iron pipe, 3 feet long, filled with concrete with brass cap stamped, witness corner, T41N, R13E, S14, 1/4, S23, 1973, S-802 stamped arrow pointing to corner marked 33 feet on east side of brass cap.

Iron pipe which was found in road bears S32° 27'W, 6.28 feet from the corner as located above. This pipe was set by a local surveyor on a straight line between section corners. Straight line proportion was not accepted because of the evidence found of a survey of record and the survey records a bend at the quarter corner position.

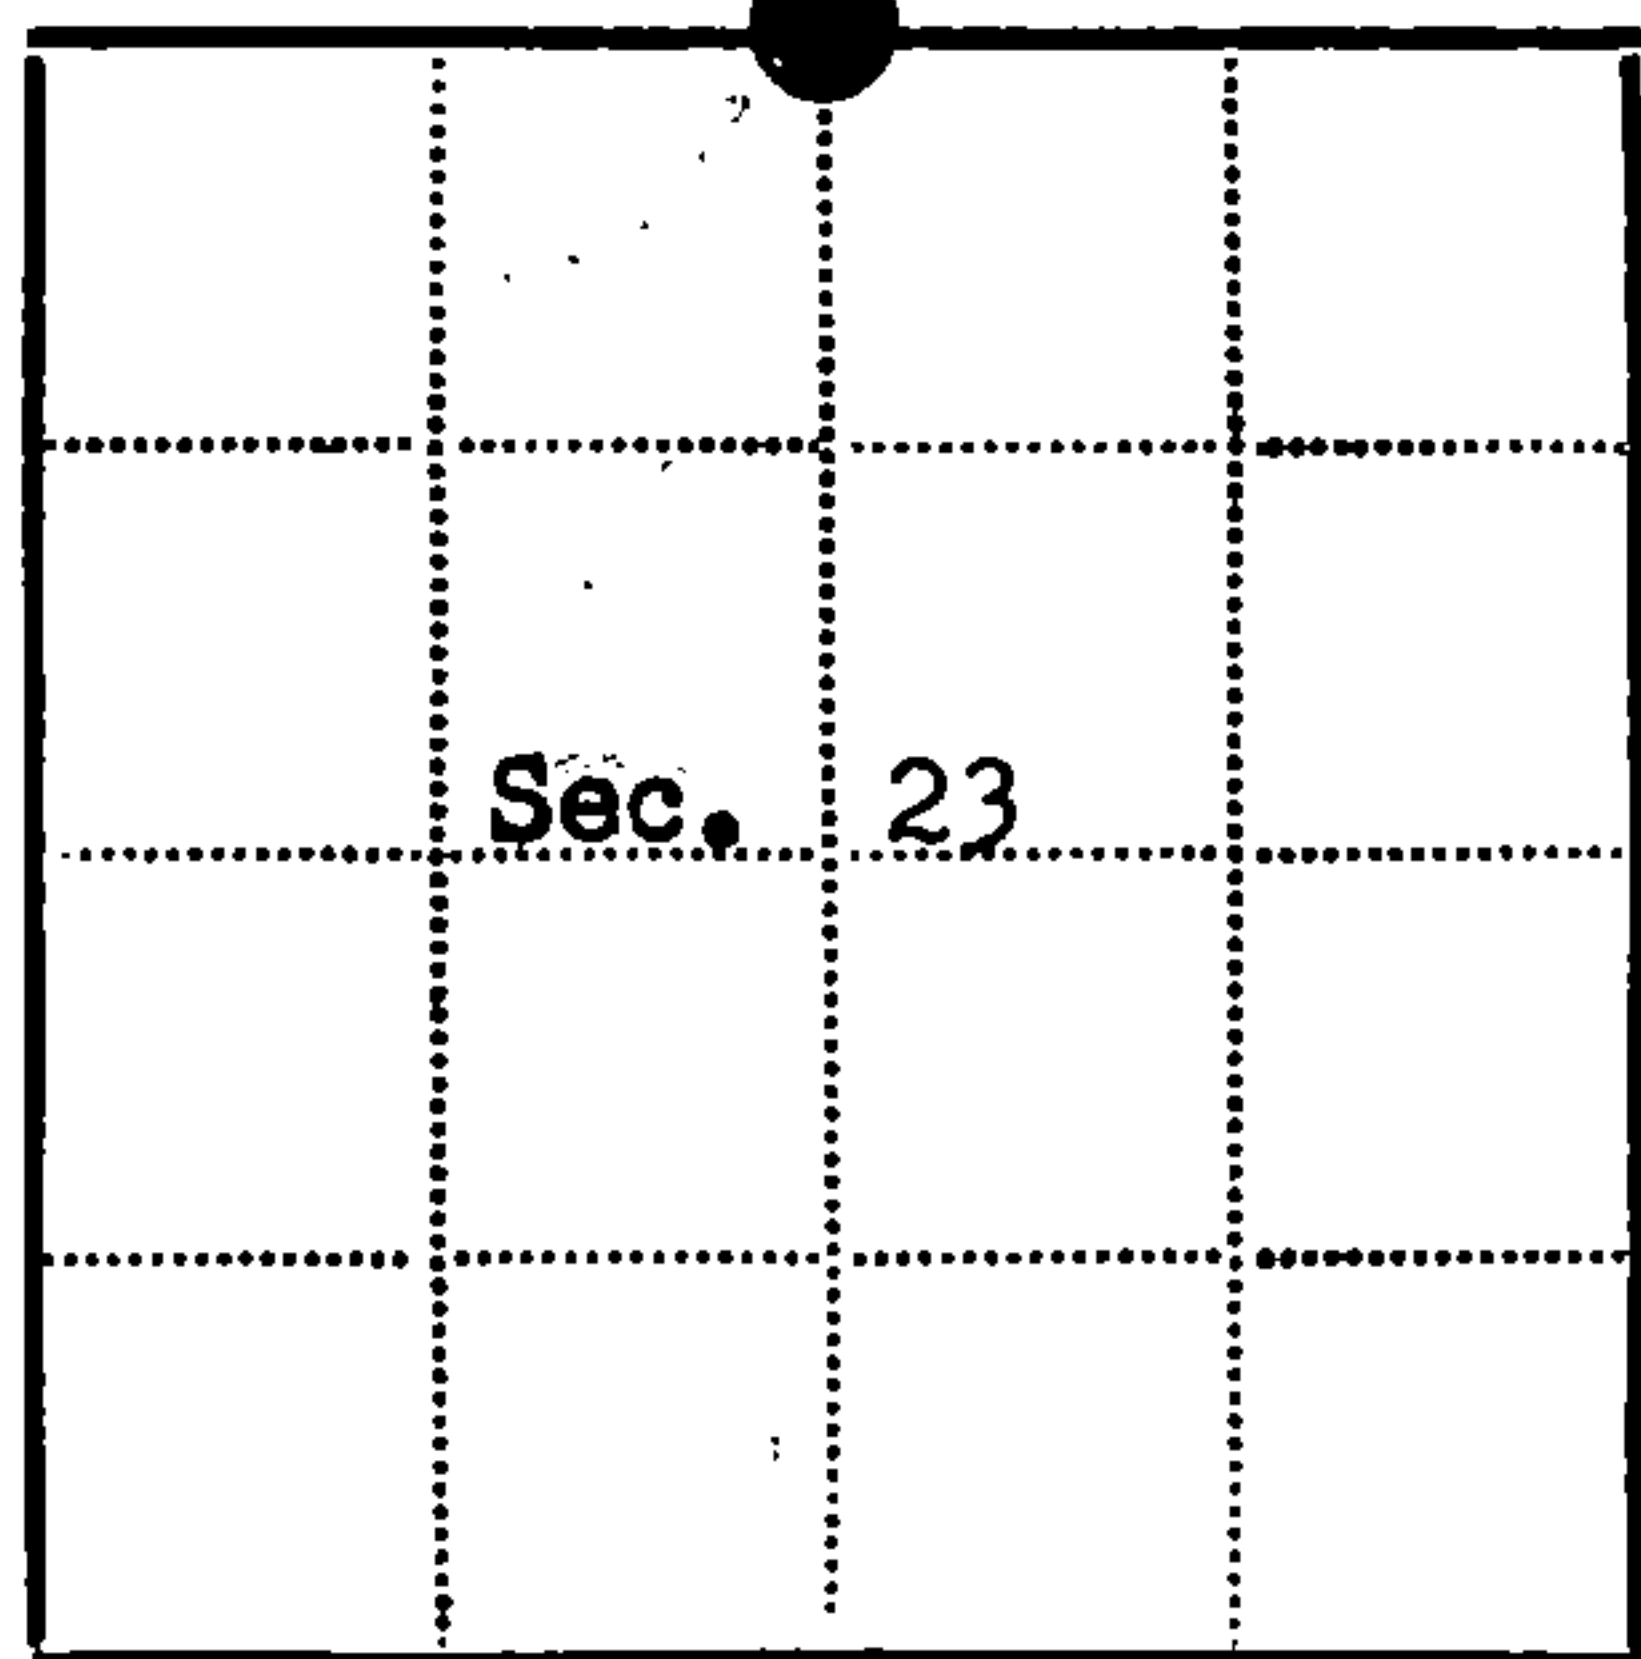

● - Corner monument restored

□ -

Resident witnesses

Dated at Rhinelander

1973

Signature Jean F. Resvick Title Land Surveyor

(County Surveyor, Registered Land Surveyor, or other duly authorized official)

Surveyors Registration No. S-802Office of Register of Deeds County of Forest

I hereby certify that the within instrument was filed in this office for record on the 5th day of November 1973, and was filed in Book No. 1 Page No. N19 of County Records.

Signature Eugene Stagny Title Register of Deeds

Township 41 north, Range 13 east, Section 23, Index No. N-19, Page No. N19

44113140020

N19