

CERTIFIED LAND CORNER RESTORATION

State of Wisconsin }
County of Forest } ss.

I William B. Cochrane, do hereby certify that on the 27th day of May, 19 82, I found evidence of the Southeast Section corner of Section 17 Township 40 North Range 13 East, Fourth Principal Meridian, as described hereon; and that from this evidence I established a new monument and accessories as described hereon to perpetuate the original location of this corner:

Description of original monument and accessories and subsequent restorations:

Original survey in 1865 by William E. Daugherty
Dependent resurvey of the boundaries of Section 17 in 1975 by Barry G. Krebs
From recorded topographic calls, set copper covered 9/16" rod with bronze cap stamped T40N, R13E, S16, S17, S20, S21, 1975
From which the following bear:
Spruce, 12", S31 $\frac{1}{2}$ E, 64 lks.
Spruce, 10", S64 $\frac{1}{2}$ W, 35 lks.
Spruce, 10", N67 $\frac{1}{2}$ W, 52 lks.



Description of corner evidence found:

Monument as described and in place
Spruce, 13", S31 $\frac{1}{2}$ E, 42.24 ft.
Spruce, 11", S64 $\frac{1}{2}$ W, 23.10 ft.
Spruce, 11", N67 $\frac{1}{2}$ W, 34.32 ft.

Description of monument and accessories I established to perpetuate the location of this corner:

Blazed and scribed the following new bearing trees:
Tamarack, 6", N35E, 50.55 ft.
Steel sign post, West, 1.0 ft.

DOCUMENT NO.
124414

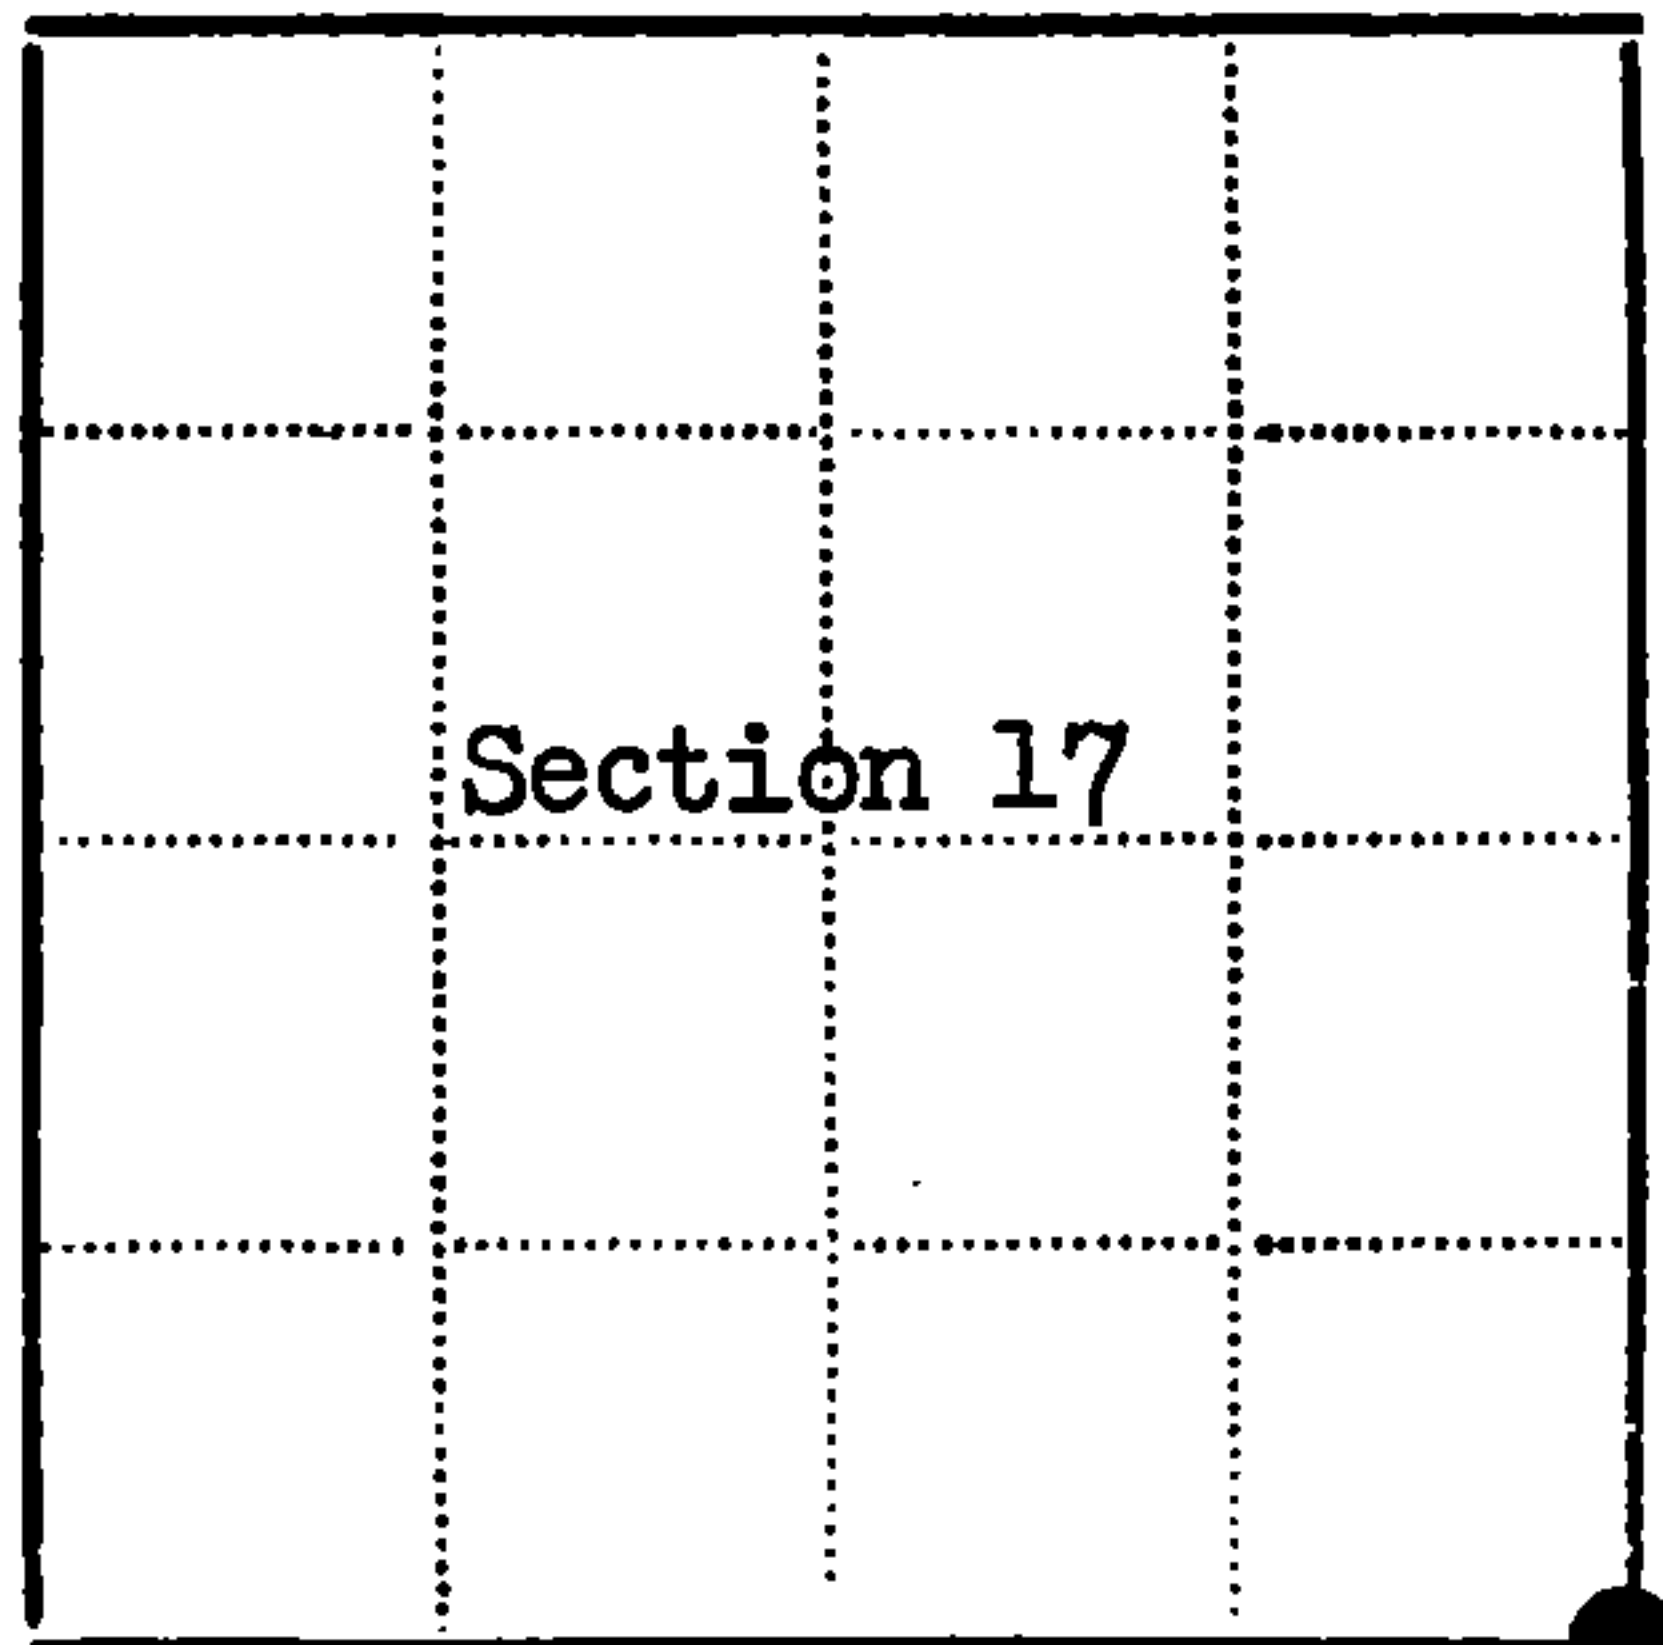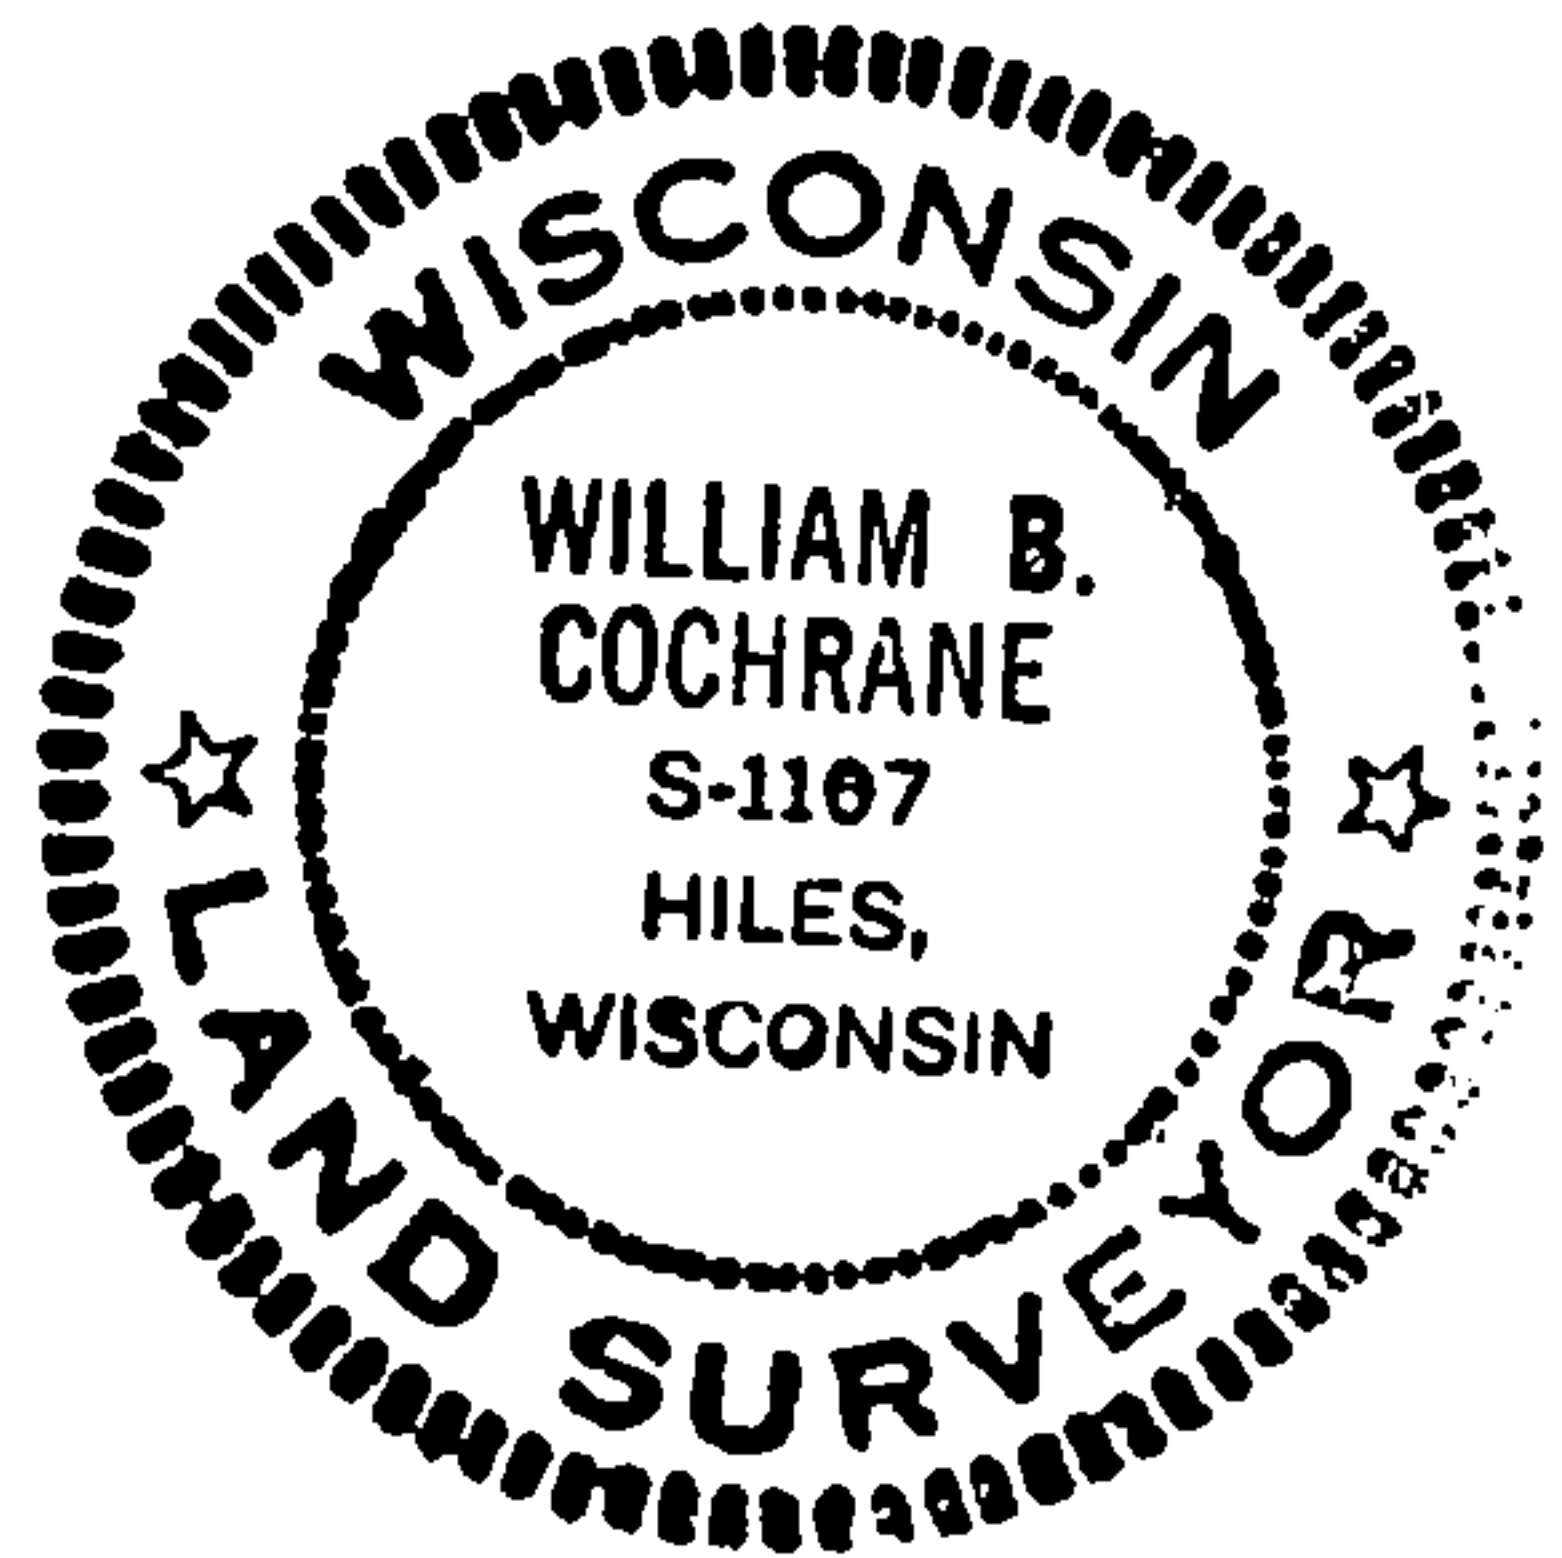

● - Corner monument restored
□ -

Resident witnesses _____
Dated at Hiles Wisconsin, this 21st day of July 19 82.
Signature William B. Cochrane Title Land Surveyor
(County Surveyor, Registered Land Surveyor, or other duly authorized official)
Surveyors Registration No. S-1107
Office of Register of Deeds County of Forest
I hereby certify that the within instrument was filed in this office for record on the 10th day of October 19 83, and was filed in Book No. _____ Page No. _____ of County Records.
Signature Eugene Stagny Title Register of Deeds
Township 40 North Range 13 East Section 17 Index No. N-9 Page No. _____

44113170000

N
6