

CERTIFIED LAND CORNER RESTORATION

State of Wisconsin

County of Forest

SS.

DOCUMENT NUMBER **99465**

I, Jean F. Resvick, do hereby certify that on the 9th day of September, 1970, I found evidence of the West Quarter corner of Section 30 Township 41 North, Range 14 East; Fourth Principal Meridian, as described hereon; and that from this evidence I established a new monument and accessories as described hereon to perpetuate the original location of this corner:

Description of original monument and accessories and subsequent restorations:

Survey in 1865 by William Daugherty and McDill. Dependent Resurvey in 1942 by Guy R. Veal. Set a concrete monument, 24 inches long, 4 inches in diameter, 18 inches in the ground, with an iron post, 22 inches long, 1 inch in diameter, embedded in center, with brass cap marked: $\frac{1}{4}$, S25, S30, 1942. From which the following bear:

A fallen White Pine, 26" diam., bears N44W, 17 lks.

Rotted Birch stump, bears S51E, 19 lks.

Local bearing tree, Yellow Birch, 11", bears S89°15'W, 20½ lks.

New Bearing Trees:

Hemlock 8", bears N81°30'E, 67 lks.

Hemlock 11" bears N22W, 77 lks.


Description of corner evidence found:

Monument found as described above with brass cap stamped.
From which the following bear:

Yellow Birch, 15, bears S80°30'W, 13.50 feet

Hemlock, fallen, bears N81°30'E, 44.20 feet, scribing readable

Hemlock 15, bears N21°30'W, 50.82 feet

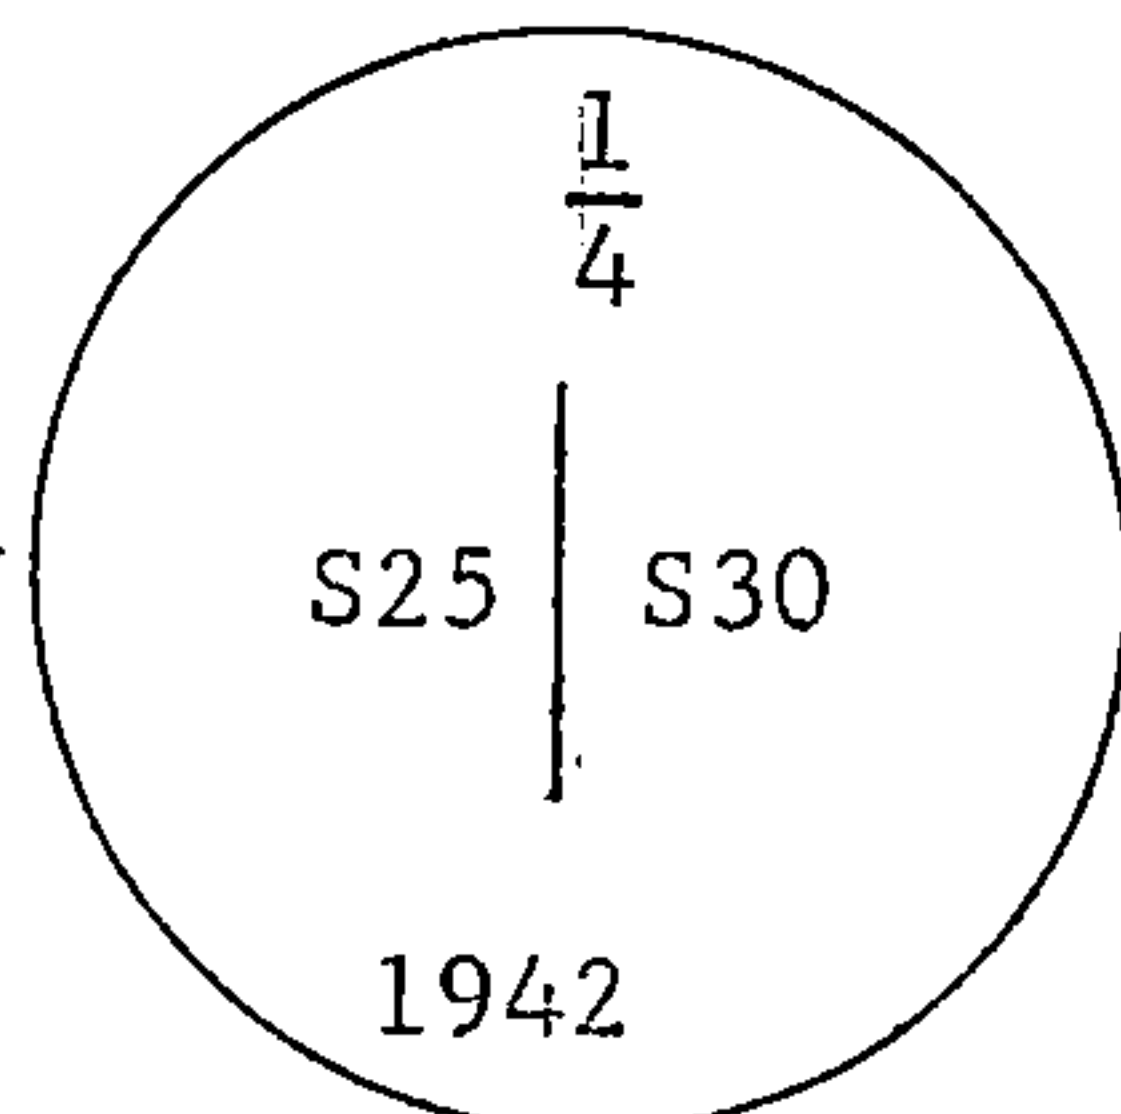

Description of monument and accessories I established to perpetuate the original location of this corner:

Blazed and scribed the following new bearing trees.


Cedar 14, bears S48E, 56 lks.

Set steel post with signs. 1 foot NW of monument.

Place bearing tree signs on Yellow Birch and Hemlock



441 13252000

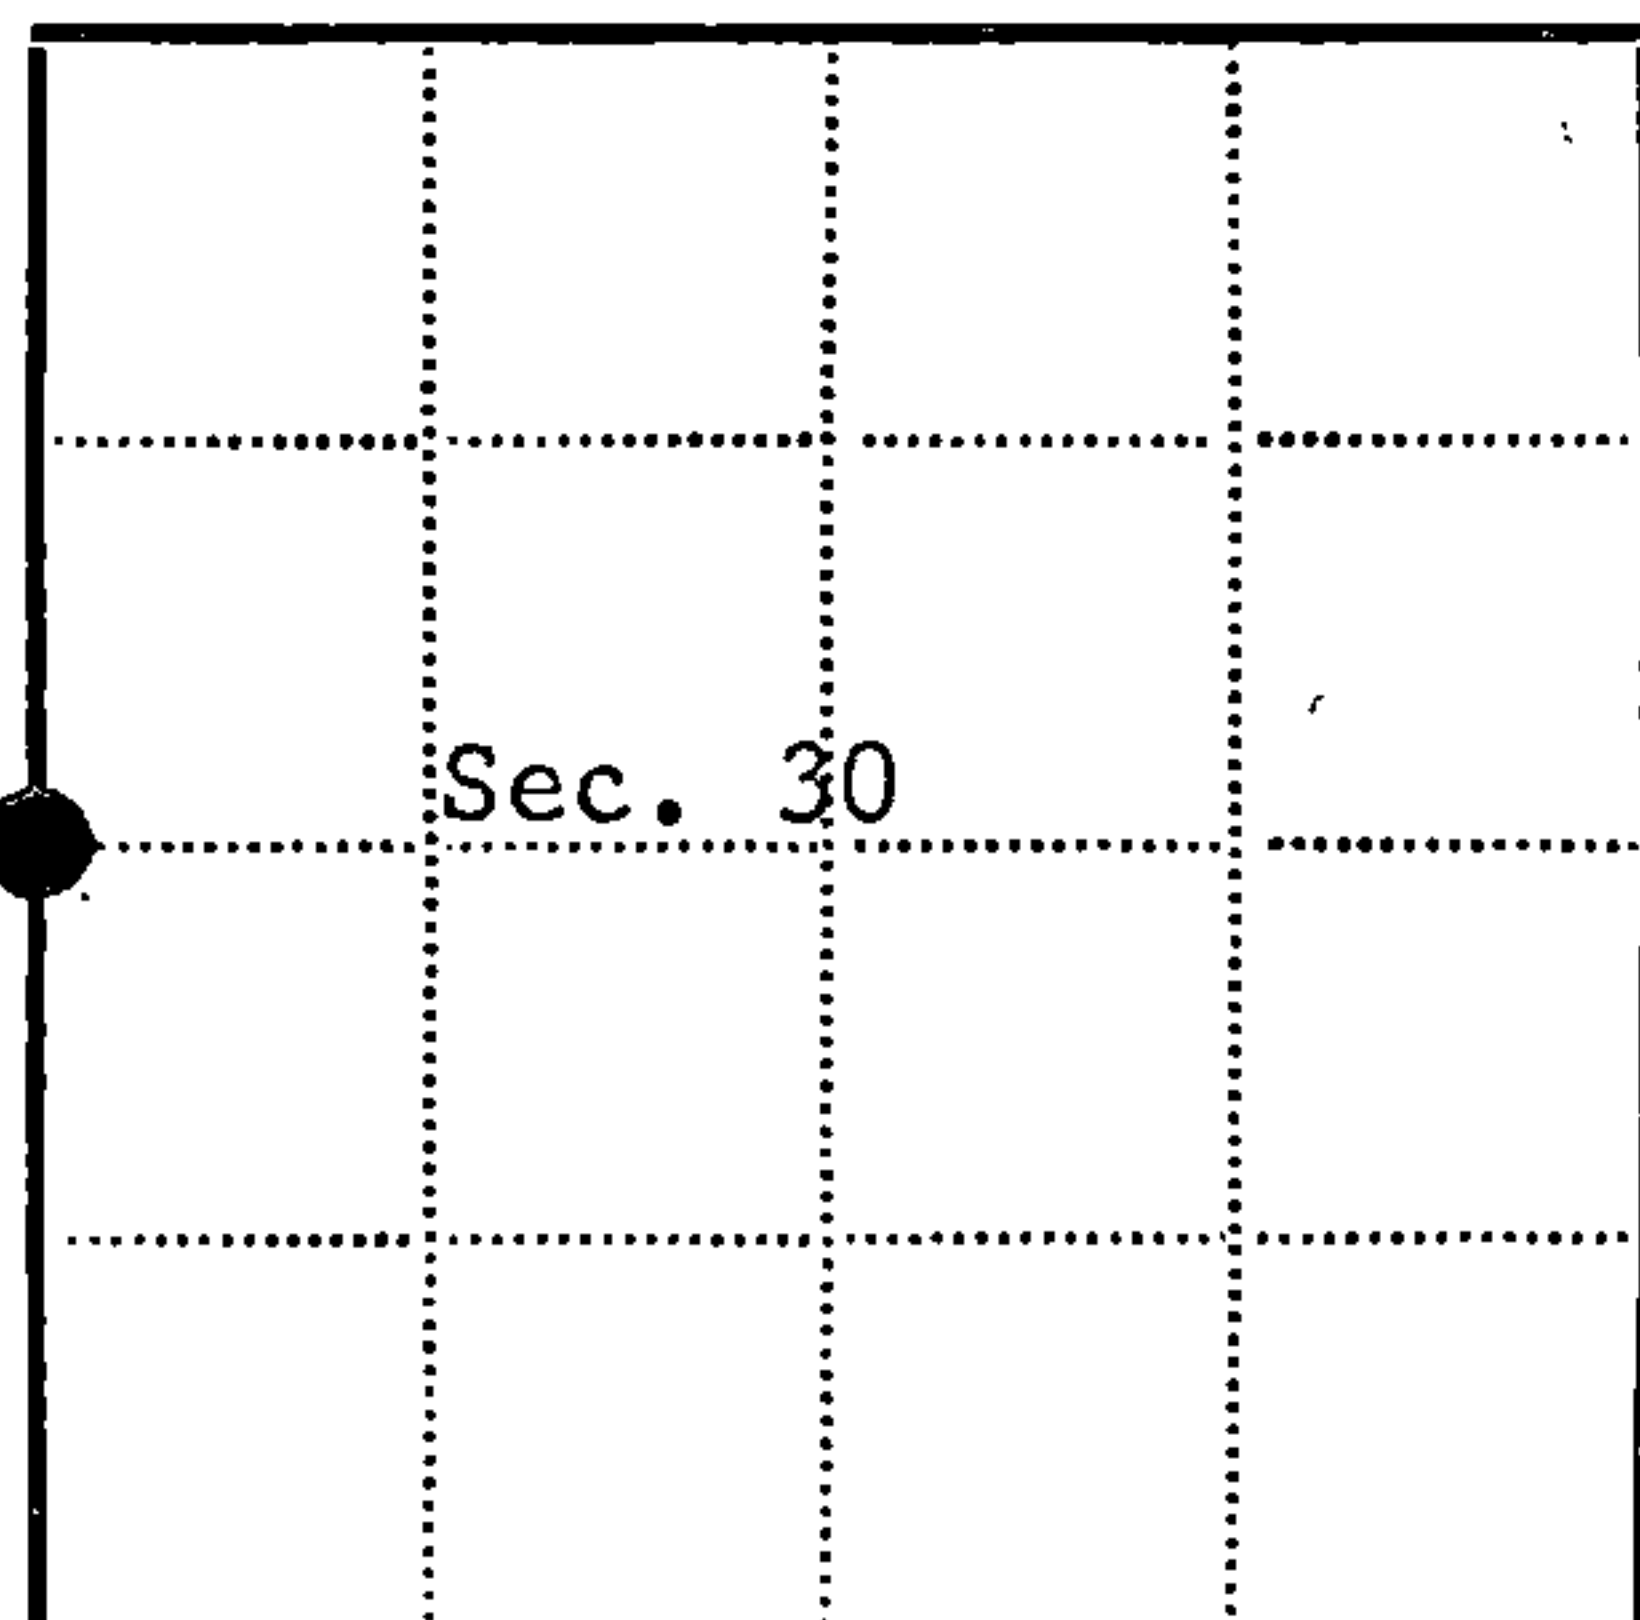

● = Corner monument restored

□ =

Resident witnesses

Dated at Rhineland Wisconsin, this 2nd day of Nov. 1970.

Signature Jean F. Resvick Title Cadastral Surveyor
(County Surveyor, Registered Land Surveyor, or other duly authorized official)

Surveyors Registration No. S-802

Office of Register of Deeds County of Forest

I hereby certify that the within instrument was filed in this office for record on the 16th day of March 19 71, and was filed in Book No. 1 Page No. T-1 of County Records.

Signature Eugene Stetson Title Register of Deeds

Township 41 North, Range 14 East, Section 30, Index No. T-1, Page No.