

CERTIFIED LAND CORNER RESTORATION

State of Wisconsin

County of Forest

ss.

I Jean F. Resvick, do hereby certify that on the 5 day of October, 1970, I found evidence of the South East Section corner of Section 31 Township 41 North, Range 13 East, Fourth Principal Meridian, as described hereon; and that from this evidence I established a new monument and accessories as described hereon to perpetuate the original location of this corner:

Description of original monument and accessories and subsequent restorations:

Original survey by Artemas Curtis in 1857. Dependent resurvey in 1942 by Guy R. Veal. At proportionate distance set concrete monument, 24 inches long, 6 inches in diameter, for standard corner of section 31 and 32, with brass cap marked S.C., T41N, R13E, S31, S32, 1942 from which:

A Norway Pine, 14 inches in diameter, bears N25E, 122 lks.

A White Birch, 6 inches in diameter, bears N10W, 32 lks.

Description of corner evidence found:

Concrete monument as described above.


A Norway Pine, 20 inches in diameter, N25E, 124 lks.

A White Birch stump, 9 inches in diameter, N10W, 32 lks., scribing readable.

Description of monument and accessories I established to perpetuate the original location of this corner:

Blazed and scribed the following new B.T.


White Spruce, 9 inches in diameter, N43W, 30.97 ft.

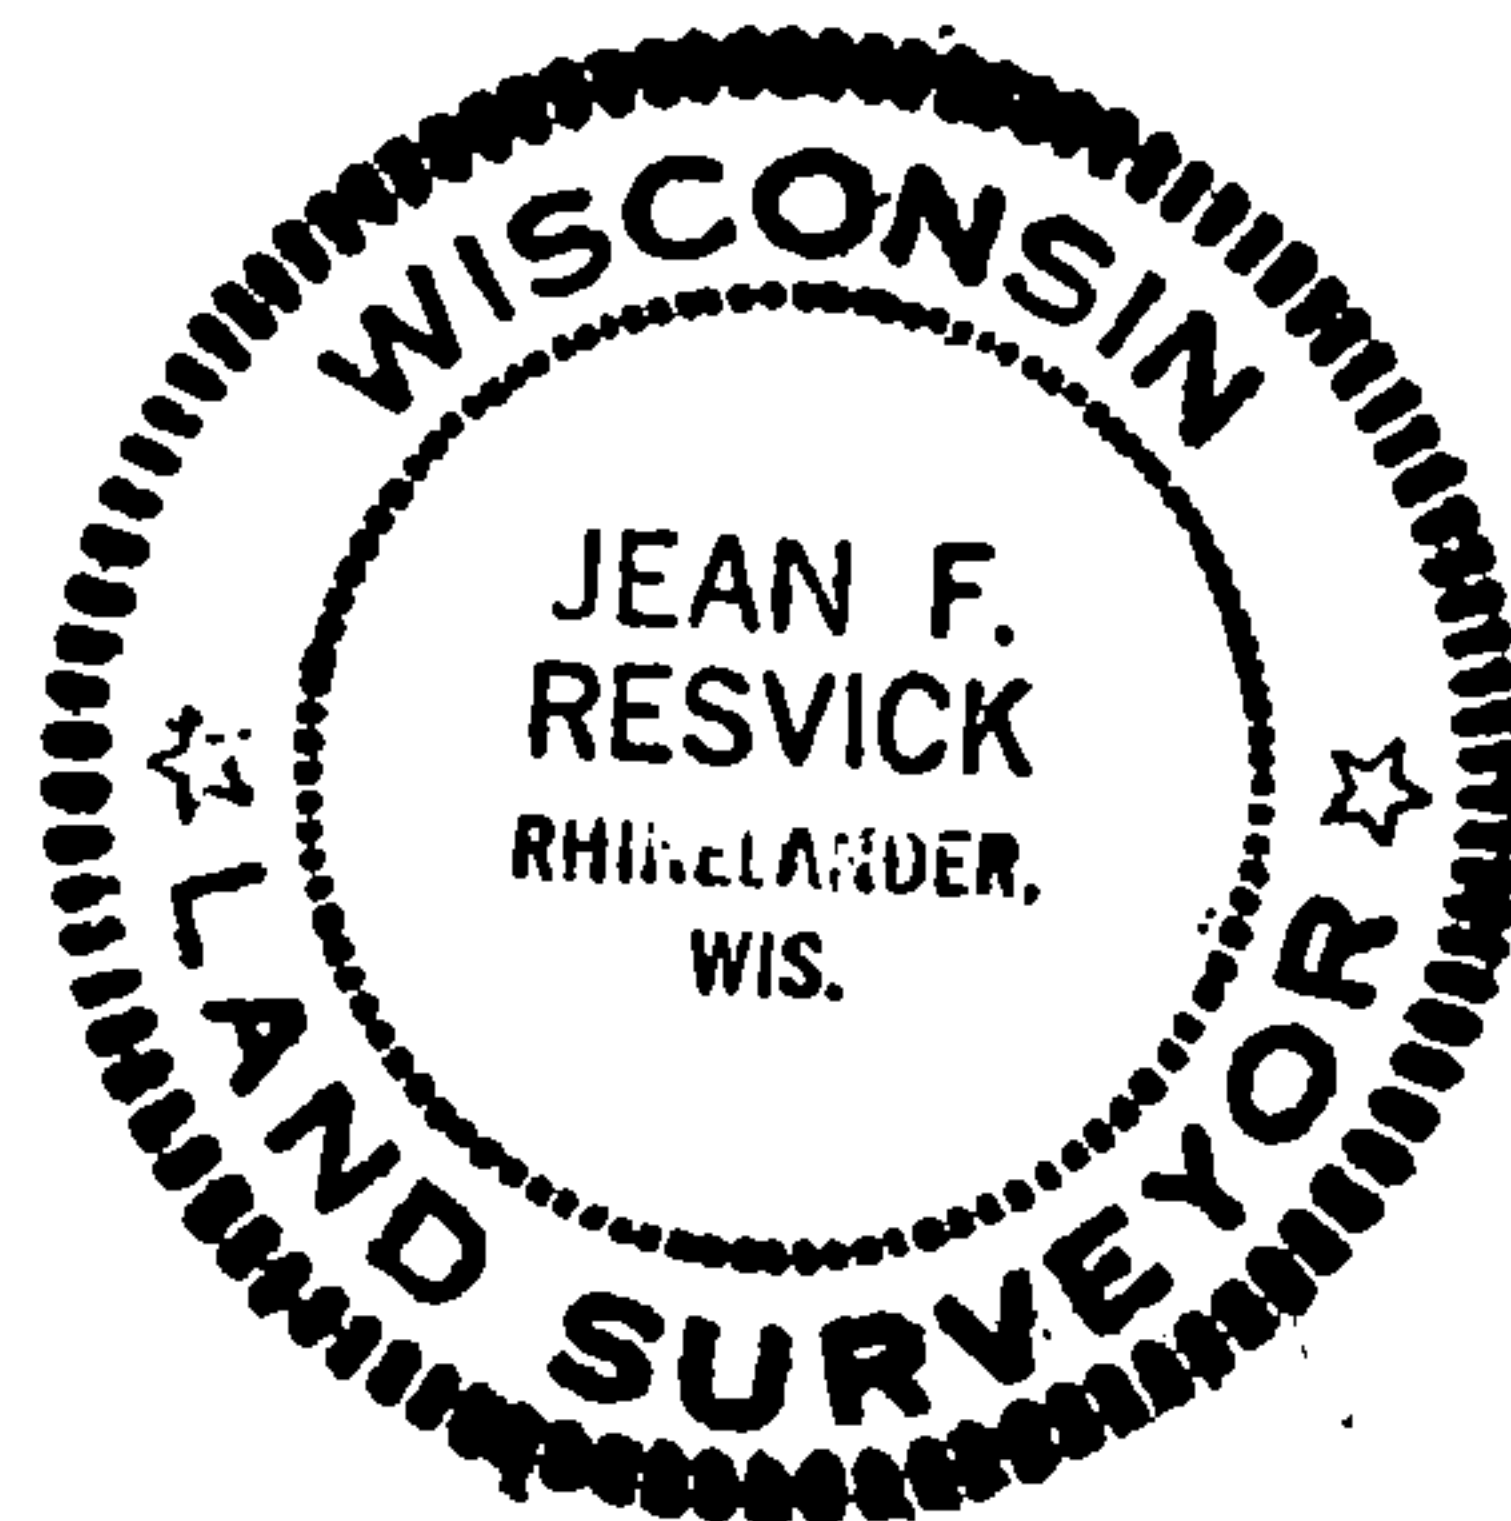

DOCUMENT NUMBER

102394

25

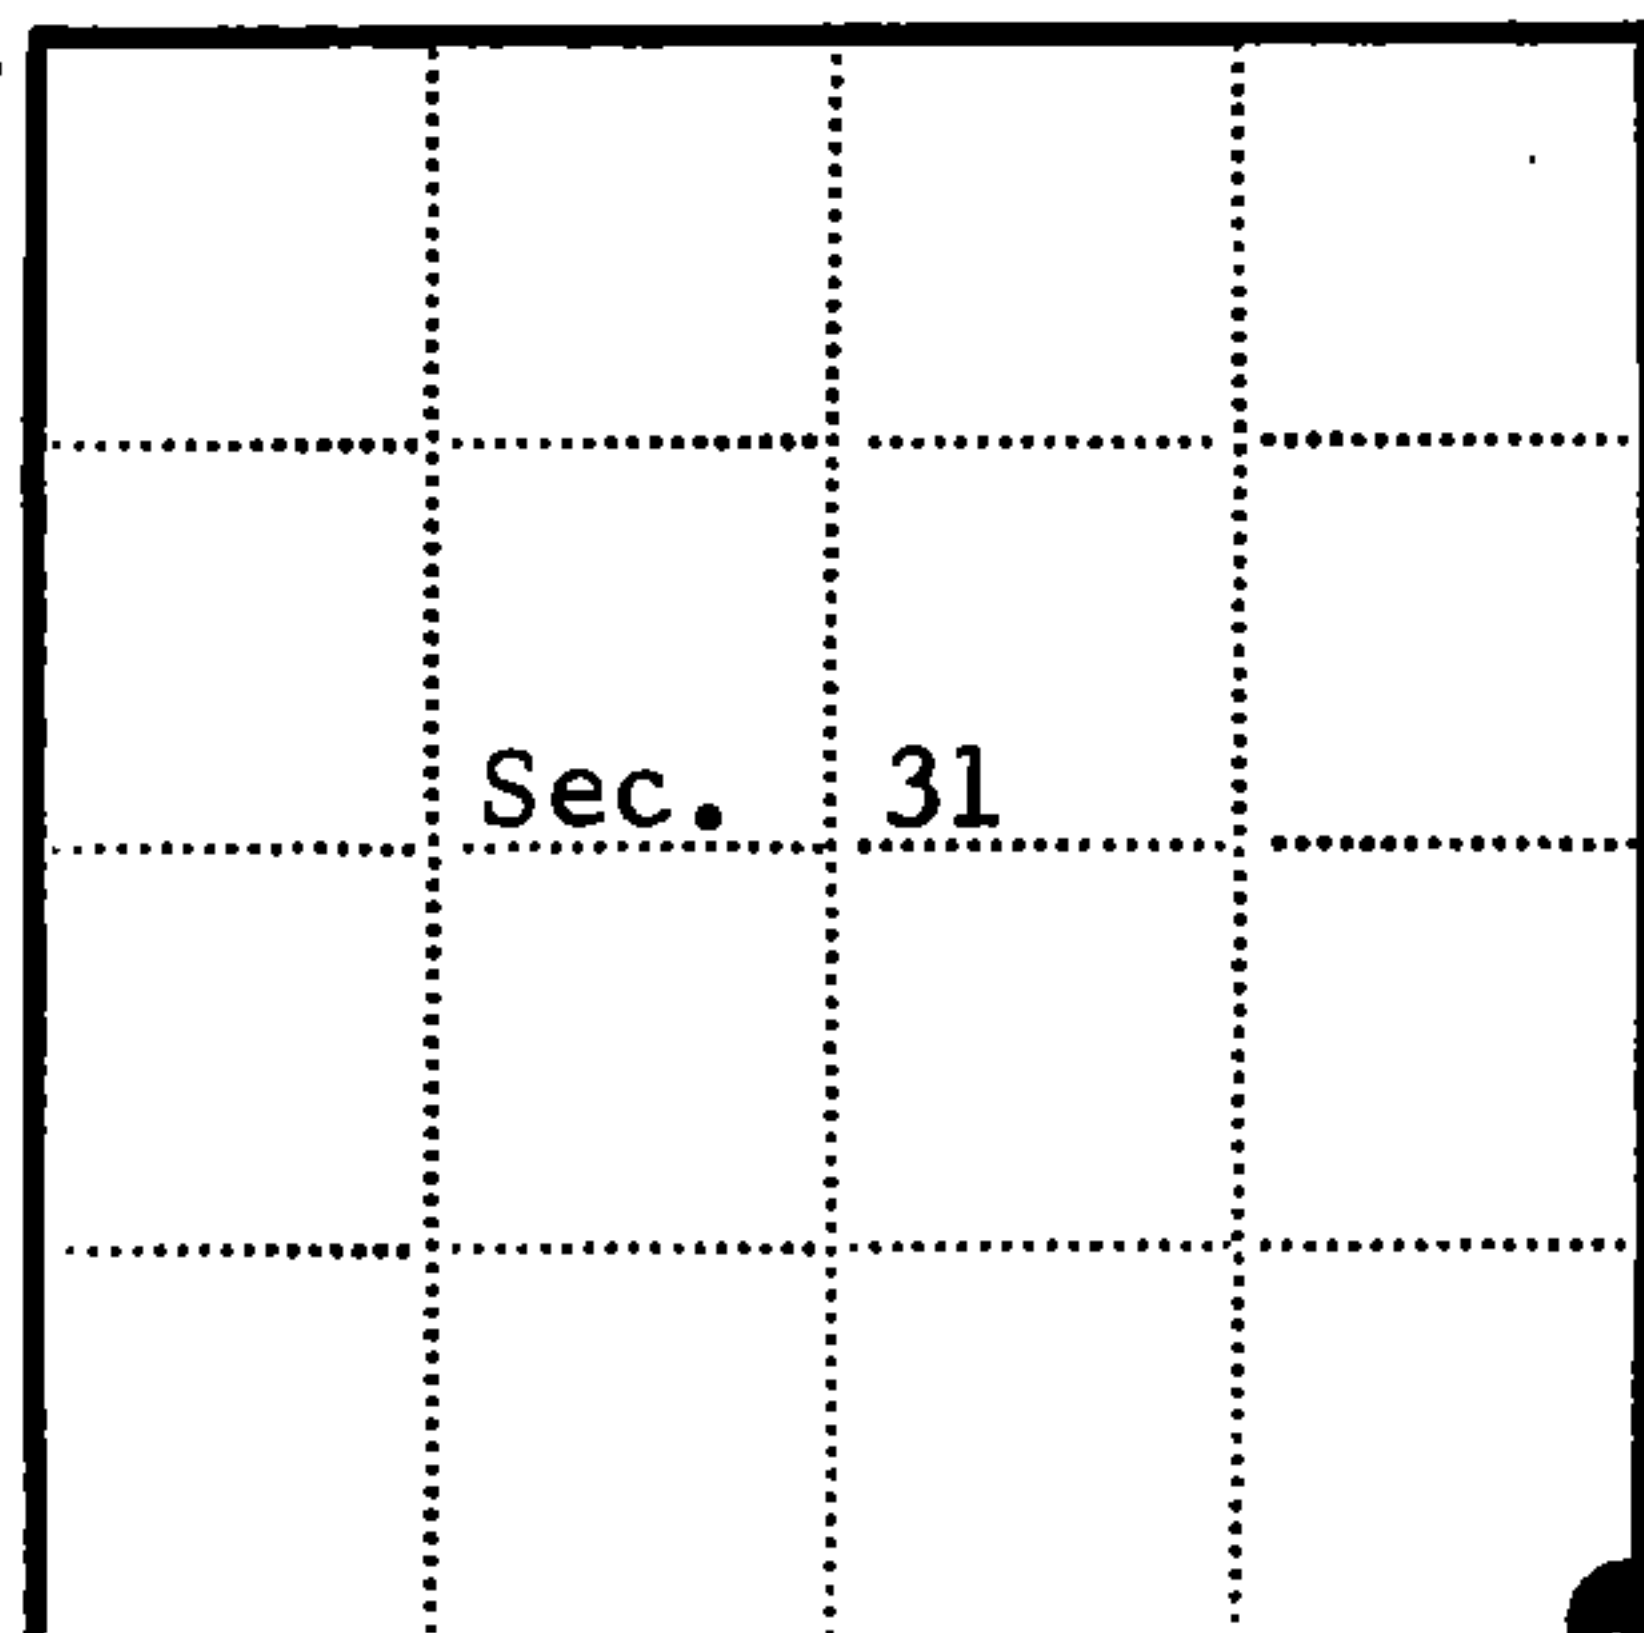

● = Corner monument restored

□ =

Resident witnesses

Dated at Rhinelander Wisconsin, this 12th day of Sept 1972.

Signature Jean F. Resvick Title Land Surveyor
(County Surveyor, Registered Land Surveyor, or other duly authorized official)

Surveyors Registration No. S-802

Office of Register of Deeds County of Forest

I hereby certify that the within instrument was filed in this office for record on the 18th day of October 9:30 AM 1972, and was filed in Book No. I Page No. 2-5 of County Records.

Signature Eugene Stegny Title Register of Deeds

Township 41 North, Range 13 East, Section 31, Index No. 2-5, Page No.

44113310000