

# CERTIFIED LAND CORNER RESTORATION

State of Wisconsin }  
County of Forest } ss.

I Jean F. Resvick, do hereby certify that on the 21st day of October, 1977, I found evidence of the South quarter corner of Section 35 Township 41 North Range 13 East, Fourth Principal Meridian, as described hereon; and that from this evidence I established a new monument and accessories as described hereon to perpetuate the original location of this corner:

Description of original monument and accessories and subsequent restorations:



Survey in 1865 by William Daugherty  
Dependent resurvey in 1942 by Guy R. Veal  
At proportionate distance for position in longitude and in center of road for position in latitude deposited a concrete monument, 12 inches long, 6 inches diameter, 24 inches in the ground for standard 1/4 corner, section 35, no marks. At a point North, 40 links distance, set a concrete monument, 24 inches long, 6 inches diameter, for witness standard quarter corner with brass cap marked: WC, SC, 1/4, S35, 1942.

Description of corner evidence found:

Monument as described above but stamped SC, 1/4, S35, 1942  
Dug in road and recovered corner mark, witness corner bears North 26.72 feet Hemlock 17, N55W, 32 lks.  
Maple 12, S77W, 7.5 lks.

Description of monument and accessories I established to perpetuate the location of this corner:

Place PK nail in center of corner mark.  
Hemlock 17, N23W, 42.22 feet, same bearing tree as for witness corner above  
Maple 10, N20E, 30.65 feet, blazed and scribed  
Set steel sign post near monument, place iron wheel around monument.

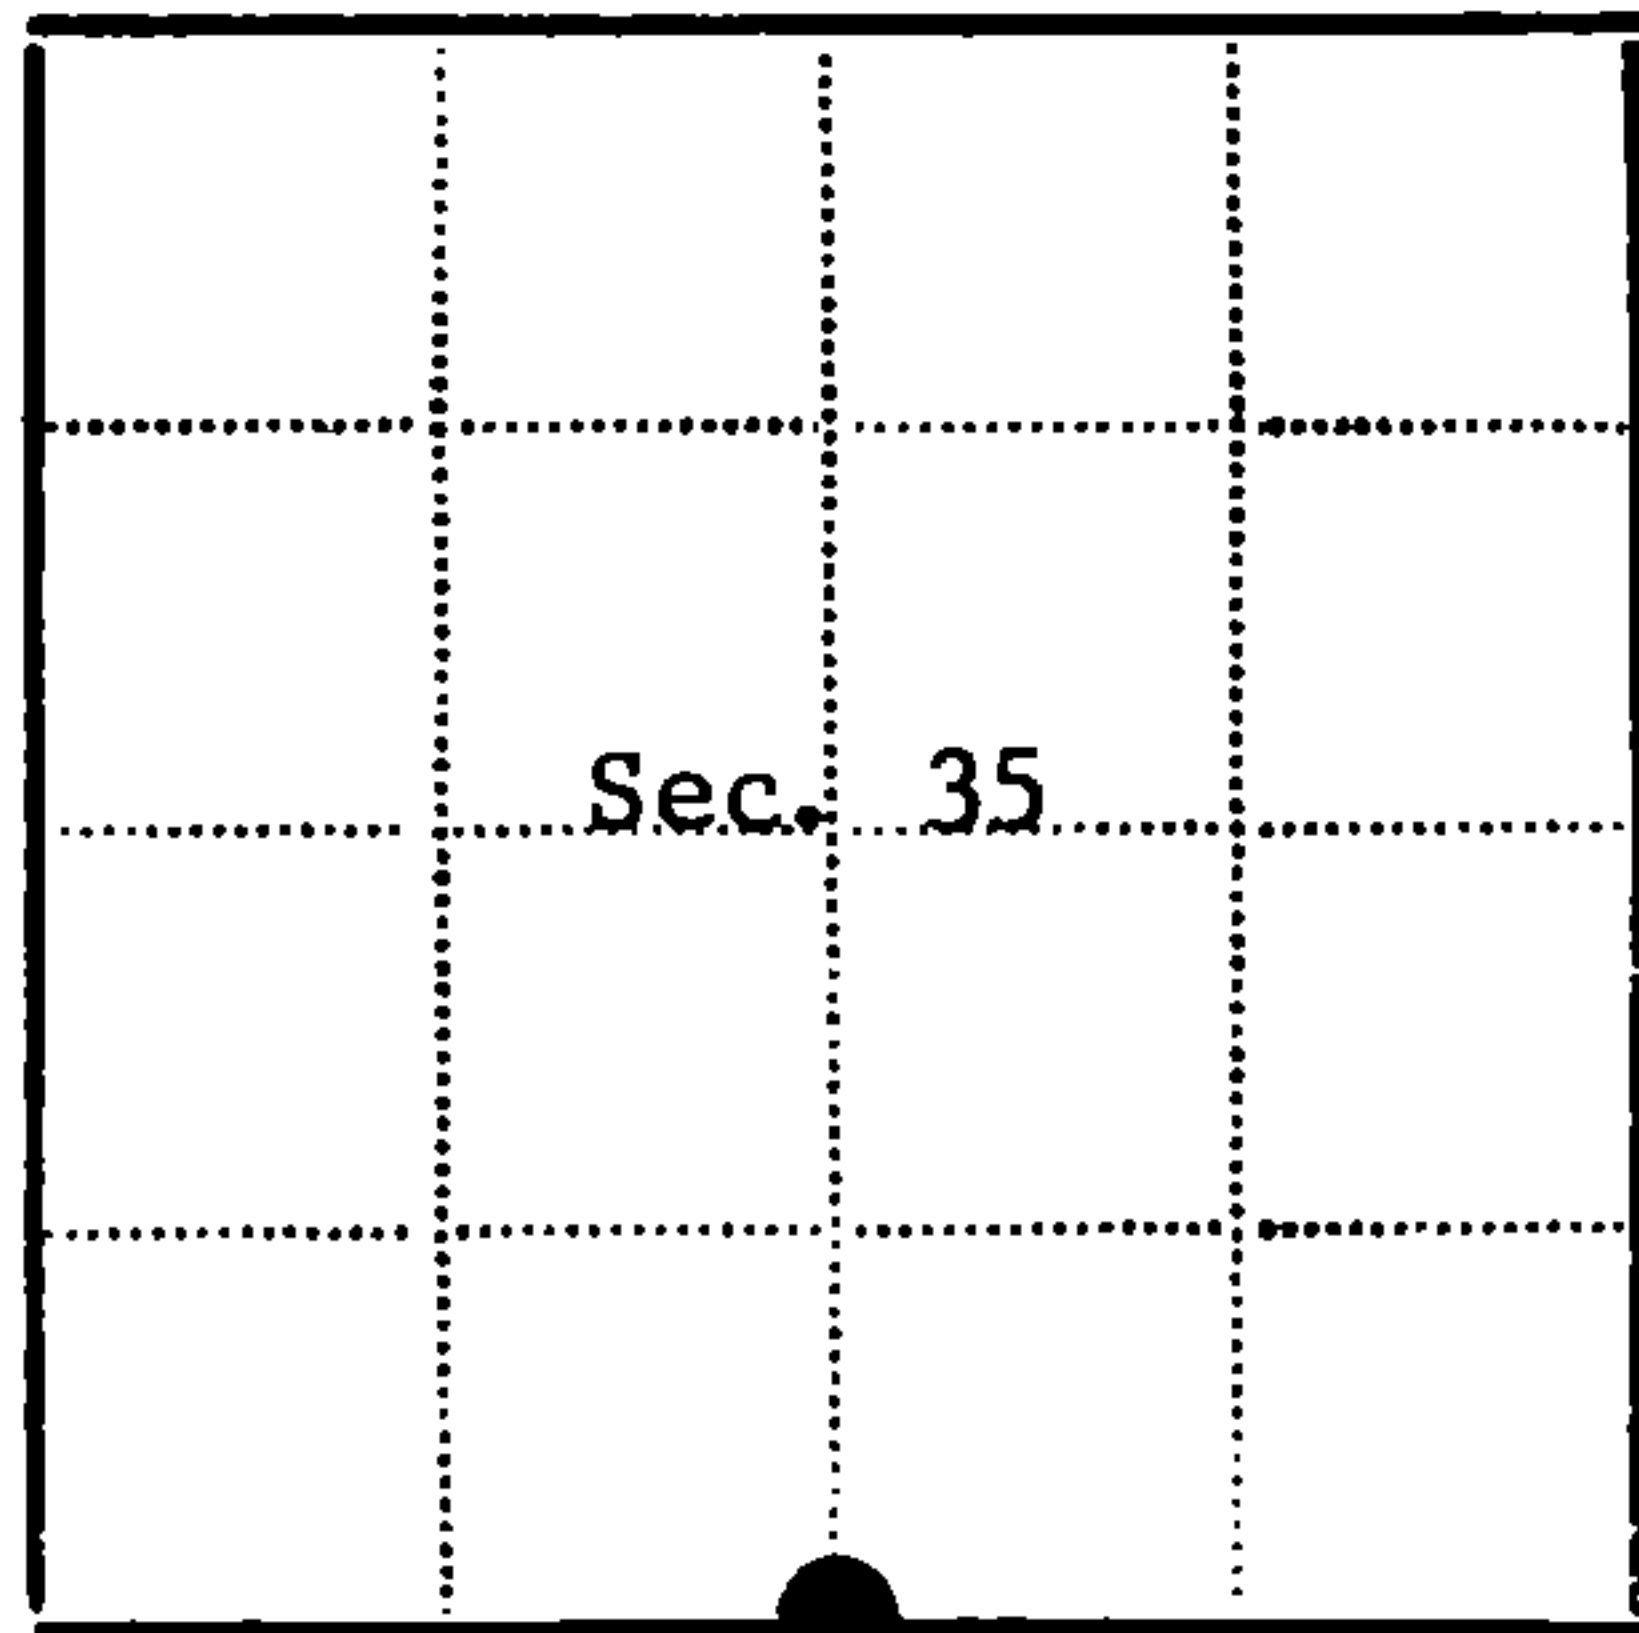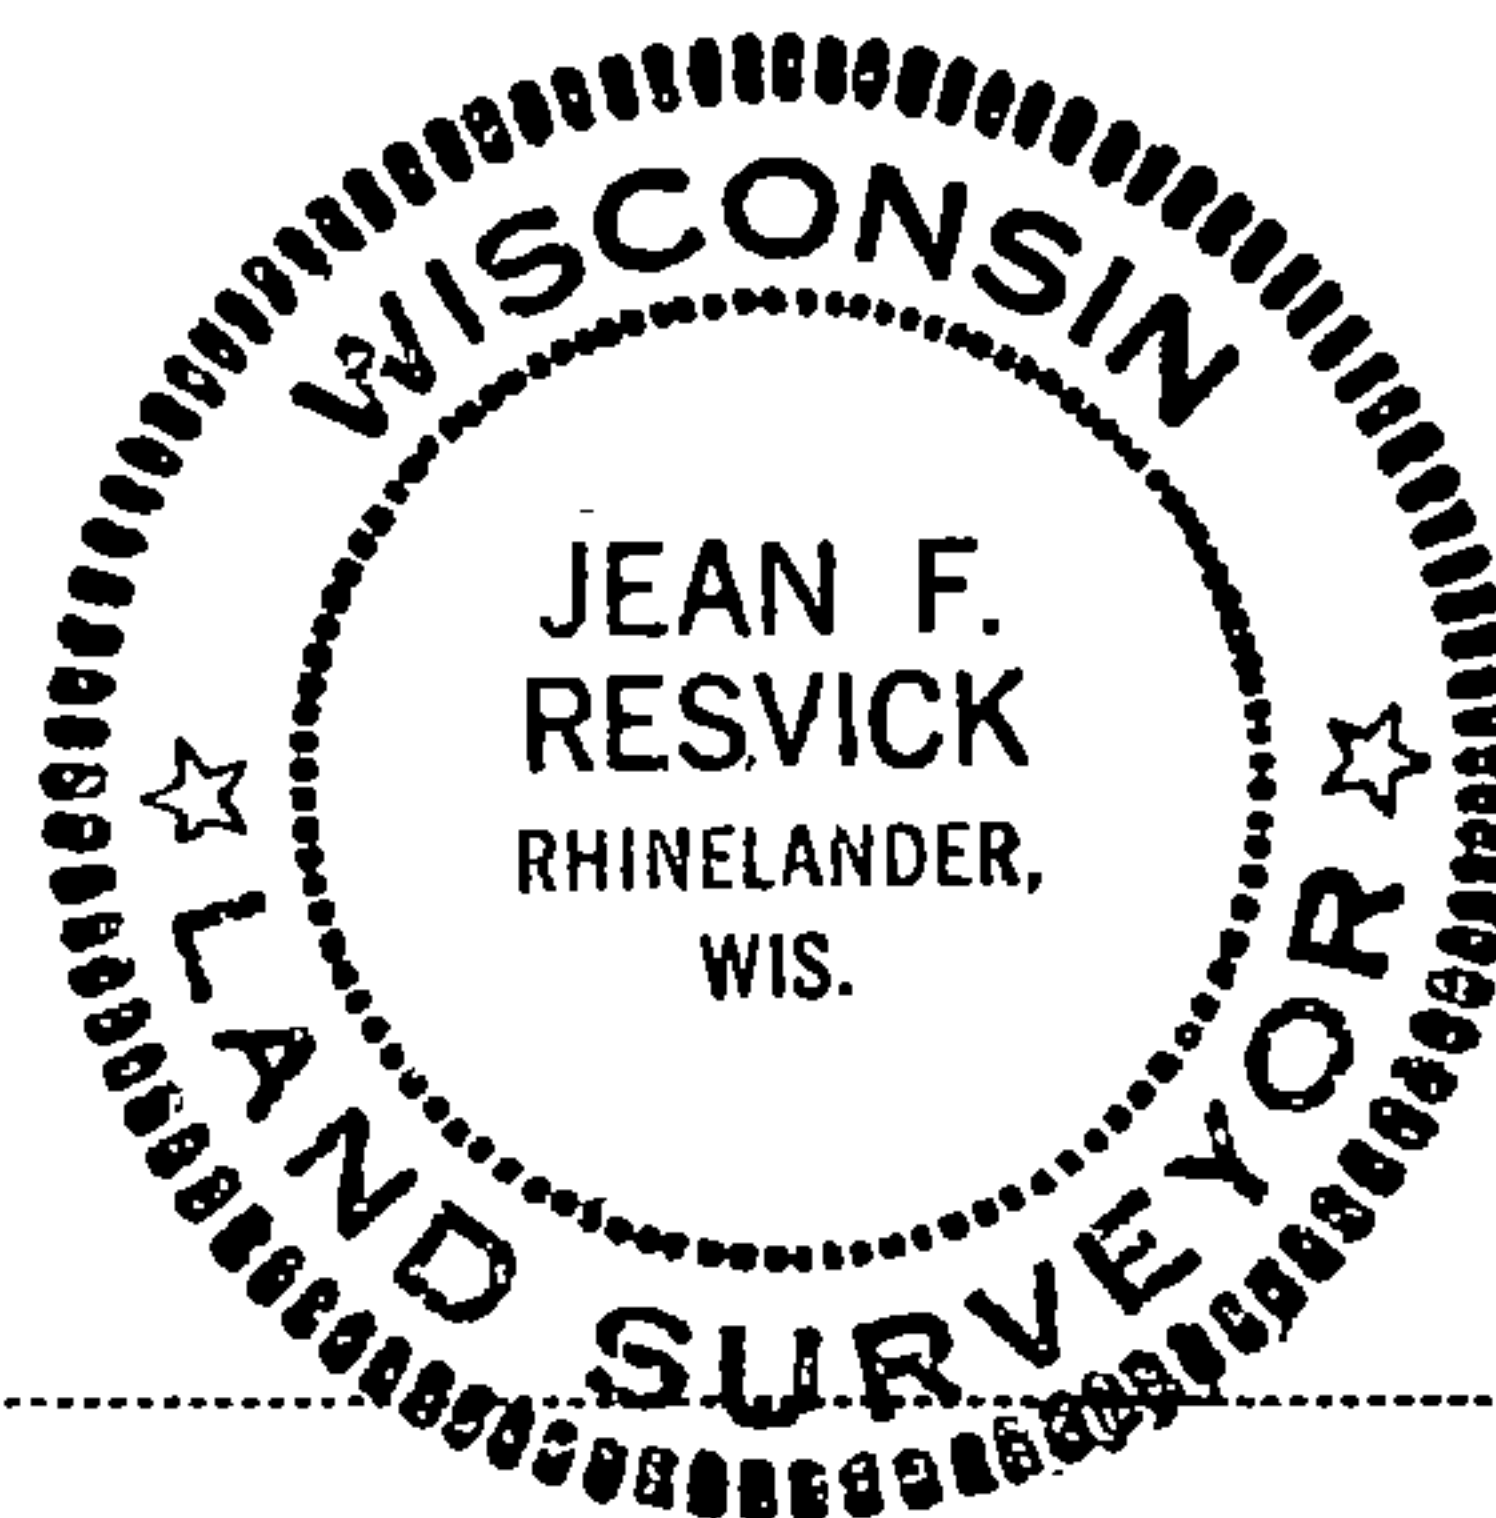

● - Corner monument restored  
□ -

Resident witnesses.....

Dated at Rhinelander Wisconsin, this 15 day of December 1977.

Signature *Jean F. Resvick* Title Land Surveyor  
(County Surveyor, Registered Land Surveyor, or other duly authorized official)

Surveyors Registration No. S-802 DOCUMENT NUMBER 113317

Office of Register of Deeds County of Forest

I hereby certify that the within instrument was filed in this office for record on the 13th day of February 1978, and was filed in Book No. Page No. of County Records.

Signature *Eugene Stutzman* Title Register of Deeds

Township 41 North, Range 13 East, Section 35, Index No. Z-19, Page No.

44113350020

SEE ALSO A-19-P40-13

719