



Stock No. 26273

REGISTER'S OFFICE  
Forest County, Wis.Received for record this 15th day  
of April, A.D., 1985 at  
3:10 o'clock P.M. and recorded  
in Vol. CORNER RESTORATION  
page 35-36, 16-17  
*Paul Aschebrenner*  
Register of DeedsDocument Number **127822**

Sheet 1 of 3

**CERTIFIED LAND CORNER  
RESTORATION & BOUNDARY  
ESTABLISHMENT**

Being the Corners on the Range Line to Sections 19-30, 24-25,  
30-31-25-36, 31-6-36-1, and Quarter Corners to Sections 25-30,  
and 36-31. Townships 35-36 North, Ranges 16-17 East, Fourth  
Principal Meridian, Forest and Marinette Counties, Wisconsin

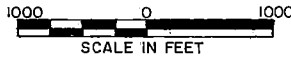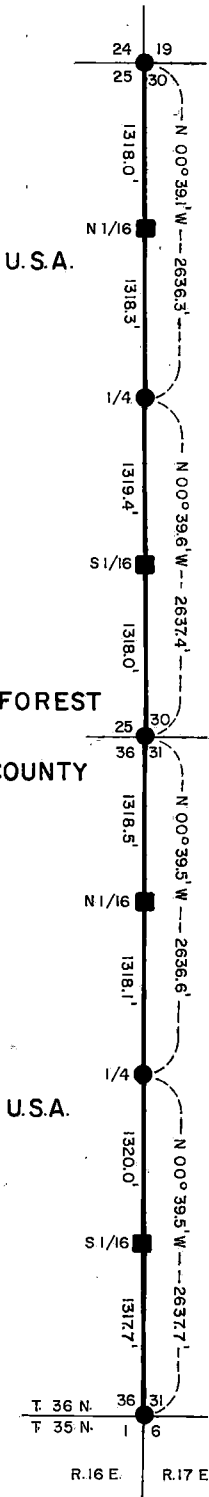MARINETTE  
COUNTY**LEGEND**

- 4" Iron Pipe With Marinette County Brass Cap
- 4"x4" Cedar Post Set By F Gould and B. Hammes In 1936-1937 Survey
- Marked Boundary Line of U.S. Government Land

Conversion Factors:  
Feet to Meters - 0.304801  
Meters to Feet - 3.280833

R. 16 E. R. 17 E.

T36-R16

4361625000

Stock No. 26273

Sheet 2 of 3

SURVEY NOTES

This survey was made by the U. S. Department of Agriculture, Forest Service, for the purpose of restoring and establishing corners on the range line between 16 and 17 East, for establishing corners on the range line, and for locating and marking the boundaries of U. S. Government lands on the perimeter of Township 36 North, Range 16-17 East, Fourth Principal Meridian, Marinette County, Wisconsin.

The U. S. Government lands in this section were acquired in 1935 and 1936.

The original government subdivision survey of this township was made in 1857.

The corner positions recovered, restored, and established by this survey are marked by the monument described in the map legend.

The corner positions established were located to an accuracy of one part in 3000.

The bearings between corner positions are true bearings as determined by solar observations.

The field notes of this survey and a copy of this plat are on file in the Forest Supervisor's Office at Rhineland, Wisconsin.

CORNERS RECOVERED AND RESTORED1. Township Corner to Sections 1-6-31-36, T.36-35N., R.16-17E.

Corner position found marked by a 4" iron pipe with Marinette County brass cap, as set by J. J. Jenkins in 1934-1935.

Corner References:

Maple	10"	N.22°E.	35.45 feet
Maple	13"	S.46°E.	32.07 feet
Maple	6"	S.68°W.	11.34 feet
Elm	7"	N.13°W.	31.43 feet
Steel Sign Post		North	1.20 feet

2. Section Corner to Sections 25-30-31-36, T.36N., R.16-17E.

Corner position found marked by a 4" iron pipe with Marinette County brass cap, as set by Frank Gould and Bernard Hammes in 1936-1937.

Corner References:

Cherry	12"	N.60°E.	25.67 feet
Ironwood	3"	S.38°E.	15.20 feet
Maple	26"	N.82°E.	176.22 feet
Maple	26"	S.16°W.	129.36 feet
Ironwood	4"	S.28°W.	23.35 feet
Aspen	4"	N.22°W.	17.12 feet
Steel Sign Post		South	2.64 feet

Stock No. 26273

Sheet 3 of 3

3. Section Corner to Sections 19-30-24-25, T.36N., R.16-17E.

Corner found marked by a 4" iron pipe with a Marinette County brass cap, as set by Frank Gould and Bernard Hammes in 1936-1937. They found the original bearing trees burnt out and an old post.

Corner References:

Aspen	4"	N.79°E.	94.81 feet
Spruce	8"	S.72°E.	128.00 feet
Cherry	3"	S.70°W.	102.56 feet
Cherry	10"	N.34°W.	73.45 feet
Steel Sign Post		South	1.85 feet

4. Quarter Corner to Sections 36-31, T.36N., R.16-17E.

Corner found marked by a 4" iron pipe with a Marinette County brass cap, as set by Frank Gould and Bernard Hammes in 1936-1937. They restored this corner by single proportionate measure.

Corner References:

Balsam	3"	S.88°E.	9.68 feet
Maple	14"	S.29°W.	15.94 feet
Maple		S.19°E.	17.82 feet
Elm	14"	N.60°W.	38.78 feet
Ironwood	10"	N.34°W.	74.58 feet
Steel Sign Post		South	3.94 feet

5. Quarter Corner to Sections 25-30, T.36N., R.16-17E.

Corner found marked by a 4" iron pipe with a Marinette County brass cap, as set by Frank Gould and Bernard Hammes. They restored this corner by single proportionate measure.

Corner References:

Basswood	10"	N.82°E.	20.10 feet
Ironwood	4"	S.70°W.	14.43 feet
Basswood	6"	N.28°W.	29.37 feet
Steel Sign Post		North	1.60 feet

SURVEYOR'S AFFIDAVIT

State of Wisconsin ]  
County of Marinette ] SS

I, Milo E. Stefan, Cadastral Surveyor, U. S. Forest Service, and a registered surveyor in the State of Wisconsin, hereby certify that I have surveyed the range line of Township 36 North, Range 16-17 East, Fourth Principal Meridian, State of Wisconsin.

The plat map and the notes herewith are a correct representation of the land surveyed and divided. I have surveyed and subdivided said section in accordance with the rules for survey of the public lands and with the statutes of the State of Wisconsin.



*Milo E. Stefan*

Cadastral Surveyor, U. S. Forest Service  
R.L.S., State of Wisconsin  
Certificate S-1558

Plat Ready For Filing

*Dale S. Stange*  
District Ranger

Date of Survey: 1984

Stock No. 26273

Document Number 127833

REGISTER'S OFFICE

Forest County, Wis.

Received for record this 19th day

of April A.D. 1985 at

3:10 o'clock P.M. and recorded

in Vol. CORNER RESTORATION

pages 35, 36, 16

Paul Aschenbrenner


Register of Deeds

SHEET 1 OF 3

# CERTIFIED LAND CORNER RESTORATION AND BOUNDARY ESTABLISHMENT

Being the Section Corners to Sections 1-2-35-36; 2-3-34-35; and 3-4-33-34;  
and Quarter Corners to Sections 2-35; and 3-34; with Boundary Lines Between  
Sections 2-35.

Township 35-36 North, Range 16 East,  
Fourth Principal Meridian  
FOREST COUNTY, WISCONSIN

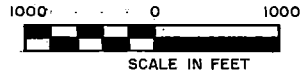

## Legend


- 2" Diameter Aluminum Monument - 36" Long
- 2" Diameter Iron Pipe with a Brass Cap - 60" Long
- Marked Boundary Line of U.S. Government Lands

## Conversion Factors

Feet to Meters - 0.304801  
Meters to Feet - 3.280833



43616340000

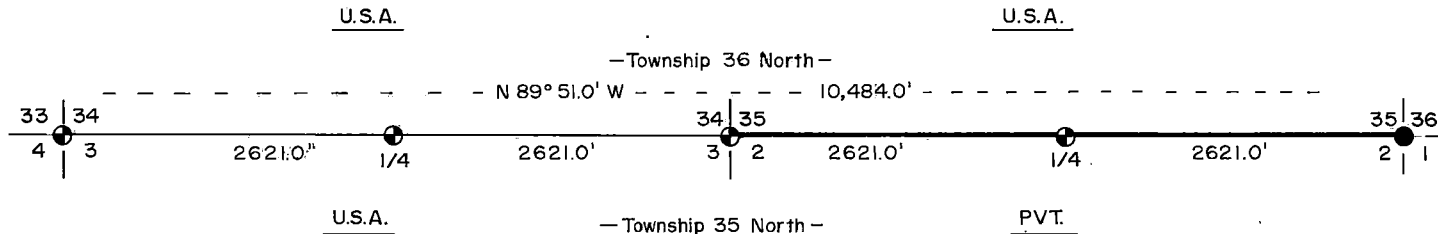

-736-R16

Stock No. 26273

Sheet 2 of 3

SURVEY NOTES

This survey was made by the U. S. Department of Agriculture, Forest Service, for the purpose of restoring and establishing corners on the perimeter of Section 2 and for locating and marking the boundaries of U. S. Government land on the perimeter of Section 2, Township 35-36 North, Range 16 East, Fourth Principal Meridian, Forest County, Wisconsin.

The U. S. Government lands in this section were acquired in 1935 and 1936.

The original Government subdivision survey of this township was made in 1857.

The corner positions recovered, restored, and established by this survey are marked by the monument described in the map legend.

The corner positions established were located to an accuracy of one part in 3000.

The bearings between corner positions are true bearings as determined by solar observations.

The field notes of this survey and a copy of this plat are on file in the Forest Supervisor's Office at Rhinelander, Wisconsin.

CORNERS RECOVERED AND RESTORED1. Section Corner to Sections 1, 2, 35, and 36, T.35-36N., R.16E.

Corner position found marked by a 2" iron pipe with brass cap set by Jean Resvick on July 22, 1969. Certificate on file--Document Number 98043.

2. Section Corner to Sections 2, 3, 34, and 35, T.35-36N., R.16E.

Corner position was restored by single proportionate measure from section corners 1 mile east and west.

Corner References:

Basswood	7"	N.43°E.	45.55 feet
Sugar Maple	5"	S.76°E.	123.53 feet
White Oak	7"	S.09°W.	63.55 feet
Sugar Maple	4"	N.59°W.	46.07 feet
Flue Pipe	2"	N.8°05'31"E.	9.51 feet
Steel Sign Post	7'	East	1.40 feet

3. Section Corner to Sections 3, 4, 33, and 34, T.35-36N., R.16E.

Corner position found marked by a 1½" flue pipe 2' above the ground, which was set by Goodman Lumber Company in 1926 from the original bearing trees.

Corner References:

Sugar Maple	7"	N.82°E.	8.22 feet
Yellow Birch	8"	S.20°E.	27.93 feet
Black Cherry	14"	S.37°W.	23.75 feet
Sugar Maple	8"	N.29°W.	23.90 feet
Steel Sign Post	7'	Northwest	1.50 feet

Stock No. 26273

Sheet 3 of 3

4. One-Quarter to Sections 2 and 35, T.35-36N., R.16E.

Corner position was restored by single proportionate position.

Corner References:

Sugar Maple	10"	N.77°E.	63.80 feet
Sugar Maple	6"	S.28°E.	47.30 feet
Sugar Maple	6"	N.68°W.	21.80 feet
Flue Pipe	2"	N.12°51'10"E.	11.44 feet
(Goodman Lumber Company)			
Steel Sign Post	7'	West	1.50 feet

5. One-Quarter Corner to Sections 3 and 34, T.35-36N., R.16E.

Corner position was restored by single proportionate position.

Corner References:

Sugar Maple	5"	N.19°E.	22.79 feet
Sugar Maple	10"	S.06°W.	78.53 feet
Basswood	9"	N.51°W.	47.47 feet
Flue Pipe	2"	N.38°49'15"W.	7.00 feet
(Goodman Lumber Company)			
Steel Sign Post	7'	Northeast	1.30 feet

SURVEYOR'S AFFIDAVIT

State of Wisconsin ]  
 County of Forest    SS

I, Milo E. Stefan, Cadastral Surveyor, U. S. Forest Service and a registered surveyor in the State of Wisconsin, hereby certify that I have surveyed Section 2, Township 35-36 North, Range 16 East, Fourth Principal Meridian, State of Wisconsin.

The plat map and the notes herewith are a correct representation of the land surveyed. I have surveyed said section in accordance with the rules for survey of the public lands and with the statutes of the State of Wisconsin.



Milo E. Stefan  
 Cadastral Surveyor, U. S. Forest Service  
 R.L.S., State of Wisconsin  
 Certificate S-1558

Plat Ready For Filing

Dale S. Staeger  
 District Ranger

Date of Survey: 1984

Stock No. 26273

Document Number 1289824

REGISTER'S OFFICE

Forest County, Wis.

Received for record this 15th day

of April, A.D. 1985, at

3:10 P.M. and recorded

in Vol. CORNER RESTORATION

pages 36-15, 16



Paul Holmgren

Register of Deeds

SHEET 1 OF 1

**CERTIFIED LAND CORNER RESTORATION AND ESTABLISHMENT**

Being the North and West Sides of Section 35, Township 36 North,  
Range 15 East, and the South and East Sides of Section 25, Township 36 North, Range 15-16 East

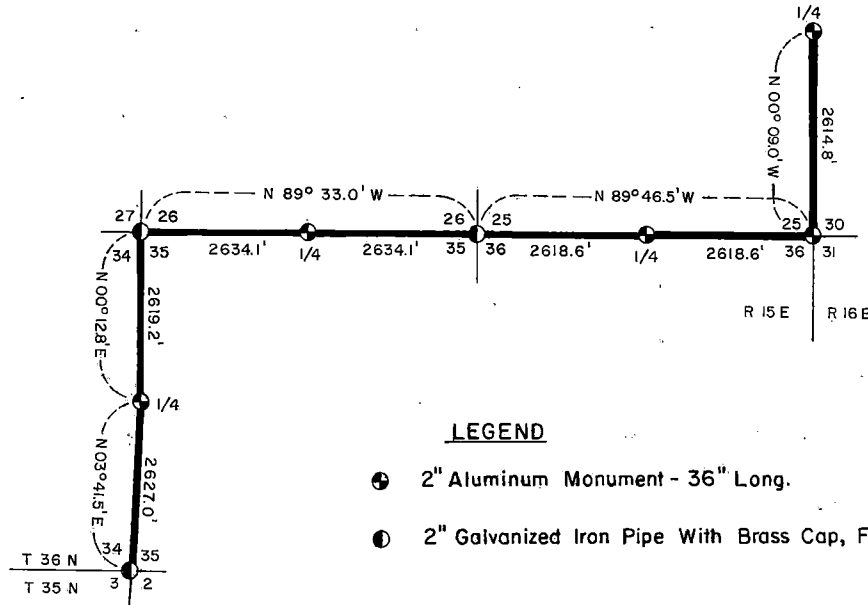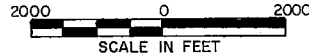**LEGEND**

- 2" Aluminum Monument - 36" Long.
- 2" Galvanized Iron Pipe With Brass Cap, Filled With Concrete - 36" Long.

Conversion Factor:  
Feet to Meters - 0.304801  
Meters to Feet - 3.280833

T 36-R16 43616250000

Stock No. 26273

Sheet 2 of 4.

SURVEY NOTES

This survey was made by the U. S. Department of Agriculture, Forest Service, for the purpose of restoring and establishing corners on the west and north sides of Section 35 and the south and east sides of Section 25 and for locating and marking the boundaries of U. S. Government land in Township 36 North, Range 15 East, Fourth Principal Meridian, Forest County, Wisconsin.

The U. S. Government lands in these sections were acquired in 1935 and 1936.

The original Government subdivision survey of this township was made in 1858 and 1859.

The corner positions recovered, restored, and established by this survey are marked by the monument described in the map legend.

The corner positions established were located to an accuracy of one part in 3000.

The bearings between corner positions are true bearings as determined by solar observations.

The field notes of this survey and a copy of this plat are on file in the Forest Supervisor's Office at Rhinelander, Wisconsin.

CORNERS RECOVERED AND RESTORED1. Section Corner to Sections 25, 30, 31, and 36, T.36N., R.15-16E.

Corner position recovered from original Elm stump and supported by two stump holes. Also found large chopped out face on 20"-24" Hemlock with location poster.

Corner References:

Sugar	9"	N.12°E.	17.58	feet
Hemlock	16"	S.35°E.	28.31	feet
Hemlock	12"	S.78°W.	58.72	feet
Sugar	6"	N.74°W.	34.74	feet
Steel Sign Post		Southwest	2.20	feet

2. Section Corner to Sections 2, 3, 34, and 35, T.35-36N., R.15E.

Corner position found marked by a 2" x 36" galvanized iron pipe filled with concrete, with brass cap. Certificate filed with the Register of Deeds, Document No. 118083.

Corner References:

Maple	6"	N.23°E.	11.54	feet
Maple	8"	S.8°E.	6.89	feet
Yellow Birch	10"	S.58°W.	13.28	feet
Basswood	14"	N.22°W.	30.38	feet

3. Section Corner to Sections 25, 26, 35, and 36, T.36N., R.15E.

Corner position found marked by a 2" x 36" galvanized iron pipe filled with concrete, with a brass cap. Filed with the Register of Deeds, Document No. 118082.

Corner References:

Maple	8"	N.65°E.	17.67	feet
Basswood	15"	S.20°E.	35.95	feet
Basswood	10"	S.63°W.	19.49	feet
Maple	14"	N.17°W.	22.54	feet

Stock No. 26273

Sheet 3 of 4

4. Section Corner to Sections 26, 27, 34, and 35, T.36N., R.15E.

Corner position found marked by a 2" x 36" galvanized iron pipe filled with concrete, with a brass cap. Filed with the Register of Deeds, Document No. 118081.

Corner References:

Yellow Birch	10"	East	25.81 feet
Maple	7"	S.13°E.	21.92 feet
Double			
Yellow Birch	9"	S.40°W.	20.46 feet
Maple	6"	N.48°W.	9.44 feet
Steel Sign Post		South	0.50 feet

5. Quarter Corner to Sections 25 and 30, T.36N., R.15-16E.

Corner position found marked by a fallen post and post hole, remains of original Hemlock bearing tree, and a location poster by Robert Baker of the CCCs.

Corner References:

Sugar Maple	8"	N.4°E.	32.66 feet
Hemlock	18"	S.71°E.	53.35 feet
Sugar Maple	12"	S.68°W.	9.41 feet
Steel Sign Post		North	23.00 feet

6. Quarter Corner to Sections 25 and 36, T.36N., R.15E.

Corner position restored midpoint and on line between section corners.

Corner References:

Sugar Maple	6"	N.48°E.	32.21 feet
Hemlock	12"	S.23°E.	62.11 feet
Hemlock	18"	N.2°W.	35.55 feet
Steel Sign Post		East	2.00 feet

7. Quarter Corner to Sections 26 and 35, T.36N., R.15E.

Corner position restored midpoint and on line between the section corners.

Corner References:

Sugar Maple	11"	N.20°E.	28.93 feet
Yellow Birch	10"	N.47°W.	21.25 feet
Steel Sign Post		Northeast	0.50 feet

8. Quarter Corner to Sections 34 and 35, T.36N., R.15E.

Corner position restored from original bearing tree stump and stump hole; also, beaver blazes 55 to 60 years old.

Corner References:

Yellow Birch	6"	N.34°E.	37.66 feet
Sugar Maple	8"	S.65°E.	33.39 feet
Sugar Maple	5"	S.31°W.	23.70 feet
Steel Sign Post		North	3.00 feet

Stock No. 26273

Sheet 4 of 4

SURVEYOR'S AFFIDAVIT

State of Wisconsin ] SS  
 County of Forest ]

I, Milo E. Stefan, Cadastral Surveyor, U. S. Forest Service and a registered surveyor in the State of Wisconsin, hereby certify that I have surveyed and restored the corners and boundaries on the west and north sides of Section 35 and the south and east sides of Section 25, Township 36 North, Range 15 East, Fourth Principal Meridian, State of Wisconsin.

The plat map and the notes herewith are a correct representation of the land surveyed and divided. I have surveyed and subdivided said section in accordance with the rules for survey of the public lands and with the statutes of the State of Wisconsin.




Milo E. Stefan  
 Cadastral Surveyor, U. S. Forest Service  
 R. L. S., State of Wisconsin  
 Certificate S-1558

Plat Ready For Filing

Dale S. Stange  
 District Ranger

Date of Survey:

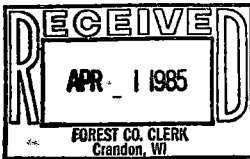

*Dora C. James*  
*Forest Co. Clerk*


## U. S. PUBLIC LAND SURVEY MONUMENT RECORD

INSTRUCTIONS: This record shall show the location of the corner and shall include all of the following nine elements (a through i).

- (a) Identify the corner by reference to the U.S. public land survey system.

○ = Corner monument restored.

Section corner to Sections 5, 6, 31, and 32,  
T.36-37N., R.16E.

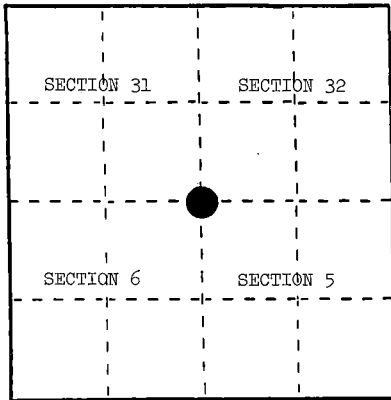

- (b) Describe any record evidence, monument evidence, occupational evidence, testimonial evidence or any other material evidence you considered, and whether the monument was found or placed.

In 1857, Artemas Curtis set post with the following BTs: Yellow Birch, 8", N.60°W., 20 links; Yellow Birch, 12", N.4°E., 23 links; Yellow Birch, 12", S.83°E., 15 links; Yellow Birch, 8", S.74°W., 5 links. Swamp edge, 2 chains east.


In the 1930s, CCC cruiser, unknown name and date, found squared stake and Yellow Birch, 14", 30 links. Put poster on Hemlock, 7", S.38°E., 10 links.

November 30, 1984, Alan Harrison found 3" scribed wood post and picket from which the following bear: Yellow Birch (blazes visible), N.60°W., 13.20'; Yellow Birch stump, N.4°E., 15.2'; stump mound, S.83°E., 9.9'; stump depression, S.74°W., 3.3'; 14" Hemlock with location poster, S.38°E., 6.7'.

- (c) In the plan view drawing below, provide reference ties to at least 4 witness monuments, or, if the location is within a municipality, to at least 2 witness monuments. (Witness monuments shall be made of concrete, natural stone, iron or other equally durable material.)  
Describe witness monuments.

- (d) Show a plan view drawing depicting the relevant monuments and reference ties which is sufficient in detail to enable accurate relocation of the corner monument if the corner monument is disturbed. Indicate north.

- 2" x 30" aluminum monument stamped to identify the corner.
- Yellow Birch, 18", N.22°E., 47.63'
- Hemlock, 12", South, 19.66'
- Yellow Birch, 14", S.71°W., 21.75'
- Hemlock, 14", N.37°W., 47.39'
- Steel Sign Post, East, 1.59'

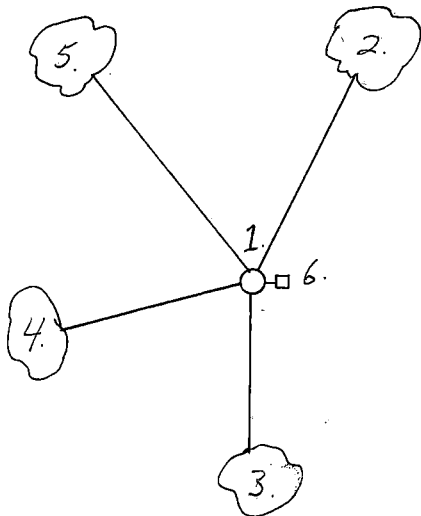

REGISTER'S OFFICE }  
Forest County, Wis.

Received for record this... 23rd day

of January... A.D., 1985 at

9:00 o'clock... M and

recorded in Vol. CORNER RESTORATION

on page 5...  
J. A. Schenker  
REGISTER

- (e) Describe any material discrepancy between the location of the corner as restored or reestablished and the location of that corner as previously restored or reestablished by distance and direction. Show the discrepancy on the plan view drawing under (d), above. Show the distances between the corner as previously restored or reestablished and (1) the corner as restored or reestablished, and (2) to at least 2 of the witness monuments shown on the drawing in (d), above.

None.

- (f) Was the corner restored through acceptance of (1) an obliterated evidence location, or, (2) a found perpetuated location?


(2) a found perpetuated location.

- (g&h) Was the corner reestablished through lost corner proportionate methods? If so, show the method, including the directions and distances to other public land survey corners used as evidence or used for proportioning in determining the corner location?

No.

- (1) I, Alan D. Harrison  
(type or print name) certify that the corner location shown on this record was determined by me or under my direction and control and that this U.S. Public Land Survey Monument Record is correct and complete to the best of my knowledge and belief.

Alan D. Harrison 12/14/84  
Signature Date

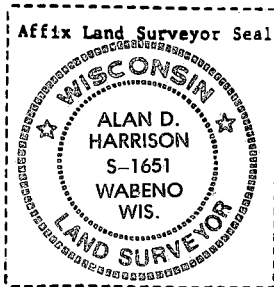


## U. S. PUBLIC LAND SURVEY MONUMENT RECORD

## INSTRUCTIONS:

This record shall show the location of the corner and shall include all of the following nine elements (a through i).

- (a) Identify the corner by reference to the U.S. public land survey system.  
 O = Corner monument restored.

Quarter Corner Common to Section 5, T.36N., R.16E., and Section 32, T.37N., R.16E., Forest County, Wisconsin.

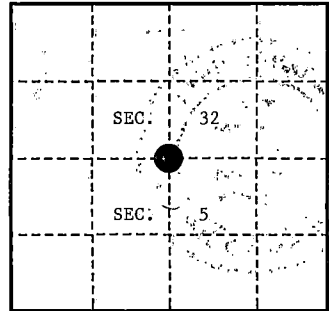

- (b) Describe any record evidence, monument evidence, occupational evidence, testimonial evidence or any other material evidence you considered, and whether the monument was found or placed.

In 1857, Artemas Curtis set  $\frac{1}{2}$  post and made the following references: Yellow Birch, 12", N.54°E., 31 links (20.46'); Ironwood, 8", S.68°W., 22 links (14.52').

In 1920's Goodman Company notes do not have information on this corner.


In June 1981, Milo Stefan found 5" x 5" squared balsam post in fenceline on rock fence. Blazed Hemlock, 16", s.68°W., 10.8', dead with no scribing and a blazed Sugar, 12", N.31°E., 23.7'.

In June 1993, Alan Harrison found post as per Stefan in poor condition. Post fits within 3 feet of proportion. Accepted as best evidence of corner location.

- (c) In the plan view drawing below, provide reference ties to at least 4 witness monuments, or, if the location is within a municipality, to at least 2 witness monuments. (witness monuments shall be made of concrete, natural stone, iron or other equally durable material.)

- (d) Show a plan view drawing depicting the relevant monuments and reference ties which is sufficient in detail to enable accurate relocation of the corner monument if the corner monument is disturbed. Indicate north.

1. 2 $\frac{1}{2}$ " x 36" Aluminum Monument stamped to identify corner location.
2. Sugar, 6", N.50°E., 27.72 feet
3. Sugar, 9", S.22°E., 12.88 feet
4. Sugar, 7", S.65°W., 18.81 feet
5. Steel Sign Post, South, 1.58 feet

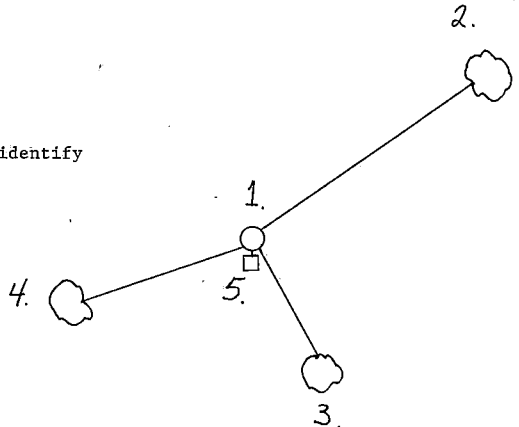

REGISTER'S OFFICE  
 Forest County, Wis.

Received for record this 30th day  
 of JUNE A.D., 1992 at

2:00 o'clock P.M. and recorded

in Vol. CORNER RESTORATIONS

page A-7

*Paul Hochman*  
 Register of Deeds

43716 320020

- (a) Describe any material discrepancy between the location of the corner as restored or reestablished and the location of that corner as previously restored or reestablished by distance and direction. Show the discrepancy on the plan view drawing under (d), above. Show the distances between the corner as previously restored or reestablished and (1) the corner as restored or reestablished, and (2) to at least 2 of the witness monuments shown on the drawing in (d), above.

None.

- (f) Was the corner restored through acceptance of (1) an obliterated evidence location, or, (2) a found perpetuated location?

A found perpetuated location.

- (g & h) Was the corner reestablished through lost corner proportionate methods? If so, show the method, including the directions and distances to other public land survey corners used as evidence or used for proportioning in determining the corner location?

No.


- (1) I, Alan D. Harrison  
(type or print name) certify that the corner location shown on this record was determined by me or under my direction and control and that this U.S. Public Land Survey Monument Record is correct and complete to the best of my knowledge and belief.

Alan D. Harrison  
Signature

6/16/93  
Date

CERTIFICATE READY FOR FILING:

Sue Vap  
District Ranger

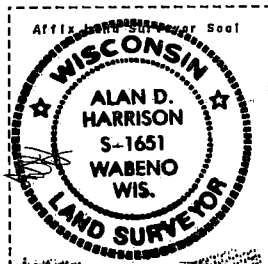


## U. S. PUBLIC LAND SURVEY MONUMENT RECORD

## INSTRUCTIONS:

This record shall show the location of the corner and shall include all of the following nine elements (a through i).

- (a) Identify the corner by reference to the U.S. public land survey system.  
 O = Corner monument restored.

Corner Common to Sections 4, 5, 32, and 33,  
 T.36-37N., R.16E., Forest County, Wisconsin.

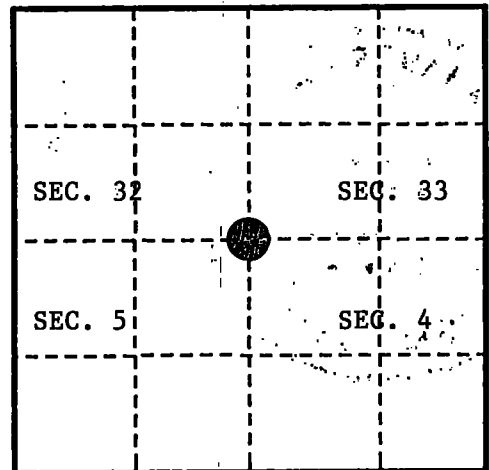

- (b) Describe any record evidence, monument evidence, occupational evidence, testimonial evidence or any other material evidence you considered, and whether the monument was found or placed.

In 1857, Artemas Curtis set post for corner and made the following references: Hemlock, 15", N.38°W., 9 links (5.94'); Yellow Birch, 22", N.46°E., 32 links (21.12'); Hemlock, 18", S.42°E., 26 links (17.16'); Yellow Birch, 10", S.32°W., 28 links (18.48').

In 1829, Goodman Company set 3" Hemlock post to replace old post. No B.T.'s found.  
 Set flue pipe 2" x 30".


In October 1991, Alan Harrison found 2" flue pipe and 1/2" iron rod marking corner position. No original corner evidence found.

In October 1992, Alan Harrison set monument in place of flue pipe.

- (c) In the plan view drawing below, provide reference ties to at least 4 witness monuments, or, if the location is within a municipality, to at least 2 witness monuments. (witness monuments shall be made of concrete, natural stone, iron or other equally durable material.)

- (d) Show a plan view drawing depicting the relevant monuments and reference ties which is sufficient in detail to enable accurate relocation of the corner monument if the corner monument is disturbed. Indicate north.

1. 2 1/2" x 36" Aluminum monument stamped to identify corner location.
2. Hemlock, 13", N.2°E., 24.01 feet
3. Sugar, 9", S.33°E. 30.31 feet
4. Sugar, 5", S.9°W., 15.30 feet
5. Hemlock, 13", S.79°W., 17.65 feet
6. Steel Sign Post, N.E., 1.40 feet

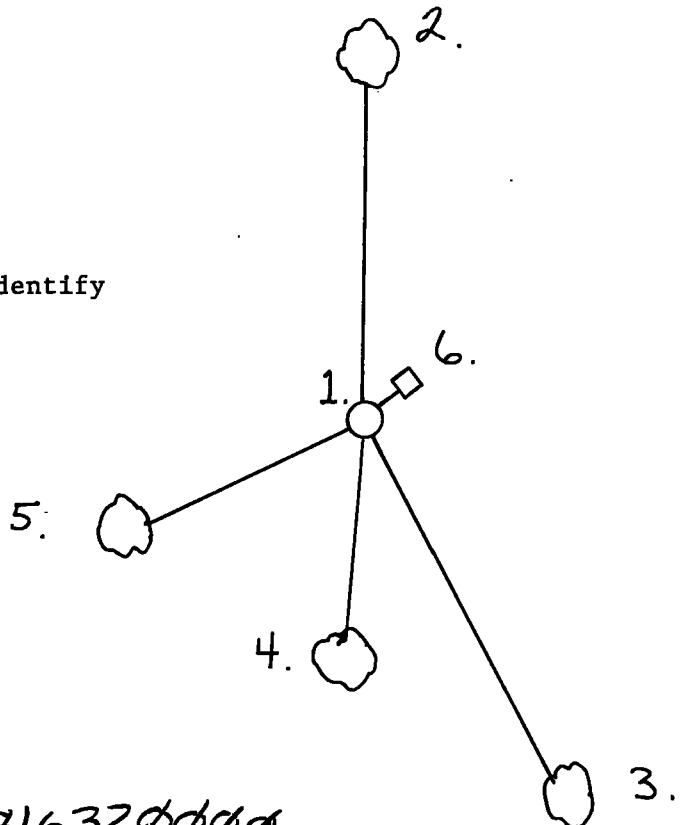

REGISTER'S OFFICE  
 Forest County, Wis.

Received for record this 30th day  
 of JUNE A.D., 1993 at  
 2:10 o'clock P.M. and recorded  
 in Vol. CORNER RESTORATIONS  
 page A-9

*John A. Schumacher*  
 Register of Deeds

43716320000

- (a) Describe any material discrepancy between the location of the corner as restored or reestablished and the location of that corner as previously restored or reestablished by distance and direction. Show the discrepancy on the plan view drawing under (d), above. Show the distances between the corner as previously restored or reestablished and (1) the corner as restored or reestablished, and (2) to at least 2 of the witness monuments shown on the drawing in (d), above.

None.

- (f) Was the corner restored through acceptance of (1) an obliterated evidence location, or, (2) a found perpetuated location?

A found perpetuated location.

- (g & h) Was the corner reestablished through lost corner proportionate methods? If so, show the method, including the directions and distances to other public land survey corners used as evidence or used for proportioning in determining the corner location?

No.

(1) I, Alan D. Harrison

(type or print name) certify that the corner location shown on this record was determined by me or under my direction and control and that this U.S. Public Land Survey Monument Record is correct and complete to the best of my knowledge and belief.

Alan D. Harrison  
Signature

6/16/93  
Date

CERTIFICATE READY FOR FILING:

Ene Vap  
District Ranger



## U. S. PUBLIC LAND SURVEY MONUMENT RECORD

## INSTRUCTIONS:


This record shall show the location of the corner and shall include all of the following nine elements (a through i).

- (a) Identify the corner by reference to the U.S. public land survey system.  
O = Corner monument restored.

Corner common to Sections 33 and 34, T37N-R16E  
and Sections 3 and 4, T36N-R16E

Index Number A-13 (T36N-R16E)

Forest County, Wisconsin

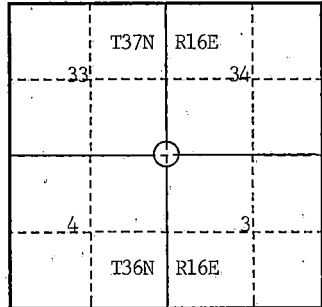

- (b) Describe any record evidence, monument evidence, occupational evidence, testimonial evidence or any other material evidence you considered, and whether the monument was found or placed.

1857 - Original wood post set by Artemas Curtis, witnessed by 7 Sugar N76W 15 lks.; 12 Hemlock N21E 23 lks.; 9 Sugar S35E 33 lks.; 9 Hemlock S44W 07 lks.


1976 - 1½" Iron pipe recovered by T. Arnott, RLS 887, believed established by Goodman Lumber Co. Corner remonumented with Forest County aluminum monument with stamped cap, witnessed by: 12 Balsam N43°E 57.17'; 14" Spruce S33°E 48.02'; 10" Balsam N21°W 49.24'. (Forest County Document No. 109430)

1991 - Coleman Engineering Co. recovered record monument and Spruce NBT (now 16"); June also recovered stumps of Balsam NBTs.

- (c) In the plan view drawing below, provide reference ties to at least 4 witness monuments, or, if the location is within a municipality, to at least 2 witness monuments. (Witness monuments shall be made of concrete, natural stone, iron or other equally durable material.)

- (d) Show a plan view drawing depicting the relevant monuments and reference ties which is sufficient in detail to enable accurate relocation of the corner monument if the corner monument is disturbed. Indicate north.

1. Forest County aluminum monument with stamped cap.
2. Spruce 16" S33°E 48.02 feet.
3. Sugar 6" N31°E 46.39 feet.
4. Sugar 6" S58°E 47.05 feet.
5. Aspen 7" S23°W 20.27 feet.
6. Sugar 3" N58°W 27.73 feet.
7. Steel sign post Southeast 1.19 feet.

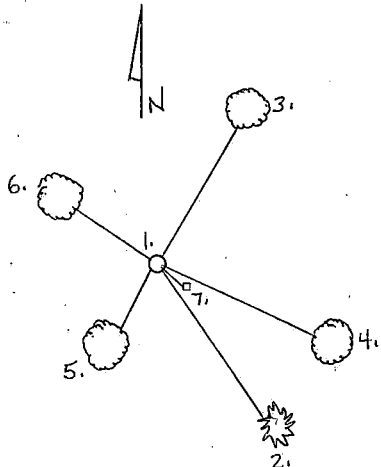

REGISTER'S OFFICE  
Forest County, Wis.

Received for record this 8th day  
of October, A.D., 1991, at  
2:00 o'clock P.M. and recorded  
in Vol. Register Restorations  
page A-13

Register of Deeds

43716330000

A-13

- (e) Describe any material discrepancy between the location of the corner as restored or reestablished and the location of that corner as previously restored or reestablished by distance and direction. Show the discrepancy on the plan view drawing under (d), above. Show the distances between the corner as previously restored or reestablished and (1) the corner as restored or reestablished, and (2) to at least 2 of the witness monuments shown on the drawing in (d), above.

Accepted position of found monument as true corner.

- (f) Was the corner restored through acceptance of (1) an obliterated evidence location, or, (2) a found perpetuated location?

(2) Found perpetuated location.

- (g & h) Was the corner reestablished through lost corner proportionate methods? If so, show the method, including the directions and distances to other public land survey corners used as evidence or used for proportioning in determining the corner location?

No.

(1) I, Charles F. Clark, RLS 1767  
COLEMAN ENGINEERING COMPANY

(type or print name) certify that the corner location shown on this record was determined by me or under my direction and control and that this U.S. Public Land Survey Monument Record is correct and complete to the best of my knowledge and belief.


Signature

August 24, 1991

Date

CERTIFICATE READY FOR FILING:

Darrell E. Richards  
Acting District Ranger

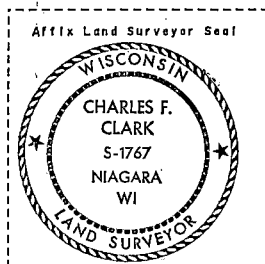

# CERTIFIED LAND CORNER RESTORATION


Index No. **A 13**

State of Wisconsin }  
County of Forest } ss.

I Thomas R. Arnott, do hereby certify that on the 7th day of June, 1976, I found evidence of the section corner of sections 3, 4, 33 & 34 Township 36 & 37, North, Range 16 E, Fourth Principal Meridian, as described hereon; and that from this evidence I established a new monument and accessories as described hereon to perpetuate the original location of this corner.

Resident witnesses:

.....  
.....  
.....

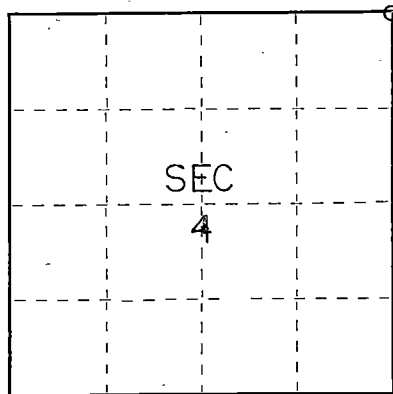


○ = Corner monument restored.

History of original corner establishment:

Sugar	7	N76W	15 Lks.
Hemlock	12	N21E	23 Lks.
Sugar	9	S35E	33 Lks.
Hemlock	9	S44W	7 Lks.

Description of corner evidence found:

Found 1 1/2" iron pipe

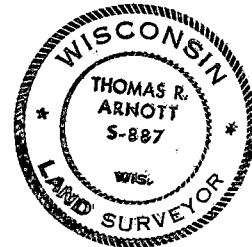

Description of monument and accessories I established to perpetuate the original location of this corner.

Replaced iron pipe with New Forest County Aluminum Monument

Ties::

Balsam	12	N43E	57.17 feet
Spruce	14	S33E	48.02 feet
Balsam	10	N21W	49.24 feet

Dated at Grandon, Wis., this 11th day of June, 1976.

Signature Thomas R. Arnott Title Surveyor Registration No. S-887  
(County Surveyor, Registered Land Surveyor, or other duly authorized official)

Office of Register of Deeds, County of Forest, I hereby certify that the within instrument was filed in this office for record on the 11th day of June, 1976, at 3 o'clock P. M.

EUGENE STATEZNY

(Register of Deeds)

Document Number **109430**

By Eileen Schmidt Deputy

43716330000

142933

## U. S. PUBLIC LAND SURVEY MONUMENT RECORD

## INSTRUCTIONS:


This record shall show the location of the corner and shall include all of the following nine elements (a through i).

- (a) Identify the corner by reference to the U.S. public land survey system.  
 O = Corner monument restored.

Quarter Corner common to Section 3, T36N-R16E,  
 and Section 34, T37N-R16E

Index Number A-15 (T36N-R16E)

Forest County, Wisconsin

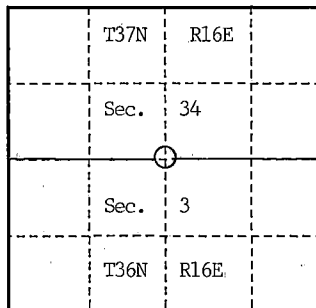

- (b) Describe any record evidence, monument evidence, occupational evidence, testimonial evidence or any other material evidence you considered, and whether the monument was found or placed.

1857 - Original wood post set by Artemas Curtis, witnessed by 10 Hemlock N46E 13 lks. and 10 Y. Birch S51W 25 lks.


1936 - CCC (Forest Service) notes by R.M. Nelson call for iron post and squared stake, likely set by Goodman Lumber Co. No mention of OBTs recovered or NBTs marked.

1991 - Found 2" iron pipe buried near edge of former beaver pond, approximately 2 feet North of downed eas-west barbwire fence. Pipe is similar to other recovered Goodman monuments, and is within 2.2 feet of being equidistant between NW and NE section corners. Accepted monument as most probable position of true corner.

- (c) In the plan view drawing below, provide reference ties to at least 4 witness monuments, or, if the location is within a municipality, to at least 2 witness monuments. (witness monuments shall be made of concrete, natural stone, iron or other equally durable material.)

- (d) Show a plan view drawing depicting the relevant monuments and reference ties which is sufficient in detail to enable accurate relocation of the corner monument if the corner monument is disturbed. Indicate north.

1. 2 1/2" x 36" Aluminum monument with location stamped on cap.
2. Black Spruce 5" S54°W 41.15 feet.
3. Black Spruce 6" N83°E 10.70 feet.
4. Black Spruce 6" S28°E 12.49 feet.
5. Black Spruce 5" N34°E 52.26 feet.
6. Steel sign post West 1.52 feet.

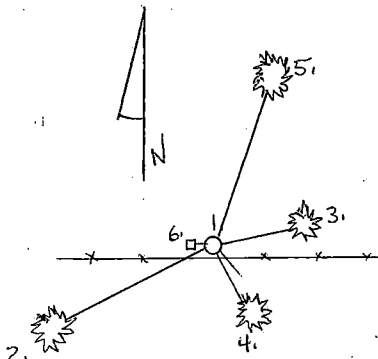

REGISTER'S OFFICE  
 Forest County, Wis.

Received for record this 27 day  
 of June A.D., 19 at  
 2:00 o'clock P.M. and recorded  
 in Vol. 3961, Page 125  
 of the Register of Deeds

Register of Deeds

43716 34 0020

A-15

A-15

- (e) Describe any material discrepancy between the location of the corner as restored or reestablished and the location of that corner as previously restored or reestablished by distance and direction. Show the discrepancy on the plan view drawing under (d), above. Show the distances between the corner as previously restored or reestablished and (1) the corner as restored or reestablished, and (2) to at least 2 of the witness monuments shown on the drawing in (d), above.

Accepted position of found monument as true corner.

- (f) Was the corner restored through acceptance of (1) an obliterated evidence location, or, (2) a found perpetuated location?

(2) Found perpetuated location.

- (g & h) Was the corner reestablished through lost corner proportionate methods? If so, show the method, including the directions and distances to other public land survey corners used as evidence or used for proportioning in determining the corner location?

No.

Charles F. Clark, RLS 1767  
(1) I, COLEMAN ENGINEERING COMPANY

(Type or print name) certify that the corner location shown on this record was determined by me or under my direction and control and that this U.S. Public Land Survey Monument Record is correct and complete to the best of my knowledge and belief.


Signature

August 24, 1991

Date

CERTIFICATE READY FOR FILING:

Darrell E. Richards  
Acting District Ranger

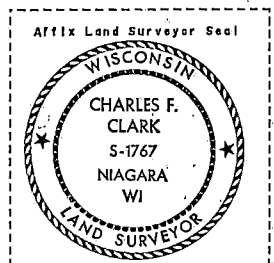

## U. S. PUBLIC LAND SURVEY MONUMENT RECORD

## INSTRUCTIONS:


This record shall show the location of the corner and shall include all of the following nine elements (a through i).

- (a) Identify the corner by reference to the U.S. public land survey system.  
O = Corner monument restored.

Corner common to Sections 34 and 35, T37N-R16E, and Sections 2 and 3, T36N-R16E

Index Number A-17 (T36N-R16E)

Forest County, Wisconsin

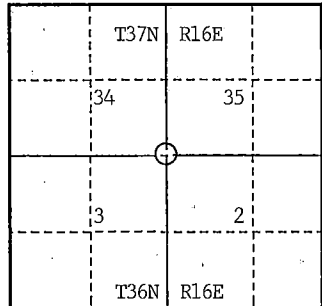

- (b) Describe any record evidence, monument evidence, occupational evidence, testimonial evidence or any other material evidence you considered, and whether the monument was found or placed.

1857 - Original wood post set by Artemas Curtis, witnessed by 15 Tamarack N83W 96 lks.; 14 Tamarack N08E 86 lks.; 14 Tamarack S75W 23 lks.

1930 - Notes of Goodman Lumber Co. indicate quarter corner common to Sections 2 and 3 was set by proportionate method between section corners  $\frac{1}{2}$ -mile to North and South. No record given for corner on town line, but is assumed to have been monumented at that time.


1934 - CCC (Forest Service) record by J.W. White as existing stake north and west of creek. No recovery of OBTs or marking of NBTs was noted.

1991 - Found 2" x 5' iron pipe 15" below surface in beaver marsh at edge of 5' wide stream; pipe is similar to other Goodman monuments recovered. Position is substantially in line with corners  $\frac{1}{2}$ -mile and 1 mile South in agreement with Goodman proportionate measure. Position is 7.3 feet North and 11.8 feet West of midpoint between section corners 1 mile to East and West. Accepted monument as most probable position of true corner.

- (c) In the plan view drawing below, provide reference ties to at least 4 witness monuments, or, if the location is within a municipality, to at least 2 witness monuments. (Witness monuments shall be made of concrete, natural stone, iron or other equally durable material.)

- (d) Show a plan view drawing depicting the relevant monuments and reference ties which is sufficient in detail to enable accurate relocation of the corner monument if the corner monument is disturbed. Indicate north.

- 2 $\frac{1}{2}$ " x 120" Aluminum monument with location stamped on cap.
- Black Spruce 9" S62°E 136.32 feet.
- White Birch 7" S44°E 147.62 feet.
- Black Spruce 4" N65°W 106.28 feet.
- Tamarack 8" N19°W 99.90 feet.
- Steel sign post North 2.00 feet.

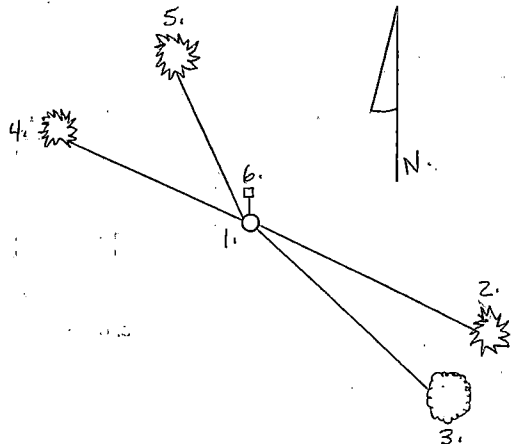

REGISTER'S OFFICE  
Forest County, Wis.

Received for record this 8th day  
of October, A.D., 1997 at  
2:00 o'clock P.M. and recorded  
in Vol. Corner Restorations  
page 8-17

Register of Deeds

43716340000

A-17

- (e) Describe any material discrepancy between the location of the corner as restored or reestablished and the location of that corner as previously restored or reestablished by distance and direction. Show the discrepancy on the plan view drawing under (d), above. Show the distances between the corner as previously restored or reestablished and (1) the corner as restored or reestablished, and (2) to at least 2 of the witness monuments shown on the drawing in (d), above.

Accepted position of monument found as true corner.

- (f) Was the corner restored through acceptance of (1) an obliterated evidence location, or, (2) a found perpetuated location?

(2) Found perpetuated location.

- (g & h) Was the corner reestablished through lost corner proportionate methods? If so, show the method, including the directions and distances to other public land survey corners used as evidence or used for proportioning in determining the corner location?

No.

(1) I, Charles F. Clark, RLS 1767  
COLEMAN ENGINEERING COMPANY

(Type or print name). certify that the corner location shown on this record was determined by me or under my direction and control and that this U.S. Public Land Survey Monument Record is correct and complete to the best of my knowledge and belief.

Charles F. Clark


Signature

August 24, 1991

Date

CERTIFICATE READY FOR FILING:

Darrell E. Richards  
Acting District Ranger

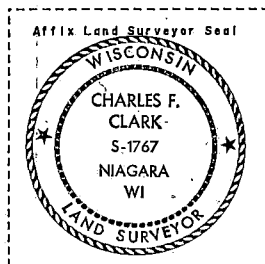

## U. S. PUBLIC LAND SURVEY MONUMENT RECORD

## INSTRUCTIONS:


This record shall show the location of the corner and shall include all of the following nine elements (a through i).

- (a) Identify the corner by reference to the U.S. public land survey system.  
 O = Corner monument restored.

Quarter Corner common to Section 35, T37N-R16E, and Section 2, T36N-R16E

Index Number A-19 (T36N-R16E)

Forest County, Wisconsin

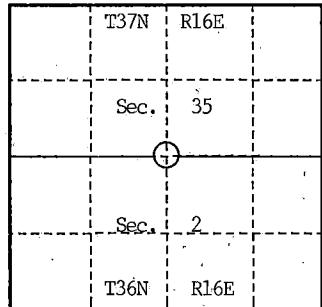

- (b) Describe any record evidence, monument evidence, occupational evidence, testimonial evidence or any other material evidence you considered, and whether the monument was found or placed.

1857 - Original post set by Artemas Curtis, witnessed by 20 Lynn N41E 34 lks.; 14 Lynn S24W 37lks.


1934 - CCC (Forest Service) record by J.W. White notes corner monumented by an iron pipe and wood stake in SE quadrant of road corner east and south, with an existing fenceline to the south. Monument is assumed to have been set previously by Goodman Lumber Co. as their records show monumentation of the 1/16 corner west of this position in 1930. No record of other evidence.

1991 - Coleman Engineering Company searched area and found no remaining monuments or original evidence. Position of corner appears to be best defined by the existing fenceline South and the centerline of the road (LaChapelle Lane) to the East as evidenced by north and south right-of-way fences. This intersection was found to fit well between corners on the town line 1/2 mile East and West. Position was monumented as the most probable location of the true corner.

- (c) In the plan view drawing below, provide reference ties to at least 4 witness monuments, or, if the location is within a municipality, to at least 2 witness monuments. (Witness monuments shall be made of concrete, natural stone, iron or other equally durable material.)

- (d) Show a plan view drawing depicting the relevant monuments and reference ties which is sufficient in detail to enable accurate relocation of the corner monument if the corner monument is disturbed. Indicate north.

- 2 1/2" x 36" Aluminum monument with location stamped on cap.
- Sugar 8" N21°E 31.87 feet.
- Sugar 6" N50°E 33.12 feet.
- Sugar 7" S32°E 35.48 feet.
- Sugar 7" S84°W 21.57 feet.
- Steel sign post West 2.11 feet.

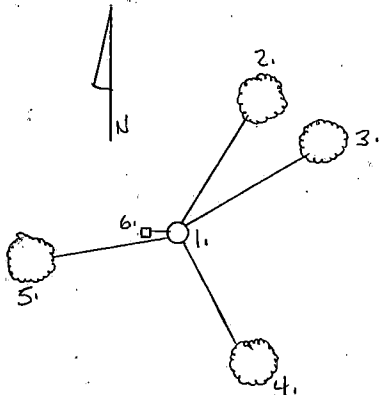

REGISTER'S OFFICE  
 Forest County, Wis.

Received for record this 8th day  
 of October, A.D., 19 97, at  
2:00 o'clock P.M. and recorded  
 in Vol. 177 of the  
 page 177.

Register of Deeds

43716350020

A-19

- (e) Describe any material discrepancy between the location of the corner as restored or reestablished and the location of that corner as previously restored or reestablished by distance and direction. Show the discrepancy on the plan view drawing under (d), above. Show the distances between the corner as previously restored or reestablished and (1) the corner as restored or reestablished, and (2) to at least 2 of the witness monuments shown on the drawing in (d), above.

Corner position as restored is believed to correspond to the position of the monument noted in the 1934 CCC record.

- (f) Was the corner restored through acceptance of (1) an obliterated evidence location, or, (2) a found perpetuated location?

(2) Corner is believed to be a perpetuated location as evidenced by the findings of the 1991 search and record information.

- (g & h) Was the corner reestablished through lost corner proportionate methods? If so, show the method, including the directions and distances to other public land survey corners used as evidence or used for proportioning in determining the corner location?

No.

- (1) I, Charles F. Clark, RLS 1767  
COLEMAN ENGINEERING COMPANY

(type or print name) certify that the corner location shown on this record was determined by me or under my direction and control and that this U.S. Public Land Survey Monument Record is correct and complete to the best of my knowledge and belief.


Signature

August 24, 1991

Date

CERTIFICATE READY FOR FILING:

Darrell E. Riehauf  
Acting District Ranger

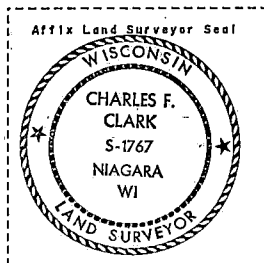

# U. S. PUBLIC LAND SURVEY MONUMENT RECORD

## INSTRUCTIONS:

This record shall show the location of the corner and shall include all of the following nine elements (a through i).


- (a) Identify the corner by reference to the U.S. public land survey system.  
O = Corner monument restored.

Quarter corner to section 1, T.36N., R.16E., and section 36, T.37N., R.16E., Forest County, Wisconsin.

REGISTER'S OFFICE  
Forest County, Wis.

Received for record this 20th day  
of March A.D. 1988 at  
2:00 o'clock P.M. and recorded  
in Vol. Case Registration  
page 1-23

*Paul H. Schumacher*  
Register of Deeds

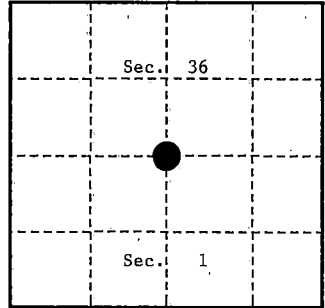

- (b) Describe any record evidence, monument evidence, occupational evidence, testimonial evidence or any other material evidence you considered, and whether the monument was found or placed.

In 1857, Artemas Curtis set a wood post with the following B.T.'s: Sugar, 10", N.58°E., 8 links (5.28 feet); Sugar, 16", S.54°W., 24 links (17.16 feet).


In 1982, H. Neider found a 1½" x 7" pipe with remains of burnt post along side.

In 1988, Alan D. Harrison (RLS) searched and found iron pipe as per Neider. No othe evidence recovered. Iron pipe is similar to Goodman Co. fluepipes at other locations in township. Replaced pipe with monument as best evidence of corner location.

- (c) In the plan view drawing below, provide reference ties to at least 4 witness monuments, or, if the location is within a municipality, to at least 2 witness monuments. (witness monuments shall be made of concrete, natural stone, iron or other equally durable material.)

- (d) Show a plan view drawing depicting the relevant monuments and reference ties which is sufficient in detail to enable accurate relocation of the corner monument if the corner monument is disturbed. Indicate north.

- 2½" x 36" aluminum monument with tablet stamped to identify the corner.
- Sugar, 12", N.60°E., 9.02 feet.
- Red Pine, 4", S.79°W., 8.93 feet.
- Red Pine, 5", N.17°W., 25.60 feet.
- Steel Sign Post, 6', East, 1.39 feet.

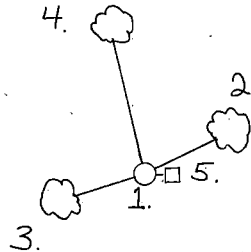

- (e) Describe any material discrepancy between the location of the corner as restored or reestablished and the location of that corner as previously restored or reestablished by distance and direction. Show the discrepancy on the plan view drawing under (d), above. Show the distances between the corner as previously restored or reestablished and (1) the corner as restored or reestablished, and (2) to at least 2 of the witness monuments shown on the drawing in (d), above.

None.

- (f) Was the corner restored through acceptance of (1) an obliterated evidence location, or, (2) a found perpetuated location?

(2) A found perpetuated location

- (g & h) Was the corner reestablished through lost corner proportionate methods? If so, show the method, including the directions and distances to other public land survey corners used as evidence or used for proportioning in determining the corner location?

No.


(1) I, Alan D. Harrison

(type or print name) certify that the corner location shown on this record was determined by me or under my direction and control and that this U.S. Public Land Survey Monument Record is correct and complete to the best of my knowledge and belief.

Alan D. Harrison 10/10/90  
Signature Date

CERTIFICATE READY FOR FILING:

Dale B. Stage  
District Ranger

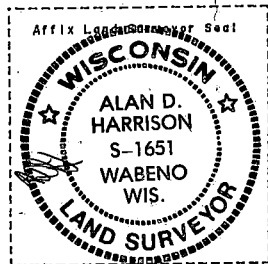

## U. S. PUBLIC LAND SURVEY MONUMENT RECORD


## INSTRUCTIONS:

This record shall show the location of the corner and shall include all of the following nine elements (a through i).

- (a) Identify the corner by reference to the U.S. public land survey system.

○ = Corner monument restored.

Section corner to Sections 1, 6, 31, and 36,  
T.36-37N., R.16-17E.

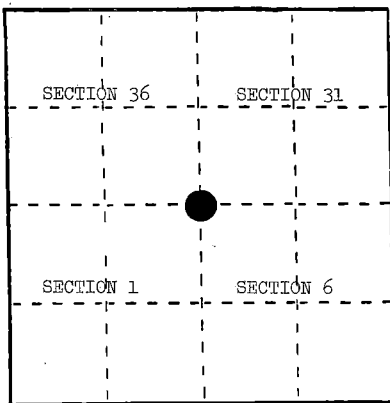

- (b) Describe any record evidence, monument evidence, occupational evidence, testimonial evidence or any other material evidence you considered, and whether the monument was found or placed.

In 1857, Artemas Curtis set post at 81.00 chains with the following BTs: Spruce, 10", S.76°W., 17 links; Spruce, 14", N.64°W., 51 links; Spruce, 6", N.40°E., 18 links; Spruce, 12", S.56°E., 43 links.

October, 1936, to May, 1937, Gould and Hammes - set 4" iron pipe with 4" brass cap from old Cedar post. BTs gone, set new BTs: Cedar, 7", N.1°E., 40.7 links; Balsam, 6", S.82°E., 65.6 links; Cedar, 4", S.45°W., 29.2 links.


May 6, 1982, Milo Stefan found a 4" brass cap Marinette County monument, 12" Cedar, N.4°E., 27.15', cut line northerly.

November 30, 1984, Harrison found corner, as per Stefan.

- (c) In the plan view drawing below, provide reference ties to at least 4 witness monuments, or, if the location is within a municipality, to at least 2 witness monuments. (Witness monuments shall be made of concrete, natural stone, iron or other equally durable material.)  
Describe witness monuments.

- (d) Show a plan view drawing depicting the relevant monuments and reference ties which is sufficient in detail to enable accurate relocation of the corner monument if the corner monument is disturbed. Indicate north.

1. 4" pipe with brass cap stamped to identify the corner.
2. Cedar, 12", N.1°E., 27.05'
3. Cedar, 5", S.7°E., 39.69'
4. Cedar, 6", S.49°W., 7.32'
5. Cedar, 6", N.47°W., 20.12'
6. Steel Sign Post, West, 1.29'

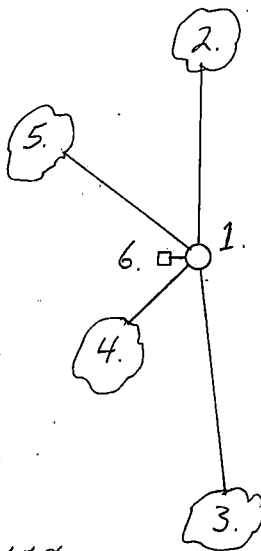

REGISTER'S OFFICE }  
Forest County, Wis. }  
Received for record this 23rd day  
of January, 1985 A.D., at  
9:00 o'clock A.M. and  
recorded in Vol. CORNER RESTORATION  
on page 4-25

Paul Aschendanner  
REGISTER

- (e) Describe any material discrepancy between the location of the corner as restored or reestablished and the location of that corner as previously restored or reestablished by distance and direction. Show the discrepancy on the plan view drawing under (d), above. Show the distances between the corner as previously restored or reestablished and (1) the corner as restored or reestablished, and (2) to at least 2 of the witness monuments shown on the drawing in (d), above.

None.

- (f) Was the corner restored through acceptance of (1) an obliterated evidence location, or, (2) a found perpetuated location?


(2) a found perpetuated location.

- (g&h) Was the corner reestablished through lost corner proportionate methods? If so, show the method, including the directions and distances to other public land survey corners used as evidence or used for proportioning in determining the corner location?

Neither.

- (1) I, Alan D. Harrison  
(type or print name) certify that the corner location shown on this record was determined by me or under my direction and control and that this U.S. Public Land Survey Monument Record is correct and complete to the best of my knowledge and belief.

Alan D. Harrison 12/14/84  
Signature Date

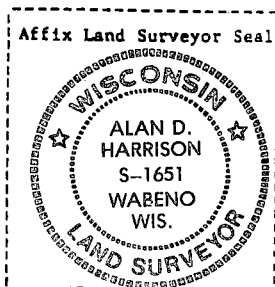


## U. S. PUBLIC LAND SURVEY MONUMENT RECORD

## INSTRUCTIONS:

This record shall show the location of the corner and shall include all of the following nine elements (a through i).

- (a) Identify the corner by reference to the U.S. public land survey system.  
 O = Corner monument restored.

Quarter corner common to Sections 5 and 6,  
 T36N, R16E.

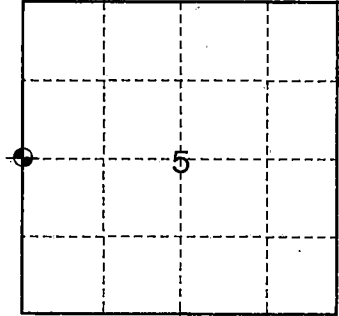

- (b) Describe any record evidence, monument evidence, occupational evidence, testimonial evidence or any other material evidence you considered, and whether the monument was found or placed.

In 1858, James McBride, Deputy Surveyor, set a wood post with the following B.T.'s:  
 Cedar - 8" - S55°W, 38 links (25.08 feet); Spruce - 12" - N85°E, 22 links (14.52 feet).


In 1981, Milo Stefan, RLS 1558, found two fallen and very rotten posts with a picket alongside. He also found the decayed remains of the spruce bearing tree at record bearing and distance from the post and picket. A scribed 8" cedar bears N31°W, 15.2 feet and blazed lines run north and east. He replaced the post with a 2" x 60" aluminum monument with a stamped tablet.

In 1993, John Garske, RLS, found Stefan's aluminum monument in good condition.

- (c) In the plan view drawing below, provide reference ties to at least 4 witness monuments, or, if the location is within a municipality, to at least 2 witness monuments. (witness monuments shall be made of concrete, natural stone, iron or other equally durable material.)

- (d) Show a plan view drawing depicting the relevant monuments and reference ties which is sufficient in detail to enable accurate relocation of the corner monument if the corner monument is disturbed. Indicate north.

- 1- Found aluminum monument with tablet stamped to identify corner.
- 2- Cedar - 11" - N35°W - 13.80 feet
- 3- Hemlock - 9" - N85°E - 32.65 feet
- 4- Cedar - 8" - S10°W - 16.07 feet
- 5- Steel sign post - 6' - NE'ly - 1.75 feet

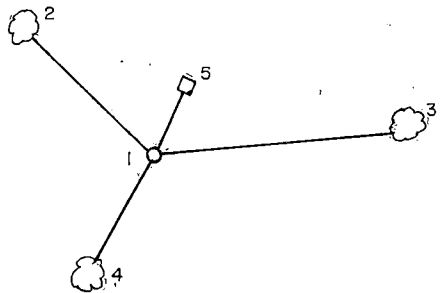

43616062000

- (e) Describe any material discrepancy between the location of the corner as restored or reestablished and the location of that corner as previously restored or reestablished by distance and direction. Show the discrepancy on the plan view drawing under (d). above. Show the distances between the corner as previously restored or reestablished and (1) the corner as restored or reestablished, and (2) to at least 2 of the witness monuments shown on the drawing in (d), above.


None

- (f) Was the corner restored through acceptance of (1) an obliterated evidence location, or, (2) a found perpetuated location?

2- A found perpetuated corner

- (g & h) Was the corner reestablished through lost corner proportionate methods? If so, show the method, including the directions and distances to other public land survey corners used as evidence or used for proportioning in determining the corner location?

No

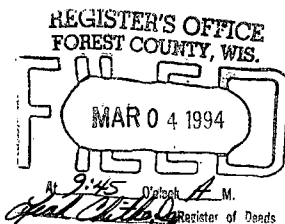

- (1) I, John R. Garske, RLS 1685

(type or print name) certify that the corner location shown on this record was determined by me or under my direction and control and that this U.S. Public Land Survey Monument Record is correct and complete to the best of my knowledge and belief.

John R. Garske 12-27-93  
Signature Date

CERTIFICATE READY FOR FILING:

Sue Vap  
District Ranger

143920


## U. S. PUBLIC LAND SURVEY MONUMENT RECORD

## INSTRUCTIONS:

This record shall show the location of the corner and shall include all of the following nine elements (a through i).

- (a) Identify the corner by reference to the U.S. public land survey system.  
 O = Corner monument restored.

Quarter corner common to sections 5 and 4  
 T.36N., R.16E. Forest County, Wisconsin

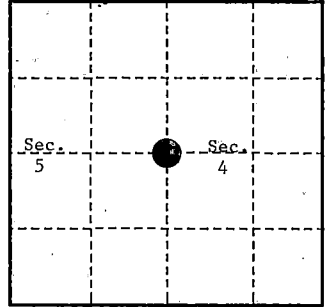

- (b) Describe any record evidence, monument evidence, occupational evidence, testimonial evidence or any other material evidence you considered, and whether the monument was found or placed.

In 1858, James Mc Bride set a wood post with the following B.T.'s: Hemlock, 18", S.16"W., 17 links (1.22 feet), Elm, 8", S.54"E., 30 links (19.80 feet).


In 1927, Goodman Lumber Co. set 3½" Hemlock post and in 1928 set a 2"x32" flue pipe. Found remains of old post set by either Jenkins of Brown Lumber Co. Several trees notched to mark post. No B.T.'s.

On October 16, 1991, Alan D. Harrison (RLS) found 2" flue pipe just West of small grove of Hemlocks. Original Hemlock B.T. is now just a stump depression. No evidence of original S.E. B.T. remaining. Also, found location poster dated 1940 and 1953 on 20" Elm snag, S.3"W., 16.5 feet. Replaced flue pipe with monument as best evidence of corner location.

- (c) In the plan view drawing below, provide reference ties to at least 4 witness monuments, or, if the location is within a municipality, to at least 2 witness monuments. (witness monuments shall be made of concrete, natural stone, iron or other equally durable material.)

- (d) Show a plan view drawing depicting the relevant monuments and reference ties which is sufficient in detail to enable accurate relocation of the corner monument if the corner monument is disturbed. Indicate north.

1. 2½"x36" Aluminum monument with tablet stamped to identify corner.
2. Sugar, 18", S.47°E., 9.82 feet.
3. Sugar, 6", S.69°W., 13.48 feet.
4. Sugar, 6", N.56°W., 25.40 feet.
5. Steel Sign Post, 6', East, 1.37 feet.

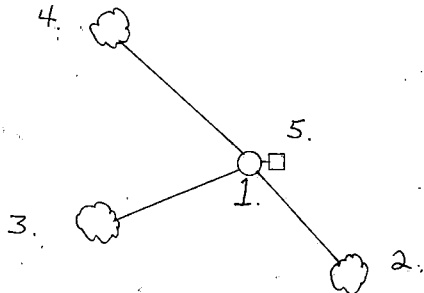

REGISTER'S OFFICE  
 Forest County, Wis.

Received for record this 2nd day  
 of March, A.D., 1992 at  
 2:00 o'clock P.M. and recorded  
 in Vol. 143920  
 page 2-9

Register of Deeds

(e) Describe any material discrepancy between the location of the corner as restored or reestablished and the location of that corner as previously restored or reestablished by distance and direction. Show the discrepancy on the plan view drawing under (d), above. Show the distances between the corner as previously restored or reestablished and (1) the corner as restored or reestablished, and (2) to at least 2 of the witness monuments shown on the drawing in (d), above.


None.

(f) Was the corner restored through acceptance of (1) an obliterated evidence location, or, (2) a found perpetuated location?

(2) a found perpetuated location.

(g & h) Was the corner reestablished through lost corner proportionate methods? If so, show the method, including the directions and distances to other public land survey corners used as evidence or used for proportioning in determining the corner location?

No.

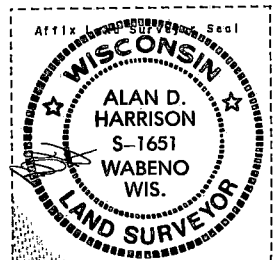

(1) I, Alan D. Harrison

(type or print name) certify that the corner location shown on this record was determined by me or under my direction and control and that this U.S. Public Land Survey Monument Record is correct and complete to the best of my knowledge and belief.

Alan D. Harrison 12/31/91  
Signature Date

CERTIFICATE READY FOR FILING:

Sue Vef  
District Ranger

## U. S. PUBLIC LAND SURVEY MONUMENT RECORD

## INSTRUCTIONS:


This record shall show the location of the corner and shall include all of the following nine elements (a through i).

- (a) Identify the corner by reference to the U.S. public land survey system.  
O = Corner monument restored.

Quarter Corner common to Sections 3 and 4,  
T36N-R16E

Index Number C-13

Forest County, Wisconsin

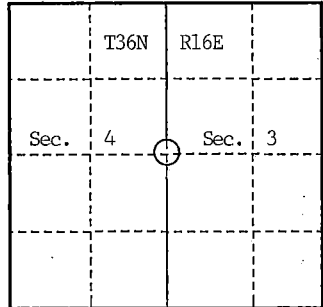

- (b) Describe any record evidence, monument evidence, occupational evidence, testimonial evidence or any other material evidence you considered, and whether the monument was found or placed.

1858 - Original post set by James McBride, witnessed by Sugar 14 N40E 23 lks.; Sugar 14 N80W 04 lks. Corner was established on corrected closing section line 40.00 chains North of corner to 3, 4, 9 and 10, and 39.40 chains south of standard corner on town line. Original notes for this line include no information as to feature calls or line trees.


Found no record of subsequent recovery or remonumentation.

1991 - Subsequent to a survey traverse between the NW and SW corners of Section 3, the general corner search area was located. A thorough search yielded no identifiable remains of the original evidence of subsequent occupations. Corner was assumed to be lost and was restored by single proportion between the controlling section corners North and South. A north-south logging paint line was observed approximately 13 feet West of the corner as monumented.

- (c) In the plan view drawing below, provide reference ties to at least 4 witness monuments, or, if the location is within a municipality, to at least 2 witness monuments. (Witness monuments shall be made of concrete, natural stone, iron or other equally durable material.)

- (d) Show a plan view drawing depicting the relevant monuments and reference ties which is sufficient in detail to enable accurate relocation of the corner monument if the corner monument is disturbed. Indicate north.

1. 2 1/2" x 36" Aluminum monument with location stamped on cap.
2. Basswood 17" S26°E 14.43 feet.
3. Sugar 17" S68°W 22.56 feet.
4. Sugar 8" N17°W 46.38 feet.
5. Sugar 4" N62°E 19.17 feet.
6. Steel sign post South 1.16 feet.

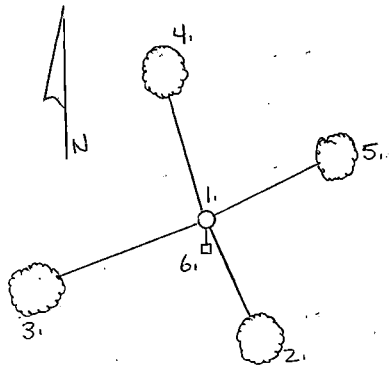

REGISTER'S OFFICE  
Forest County, Wis.

Received for record this 8th day  
of October, A.D., 1991, at  
2:00 o'clock P.M. and recorded  
in Vol. 1000, Registration  
page C-13

Paul A. Schenck  
Register of Deeds

43616042000

- (e) Describe any material discrepancy between the location of the corner as restored or reestablished and the location of that corner as previously restored or reestablished by distance and direction. Show the discrepancy on the plan view drawing under (d), above. Show the distances between the corner as previously restored or reestablished and (1) the corner as restored or reestablished, and (2) to at least 2 of the witness monuments shown on the drawing in (d), above.


Found no evidence of prior corner recovery or remonumentation.

- (f) Was the corner restored through acceptance of (1) an obliterated evidence location, or, (2) a found perpetuated location?

Neither.

- (g & h) Was the corner reestablished through lost corner proportionate methods? If so, show the method, including the directions and distances to other public land survey corners used as evidence or used for proportioning in determining the corner location?

Corner was restored at proportionate distances from, and on a straight line between, the Northwest and Southwest corners of Section 3, T36N-R16E.

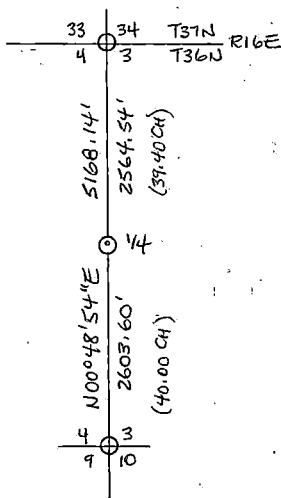

Charles F. Clark, RLS 1767  
COLEMAN ENGINEERING COMPANY

- (1) I, Charles F. Clark, (type or print name), certify that the corner location shown on this record was determined by me or under my direction and control and that this U.S. Public Land Survey Monument Record is correct and complete to the best of my knowledge and belief.

*Charles F. Clark*


August 23, 1991

Signature

Date

CERTIFICATE READY FOR FILING:

*Darrell E. Richards*  
Acting District Ranger

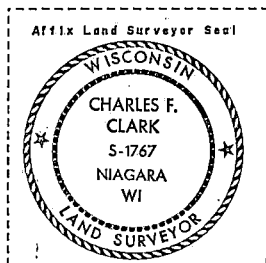


# U. S. PUBLIC LAND SURVEY MONUMENT RECORD

## INSTRUCTIONS:

This record shall show the location of the corner and shall include all of the following nine elements (a through i).

- (a) Identify the corner by reference to the U.S. public land survey system.  
O = Corner monument restored.

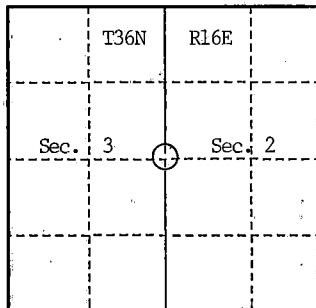

Quarter Corner common to Sections 2 and 3, T36N-R16E

Index Number C-17 (T36N-R16E)

Forest County, Wisconsin

- (b) Describe any record evidence, monument evidence, occupational evidence, testimonial evidence or any other material evidence you considered, and whether the monument was found or placed.

1858 - Original post set by James McBride, witnessed by 10 Sugar N85W 25 lks.; 10 Sugar S38E 20 lks.

1930 - Records of Goodman Lumber Co. indicate that original monument and BTs were lost to forest fire. Corner was restored by proportion (39.79 chains South to corner of 2,3,10 and 11 and 39.60 chains North to standard corner on town line. Position monumented with iron coupling pin in piled stones and a cedar post. No record of NBTs being marked.


1981 - Iron pin was recovered by M. Stefan, S-1558, and remonumented with a 2" x 30" aluminum monument with stamped cap and references: Sugar 6" S25°W 31.00; Sugar 8" N84°W 46.40'; "X" on 2x2x4' boulder S59°W 30.70'; Steel sign post N84°W 3.7'. (Forest County Document No. 124217)

1991 - Coleman Engineering Company recovered monument and references of record, and April marked additional NBTs.

- (c) In the plan view drawing below, provide reference ties to at least 4 witness monuments, or, if the location is within a municipality, to at least 2 witness monuments. (witness monuments shall be made of concrete, natural stone, iron or other equally durable material.)

- (d) Show a plan view drawing depicting the relevant monuments and reference ties which is sufficient in detail to enable accurate relocation of the corner monument if the corner monument is disturbed. Indicate north.

1. 2" x 30" Aluminum monument with location stamped on cap.
2. Sugar 6" S25°W 31.00 feet.
3. Sugar 8" N84°W 46.40 feet.
4. Aspen 5" N26°E 14.77 feet.
5. Sugar 9" twin S83°E 32.36 feet.
6. "X" on 2x2x4' Boulder S59°W 30.70 feet.
7. Steel sign post N84°W 3.7 feet.

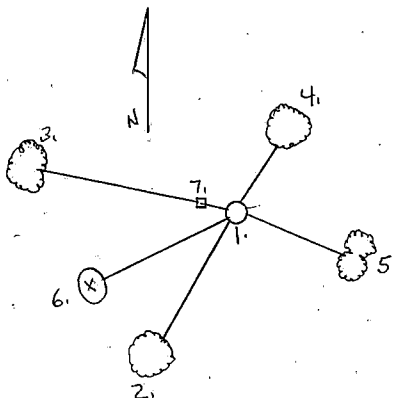

REGISTER'S OFFICE  
Forest County, Wis.

Received for record this 8th day  
of March, A.D., 1997 at  
2:00 o'clock P.M. and recorded  
in Vol. C-17 of  
pay Paul Hochmeyer  
Register of Deeds

4361603 2000

C-17

C-17

- (e) Describe any material discrepancy between the location of the corner as restored or reestablished and the location of that corner as previously restored or reestablished by distance and direction. Show the discrepancy on the plan view drawing under (d), above. Show the distances between the corner as previously restored or reestablished and (1) the corner as restored or reestablished, and (2) to at least 2 of the witness monuments shown on the drawing in (d), above.

Accepted existing monument as true restored corner.

- (f) Was the corner restored through acceptance of (1) an obliterated evidence location, or, (2) a found perpetuated location?

(2) Found perpetuated location.

- (g & h) Was the corner reestablished through lost corner proportionate methods? If so, show the method, including the directions and distances to other public land survey corners used as evidence or used for proportioning in determining the corner location?

No.

(1) I, Charles F. Clark, RLS 1767  
COLEMAN ENGINEERING COMPANY

(type or print name) certify that the corner location shown on this record was determined by me or under my direction and control and that this U.S. Public Land Survey Monument Record is correct and complete to the best of my knowledge and belief.


Signature

August 23, 1991

Date

CERTIFICATE READY FOR FILING:

Darrell E. Richards  
Acting District Ranger

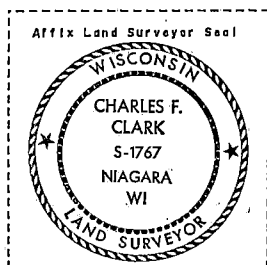

## CERTIFIED LAND CORNER RESTORATION

State of Wisconsin

County of Forest

} ss.

I Milo E. Stefan, do hereby certify that on the 10th day of September, 1981, I found evidence of the East Quarter corner of Section 3 Township 36 North, Range 16 East, Fourth Principal Meridian, as described hereon; and that from this evidence I established a new monument and accessories as described hereon to perpetuate the original location of this corner:

## Description of original monument and accessories and subsequent restorations:

South on true line between Sections 2 and 3  
 39.80 chains set  $\frac{1}{4}$  section post  
     Sugar 10", S38E, 20 links  
     Sugar 10", N83W, 25 links  
 Goodman Lumber Company, restored corner by lost methods, 9/10/1930  
 39.60 chains North and 39.79 chains South set iron pin in mound of stone  
 for  $\frac{1}{4}$  section corner.

## Description of corner evidence found:

Iron pin 1 1/8" x 10" in mound of stone as set by Goodman Lumber Company.  
 Location poster on fallen cedar post.


## Description of monument and accessories I established to perpetuate the location of this corner:

Placed a 2" x 30" aluminum monument in mound of stone 24" in ground with iron pin along side.

## References:

Sugar Maple 6", S25W, 31.00 feet  
 Boulder, 4' x 4' x 2', S59W, 30.70 feet ("X" and B.O. painted red)  
 Sugar Maple 8", N84W, 46.40 feet  
 Steel sign post, N84W, 3.7 feet

DOCUMENT NO.

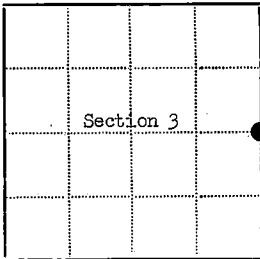**124217**

● - Corner monument restored

□ -

Resident witnesses.....

Dated at Laona Wisconsin, this 5th day of October 1981

Signature Milo E. Stefan Title Land Surveyor  
 (County Surveyor, Registered Land Surveyor, or other duly authorized official)

Surveyors Registration No. 1558Office of Register of Deeds County of Forest

I hereby certify that the within instrument was filed in this office for record on the 14th day of September 1983, and was filed in Book No. \_\_\_\_\_ Page No. \_\_\_\_\_ of County Records.

Signature Eugene H. Stangor Title Register of Deeds

Township 36 North, Range 16 East, Section 3, Index No. C-17, Page No. \_\_\_\_\_

43616 032000

17

## U. S. PUBLIC LAND SURVEY MONUMENT RECORD

## INSTRUCTIONS:


This record shall show the location of the corner and shall include all of the following nine elements (a through i).

- (a) Identify the corner by reference to the U.S. public land survey system.  
O = Corner monument restored.

Quarter Corner common to Sections 1 and 2,  
T36N-R16E

Index Number C-21 (T36N-R16E)

Forest County, Wisconsin

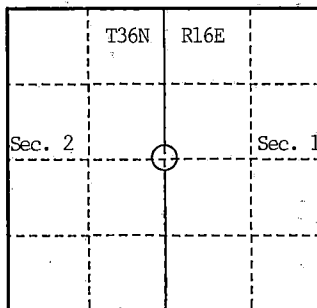


- (b) Describe any record evidence, monument evidence, occupational evidence, testimonial evidence or any other material evidence you considered, and whether the monument was found or placed.

- 1858 - Original post set by James McBride, witnessed by 36 W. Birch S55E 07 lks.; 12 Sugar N70W 30 lks. Corner was established on corrected closing line 40.00' chains North of corner to 1,2,11 and 12 and 39.84 chains South of standard corner on town line. Original notes contains no information as to feature calls or line trees.
- 1930 - Goodman Lumber Co. recovered rotted BT stumps and set a 4" oak post in a pile of stones, 10 feet east of a (north-south) road centerline. Other NBTs were noted as existing but not documented.
- 1991 - Corner search based on traverse between NW and SW corners of Section 1 by Coleman Engineering Company yielded no evidence of 1930 post or NBTs. Engleking Road (F.R. 2371) has been constructed between Sections 1 and 2; it is assumed the centerline was intended to follow the section line. A well-established fenceline runs westerly from the road, and is considered to be supporting occupational evidence of the corner location. The position identified by the road centerline/fenceline intersection is approximately 39.5 feet North of the proportioned position. Despite the conflict with record measurements, I have accepted the existing evidence as locating the most probable position of the true corner, and monumented the road centerline (24' wide gravel) at the fenceline as extended.

- (c) In the plan view drawing below, provide reference ties to at least 4 witness monuments, or, if the location is within a municipality, to at least 2 witness monuments. (Witness monuments shall be made of concrete, natural stone, iron or other equally durable material.)

- (d) Show a plan view drawing depicting the relevant monuments and reference ties which is sufficient in detail to enable accurate relocation of the corner monument if the corner monument is disturbed. Indicate north.

- 5/8" x 24" rebar with plastic cap "CEC - S-1767" set 6" below gravel surface.
- 1" x 36" Aluminum monument Witness Corner stamped "WC"; West on line 33.00 feet.
- Sugar 9" N64°E 30.16 feet.
- Sugar 9" S65°E 36.37 feet.
- Sugar 9" S40°W 56.05 feet.
- Basswood 14" N29°W 37.70 feet.

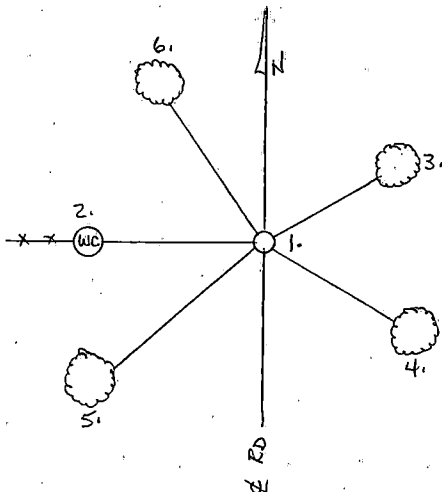

REGISTER'S OFFICE  
Forest County, Wis.

Received for record this 8th day  
of October A.D. 1997 at  
2:00 o'clock P.M. and recorded  
in Vol. County Registration  
page C-21

Register of Deeds

43616022000

C-21

C-21

- (e) Describe any material discrepancy between the location of the corner as restored or reestablished and the location of that corner as previously restored or reestablished by distance and direction. Show the discrepancy on the plan view drawing under (d), above. Show the distances between the corner as previously restored or reestablished and (1) the corner as restored or reestablished, and (2) to at least 2 of the witness monuments shown on the drawing in (d), above.

Restored corner position is believed to be the most probable location of the true corner based on accepted evidence and past usage.

- (f) Was the corner restored through acceptance of (1) an obliterated evidence location, or, (2) a found perpetuated location?

(1) Corner is believed to be obliterated, not lost, and was restored in accordance with observed evidence.

- (g & h) Was the corner reestablished through lost corner proportionate methods? If so, show the method, including the directions and distances to other public land survey corners used as evidence or used for proportioning in determining the corner location?

No.

Charles F. Clark, RLS 1767  
COLEMAN ENGINEERING COMPANY

(1) I,

(type or print name) certify that the corner location shown on this record was determined by me or under my direction and control and that this U.S. Public Land Survey Monument Record is correct and complete to the best of my knowledge and belief.

*Charles F. Clark*


Signature

August 23, 1991

Date

CERTIFICATE READY FOR FILING:

*Darrell E. Richards*  
Acting District Ranger

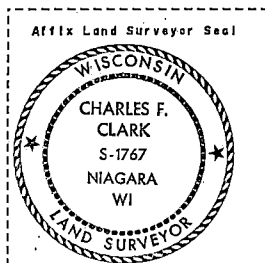

## U. S. PUBLIC LAND SURVEY MONUMENT RECORD


## INSTRUCTIONS:

This record shall show the location of the corner and shall include all of the following nine elements (a through i).

- (a) Identify the corner by reference to the U.S. public land survey system.

○ = Corner monument restored.

Quarter corner to Sections 1 and 6, T.36N., R.16-17E.

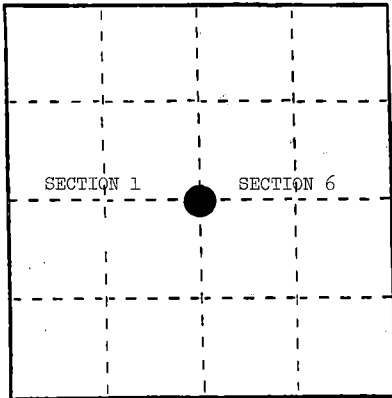

- (b) Describe any record evidence, monument evidence, occupational evidence, testimonial evidence or any other material evidence you considered, and whether the monument was found or placed.

In 1857, Artemas Curtis set post with the following BTs: Hemlock, 8", N.59°W., 3 links; Yellow Birch, 15", S.57°E., 1 link.

October, 1936, to May, 1937, Gould and Hammes - set 4" iron pipe with 4" brass cap from old post in fence corner and scribed 14" Hemlock stump, Northwest, 3 links and 22" Yellow Birch, Southeast, 1 link. New BT: Maple, 8", N.58°W., 28.3'


May 6, 1982, Milo Stefan found 4" brass cap, decayed Maple stump, N.58°W., 28.3', and remains of original Birch BT still present.

November 30, 1984, Alan Harrison found corner as by Gould, set new BTs.

- (c) In the plan view drawing below, provide reference ties to at least 4 witness monuments, or, if the location is within a municipality, to at least 2 witness monuments. (Witness monuments shall be made of concrete, natural stone, iron or other equally durable material.) Describe witness monuments.

- (d) Show a plan view drawing depicting the relevant monuments and reference ties which is sufficient in detail to enable accurate relocation of the corner monument if the corner monument is disturbed. Indicate north.

1. Brass cap stamped to identify the corner.
2. Sugar, 6", S.10°E., 28.27'
3. Sugar, 6", S.53°W., 35.59'
4. Sugar, 5", N.59°W., 45.24'
5. Steel Sign Post, Northeast, 2.32'

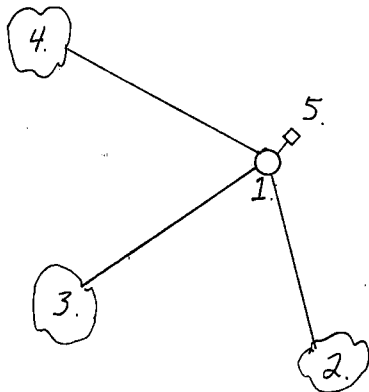

REGISTER'S OFFICE }  
Forest County, Wis. }

Received for record this 23rd day

of January, A.D., 1985

at 9:00 o'clock A.M. and

recorded in Vol. CORNER RESTORATION

on page 35

by [Signature] REGISTER

- (e) Describe any material discrepancy between the location of the corner as restored or reestablished and the location of that corner as previously restored or reestablished by distance and direction. Show the discrepancy on the plan view drawing under (d), above. Show the distances between the corner as previously restored or reestablished and (1) the corner as restored or reestablished, and (2) to at least 2 of the witness monuments shown on the drawing in (d), above.

None.

- (f) Was the corner restored through acceptance of (1) an obliterated evidence location, or, (2) a found perpetuated location?

(2) a found perpetuated location.


- (g&h) Was the corner reestablished through lost corner proportionate methods? If so, show the method, including the directions and distances to other public land survey corners used as evidence or used for proportioning in determining the corner location?

No.

- (1) I, Alan D. Harrison  
(type or print name) certify that the corner location shown  
on this record was determined by me or under my direction and  
control and that this U.S. Public Land Survey Monument Record is  
correct and complete to the best of my knowledge and belief.

Signature

Date

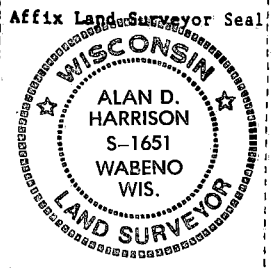


# U. S. PUBLIC LAND SURVEY MONUMENT RECORD

## INSTRUCTIONS:

This record shall show the location of the corner and shall include all of the following nine elements (a through i).

- (a) Identify the corner by reference to the U.S. public land survey system.  
O = Corner monument restored.

Quarter Corner Common to Sections 6 and 7,  
T.36N., R.16E., Forest County, Wisconsin.

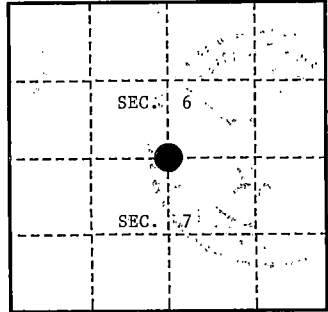

- (b) Describe any record evidence, monument evidence, occupational evidence, testimonial evidence or any other material evidence you considered, and whether the monument was found or placed.


In 1858, James McBride set  $\frac{1}{4}$  post at 49.80 chains from West and made the following references: Aspen, 10", N.18°E., 20 links (13.20'); Aspen, 12", S.26°W., 18 links (11.88').

In May 1993, Alan Harrison searched for corner evidence at proportional position and found no evidence. Position falls in cedar, spruce and black ash swamp not called for an original survey. Set corner at proportional position.

- (c) In the plan view drawing below, provide reference ties to at least 4 witness monuments, or, if the location is within a municipality, to at least 2 witness monuments. (witness monuments shall be made of concrete, natural stone, iron or other equally durable material.)

- (d) Show a plan view drawing depicting the relevant monuments and reference ties which is sufficient in detail to enable accurate relocation of the corner monument if the corner monument is disturbed. Indicate north.

1. 2 $\frac{1}{2}$ " x 60" Aluminum Monument stamped to identify corner location.
2. Spruce, 4", N.1°E., 25.77 feet
3. Spruce, 8", N.76°E., 22.61 feet
4. Black Ash 5", N.55°W., 14.04 feet
5. Steel Sign Post, West, 0.94 feet

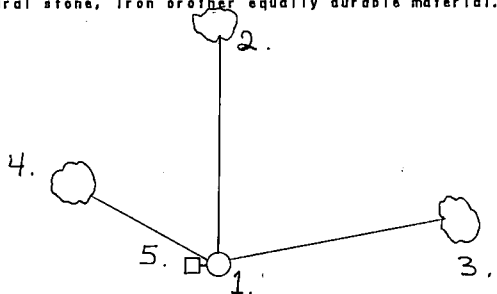

REGISTER'S OFFICE  
Forest County, Wis.

Received for record this 20th day  
of JUNE A.D. 1993 at  
2:00 o'clock A.M. and recorded  
in Vol. 1000 RESTORATIONS  
page E-3

*Paul H. Anderson*  
Register of Deeds

43616060020  
E-3

(e) Describe any material discrepancy between the location of the corner as restored or reestablished and the location of that corner as previously restored or reestablished by distance and direction. Show the discrepancy on the plan view drawing under (d), above. Show the distances between the corner as previously restored or reestablished and (1) the corner as restored or reestablished, and (2) to at least 2 of the witness monuments shown on the drawing in (d), above.


None.

(f) Was the corner restored through acceptance of (1) an obliterated evidence location, or, (2) a found perpetuated location?


No.

(g & h) Was the corner reestablished through lost corner proportionate methods? If so, show the method, including the directions and distances to other public land survey corners used as evidence or used for proportioning in determining the corner location?

Yes.

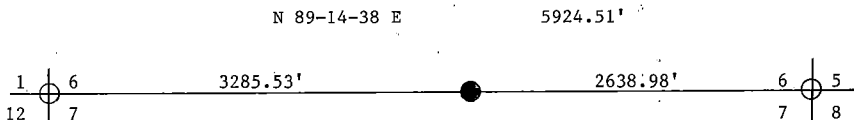

(1) I, Alan D. Harrison  
(type or print name) certify that the corner location shown on this record was determined by me or under my direction and control and that this U.S. Public Land Survey Monument Record is correct and complete to the best of my knowledge and belief.

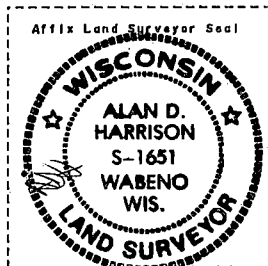

Signature

Date

CERTIFICATE READY FOR FILING:

District Ranger


## U. S. PUBLIC LAND SURVEY MONUMENT RECORD

## INSTRUCTIONS:

This record shall show the location of the corner and shall include all of the following nine elements (a through i).

- (a) Identify the corner by reference to the U.S. public land survey system.  
 O = Corner monument restored.

Corner Common to Sections 5, 6, 7, and 8,  
 T.36N., R.16E., Forest County, Wisconsin.

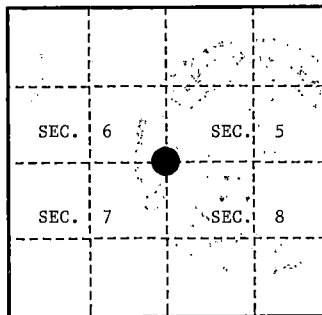

- (b) Describe any record evidence, monument evidence, occupational evidence, testimonial evidence or any other material evidence you considered, and whether the monument was found or placed.

In 1858, James McBride set post for corner and made the following references: Aspen, 10", N.61°W., 13 links (8.58'); Aspen, 12", N.32E., 33 links (21.78'); Fir, 10", S.54°E., 13 links (8.58'); Fir, 10", S.32°W., 33 links (21.78'). Left swamps 10 ch south and entered swamp 6 ch north.

In 1963, D. Seeberg found iron pipe set by Goodman Company. Goodman Company notes make no mention of this corner.


In 1964 S. Novak noted pipe bulldozed out by Brewer.

Oct. 1992, Alan Harrison set corner based on swamp calls north and south on blazed lines. Old blaze line west and on swamp call east. These all originate at same location which I accept as the best location of this corner.

- (c) In the plan view drawing below, provide reference ties to at least 4 witness monuments, or, if the location is within a municipality, to at least 2 witness monuments. (Witness monuments shall be made of concrete, natural stone, iron or other equally durable material.)

- (d) Show a plan view drawing depicting the relevant monuments and reference ties which is sufficient in detail to enable accurate relocation of the corner monument if the corner monument is disturbed. Indicate north.

1. 2½" x 36" Aluminum Monument stamped to identify corner location.
2. Sugar, 15", North, 56.36 feet
3. Sugar, 14", S.49°E., 38.01 feet
4. Sugar, 13", S.25°W., 13.40 feet
5. Yellow Birch, 9", N.45°W., 47.85 feet
6. Steel Sign Post, S.W., 1.02 feet

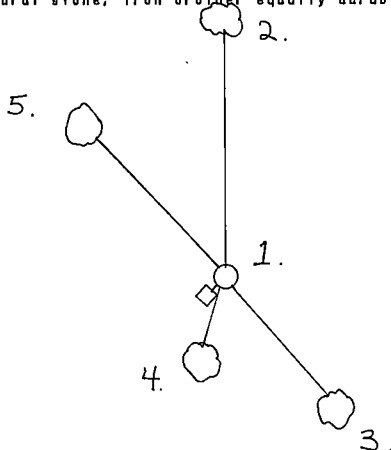

REGISTER'S OFFICE  
 Forest County, Wis.

Received for record this 20th day  
 of June, A.D., 1992, at  
 2:00 o'clock P.M. and recorded  
 in Vol. CORNER RESTORATIONS  
 page E-5  
*Paul A. Schenck*  
 Register of Deeds

43616060000

(a) Describe any material discrepancy between the location of the corner as restored or reestablished and the location of that corner as previously restored or reestablished by distance and direction. Show the discrepancy on the plan view drawing under (d), above. Show the distances between the corner as previously restored or reestablished and (1) the corner as restored or reestablished, and (2) to at least 2 of the witness monuments shown on the drawing in (d), above.

None.

(f) Was the corner restored through acceptance of (1) an obliterated evidence location, or, (2) a found perpetuated location?

An obliterated position.

(g & h) Was the corner reestablished through lost corner proportionate methods? If so, show the method, including the directions and distances to other public land survey corners used as evidence or used for proportioning in determining the corner location?

No.

(1) I, Alan D. Harrison


(type or print name) certify that the corner location shown on this record was determined by me or under my direction and control and that this U.S. Public Land Survey Monument Record is correct and complete to the best of my knowledge and belief.

Alan D. Harrison  
Signature

6/16/93  
Date

CERTIFICATE READY FOR FILING:

Eue Vap  
District Ranger

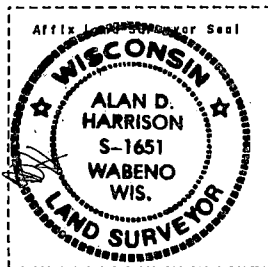


## U. S. PUBLIC LAND SURVEY MONUMENT RECORD

## INSTRUCTIONS:

This record shall show the location of the corner and shall include all of the following nine elements (a through i).

- (a) Identify the corner by reference to the U.S. public land survey system.  
 O = Corner monument restored.

Quarter corner common to sections  
 5 and 8, T.36N., R.16E. Forest County, Wisconsin

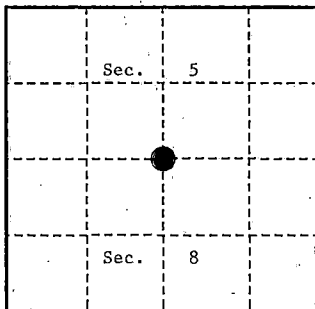

- (b) Describe any record evidence, monument evidence, occupational evidence, testimonial evidence or any other material evidence you considered, and whether the monument was found or placed.

In 1858, James Mc Bride set a wood post with the following B.T.'s: Cedar, 10", N.43°E., 29 links; Sugar, 12", S.41°E., 22 links. 2.50 chains West entered Cedar swamp, North and South 5.00 chains West stream, 4 links, South 16.50 West, leave swamp, NW and SE.


In 1928, Goodman Co. set 3" Cedar post and 2"x32" flue pipe. Original B.T.'s: Cedar, 14", N.38°E. 29 links, (19.14 feet); Maple, 17", S.43°E., 22 links, (14.52 feet).

On October 15, 1991, Alan D. Harrison (RLS) paced from North-South call on stream East 330 feet and found a 2" flue pipe and cedar post remains. From flue pipe the following bear: Cedar, 15", N.40°E., 19.1 feet, fallen on ground; maple stump, 20", S.40°E., 14.5 feet. Blazed Hemlocks facing corner. Replaced flue pipe with monument in mound of stone as best evidence of corner location.

- (c) In the plan view drawing below, provide reference ties to at least 4 witness monuments, or, if the location is within a municipality, to at least 2 witness monuments. (witness monuments shall be made of concrete, natural stone, iron or other equally durable material.)

- (d) Show a plan view drawing depicting the relevant monuments and reference ties which is sufficient in detail to enable accurate relocation of the corner monument if the corner monument is disturbed. indicate north.

- 2½"x36" Aluminum monument with tablet stamped to identify the corner.
- Hemlock, 9", N.58°E., 28.13 feet.
- Hemlock, 9", S.10°E., 18.85 feet.
- Sugar, 7", N.55°W., 15.68 feet.
- Steel Sign Post, 6", 1.23 feet, S.W. of

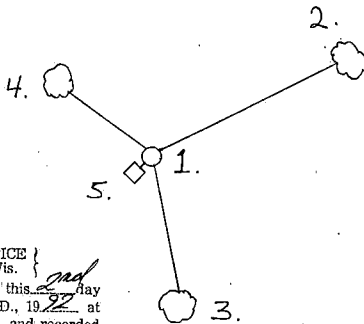

REGISTER'S OFFICE  
 Forest County, Wis.  
 Received for record this 2nd day  
 of March, A.D., 1992, at  
 2:00 o'clock P.M. and recorded  
 in Vol. 1000 Restoration  
 page E-7

(e) Describe any material discrepancy between the location of the corner as restored or reestablished and the location of that corner as previously restored or reestablished by distance and direction. Show the discrepancy on the plan view drawing under (d), above. Show the distances between the corner as previously restored or reestablished and (1) the corner as restored or reestablished, and (2) to at least 2 of the witness monuments shown on the drawing in (d), above.

None.

(f) Was the corner restored through acceptance of (1) an obliterated evidence location, or, (2) a found perpetuated location?

(2) a found perpetuated location.

(g & h) Was the corner reestablished through lost corner proportionate methods? If so, show the method, including the directions and distances to other public land survey corners used as evidence or used for proportioning in determining the corner location?

No.

(1) I, Alan D. Harrison  
(type or print name) certify that the corner location shown on this record was determined by me or under my direction and control and that this U.S. Public Land Survey Monument Record is correct and complete to the best of my knowledge and belief.


Alan D. Harrison  
Signature

12/31/91  
Date

CERTIFICATE READY FOR FILING:

Sue Vap

District Ranger

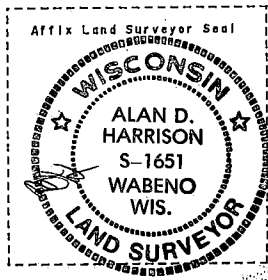

143922


## U. S. PUBLIC LAND SURVEY MONUMENT RECORD

## INSTRUCTIONS:

This record shall show the location of the corner and shall include all of the following nine elements (a through i).

- (a) Identify the corner by reference to the U.S. public land survey system.  
 O = Corner monument restored.

Section corner to Sections 4, 5, 8 and 9,  
 T.36N., R.16E., Forest County, Wisconsin.

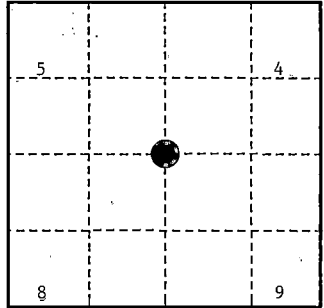

- (b) Describe any record evidence, monument evidence, occupational evidence, testimonial evidence or any other material evidence you considered, and whether the monument was found or placed.

In 1858, Jmaes Mc Bride set wood post with the following B.T.'s: Cedar, 8", N.42°W., 22 links (14.52 feet); Cedar, 12", N.22°E., 11 links (7.26 feet); Cedar, 12", S.35°E., 25 links (16.50 feet); Cedar, 12", S.28°W., 11 links (7.26 feet); North, 0.88 chains (58.08 feet), Stream 10 links wide, runs East.


In 1928 Goodman Co. set 3" Cedar post and flue pipe; from Cedar post the following bear: Cedar, 11", N.15°E., 11 links (7.26 feet); Cedar, 13", S.54°E., 21 links (13.86 feet); Cedar, 12", S.30°W., 10 links (6.60 feet).

On October 16, 1991, Alan D. Harrison (RLS) found 2" flue pipe South of stream 60 feet; from pipe the following bear: Cedar, 10", N.42°W., 13.8 feet, fallen over with blazes visible; no scribing visible; Cedar stump and 14" tree lying on ground, N.20°E., 7.26 feet, no scribing visible; old Cedar stump remains, S.40°E., 13.86 feet; Cedar, 15", S.32°W., 7.1 feet, lying on ground, can feel blaze on underside; location poster on 30 foot Hemlock snag, N.84°W., 17 feet, dated 1940 and 1953. Replaced flue pipe with monument as best evidence of corner location.

- (c) In the plan view drawing below, provide reference ties to at least 4 witness monuments, or, if the location is within a municipality, to at least 2 witness monuments. (witness monuments shall be made of concrete, natural stone, iron or other equally durable material.)

- (d) Show a plan view drawing depicting the relevant monuments and reference ties which is sufficient in detail to enable accurate relocation of the corner monument if the corner monument is disturbed. Indicate north.

- 2½"x36" Aluminum monument with tablet stamped to identify.
- White Birch, 7", N.42°E., 38.65 feet.
- Black Ash, 4", S.62°E., 14.62 feet.
- Cedar, 14", S.31°W., 32.21 feet.
- Cedar, 16", N.66°W., 53.87 feet.
- Steel Sign Post, 6', North, 0.82 feet.

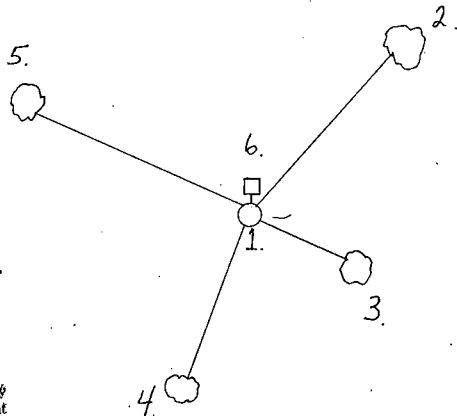

REGISTER'S OFFICE  
 Forest County, Wis.

Received for record this 2nd day  
 of March A.D., 1992 at  
 2:00 o'clock P.M. and recorded  
 in Vol. 1000, page 1000  
 page 5-9

Register of Deeds

43616050000

(e) Describe any material discrepancy between the location of the corner as restored or reestablished and the location of that corner as previously restored or reestablished by distance and direction. Show the discrepancy on the plan view drawing under (d), above. Show the distances between the corner as previously restored or reestablished and (1) the corner as restored or reestablished, and (2) to at least 2 of the witness monuments shown on the drawing in (d), above.

None.

(f) Was the corner restored through acceptance of (1) an obliterated evidence location, or, (2) a found perpetuated location?

(2) a found perpetuated location.

(g & h) Was the corner reestablished through lost corner proportionate methods? If so, show the method, including the directions and distances to other public land survey corners used as evidence or used for proportioning in determining the corner location?

No.


(1) I, Alan D. Harrison

(type or print name) certify that the corner location shown on this record was determined by me or under my direction and control and that this U.S. Public Land Survey Monument Record is correct and complete to the best of my knowledge and belief.

Alan D. Harrison 1/10/92  
Signature Date

CERTIFICATE READY FOR FILING:

Sue Vap  
District Ranger

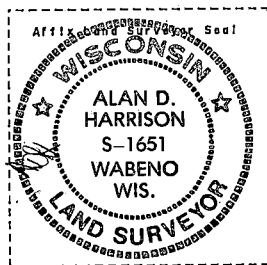

# Document Number

195866 U.S. PUBLIC LAND SURVEY MONUMENT RECORD

(As Required By s. A-E 7.08, WI Adm. Code)

REGISTER'S OFFICE  
Forest County, WI  
Received for record this 7th day  
of November AD, 2007  
at 9:00 o'clock A M. and  
recorded in Vol. Corner Restorations  
on page E-11  
Kay Swanson  
Deputy REGISTER


History of original corner establishment and subsequent restorations and description of any record, monument, occupational, testimonial or other evidence considered:

2006 JEFFREY M. LIEUWEN FOUND 2" PIPE SLEEPING IN NEWLY "CUT OFF" AND BUILT, DOZED AREA. I RESET THIS PIPE WHERE BELIEVED IT HAD BEEN. I FOUND POSITION TO BE TO FAR NORTH. AFTER ADDITIONAL SEARCH OF AREA, I SET A 2" x 18" PIPE HALF WAY ON LINE BETWEEN FOUND SOUTHEAST AND SOUTHWEST SECTION CORNERS

Corner was: (Check All That Apply)

- ☐ Restored through acceptance of an obliterated evidence location
- ☐ Restored through acceptance of a found perpetuated location
- ☒ Considered a lost corner and reestablished through lost corner proportionate methods(include a plan view drawing showing distances and directions to other Public Land Survey Corner used for proportioning and determining the corner location)
- ☐ Restored or reestablished in a location that differs from a previous restoration of reestablishment(include a plan view drawing and indicate what was set and/or found)

Describe the monument and accessories used to perpetuate the location of this corner. (include a plan view drawing and indicate what was set and/or found)

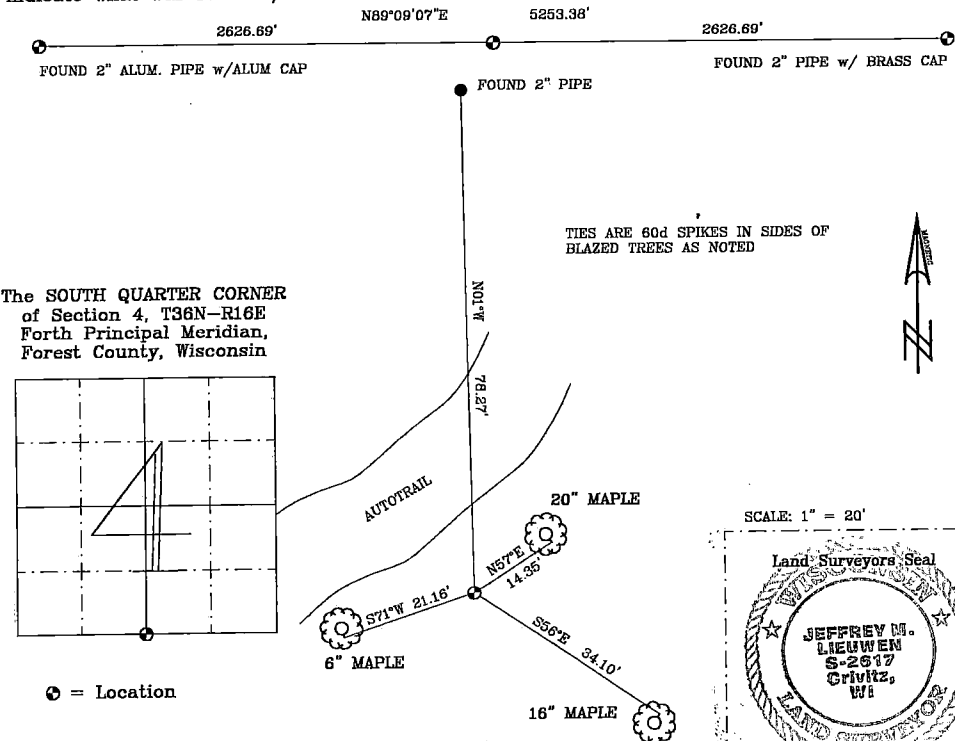

⊙ = Location

JEFFREY M. LIEUWEN RLS 2617  
(Type or print name) certify that the corner location shown on this record was determined by me or under my direction and control and that this (U.S. Public Land Survey Monument Record) is correct and complete to the best of my knowledge and belief.

Jeffrey M. Lieuwen  
Signature



Nov. 6, 2007  
Date

Index No. E-11

4361604 0020

E-11

# U. S. PUBLIC LAND SURVEY MONUMENT RECORD

## INSTRUCTIONS:


This record shall show the location of the corner and shall include all of the following nine elements (a through i).

- (a) Identify the corner by reference to the U.S. public land survey system.  
O = Corner monument restored.

Corner Common to Sections 3, 4, 9 and 10,  
T36N-R16E

Index Number E-13 (T36N-R16E)

Forest County, Wisconsin

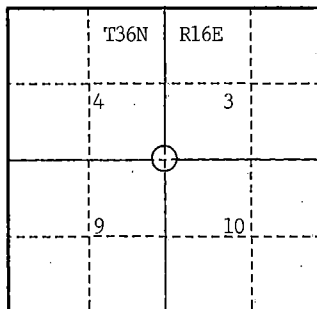

- (b) Describe any record evidence, monument evidence, occupational evidence, testimonial evidence or any other material evidence you considered, and whether the monument was found or placed.

1858 - Original post by James McBride, witnessed by 10 Hemlock N43W 33 lks.; 12 Hemlock N20E 44lks.; 16 Hemlock S35W 24 lks.; 24 W. Birch S11E 48 lks.

1930± Goodman Lumber Co. notes show corner monumented with 2" flue pipe.


1973 - Iron pipe and OBT stumps recovered by J. Resvick, S-802. Corner position restored with 2" x 36" iron pipe with stamped brass cap witnessed by: Hemlock 23" N45°W 39.29'; Maple 14" N50°E 20.55'; Maple 12" S54°W 34.73'; Steel sign post NE 0.5'. (Forest County Document No. 107007)

1991 - Coleman Engineering Company recovered record monument and references, marked March 2 additional NBTs.

- (c) In the plan view drawing below, provide reference ties to at least 4 witness monuments, or, if the location is within a municipality, to at least 2 witness monuments. (Witness monuments shall be made of concrete, natural stone, iron or other equally durable material.)

- (d) Show a plan view drawing depicting the relevant monuments and reference ties which is sufficient in detail to enable accurate relocation of the corner monument if the corner monument is disturbed. Indicate north.

- 2" Iron pipe with brass cap stamped to identify location
- Hemlock 23" N45°W 39.29 feet.
- Maple 14" N50°E 20.55 feet.
- Maple 12" S54°W 34.73 feet.
- Maple 6" S42°W 54.79 feet.
- Hemlock 19" N64°W 49.94 feet.
- Steel sign post Northeast 0.5 foot.

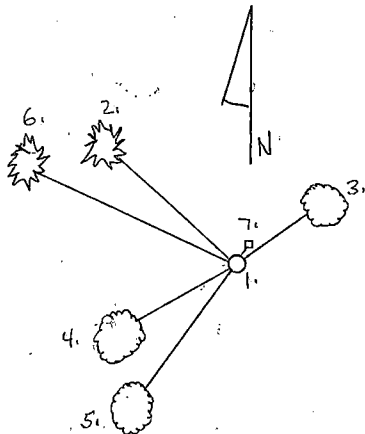

REGISTER'S OFFICE  
Forest County, Wis.

Received for record this 28th day  
of October, A.D., 1991, at  
2:00 o'clock P.M. and recorded  
in Vol. 1000 and recorded  
page E-13

Register of Deeds

43616040000

E-13

- (a) Describe any material discrepancy between the location of the corner as restored or reestablished and the location of that corner as previously restored or reestablished by distance and direction. Show the discrepancy on the plan view drawing under (d). above. Show the distances between the corner as previously restored or reestablished and (1) the corner as restored or reestablished, and (2) to at least 2 of the witness monuments shown on the drawing in (d). above.

Accepted found monument as true corner.

- (f) Was the corner restored through acceptance of (1) an obliterated evidence location, or, (2) a found perpetuated location?

(2) Found perpetuated location.

- (g & h) Was the corner reestablished through lost corner proportionate methods? If so, show the method, including the directions and distances to other public land survey corners used as evidence or used for proportioning in determining the corner location?

No.

Charles F. Clark, RLS 1767  
COLEMAN ENGINEERING COMPANY

(1) I,

(type or print name) certify that the corner location shown on this record was determined by me or under my direction and control and that this U.S. Public Land Survey Monument Record is correct and complete to the best of my knowledge and belief.

*Charles F. Clark*


Signature

August 22, 1991

Date

CERTIFICATE READY FOR FILING:

*Darrell E. Richards*  
Acting District Ranger

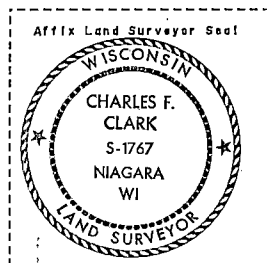

# CERTIFIED LAND CORNER RESTORATION

State of Wisconsin

County of Forest

ss.

I Jean F. Resvick, do hereby certify that on the 15th day of November, 19 73, I found evidence of the southeast section corner of Section 4 Township 36 North, Range 16 East, Fourth Principal Meridian, as described hereon; and that from this evidence I established a new monument and accessories as described hereon to perpetuate the original location of this corner:

## Description of original monument and accessories and subsequent restorations:

Surveyed in 1858 by James McBride

80.00 chains north between Sections 9 and 10 set post.


Hemlock 10, N43W, 33 lks	6.00 chs south ent. tamarack swamp bears E & W
Hemlock 12, N20E, 44 lks	8.00 chs south stream, 10 lks wide, runs east
Birch 24, S11E, 48 lks	10.00 chs east ent. swamp bears NE & SW
Hemlock 16, S35W, 24 lks	19.00 chs east stream, 10 lks wide, runs NE
	20.00 chs west ent. tamarack swamp bears NW & SE
	23.50 chs west stream, 8 lks wide runs SE

## Description of corner evidence found:

1 1/2 inch iron pipe 3 feet above ground  
 Stump remains, N43W, 33 lks  
 Stump remains, N20E, 44 lks  
 Stump remains, S11E, 48 lks  
 Stump remains, S35W, 24 lks  
 Natural calls above check  
 Maple 14, N50E, 20.55 ft., scribed  
 Maple 12, S54W, 34.73 ft., scribed

## Description of monument and accessories I established to perpetuate the location of this corner:

Replaced the 1 1/2 inch pipe with a 2 inch inside diameter galvanized pipe, 3 feet long, filled with concrete with a brass cap stamped: T36N, R16E, S3, S4, S9, S10, 1975, S-802  
 From which the following new blazed and scribed bearing trees bear:  
 Hemlock 23 inch diameter N45W, 39.29 feet  
 Set a steel sign post northeast of the monument, 0.50 feet

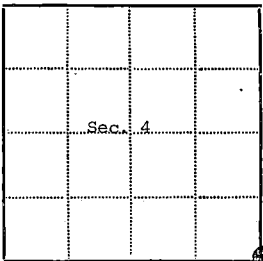

- ⊙ - Corner monument restored
- -

Resident witnesses

Dated at Rhinelander Wisconsin, this 4 day of April, 19 75.

Signature Jean F. Resvick Title Land Surveyor  
 (County Surveyor, Registered Land Surveyor, or other duly authorized official)

Surveyors Registration No. S-802 DOCUMENT NUMBER 107007

Office of Register of Deeds County of Forest

I hereby certify that the within instrument was filed in this office for record on the 30th day of April, 19 75, and was filed in Book No. \_\_\_\_\_ Page No. \_\_\_\_\_ of County Records.

Signature Eugene Stutz Title Register of Deeds

Township 36 North, Range 16 East Section 4 Index No. E-13, Page No. \_\_\_\_\_

43616740000

E  
13

142940

## U. S. PUBLIC LAND SURVEY MONUMENT RECORD

## INSTRUCTIONS:


This record shall show the location of the corner and shall include all of the following nine elements (a through i).

- (a) Identify the corner by reference to the U.S. public land survey system.  
O = Corner monument restored.

Quarter Corner Common to Sections 3 and 9,  
T36N-R16E

Index Number E-15 (T36N-R16E)

Forest County, Wisconsin

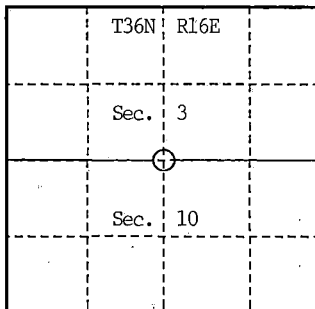

- (b) Describe any record evidence, monument evidence, occupational evidence, testimonial evidence or any other material evidence you considered, and whether the monument was found or placed.

1858 - Original post set by James McBride, witnessed by Fir 8 N05W 21 lks.;  
Fir 8 S41W 18 lks.


Found no record of subsequent recovery or remonumentation.

1991 - Coleman Engineering Company established survey traverse between SW and SE corners of Section 3 to establish search location. No recovery of identifiable original evidence resulted from thorough search of area. Corner was assumed to be lost and to be restored by proportionate method. Established monument at midpoint of straight line between section corners. Position falls 15 to 20 feet West of toe of high ground to East (GLO measure is 0.5 chain or 33 feet). Found leaning 15" Cedar S47°W 58.0' from established monument with Consolidated Waterpower and Paper Co. corner poster dated 1953.

- (c) In the plan view drawing below, provide reference ties to at least 4 witness monuments, or, if the location is within a municipality, to at least 2 witness monuments. (witness monuments shall be made of concrete, natural stone, iron or other equally durable material.)

- (d) Show a plan view drawing depicting the relevant monuments and reference ties which is sufficient in detail to enable accurate relocation of the corner monument if the corner monument is disturbed. Indicate north.

1. 2½" x 36" Aluminum monument with location stamped on cap.
2. Y. Birch 20" N38°E 6.58' feet.
3. Cedar 10" S31°E 53.56 feet.
4. Y. Birch 12" S57°W 22.22 feet.
5. Y. Birch 14" N34°W 48.61 feet.
6. Steel sign post North 1.60 feet.

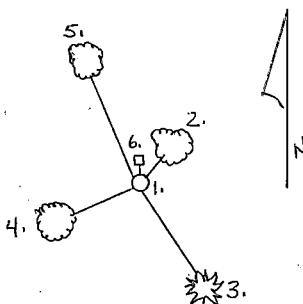

REGISTER'S OFFICE  
Forest County, Wis.

Received for record this 8th day  
of October A.D. 1991 at  
2:00 o'clock P.M. and recorded  
in Vol. Corner Restorations  
page E-15

Register of Deeds

43616030020

E-15

- (e) Describe any material discrepancy between the location of the corner as restored or reestablished and the location of that corner as previously restored or reestablished by distance and direction. Show the discrepancy on the plan view drawing under (d), above. Show the distances between the corner as previously restored or reestablished and (1) the corner as restored or reestablished, and (2) to at least 2 of the witness monuments shown on the drawing in (d), above.

Found no evidence of prior corner recovery or restoration.


- (f) Was the corner restored through acceptance of (1) an obliterated evidence location, or, (2) a found perpetuated location?

Neither.

- (g & h) Was the corner reestablished through "lost corner proportionate methods"? If so, show the method, including the directions and distances to other public land survey corners used as evidence or used for proportioning in determining the corner location?

Corner restored at midpoint of straight line between Southwest and Southeast corners of Section 3.

T36N-R16E

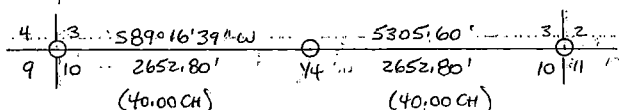

Charles F. Clark, RLS 1767  
COLEMAN ENGINEERING COMPANY

- (1) I, COLEMAN ENGINEERING COMPANY  
(type or print name) certify that the corner location shown on this record was determined by me or under my direction and control and that this U.S. Public Land Survey Monument Record is correct and complete to the best of my knowledge and belief.

Charles F. Chubb


August 23, 1991

**Signature**

Date \_\_\_\_\_

**CERTIFICATE READY FOR FILING:**

Darrell E. Richards  
Acting District Ranger

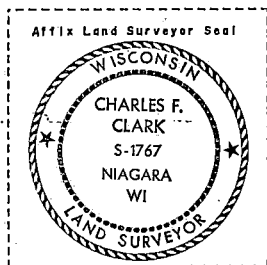

CERTIFIED LAND CORNER RESTORATION

State of Wisconsin }  
County of Forest } ss.

I Milo E. Stefan, do hereby certify that on the 10th day of September, 1981, I found evidence of the Northwest corner of Section 11 Township 36 North, Range 16 East, Fourth Principal Meridian, as described hereon; and that from this evidence I established a new monument and accessories as described hereon to perpetuate the original location of this corner:

Description of original monument and accessories and subsequent restorations:  
Surveyed in 1858 by James McBride  
80.00 chains, set wood post  
Hemlock, 20", N3W, 57 lks.  
Hemlock, 16", N54E, 28 lks.  
Sugar, 12", S79E, 30 lks.  
Hemlock, 12", S78W, 31 lks.  
Surveyed in October, 1927, by Goodman Lumber Co.  
Placed 2" iron flue pipe alongside ironwood post. Area recently burnt, no BTs remain.

Description of corner evidence found:


Accepted iron pipe as best remaining evidence, as it was used by Goodman and the Forest Service for many years.

Description of monument and accessories I established to perpetuate the location of this corner:

Replaced flue pipe with a 2" x 30" aluminum pipe in mound of stone with tablet stamped as follows:  
T36N, R16E, S3, S2, S10, S11, 1981, RLS-1558  
From which the following bear:  
S. Maple, 6", N24E, 40.58 feet  
Y. Birch, 6", S25E, 33.35 feet  
S. Maple, 6", S69W, 16.91 feet  
S. Maple, 8", N60W, 30.93 feet  
Set a steel sign post Northwest 2.3 feet

DOCUMENT NO.

**124219**

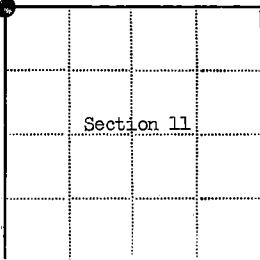

● - Corner monument restored

□ -

Resident witnesses.....

Dated at Rhinelander, Wisconsin, this 4 day of MARCH 1982.

Signature Milo E. Stefan Title Land Surveyor  
(County Surveyor, Registered Land Surveyor, or other duly authorized official)

Surveyors Registration No. RLS-1558

Office of Register of Deeds County of Forest

I hereby certify that the within instrument was filed in this office for record on the 14th day of September, 1983, and was filed in Book No. \_\_\_\_\_ Page No. \_\_\_\_\_ of County Records.

Signature Eugene Stutzman Title Register of Deeds

Township 36 North, Range 16 East, Section 11, Index No. E-17, Page No. 47

43616030000

E 17

## U. S. PUBLIC LAND SURVEY MONUMENT RECORD

## INSTRUCTIONS:


This record shall show the location of the corner and shall include all of the following nine elements (a through i).

- (a) Identify the corner by reference to the U.S. public land survey system.  
O = Corner monument restored.

Quarter Corner common to Sections 2 and 11,  
T36N-R16E

Index Number E-19 (T36N-R16E)

Forest County, Wisconsin

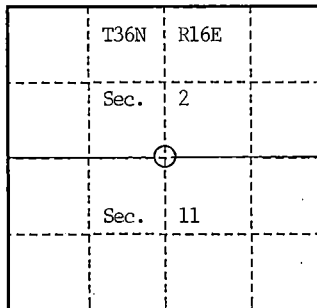

- (b) Describe any record evidence, monument evidence, occupational evidence, testimonial evidence or any other material evidence you considered, and whether the monument was found or placed.

1858 - Original post established by James McBride, witnessed by 16 W. Birch South 51 lks.; 14 W. Birch N44E 29 lks.


1930 - Goodman Lumber Co. notes show corner restored as post set in pile of stones, apparently by proportionate measure. No recovery of original monument or BTs was noted, nor was the marking of NBTs.

1991 - Coleman Engineering Company established a traverse survey between the SW and SE corners of Section 11 to locate the area of corner search. No identifiable remains of the original monument or BTs were found, nor was the post from 1930. However, the remnants of the 1930 stone mound were recovered N03°E 6.4 feet from the calculated corner position. Since the 1930 record was unclear as to the method of corner restoration (no Goodman record for the SE corner of Section 2), the true corner was considered lost. The calculated midpoint location was monumented as the Most probable corner position. No other evidence of occupation or possession was apparent.

- (c) In the plan view drawing below, provide reference ties to at least 4 witness monuments, or, if the location is within a municipality, to at least 2 witness monuments. (Witness monuments shall be made of concrete, natural stone, iron or other equally durable material.)

- (d) Show a plan view drawing depicting the relevant monuments and reference ties which is sufficient in detail to enable accurate relocation of the corner monument if the corner monument is disturbed. Indicate north.

1. 2½" x 36" Aluminum monument with position stamped on cap.
2. Sugar 8" N40°E 16.18 feet.
3. Basswood 5" S61°E 26.69 feet.
4. Aspen 8" S41°W 18.39 feet.
5. Aspen 6" N38°W 10.09 feet.
6. Steel sign post Southwest 1.15 feet.

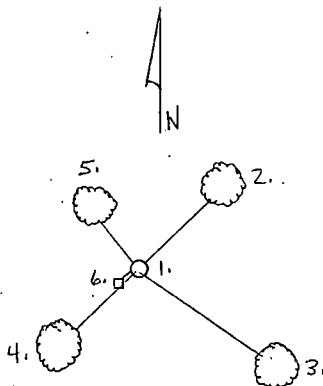

REGISTER'S OFFICE  
Forest County, Wis.

Received for record this 8th day  
of October, A.D., 1997 at  
2:00 o'clock P.M. and recorded  
in Vol. County Recordations  
page 129

Register of Deeds

43616020020

E-19

- (e) Describe any material discrepancy between the location of the corner as restored or reestablished and the location of that corner as previously restored or reestablished by distance and direction. Show the discrepancy on the plan view drawing under (d). above. Show the distances between the corner as previously restored or reestablished and (1) the corner as restored or reestablished, and (2) to at least 2 of the witness monuments shown on the drawing in (d), above.

Found no evidence of prior corner recovery or restoration acceptable for this survey.


- (f) Was the corner restored through acceptance of (1) an obliterated evidence location, or, (2) a found perpetuated location?

Neither.

- (g & h) Was the corner reestablished through lost corner proportionate methods? If so, show the method, including the directions and distances to other public land survey corners used as evidence or used for proportioning in determining the corner location?

Corner was restored by proportionate method at the midpoint of the straight line between the SW and SE corners of Section 2.

T36N-R16E

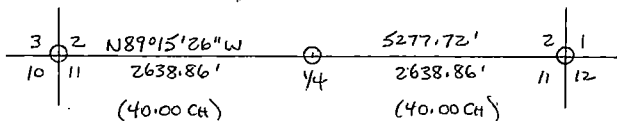

Charles F. Clark, RLS 1767  
COLEMAN ENGINEERING COMPANY

(1). I,

(type or print name) certify that the corner location shown on this record was determined by me or under my direction and control and that this U.S. Public Land Survey Monument Record is correct and complete to the best of my knowledge and belief.

*Charles F. Clark*


Signature

August 23, 1991

Date

CERTIFICATE READY FOR FILING:

*Darrell E. Richard*  
Acting District Ranger

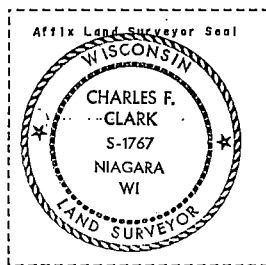

142942

## U. S. PUBLIC LAND SURVEY MONUMENT RECORD

## INSTRUCTIONS:


This record shall show the location of the corner and shall include all of the following nine elements (a through i).

- (a) Identify the corner by reference to the U.S. public land survey system.  
 O = Corner monument restored.

Corner Common to Sections 1, 2, 11 and 12,  
 T36N-R16E

Index Number E-21 (T36N-R16E)

Forest County, Wisconsin

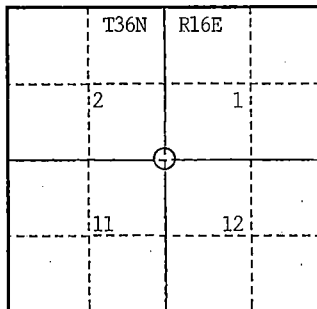

- (b) Describe any record evidence, monument evidence, occupational evidence, testimonial evidence or any other material evidence you considered, and whether the monument was found or placed.

1858 - Original post set by James McBride, witnessed by 10 Sugar N42W 40 lks.;  
 16 Sugar N71E 67 lks.; 20 Hemlock S15E 50 lks.; 20 W. Birch S55W 32 lks.


Found no record of prior corner recovery or restoration.

1991 - Coleman Engineering Company located corner search area from traverse survey between NW corner Sec. 1 and W $\frac{1}{4}$  corner Sec. 12, and SW corner Sec. 2 and S $\frac{1}{4}$  corner Sec. 1. Found 1" x 12" iron bolt with a 1 $\frac{1}{2}$ " square head buried 0.5' below grade in west track of north-south gravel trail road. Original corner monument and BTs likely were lost prior to, or during, trail road construction. No apparent evidence of lines or occupations was evident. Distances and directions to controlling corners in cardinal directions are in general agreement with original survey. Iron bolt was likely established during an earlier unrecorded survey. Position was accepted as the most probable location of the original corner and was restored with a standard monument.

- (c) In the plan view drawing below, provide reference ties to at least 4 witness monuments, or, if the location is within a municipality, to at least 2 witness monuments. (witness monuments shall be made of concrete, natural stone, iron or other equally durable material.)

- (d) Show a plan view drawing depicting the relevant monuments and reference ties which is sufficient in detail to enable accurate relocation of the corner monument if the corner monument is disturbed. Indicate north.

1. 2 $\frac{1}{2}$ " x 36" Aluminum monument with position stamped on cap.
2. Sugar 6" N57°E 25.55 feet.
3. Sugar 9" S38°E 40.82 feet.
4. Sugar 12" S65°W 17.16 feet.
5. Sugar 8" N64°W 52.31 feet.
6. Steel sign post Northwest 11.52 feet.

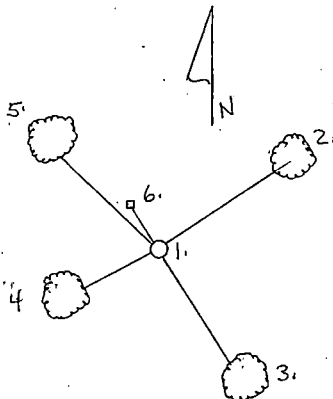

REGISTER'S OFFICE  
 Forest County, Wis.

Received for record this 2nd day  
 of October, A.D., 19 91 at  
2:00 o'clock P.M. and recorded  
 in Book Restorations  
 page E-21

Paul H. Schenck  
 Register of Deeds

43616020000

E-21

- (e) Describe any material discrepancy between the location of the corner as restored or reestablished and the location of that corner as previously restored or reestablished by distance and direction. Show the discrepancy on the plan view drawing under (d), above. Show the distances between the corner as previously restored or reestablished and (1) the corner as restored or reestablished, and (2) to at least 2 of the witness monuments shown on the drawing in (d), above.

Accepted position of found monument as most probable true corner location.

- (f) Was the corner restored through acceptance of (1) an obliterated evidence location, or, (2) a found perpetuated location?

(2) Found perpetuated location.

- (g & h) Was the corner reestablished through lost corner proportionate methods? If so, show the method, including the directions and distances to other public land survey corners used as evidence or used for proportioning in determining the corner location?

No.

Charles F. Clark, RLS 1767  
COLEMAN ENGINEERING COMPANY

(1) I,

(type or print name) certify that the corner location shown on this record was determined by me or under my direction and control and that this U.S. Public Land Survey Monument Record is correct and complete to the best of my knowledge and belief.

Charles F. Clark


Signature

August 22, 1991

Date

CERTIFICATE READY FOR FILING:

Darrell E. Richards  
Acting District Ranger

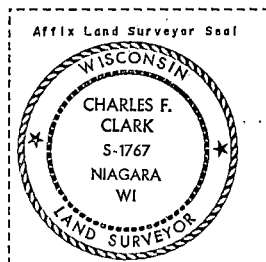

## CERTIFIED LAND CORNER RESTORATION

State of Wisconsin

County of Forest

ss.

I Milo E. Stefan, do hereby certify that on the 24th day of June, 1982, I found evidence of the North Quarter corner of Section 12 Township 36 North Range 16 East, Fourth Principal Meridian, as described hereon; and that from this evidence I established a new monument and accessories as described hereon to perpetuate the original location of this corner:

## Description of original monument and accessories and subsequent restorations:

Surveyed in 1858 by James McBride  
40.00 chains, set wood post  
Spruce, 8", S21°W, 24 lks.  
Tamarack, 10", N53°W, 25 lks.


## Description of corner evidence found:

Found root remains of Spruce BT, S21°W, 15.84 feet  
Tamarack stump, 10", N53°W, 16½ feet scribed "1/4s"  
Local Evidence: Location poster (DNR), N84°E, 20.8 feet, on 8" Cedar.

## Description of monument and accessories I established to perpetuate the location of this corner:

We placed a 2" x 60" aluminum monument stamped as follows:  
T36N, R16E, S1, 1/4, S12, 1982, RLS-1558  
From which the following bear:  
Cedar, 8", S76°E, 35.08 feet  
Cedar, 5", S66°W, 24.77 feet  
Cedar, 6", N45°W, 30.21 feet  
Steel Sign Post, East, 1.70 feet

DOCUMENT NO.

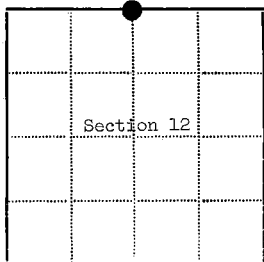**124220**

● - Corner monument restored

□ -

Resident witnesses.....

Dated at Rhineland Wisconsin, this 14th day of September, 1983...

Signature Milo E. Stefan Title Land Surveyor  
(County Surveyor, Registered Land Surveyor, or other duly authorized official)

Surveyors Registration No. RLS-1558Office of Register of Deeds County of Forest

I hereby certify that the within instrument was filed in this office for record on the 14th day of September, 1983, and was filed in Book No. \_\_\_\_\_ Page No. \_\_\_\_\_ of County Records.

Signature Eugene J. Stangor Title Register of Deeds

Township 36 North, Range 16 East, Section 12, Index No. E-23, Page No. 28

436 16010020

## U. S. PUBLIC LAND SURVEY MONUMENT RECORD


## INSTRUCTIONS:

This record shall show the location of the corner and shall include all of the following nine elements (a through i).

- (a) Identify the corner by reference to the U.S. public land survey system.

○ = Corner monument restored.

Section corner to Sections 1, 6, 7, and 12,  
T.36N., R.16-17E.

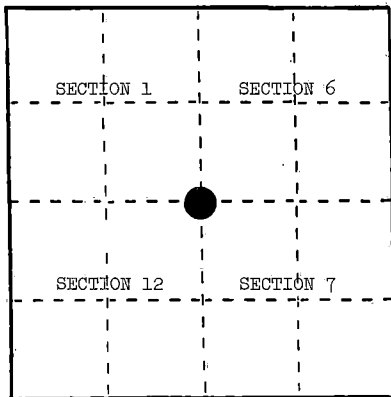

- (b) Describe any record evidence, monument evidence, occupational evidence, testimonial evidence or any other material evidence you considered, and whether the monument was found or placed.

In 1857, Artemas Curtis set post with the following BTs: Hemlock, 16", S.78°W., 17 links; Yellow Birch, 16", N.38°W., 23 links; Hemlock, 10", N.39°E., 48 links; Hemlock, 12", S.22°E., 17 links.


In 1937, Gould and Hammes set iron pipe with brass cap. Set new BTs as follows: Cedar, 8", S.02°W., 70.4 links; Cedar, 6", S.81°W., 130.3 links.

November 30, 1984, Alan Harrison found the following: 4" diameter iron pipe with brass cap; Cedar, 12", S.02°W., 46.46'; Cedar, 8", snag, S.81°W., 86.00'; Hemlock stump, S.22°E., 11.2', "original."

- (c) In the plan view drawing below, provide reference ties to at least 4 witness monuments, or, if the location is within a municipality, to at least 2 witness monuments. (Witness monuments shall be made of concrete, natural stone, iron or other equally durable material.) Describe witness monuments.

- (d) Show a plan view drawing depicting the relevant monuments and reference ties which is sufficient in detail to enable accurate relocation of the corner monument if the corner monument is disturbed. Indicate north.

1. 4" brass cap stamped to identify the corner.
2. Black Cherry, 8", S.86°E., 47.84'
3. Cedar, 12", S.5°W., 46.96'
4. Balsam, 5", S.44°W., 25.42'
5. Black Cherry, 6", N.30°W., 21.49'

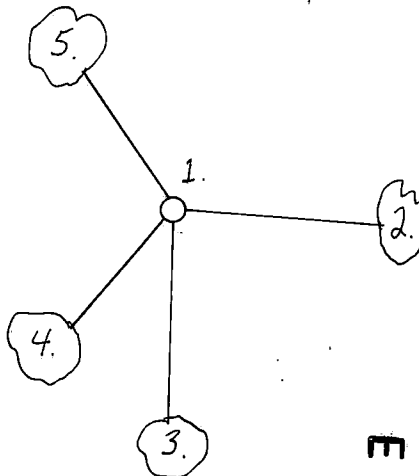

REGISTER'S OFFICE }  
Forest County, Wis.

Received for record this 23rd day  
of January, 1985 at  
9:00 o'clock A.M. and  
recorded in Vol. CORNER RESTORATION  
on page 15

*John A. Anderson*  
REGISTER

- (e) Describe any material discrepancy between the location of the corner as restored or reestablished and the location of that corner as previously restored or reestablished by distance and direction. Show the discrepancy on the plan view drawing under (d), above. Show the distances between the corner as previously restored or reestablished and (1) the corner as restored or reestablished, and (2) to at least 2 of the witness monuments shown on the drawing in (d), above.

None.

- (f) Was the corner restored through acceptance of (1) an obliterated evidence location, or, (2) a found perpetuated location?

(2) a found perpetuated location.


- (g&h) Was the corner reestablished through lost corner proportionate methods? If so, show the method, including the directions and distances to other public land survey corners used as evidence or used for proportioning in determining the corner location?

No.

- (1) I, Alan D. Harrison  
(type or print name) certify that the corner location shown on this record was determined by me or under my direction and control and that this U.S. Public Land Survey Monument Record is correct and complete to the best of my knowledge and belief.

Alan D. Harrison  
Signature

12/14/84  
Date

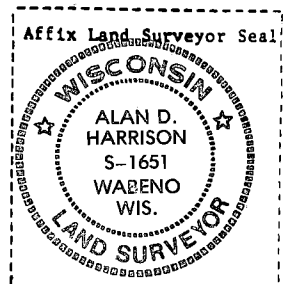

CERTIFIED LAND CORNER RESTORATION

State of Wisconsin }  
County of Forest } ss.

I Milo E. Stefan, do hereby certify that on the 13 day of December, 1979, I found evidence of the East Quarter corner of Section 7 Township 36 North, Range 16 East, Fourth Principal Meridian, as described hereon; and that from this evidence I established a new monument and accessories as described hereon to perpetuate the original location of this corner:

Description of original monument and accessories and subsequent restorations:

Surveyed in 1858 by James McBride.  
North between Sections 7 and 8.  
40.00 chains set  $\frac{1}{4}$  section post.  
Tamarack 8", N20°E, 15 links.  
Tamarack 8", S31°W, 11 links.

Description of corner evidence found:

5" X 5" wood post, scribed, with  $1\frac{1}{2}$ " iron pipe along side, from which evidence of original bearing trees were located. 10" scribed tamarack snag, N20°E, 15 links.  
12" Tamarack stump with BT blaze S31°W, 11 links.


Description of monument and accessories I established to perpetuate the location of this corner:

Replaced wood post and iron pipe with a 2 inch inside diameter aluminum pipe capped with a  $3\frac{1}{2}$ " tablet stamped: T36N, R16E,  $\frac{1}{4}$ , S7, S8, 1979, S-1558.

Blazed and scribed the following new bearing trees:  
Cedar, 11", S18°E, 32.20 feet  
Cedar 9", S60°W, 29.70 feet  
Yellow Birch, 11", N42°W, 12.10 feet  
Set a steel sign post southwest of the monument 1.0 feet.

DOCUMENT NO.

**119858**

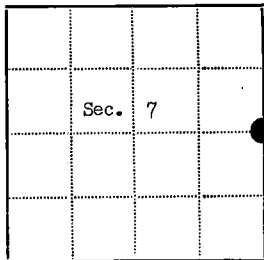

● - Corner monument restored

□ -

Resident witnesses.....

Dated at Laona Wisconsin, this 3 day of November 19 80.

Signature Milo E. Stefan Title Land Surveyor  
(County Surveyor, Registered Land Surveyor, or other duly authorized official)

Surveyors Registration No. S-1558

Office of Register of Deeds County of Forest

I hereby certify that the within instrument was filed in this office for record on the 2nd day of June, 1981, and was filed in Book No. \_\_\_\_\_ Page No. \_\_\_\_\_ of County Records.

Signature Eugene D. Staty Title Register of Deeds

Township 36N, Range 16E, Section 7, Index No. G-5, Page No. \_\_\_\_\_

43616072000

5  
5

## U. S. PUBLIC LAND SURVEY MONUMENT RECORD

## INSTRUCTIONS:


This record shall show the location of the corner and shall include all of the following nine elements (a through i).

- (a) Identify the corner by reference to the U.S. public land survey system.  
O = Corner monument restored.

Quarter Corner common to Sections 9 and 10,  
T36N-R16E

Index Number G-13 (T36N-R16E)

Forest County, Wisconsin

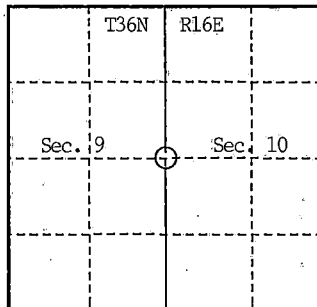

- (b) Describe any record evidence, monument evidence, occupational evidence, testimonial evidence or any other material evidence you considered, and whether the monument was found or placed.

1858 - Original post set by James McBride, witnessed by 12 Spruce N74E 20 lks.;  
12 Cedar N64W 10 lks.


Found no record of subsequent corner recovery or restoration.

1991 - Coleman Engineering Co. established a survey traverse between the NW and SW corners of Section 10 to locate the area of corner search at the midpoint of the straight line between section corners. A thorough search was made and no identifiable remains of the original monument or BTs were found. No evidence of prior lines or occupations was apparent. Corner was considered to be lost and to be restored by proportionate method.

- (c) In the plan view drawing below, provide reference ties to at least 4 witness monuments; or, if the location is within a municipality, to at least 2 witness monuments. (witness monuments shall be made of concrete, natural stone, iron or other equally durable material.)

- (d) Show a plan view drawing depicting the relevant monuments and reference ties which is sufficient in detail to enable accurate relocation of the corner monument if the corner monument is disturbed. Indicate north.

- 2 1/2" x 36" Aluminum monument with position stamped on cap.
- Cedar 12" N18°E 46.33 feet.
- Hemlock 14" S63°E 6.66 feet.
- Y. Birch 16" S47°W 15.75 feet.
- Hemlock 12" N42°W 16.68 feet.
- Steel sign post East 1.26 feet.

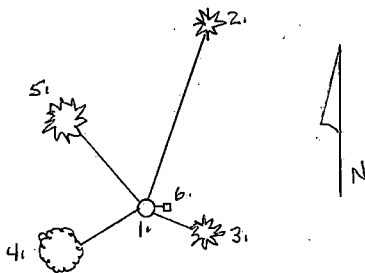

REGISTER'S OFFICE }  
Forest County, Wis. }

Received for record this 18th day  
of October, A.D., 1991 at  
2:00 o'clock P.M. and recorded  
in Vol. 13 of Registration  
page 4-13

Paul A. Schenker  
Register of Deeds

43616092000

G-13

G-13

- (e) Describe any material discrepancy between the location of the corner as restored or reestablished and the location of that corner as previously restored or reestablished by distance and direction. Show the discrepancy on the plan view drawing under (d). above. Show the distances between the corner as previously restored or reestablished and (1) the corner as restored or reestablished, and (2) to at least 2 of the witness monuments shown on the drawing in (d), above.



Found no evidence of prior corner recovery or restoration.

- (f) Was the corner restored through acceptance of (1) an obliterated evidence location, or, (2) a found perpetuated location?

Neither.

- (g & h) Was the corner reestablished through lost corner proportionate methods? If so, show the method, including the directions and distances to other public land survey corners used as evidence or used for proportioning in determining the corner location?

Corner was restored at the midpoint of a straight line between the Northwest and Southwest corners of Section 10, T36N-R16E.

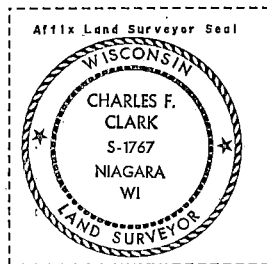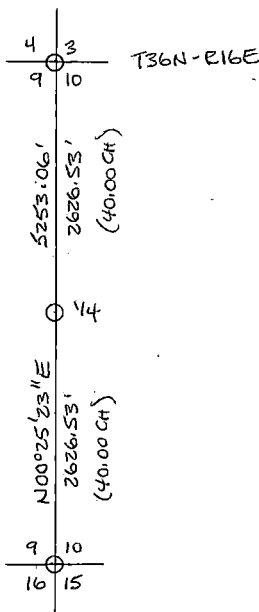

(1) I, Charles F. Clark, RLS 1767  
COLEMAN ENGINEERING COMPANY

(type or print name) certify that the corner location shown on this record was determined by me or under my direction and control and that this U.S. Public Land Survey Monument Record is correct and complete to the best of my knowledge and belief.

Charles F. Clark  
Signature

August 23, 1991

Date

CERTIFICATE READY FOR FILING:

Darrell E. Richards  
Acting District Ranger

CERTIFIED LAND CORNER RESTORATION

State of Wisconsin

County of Forest

SS.

I Milo E. Stefan, do hereby certify that on the 18th day of November, 1981, I found evidence of the West 1/4 corner of Section 11, Township 36 North, Range 16 East, Fourth Principal Meridian, as described hereon; and that from this evidence I established a new monument and accessories as described hereon to perpetuate the original location of this corner:

Description of original monument and accessories and subsequent restorations:

Surveyed in 1858 by James McBride  
40.00 chains, set  $\frac{1}{4}$  section wood post  
Elm, 12", S56E, 14 lks., 9.24 feet  
Birch, 16", S66W, 20 lks., 13.2 feet

Surveyed in 1927 by Goodman Lumber Co.  
Found 3" Hardwood post and 14" Elm stump,  
S56E, 14 lks., set 3" Hemlock post and  
25" flue pipe.

Description of corner evidence found:

Found flue pipe.


Found stump hole, S66W, 13.2 feet and possible stump hole, S56E, 9.24 feet.

Description of monument and accessories I established to perpetuate the location of this corner:

We replaced flue pipe with a 36" aluminum monument with tablet stamped as follows:  
T36N, R16E, S10,  $\frac{1}{4}$ , S11, 1981, RLS-1558  
From which the following bear:  
Rock Elm, 6", S61E, 13.45 feet  
W. Spruce, 8", S14E, 104.18 feet  
W. Spruce, 10", N17W, 112.86 feet  
Steel sign post with mound of stone around monument, N70E, 1.4 ft.

DOCUMENT NO.

**124219**

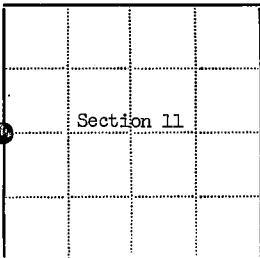

● - Corner monument restored

□ -

Resident witnesses.....

Dated at Rhinelanders Wisconsin, this 2 day of May, 1982.

Signature Milo E. Stefan Title Land Surveyor  
(County Surveyor, Registered Land Surveyor, or other duly authorized official)

Surveyors Registration No. RLS-1558

Office of Register of Deeds County of Forest

I hereby certify that the within instrument was filed in this office for record on the 14th day of September, 1983, and was filed in Book No. \_\_\_\_\_ Page No. \_\_\_\_\_ of County Records.

Signature Ernest Stary Title Register of Deeds

Township 36 North, Range 16 East, Section 11, Index No. G-17, Page No. 78

43616182000

6  
17

142944

## U. S. PUBLIC LAND SURVEY MONUMENT RECORD

## INSTRUCTIONS:


This record shall show the location of the corner and shall include all of the following nine elements (a through i).

- (a) Identify the corner by reference to the U.S. public land survey system.  
O = Corner monument restored.

Quarter Corner common to Sections 11 and 12,  
T36N-R16E

Index Number G-21 (T36N-R16E)

Forest County, Wisconsin

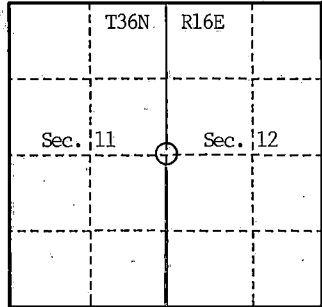


- (b) Describe any record evidence, monument evidence, occupational evidence, testimonial evidence or any other material evidence you considered, and whether the monument was found or placed.

- 1858 - Original post set by James McBride, witnessed by 24 Hemlock S81E 12 lks.;  
24 Hemlock N66W 32 lks.  
1928 - Goodman Lumber Co. notes show corner restored with flue pipe from existing  
NW Hemlock BT.  
1968 - Iron pipe and post recovered by J. Resvick, S-802; Hemlock BT stump in place  
N66°W 21.1'. Additional references were established: Spruce 7" N34°W 21.40';  
Aspen 6" S22°E 30.87'; 4x4" Cedar post Southeast 2.2'. (Forest Co. Document #95887)  
1991 - Coleman Engineering Company recovered 2" iron pipe with stamped brass cap set  
Feb. by J. Resvick and Spruce NBT. Established additional corner references.

- (c) In the plan view drawing below, provide reference ties to at least 4 witness monuments, or, if the location is within a municipality, to at least 2 witness monuments. (Witness monuments shall be made of concrete, natural stone, iron or other equally durable material.)

- (d) Show a plan view drawing depicting the relevant monuments and reference ties which is sufficient in detail to enable accurate relocation of the corner monument if the corner monument is disturbed. Indicate north.

1. 2" Iron pipe with position stamped on brass cap.
2. Spruce 12" N35°W 21.46 feet.
3. Aspen 8" N67°E 33.01 feet.
4. Sugar 4" S65°E 21.15 feet.
5. Balsam 8" S25°W 46.78 feet.
6. Steel sign post Southeast 2.70 feet.

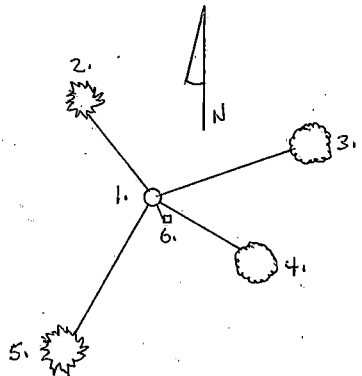

REGISTER'S OFFICE  
Forest County, Wis.

Received for record this 8th day  
of October, A.D., 1991 at  
2:00 o'clock P.M. and recorded  
in Vol. Corral Exposition  
page 8-21

Register of Deeds

43616112000

G-21

G-21

- (e) Describe any material discrepancy between the location of the corner as restored or reestablished and the location of that corner as previously restored or reestablished by distance and direction. Show the discrepancy on the plan view drawing under (d), above. Show the distances between the corner as previously restored or reestablished and (1) the corner as restored or reestablished, and (2) to at least 2 of the witness monuments shown on the drawing in (d), above.

Accepted found monument as true corner.

- (f) Was the corner restored through acceptance of (1) an obliterated evidence location, or, (2) a found perpetuated location?

(2) Found perpetuated location.

- (g & h) Was the corner reestablished through lost corner proportionate methods? If so, show the method, including the directions and distances to other public land survey corners used as evidence or used for proportioning in determining the corner location?

No.

Charles F. Clark RLS 1767  
COLEMAN ENGINEERING COMPANY

(1) I,

(type or print name) certify that the corner location shown on this record was determined by me or under my direction and control and that this U.S. Public Land Survey Monument Record is correct and complete to the best of my knowledge and belief.

*Charles F. Clark*


Signature

August 23, 1991

Date

CERTIFICATE READY FOR FILING:

*Darrell E. Richards*  
Acting District Ranger

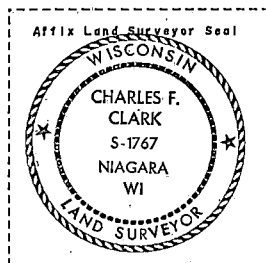

## CERTIFIED LAND CORNER RESTORATION

State of Wisconsin

County of Forest

ss.

I, Jean F. Resvick, do hereby certify that on the 19th day of July, 1968, I found evidence of the West Quarter corner of Section 12 Township 36 North, Range 16 East, Fourth Principal Meridian, as described hereon; and that from this evidence I established a new monument and accessories as described hereon to perpetuate the original location of this corner:

## Description of original monument and accessories and subsequent restorations:

Surveyed in 1858 by James McBride.  
40.00 chains North between Sections 11 and 12  
Set wood post from which:  
Hemlock, 2 1/2 in., bears S. 81° E., 12 Lks.  
Hemlock, 2 1/2 in., bears N. 66° W., 32 Lks.  
6.50 chains North, a stream, 4 Lks. wide, runs SW  
7.50 chains South, a stream, 5 Lks. wide, runs NE

## Description of corner evidence found:



Iron pipe driven in the ground and a wood post alongside, from which a Hemlock stump bears N. 66° W., 21.1 ft.  
The stream calls agree with the recorded distances.

## Description of monument and accessories I established to perpetuate the original location of this corner:

I replaced iron pipe and post with a 2 inch inside diameter galvanized wrought iron pipe, 5 ft. long, flanged at the bottom, filled with concrete with brass cap marked:

from which the following new blazed and scribed bearing trees bear:

Spruce, 7 in. dia., bears N. 34° W., 21.40 ft. or 32.42 Lks.  
Aspen, 6 in. dia., bears S. 22° E., 30.87 ft. or 46.77 Lks.  
4 x 4 Cedar post, bears SE, 2.2 ft. or 3.33 Lks.

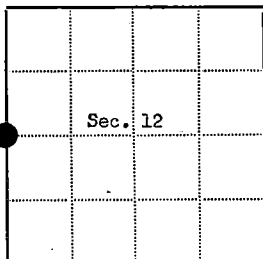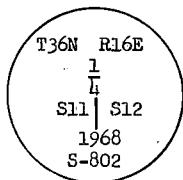

⊗ = Corner monument restored

□ =

Resident witnesses.....

Dated at Rhinelanders Wisconsin, this 19th day of Dec 1968.

Signature Jean F. Resvick Title Cadastral Surveyor  
(County Surveyor, Registered Land Surveyor, or other duly authorized official)


Surveyors Registration No. S-802 DOCUMENT NO. 95887

Office of Register of Deeds County of Forest

I hereby certify that the within instrument was filed in this office for record on the 31st day of January, 1969, and was filed in Book No. I Page No. G-21 of County Records.

Signature Eugene Staley Title Register of Deeds

Township 36 North, Range 16 East, Section 12, Index No. G-21, Page No. 1

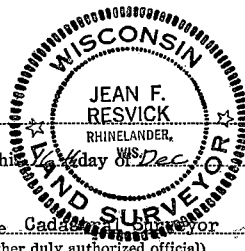

621


# U. S. PUBLIC LAND SURVEY MONUMENT RECORD

## INSTRUCTIONS:

This record shall show the location of the corner and shall include all of the following nine elements (a through i).

- (a) Identify the corner by reference to the U.S. public land survey system.  
O = Corner monument restored.

Forest County Marinette County

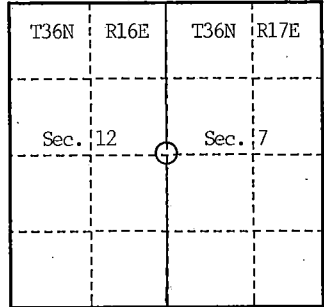

Quarter Corner Common to Section 12, T36N-R16E,  
and Section 7, T36N-R17E

Index Number G-25 (T36N-R16E)

Forest County, Wisconsin


- (b) Describe any record evidence, monument evidence, occupational evidence, testimonial evidence or any other material evidence you considered, and whether the monument was found or placed.

- 1857 - Original post set by Artemas Curtis, witnessed by 6 Cedar N45W 20 lks.;  
8 Y. Birch S63E 02 lks.
- 1937 - Gould and Hammes (Marinette County Survey) recovered old post and verified OBT stumps. Restored corner with 4" iron pipe with brass cap stamped to identify position. No NBTs were marked.
- 1991 - Coleman Engineering Company recovered record monument of Marinette County March Survey; remains of OBT stumps are unidentifiable. Established new corner references.

- (c) In the plan view drawing below, provide reference ties to at least 4 witness monuments, or, if the location is within a municipality, to at least 2 witness monuments. (Witness monuments shall be made of concrete, natural stone, iron or other equally durable material.)

- (d) Show a plan view drawing depicting the relevant monuments and reference ties which is sufficient in detail to enable accurate relocation of the corner monument if the corner monument is disturbed. Indicate north.

- 4" Iron pipe with Marinette County Survey brass cap stamped to identify position.
- Red Maple 6" N65°E 23.55 feet.
- Black Cherry 6" N45°W 24.89 feet.
- Red Maple 6" twin S09°E 29.92 feet.
- Black Cherry 6" S47°W 40.38 feet.
- Steel sign post West 1.51 feet.

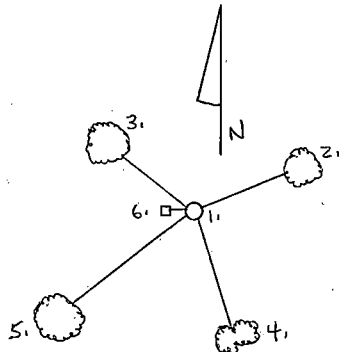

REGISTER'S OFFICE  
Forest County, Wis.

Received for record this 8th day  
of October, A.D., 1997, at  
2:00 o'clock P.M. and recorded  
in Vol. County Restorations  
page G-25.

Register of Deeds

4361612 2000

G-25

4-25

- (e) Describe any material discrepancy between the location of the corner as restored or reestablished and the location of that corner as previously restored or reestablished by distance and direction. Show the discrepancy on the plan view drawing under (d), above. Show the distances between the corner as previously restored or reestablished and (1) the corner as restored or reestablished, and (2) to at least 2 of the witness monuments shown on the drawing in (d), above.

Accepted recovered monument as true corner position.

- (f) Was the corner restored through acceptance of (1) an obliterated evidence location, or, (2) a found perpetuated location?

(2) Found perpetuated location.

- (g & h) Was the corner reestablished through lost corner proportionate methods? If so, show the method, including the directions and distances to other public land survey corners used as evidence or used for proportioning in determining the corner location?

No.

Charles F. Clark, RLS 1767  
COLEMAN ENGINEERING COMPANY

(1) I,

(type or print name) certify that the corner location shown on this record was determined by me or under my direction and control and that this U.S. Public Land Survey Monument Record is correct and complete to the best of my knowledge and belief.

*Charles F. Clark*


Signature

August 23, 1991

Date

CERTIFICATE READY FOR FILING:

*Darrell E. Richards*  
Acting District Ranger

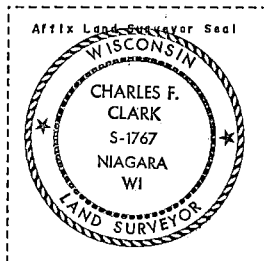

147755


## U. S. PUBLIC LAND SURVEY MONUMENT RECORD

## INSTRUCTIONS:

This record shall show the location of the corner and shall include all of the following nine elements (a through i).

- (a) Identify the corner by reference to the U.S. public land survey system.  
 O = Corner monument restored.

Quarter Corner, Common to Sections 7 and 18,  
 T.36N., R.16E., Forest County, Wisconsin.

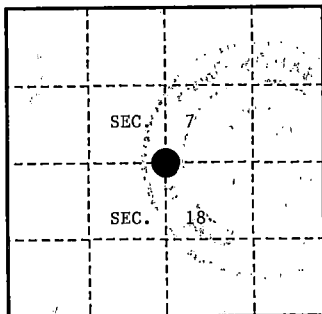

- (b) Describe any record evidence, monument evidence, occupational evidence, testimonial evidence or any other material evidence you considered, and whether the monument was found or placed.

In 1858, James McBride set  $\frac{1}{4}$  post at 49.50 chains from West and made the following references: Aspen, 14", S.38°W., 18 links (11.88'); Aspen, 12", N.58°W., 18 links, (11.88').


In 1928, Goodman Company makes no notes of what found at this corner. At E. 1/8 found 4" Hemlock post set by Blackwell (Company). Set flue pipe 2" x 32".

In 1993, Alan Harrison searched area for corner. Found location tag on 4" sugar tree. Tag rusted and unreadable. Found no evidence of original or subsequent corner. Restored corner at double distance through E. 1/8 pipe as best location of corner. Fits proportion by 3.9 feet.

- (c) In the plan view drawing below, provide reference ties to at least 4 witness monuments, or, if the location is within a municipality, to at least 2 witness monuments. (witness monuments shall be made of concrete, natural stone, iron or other equally durable material.)

- (d) Show a plan view drawing depicting the relevant monuments and reference ties which is sufficient in detail to enable accurate relocation of the corner monument if the corner monument is disturbed. Indicate north.

1. 2 1/2" x 36" Aluminum Monument stamped to identify corner location.
2. Sugar, 10", S.58°E., 13.00 feet
3. Sugar, 9", S.38°W., 27.15 feet
4. Sugar, 9", N.30°W., 24.86 feet
5. Steel Sign Post, South, 0.90 feet

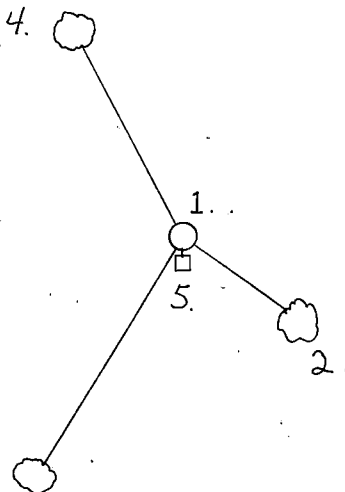

REGISTER'S OFFICE  
 Forest County, Wis.

Received for record this 30th day  
 of JUNE A.D., 19 92 at  
2:00 o'clock P.M. and recorded  
 in Vol. CORNER RESTORATIONS  
 page 3

Paul Hochstetler  
 Register of Deeds

4 3616070020

- (a) Describe any material discrepancy between the location of the corner as restored or reestablished and the location of that corner as previously restored or reestablished by distance and direction. Show the discrepancy on the plan view drawing under (d), above. Show the distances between the corner as previously restored or reestablished and (1) the corner as restored or reestablished, and (2) to at least 2 of the witness monuments shown on the drawing in (d), above.

None.

- (f) Was the corner restored through acceptance of (1) an obliterated evidence location, or, (2) a found perpetuated location?

An obliterated location.

- (g & h) Was the corner reestablished through last corner proportionate methods? If so, show the method, including the directions and distances to other public land survey corners used as evidence or used for proportioning in determining the corner location?

No.

(1) I, Alan D. Harrison


(type or print name) certify that the corner location shown on this record was determined by me or under my direction and control and that this U.S. Public Land Survey Monument Record is correct and complete to the best of my knowledge and belief.

Alan D. Harrison  
Signature

6/16/93  
Date

CERTIFICATE READY FOR FILING:

Sue Vep  
District Ranger

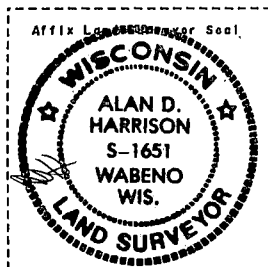


## U. S. PUBLIC LAND SURVEY MONUMENT RECORD

## INSTRUCTIONS:

This record shall show the location of the corner and shall include all of the following nine elements (a through i).

- (a) Identify the corner by reference to the U.S. public land survey system.  
 O = Corner monument restored.

Section Corner to Sections 7-8-17-18,  
 T.36N., R.16E., Forest County, Wisconsin.

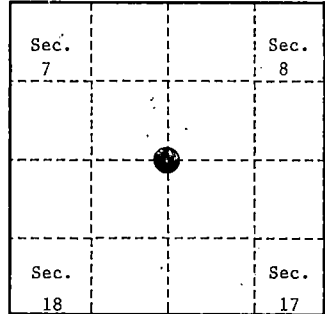

- (b) Describe any record evidence, monument evidence, occupational evidence, testimonial evidence or any other material evidence you considered, and whether the monument was found or placed.

In 1858, James McBride set a wood post with the following B.T.'s: Spruce, 5", N.30°W., 7 links (4.62'); Spruce, 5", N.88°E., 64 links (42.24'); Spruce, 5", S.29°E., 34 links (22.44'); Spruce, 5", S.52°W., 17 links (11.22').

In 1920's Goodman Lumber Company found an old Spruce Post; set 2" x 64" Flue Pipe.

In 1975 and 1976 William Cochrane (RLS) found iron pipe with old post point alongside as per Goodman Lumber Company, from pipe Spruce stump N.88°E., 64 links (42.24'), Spruce stump S.29°E., 34 links (22.44'), Spruce stump S.52°W., 17 links (11.22). He replaced post point with a 2' x 36" galvanized pipe filled with concrete with a brass cap stamped to identify the corner with the following B.T.'s: Spruce, 5", N.67°E., 15.83 feet; Spruce, 4", S.17°E., 22.66 feet; Spruce, 5", S.56°W., 26.21 feet; Spruce, 3", N.52°W., 14.88 feet.


In 1989 Alan Harrison (RLS) found monument and B.T.'s as per Resvick, Northwest B.T. is dead and down, added a B.T. and Steel Sign Post.

In 1993 Alan Harrison (RLS) found monument and bearing trees as described above. Added a new bearing tree; Black Spruce, 3", S.35°E., 5.45 feet.

- (c) In the plan view drawing below, provide reference ties to at least 4 witness monuments, or, if the location is within a municipality, to at least 2 witness monuments. (witness monuments shall be made of concrete, natural stone, iron or other equally durable material.)

- (d) Show a plan view drawing depicting the relevant monuments and reference ties which is sufficient in detail to enable accurate relocation of the corner monument if the corner monument is disturbed. Indicate north.

1. 2" x 36" Iron Pipe filled with concrete with brass cap stamped to identify the corner.
2. Black Spruce, 5", N.67°E., 15.83 feet.
3. Black Spruce, 5", S.56°W., 26.21 feet.
4. Black Spruce, 4", N.32°W., 11.21 feet.
5. Black Spruce, 3", S.35°E., 5.45 feet.
6. Steel Sign Post, South, 0.55 feet.

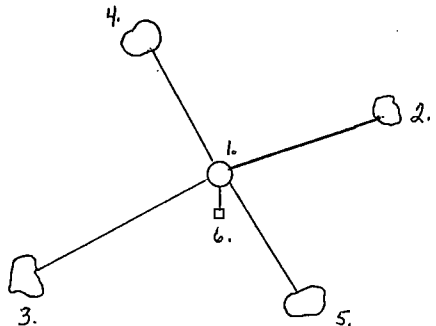

(e) Describe any material discrepancy between the location of the corner as restored or reestablished and the location of that corner as previously restored or reestablished by distance and direction. Show the discrepancy on the plan view drawing under (d), above. Show the distances between the corner as previously restored or reestablished and (1) the corner as restored or reestablished, and (2) to at least 2 of the witness monuments shown on the drawing in (d), above.

None

(f) Was the corner restored through acceptance of (1) an obliterated evidence location, or, (2) a found perpetuated location?

(2) found perpetuated location.

(g & h) Was the corner reestablished through lost corner proportionate methods? If so, show the method, including the directions and distances to other public land survey corners used as evidence or used for proportioning in determining the corner location?

REGISTER'S OFFICE  
Forest County, Wis.

Received for record this 15<sup>th</sup> day  
of September, A.D., 19 94 at  
10 o'clock A. and recorded  
in Vol. County Restorations  
page 5

*John C. Chiles, Deputy*  
Register of Deeds

(1) I, Alan D. Harrison


(type or print name) certify that the corner location shown on this record was determined by me or under my direction and control and that this U.S. Public Land Survey Monument Record is correct and complete to the best of my knowledge and belief.

*Alan D. Harrison*  
Signature

8/17/94  
Date

CERTIFICATE READY FOR FILING:

*Sam Vap*  
District Ranger

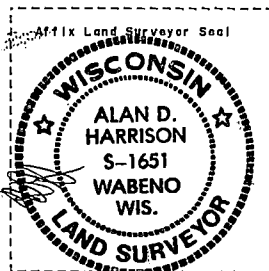

139375

## U. S. PUBLIC LAND SURVEY MONUMENT RECORD.


## INSTRUCTIONS:

This record shall show the location of the corner and shall include all of the following nine elements (a through i).

- (a) Identify the corner by reference to the U.S. public land survey system.

④ = Corner monument restored.

Section Corner to Sections 7-8-17-18,  
T.36N., R.16E., Forest County, Wisconsin.

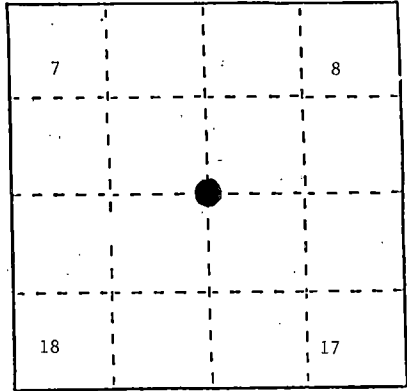

- (b) Describe any record evidence, monument evidence, occupational evidence, testimonial evidence or any other material evidence you considered, and whether the monument was found or placed.

In 1858 James McBride set a wood post with the following B.T.'s: Spruce, 5", N.30°W., 7 links (4.62'); Spruce, 5", N.88°E., 64 links (42.24'); Spruce, 5", S.29°E., 34 links (22.44'); Spruce, 5", S.52°W., 17 links (11.22').

In 1920's Goodman Lumber Company found an old Spruce Post; set 2" x 64" Flue Pipe.


In 1975 and 1976 Jean Resvick (RLS) found iron pipe with old post point alongside as per Goodman Lumber Company, from pipe Spruce stump N.88°E., 64 links (42.24'), Spruce stump S.29°E., 34 links (22.44'), Spruce stump S.52°W., 17 links (11.22'). He replaced post point with a 2' x 36" galvanized pipe filled with concrete with a brass cap stamped to identify the corner with the following B.T.'s: Spruce, 5", N.67°E., 15.83 feet; Spruce, 4", S.17°E., 22.66 feet; Spruce, 5", S.56°W., 26.21 feet; Spruce, 3", N.52°W., 14.88 feet.

In 1989 Alan Harrison (RLS) found monument and B.T.'s as per Resvick, Northwest B.T. is dead and down, added a B.T. and Steel Sign Post.

- (c) In the plan view drawing below, provide reference ties to at least 4 witness monuments, or, if the location is within a municipality, to at least 2 witness monuments. (Witness monuments shall be made of concrete, natural stone, iron or other equally durable material.) Describe witness monuments.

- (d) Show a plan view drawing depicting the relevant monuments and reference ties which is sufficient in detail to enable accurate relocation of the corner monument if the corner monument is disturbed. Indicate north.

- 2" x 36" Iron Pipe filled with concrete with brass cap stamped to identify the corner.
- Black Spruce, 5", N.67°E., 15.83 feet.
- Black Spruce, 4", S.17°E., 22.66 feet.
- Black Spruce, 5", S.56°W., 26.21 feet.
- Black Spruce, 4", N.32°W., 11.21 feet.
- Steel Sign Post, South, 0.55 feet.

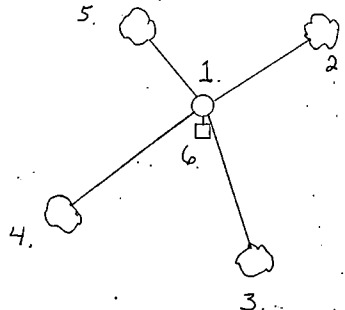

REGISTER'S OFFICE  
Forest County, Wis.

Received for record this 29<sup>th</sup> day  
of March A.D., 1990 at  
10:00 o'clock A.M. and recorded  
in Vol. CORNER RESTORATIONS

Paul H. Hensel  
Register of Deeds

- (e) Describe any material discrepancy between the location of the corner as restored or reestablished and the location of that corner as previously restored or reestablished by distance and direction. Show the discrepancy on the plan view drawing under (d), above. Show the distances between the corner as previously restored or reestablished and (1) the corner as restored or reestablished, and (2) to at least 2 of the witness monuments shown on the drawing in (d), above.

None.

- (f) Was the corner restored through acceptance of (1) an obliterated evidence location, or, (2) a found perpetuated location?


(2) a found perpetuated location.

- (g) Was the corner reestablished through lost corner proportionate methods? If so, show the method, including the directions and distances to other public land survey corners used as evidence or used for proportioning in determining the corner location?

No.

- (1) I, Alan D. Harrison (type or print name) certify that the corner location shown on this record was determined by me or under my direction and control and that this U.S. Public Land Survey Monument Record is correct and complete to the best of my knowledge and belief.

Alan D. Harrison 3/1/90  
Signature Date

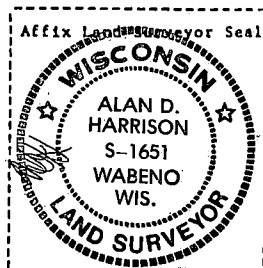

CERTIFICATE READY FOR FILING:

Valer B. Itag  
District Ranger

CERTIFIED LAND CORNER RESTORATION

State of Wisconsin

County of Forest

ss.

I William B. Cochrane, do hereby certify that on the 26 day of July, 19 77, I found evidence of the Northwest Section corner of Section 17 Township 36 North Range 16 East, Fourth Principal Meridian, as described hereon; and that from this evidence I established a new monument and accessories as described hereon to perpetuate the original location of this corner:

Description of original monument and accessories and subsequent restorations:

Surveyed in 1858 by James McBride  
North between Sections 17 and 18. 80.0 chains set post corner to  
Sections 7, 8, 17 and 18.  
Spruce, 5, N30W, 7 lks.  
Spruce, 5, N88E, 64 lks.  
Spruce, 5, S29E, 34 lks.  
Spruce, 5, S52W, 17 lks.  
29.0 chs. South leave swamp NE & SW  
16.0 chs. East leave swamp NE & SW

Description of corner evidence found:


1 1/2" iron pipe 5 feet long, along side and north of old post point.  
From post point: Spruce stump bears, N88E, 64 lks.  
Spruce stump bears, S29E, 32 lks.  
Spruce stump bears, S52W, 17 lks.  
29 chs. South leave swamp  
16.5 chs. East leave swamp

Description of monument and accessories I established to perpetuate the location of this corner:

I replaced the post point with a 2 inch inside diameter galvanized pipe,  
6 feet long, 3 feet filled with concrete, with a brass cap stamped:  
T36N R16E, S7, S8, S17, S18, 1977, S-1107  
From which the following bear:  
Black Spruce, 5", N67°E, 15.83 feet  
Black Spruce, 4", S17°E, 22.66 feet  
Black Spruce, 5", S56°W, 26.21 feet  
Black Spruce 3", N52°W, 14.88 feet  
Steel sign post, North, 0.30 feet



43616070000

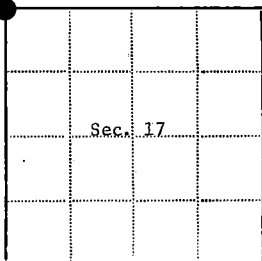

● - Corner monument restored

□ -

Resident witnesses.....

Dated at Laona Wisconsin, this 8 day of August 19 77.

Signature William B. Cochrane Title Survey Technician  
(County Surveyor, Registered Land Surveyor, or other duly authorized official)

Surveyors Registration No. S-1107 DOCUMENT NUMBER 113299

Office of Register of Deeds County of Forest

I hereby certify that the within instrument was filed in this office for record on the 13th day of February 19 78, and was filed in Book No. .... Page No. .... of County Records.

Signature Eugene Stutzman Title Register of Deeds

Township 36 North, Range 16 East, Section 17, Index No. J-5, Page No. ....

## CERTIFIED LAND CORNER RESTORATION

State of Wisconsin

County of Forest

} ss.

I Jean F. Resvick, do hereby certify that on the 24 day of August, 1976, I found evidence of the North quarter corner of Section 17 Township 36 North Range 16 East, Fourth Principal Meridian, as described hereon; and that from this evidence I established a new monument and accessories as described hereon to perpetuate the original location of this corner:

## Description of original monument and accessories and subsequent restorations:

Surveyed in 1858 by James McBride

40.00 chains west corrected between Sections 8 and 17, set post.

Elm 6, S26W, 15 lks.

Aspen 14, N15E, 14 lks.

## Description of corner evidence found:

Iron pipe driven into old post

40 chains East to section corner

40 chains west to section corner

## Description of monument and accessories I established to perpetuate the location of this corner:

Replaced iron pipe with 2 inch inside diameter galvanized iron pipe,  
filled with concrete, with brass cap stamped:

T36N, R16E, S8, 1/4, S17, 1976, S-802

Blazed and scribed the following new bearing trees


Maple 10, N65E, 16.33 ft.

Maple 9, S37E, 34.84 ft.

Maple 8, S39W, 14.30 ft.

Set steel sign post 6 inches NE of monument

43616080020

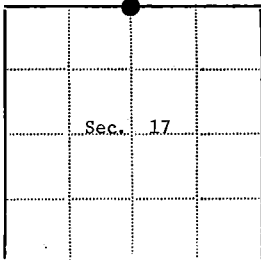

● - Corner monument restored

□ -

Resident witnesses.....

Dated at Rhineland Wisconsin, this 9 day of August 1977..

Signature Jean F. Resvick Title Land Surveyor  
(County Surveyor, Registered Land Surveyor, or other duly authorized official)

Surveyors Registration No. S-802 DOCUMENT NUMBER 113300

Office of Register of Deeds County of Forest

I hereby certify that the within instrument was filed in this office for record on the 13th day of February 1978, and was filed in Book No.        Page No.        of County Records.

Signature Eugene Stutzman Title Register of Deeds

Township 36 North, Range 16 East, Section 17, Index No. J-7, Page No.

## CERTIFIED LAND CORNER RESTORATION

State of Wisconsin

County of Forest

ss.

I William B. Cochrane, do hereby certify that on the 24 day of August, 19 76, I found evidence of the Northeast Section corner of Section 17 Township 36 North Range 16 East, Fourth Principal Meridian, as described hereon; and that from this evidence I established a new monument and accessories as described hereon to perpetuate the original location of this corner:

## Description of original monument and accessories and subsequent restorations:


Surveyed in 1858 by James McBride  
North between Sections 16 and 17  
80.00 chains set post corner to Sections 8,9,16 and 17  
Lind, 8", N70°W, 4 lks.  
Birch, 10", N22°E, 26 lks.  
Sugar, 8", S85°E, 10 lks.  
Birch, 8", S6°W, 18 lks.

## Description of corner evidence found:


Iron pipe in a mound of rock. Pipe driven in an old post point. From the iron pipe a yellow birch, fallen, bears N22°E, 26 lks. and a sugar, 24", bears S85°E, 10 lks.

## Description of monument and accessories I established to perpetuate the location of this corner:

I replaced the iron pipe with a 2 inch inside diameter galvanized pipe, 3 feet long, filled with concrete, with a brass cap stamped: T36N, R16E, S8, S9, S16, S17, 1977 S-1107. From which the following bear:  
Maple, 12", N6°E, 43.49 feet  
Maple, 24", original B.T., S85°E, 5.99 feet  
Maple 12", S45°W, 37.11 feet  
Y. Birch, 12", N60°W, 35.80 feet  
Set a steel sign post SW, 0.50 feet

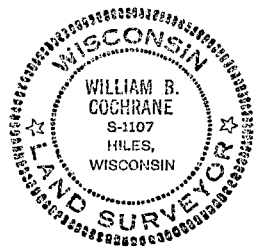

4361680000

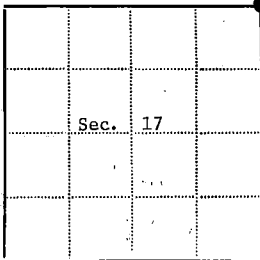

● - Corner monument restored

□ -

Resident witnesses.....

Dated at Laona Wisconsin, this 19 day of July 19 77.Signature William B. Cochrane Title Survey Technician  
(County Surveyor, Registered Land Surveyor, or other duly authorized official)Surveyors Registration No. S-1107 DOCUMENT NUMBER **113301**Office of Register of Deeds County of ForestI hereby certify that the within instrument was filed in this office for record on the 13th day of February 19 78, and was filed in Book No.        Page No.        of County Records.Signature Eugene H. Hiles Title Register of DeedsTownship 36 North, Range 16 East, Section 17, Index No. J-9, Page No. 6


## U. S. PUBLIC LAND SURVEY MONUMENT RECORD

## INSTRUCTIONS:

This record shall show the location of the corner and shall include all of the following nine elements (a through i).

- (a) Identify the corner by reference to the U.S. public land survey system.  
 O = Corner monument restored.

Section corner to sections 9, 10, 15, and 16;  
 T.36N., R.16E., Forest County, Wisconsin.

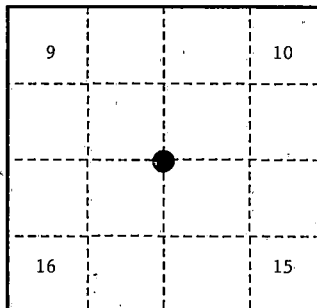

- (b) Describe any record evidence, monument evidence, occupational evidence, testimonial evidence or any other material evidence you considered, and whether the monument was found or placed.

In 1858, James McBride set a wood post with the following B.T.'s: Tamarack, 12", N.69°W., 39 links (25.74 feet); Tamarack, 14", N.47°E., 25 links (16.50 feet); Tamarack, 12", S.79°E., 5 links (3.30 feet); Tamarack, 8", S.57°E., 19 links (12.54 feet).

In 1928, Goodman Company found a wood post and set a 2" x 6" pipe.

In 1934, John Laird (CCC) found a scribed wood post and an iron pipe. B.T.'s: Spruce, 10", Southwest, 18 feet, Spruce, 9", Northeast, 5 feet; and placed a location poster on Balsam, 4", South, 4 feet from corner.

In 1990, Alan D. Harrison (RLS) found a 4" x 4" wood post and 2" iron pipe, the southwest Spruce B.T. stump, new southwest B.T. had a D.B.H. and B.T, blaze approximately 40 years old.

- (c) In the plan view drawing below, provide reference ties to at least 4 witness monuments, or, if the location is within a municipality, to at least 2 witness monuments. (witness monuments shall be made of concrete, natural stone, iron or other equally durable material.)


- (d) Show a plan view drawing depicting the relevant monuments and reference ties which is sufficient in detail to enable accurate relocation of the corner monument if the corner monument is disturbed. Indicate north.

- 2 1/2" x 60" aluminum monument with tablet stamped to identify the corner.
- Cedar, 7", N.73°E., 31.25 feet.
- Cedar, 7", S.38°E., 18.74 feet.
- Cedar, 7", S.07°W., 24.54 feet.
- Black Spruce, 7", N.55°W., 30.07 feet.
- Steel Sign Post, 6", Northwest, 0.75 feet.

REGISTER'S OFFICE  
 Forest County, Wis.

Received for record this 19th day  
 of December A.D., 1990 at  
 8:45 o'clock P.M. and recorded  
 in Vol. Case Restorations  
 page 13

Register of Deeds

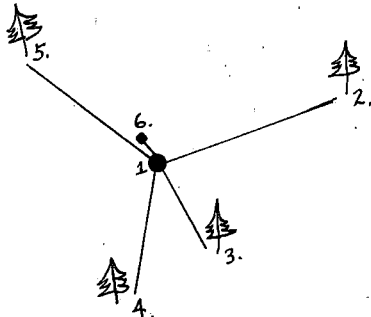

43616090000

(e) Describe any material discrepancy between the location of the corner as restored or reestablished and the location of that corner as previously restored or reestablished by distance and direction. Show the discrepancy on the plan view drawing under (d), above. Show the distances between the corner as previously restored or reestablished and (1) the corner as restored or reestablished, and (2) to at least 2 of the witness monuments shown on the drawing in (d), above.

None.

(f) Was the corner restored through acceptance of (1) an obliterated evidence location, or, (2) a found perpetuated location?

W(2) a found perpetuated location

(g & h) Was the corner reestablished through lost corner proportionate methods? If so, show the method, including the directions and distances to other public land survey corners used as evidence or used for proportioning in determining the corner location?

No.

(1) I, Alan D. Harrison

(type or print name) certify that the corner location shown on this record was determined by me or under my direction and control and that this U.S. Public Land Survey Monument Record is correct and complete to the best of my knowledge and belief.

Alan D. Harrison

Signature


11/30/90

Date

CERTIFICATE READY FOR FILING:

Dale Stange

District Ranger

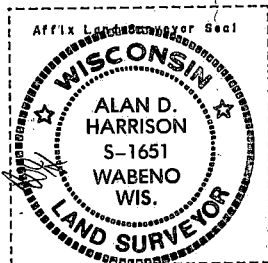

## U. S. PUBLIC LAND SURVEY MONUMENT RECORD

## INSTRUCTIONS:

This record shall show the location of the corner and shall include all of the following nine elements (a through i).


- (a) Identify the corner by reference to the U.S. public land survey system.  
● = Corner monument restored.

Quarter corner to sections 10 and 15,  
T.36N., R.16E., Forest County, Wisconsin,

REGISTER'S OFFICE  
Forest County, Wis.

Received for record this 20th day  
of November A.D., 19 90 at  
1:00 o'clock P.M. and recorded  
in Vol. Casey Testations  
page 1-15

Paul Hachenheimer  
Register of Deeds

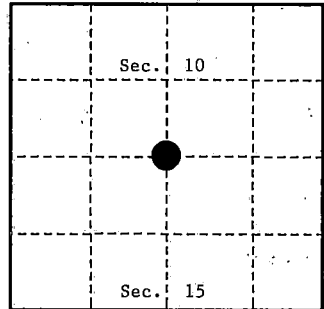

- (b) Describe any record evidence, monument evidence, occupational evidence, testimonial evidence or any other material evidence you considered, and whether the monument was found or placed.

In 1858, James McBride set a wood post with the following B.T.'s: Sugar, 12", S.14°W., 35 links (23.10 feet); Sugar, 14", S.29°E., 35 links (23.10 feet).


In 1927, Goodman Company found an old 2½" wood post and both B.T.'s at 34 links, set 3½" wood post and flue pipe 19" above the ground by perpetuated method.

In 1990, Alan D. Harrison (RLS) found flue pipe with post hole. Replaced Iron pipe with monument as best evidence of corner location.

- (c) In the plan view drawing below, provide reference ties to at least 4 witness monuments, or, if the location is within a municipality, to at least 2 witness monuments. (Witness monuments shall be made of concrete, natural stone, iron or other equally durable material.)

- (d) Show a plan view drawing depicting the relevant monuments and reference ties which is sufficient in detail to enable accurate relocation of the corner monument if the corner monument is disturbed. Indicate north.

- 2½" x 36" aluminum monument with tablet stamped to identify the corner.
- Sugar, 6", N.54°E., 28.99 feet.
- Hemlock, 11", S.45°E., 39.11 feet.
- Hemlock, 7", N.61°W., 14.12 feet.
- Steel Sign Post, North, 1.35 feet.

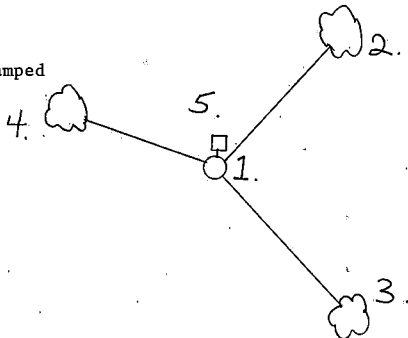

(e) Describe any material discrepancy between the location of the corner as restored or reestablished and the location of that corner as previously restored or reestablished by distance and direction. Show the discrepancy on the plan view drawing under (d), above. Show the distances between the corner as previously restored or reestablished and (1) the corner as restored or reestablished, and (2) to at least 2 of the witness monuments shown on the drawing in (d), above.

None.

(f) Was the corner restored through acceptance of (1) an obliterated evidence location, or, (2) a found perpetuated location?

(2) a found perpetuated location

(g & h) Was the corner reestablished through lost corner proportionate methods? If so, show the method, including the directions and distances to other public land survey corners used as evidence or used for proportioning in determining the corner location?

No.

(1) I, Alan D. Harrison

(type or print name) certify that the corner location shown on this record was determined by me or under my direction and control and that this U.S. Public Land Survey Monument Record is correct and complete to the best of my knowledge and belief.

Signature

Date

CERTIFICATE READY FOR FILING:

District Ranger



## CERTIFIED LAND CORNER RESTORATION

State of Wisconsin

County of Forest

ss.

I Milo E. Stefan, do hereby certify that on the 10th day of September, 1981, I found evidence of the Northwest corner of Section 14 Township 36 North, Range 16 East, Fourth Principal Meridian, as described hereon; and that from this evidence I established a new monument and accessories as described hereon to perpetuate the original location of this corner:

## Description of original monument and accessories and subsequent restorations:

Surveyed in 1858 by James McBride  
80.00 chains, set wood post  
Sugar, 10", N40W, 24 lks.  
Sugar, 10", N28E, 31 lks.  
Sugar, 12", S62E, 29 lks.  
Sugar, 10", S30W, 39 lks.

Surveyed in 1927 by Goodman Lumber Co.  
From NW BT, set flue pipe 34" long alongside  
3" Elm post.

## Description of corner evidence found:

Found 34" flue pipe.

Found very rotten Sugar Maple stump. Remains N40W, 16', as called by Goodman.

## Description of monument and accessories I established to perpetuate the location of this corner:

Replaced flue pipe with a 2" x 30" aluminum pipe in a mound of stone with tablet stamped as follows:

T36N, R16E, S10, S11, S15, S14, 1981, RLS-1558

From which the following bear:

Sugar, 5", N40E, 2.45 feet

Sugar, 4", S48E, 16.51 feet

Sugar, 5", S3W, 22.56 feet

Sugar, 5", N55W, 10.45 feet

Set a steel sign post SW, 3.6 feet

DOCUMENT NO.

124222

43616100000



Resident witnesses.....

Dated at Rhinelander Wisconsin, this 14th day of September, 1982.


Signature Milo E. Stefan Title Land Surveyor  
(County Surveyor, Registered Land Surveyor, or other duly authorized official)

Surveyors Registration No. RLS-1558Office of Register of Deeds County of Forest

I hereby certify that the within instrument was filed in this office for record on the 14th day of September, 1983, and was filed in Book No.          Page No.          of County Records.

Signature Eugene J. Stracy Title Register of Deeds

Township 36 North, Range 16 East, Section 14, Index No. J-17, Page No. 77

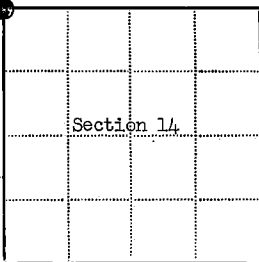

● - Corner monument restored

□ -

## U. S. PUBLIC LAND SURVEY MONUMENT RECORD

## INSTRUCTIONS:


This record shall show the location of the corner and shall include all of the following nine elements (a through i).

- (a) Identify the corner by reference to the U.S. public land survey system.  
O = Corner monument restored.

Quarter Corner Common to Sections 11 and 14,  
T36N-R16E

Index Number J-19 (T36N-R16E)

Forest County, Wisconsin

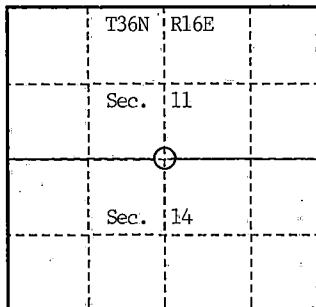

- (b) Describe any record evidence, monument evidence, occupational evidence, testimonial evidence or any other material evidence you considered, and whether the monument was found or placed.

1858 - Original post set by James McBride, witnessed by 20 W. Birch North 20 lks.;  
16 Hemlock S24E 10 lks.


1928 - Records of Goodman Lumber Company note burned post laying on ground. No mention of OBT recovery or restoration of corner.

1991 - Coleman Engineering Company established traverse survey between SW and SE corners of Section 11 to locate midpoint search area; measured mile is 59.2 feet longer than record 80.00 chains. Very few signs of any stump remains within 100' of this location. Approximate field corner (South and East edges of spruce tree cover bears S24°E approximately 83 feet from calculated corner position. No other evidence of lines or occupations is apparent. Corner was assumed to be lost and was restored by the proportionate method.

- (c) In the plan view drawing below, provide reference ties to at least 4 witness monuments, or, if the location is within a municipality, to at least 2 witness monuments. (Witness monuments shall be made of concrete, natural stone, iron or other equally durable material.)

- (d) Show a plan view drawing depicting the relevant monuments and reference ties which is sufficient in detail to enable accurate relocation of the corner monument if the corner monument is disturbed. Indicate north.

1. 2½" x 36" Aluminum monument with position stamped on cap.
2. Basswood 10" S41°E 17.54 feet.
3. Sugar 8" S31°W 12.10 feet.
4. Sugar 10" N89°W 18.50 feet.
5. Ash 12" N06°W 9.62 feet.
6. Steel sign post North 1.35 feet.

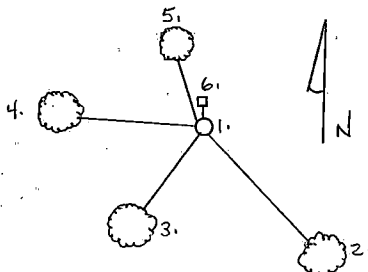

REGISTER'S OFFICE  
Forest County, Wis.

Received for record this 24 day  
of October, A.D. 1991 at  
2:00 o'clock P.M. and recorded  
in Vol. 19 Page 12  
James H. Hennen  
Register of Deeds

43616118020

J-19

J-19

- (e) Describe any material discrepancy between the location of the corner as restored or reestablished and the location of that corner as previously restored or reestablished by distance and direction. Show the discrepancy on the plan view drawing under (d), above. Show the distances between the corner as previously restored or reestablished and (1) the corner as restored or reestablished, and (2) to at least 2 of the witness monuments shown on the drawing in (d), above.


No evidence of prior corner recovery or restoration.

- (f) Was the corner restored through acceptance of (1) an obliterated evidence location, or, (2) a found perpetuated location?

Neither.

- (g & h) Was the corner reestablished through lost corner proportionate methods? If so, show the method, including the directions and distances to other public land survey corners used as evidence or used for proportioning in determining the corner location?

Corner was restored at the midpoint of a straight line between the Southwest and Southeast corners of Section 11, T36N-R16E.

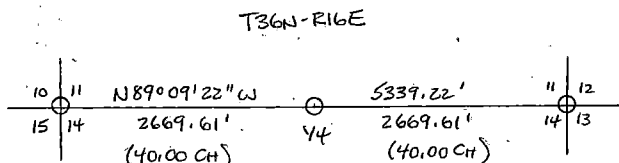

Charles F. Clark, RLS 1767  
COLEMAN ENGINEERING COMPANY

(1) I,

(type or print name) certify that the corner location shown on this record was determined by me or under my direction and control and that this U.S. Public Land Survey Monument Record is correct and complete to the best of my knowledge and belief.

*Charles F. Clark*


Signature

August 22, 1991

Date

CERTIFICATE READY FOR FILING:

*Darrell E. Richards*  
Acting District Ranger

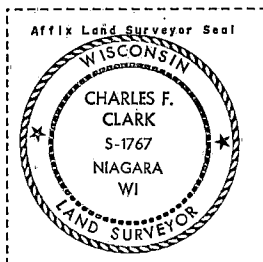

## CERTIFIED LAND CORNER RESTORATION

State of Wisconsin

County of Forest

ss.

I, Jean F. Resvick, do hereby certify that on the 19th day of July, 1968, I found evidence of the Southwest Section corner of Section 12 Township 36 North, Range 16 East, Fourth Principal Meridian, as described hereon; and that from this evidence I established a new monument and accessories as described hereon to perpetuate the original location of this corner:

## Description of original monument and accessories and subsequent restorations:

Surveyed in 1858 by James McBride  
80.00 chains North between Sections 13 and 14  
Set wood post from which:

Cedar, 12 in., bears N. 27° W., 12 Lks.  
Cedar, 16 in., bears N. 58° E., 18 Lks.  
Hemlock, 24 in., bears S. 77° E., 25 Lks.  
Cedar, 14 in., S. 44° W., 26 Lks.

6.0 chs. South enter swamp bears NW & SE  
10.5 chs. South, stream, 75 Lks. wide,  
runs SE  
8.25 chs. North, stream, 100 Lks. wide,  
runs SW  
4.20 chs. West, stream, 2.0 chs. wide,  
runs South


## Description of corner evidence found:

Iron pipe driven in the ground from which:  
Stump hole bears N. 27° W., 7.9 feet  
Stump hole bears N. 58° E., 11.88 feet  
Stump hole bears S. 77° E., 16.50 feet  
Stump hole bears S. 44° W., 17.82 feet  
The natural calls agree with the recorded distances.

43616110000

## Description of monument and accessories I established to perpetuate the original location of this corner:

I replaced the iron pipe with a 2 inch inside diameter, galvanized wrought iron pipe, 5 feet long, flanged at the bottom and filled with concrete, with brass cap marked:

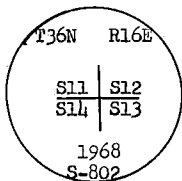

from which the following blazed and scribed new bearing trees bear:

Spruce, 4 in., bears N. 10° W., 93.25 feet or 141.29 Lks.  
Spruce, 4 in., bears S. 84° E., 56.00 feet or 84.85 Lks.  
Spruce, 4 in., bears S. 2° W., 38.20 feet or 57.88 Lks.  
Aspen, 6 in., bears N. 73° W., 49.37 feet or 74.80 Lks.  
4 x 4 cedar post bears N. 42° E., 1.70 feet or 2.58 Lks.

Resident witnesses

Dated at Rhineland Wisconsin, this 27th day of July, 1968.


Signature Jean F. Resvick Title County Surveyor  
(County Surveyor, Registered Land Surveyor, or other duly authorized official)

Surveyors Registration No. S-802Office of Register of Deeds County of Forest

I hereby certify that the within instrument was filed in this office for record on the 31st day of January, 1969, and was filed in Book No. I Page No. J-21 of County Records.

Signature Eugene Stegny Title Register of Deeds

Township 36 North, Range 16 East, Section 12, Index No. J-21, Page No. 21

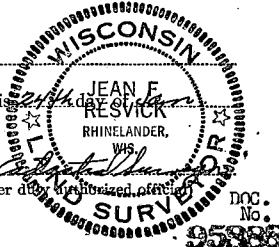

● = Corner monument restored

□ =

142947

## U. S. PUBLIC LAND SURVEY MONUMENT RECORD


INSTRUCTIONS: This record shall show the location of the corner and shall include all of the following nine elements (a through i).

- (a) Identify the corner by reference to the U.S. public land survey system.  
O = Corner monument restored.

Quarter Corner Common to Sections 12 and 13, T36N-R16E

Index Number J-23 (T36N-R16E)

Forest County, Wisconsin

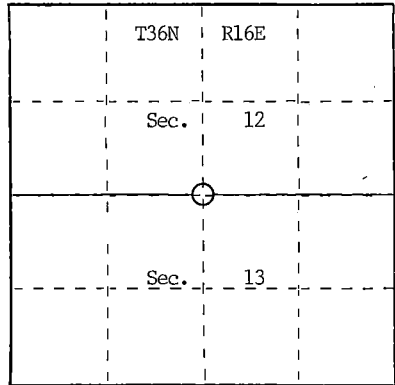


- (b) Describe any record evidence, monument evidence, occupational evidence, testimonial evidence or any other material evidence you considered, and whether the monument was found or placed.

- 1858 - Original post set by James McBride, witnessed by 12 Fir N42E 20 lks.; 12 Fir S45E 13 lks.  
1917 - Records of Goodman Lumber Co. indicate corner restored with 5" cedar post by J. Jenkins; no record of original evidence recovered or NBTs marked. Goodman further restored this corner in 1927 with a flue pipe in a pile of stones.  
1982 - Pipe was recovered by M. Stefan, S-1558, per Forest Service records. Corner was restored with 2" x 36" aluminum monument witnessed by: W.Spruce 12" S79°E 41.03'; W.Spruce 10" S09°E 64.30'; W.Spruce 18" S85°W 68.19'; Steel sign post East 1.4'.  
1991 - Coleman Engineering Company recovered aluminum monument and references by March M. Stefan and marked one additional NBT

- (c) In the plan view drawing below, provide reference ties to at least 4 witness monuments, or, if the location is within a municipality, to at least 2 witness monuments. (Witness monuments shall be made of concrete, natural stone, iron or other equally durable material.)  
Describe witness monuments.

- (d) Show a plan view drawing depicting the relevant monuments and reference ties which is sufficient in detail to enable accurate relocation of the corner monument if the corner monument is disturbed. Indicate north.

1. 2" x 36" Aluminum monument with position stamped on cap.
2. W. Spruce 12" S79°E 41.03 feet.
3. W. Spruce 10" S09°E 64.30 feet.
4. W. Spruce 18" S85°W 68.19 feet.
5. Aspen 8" N50°E 10.77 feet.
6. Steel sign post East 1.4 feet.

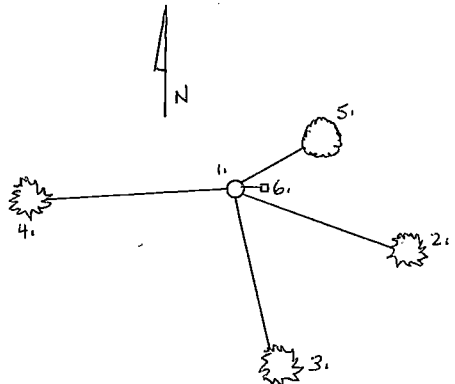

REGISTER'S OFFICE {  
Forest County, Wis.

Received for record this 8th day  
of October, A.D., 1997, at  
2:00 o'clock P.M. and recorded  
in Vol. 1000, Page 1000  
J-23

Register of Deeds

43616120020

T-23

J-23

- (e) Describe any material discrepancy between the location of the corner as restored or reestablished and the location of that corner as previously restored or reestablished by distance and direction. Show the discrepancy on the plan view drawing under (d), above. Show the distances between the corner as previously restored or reestablished and (1) the corner as restored or reestablished; and (2) to at least 2 of the witness monuments shown on the drawing in (d), above.

Accepted recovered monument as true corner position.

- (f) Was the corner restored through acceptance of (1) an obliterated evidence location, or, (2) a found perpetuated location?

(2) Found perpetuated location.

- (g&h) Was the corner reestablished through lost corner proportionate methods? If so, show the method, including the directions and distances to other public land survey corners used as evidence or used for proportioning in determining the corner location?

No.

- (i) I, Charles F. Clark, RLS 1767  
COLEMAN ENGINEERING COMPANY  
(type or print name) certify that the corner location shown on this record was determined by me or under my direction and control and that this U.S. Public Land Survey Monument Record is correct and complete to the best of my knowledge and belief.

Signature


Date

August 22, 1991

CERTIFICATE READY FOR FILING:

Acting District Ranger

Affix Land Surveyor Seal

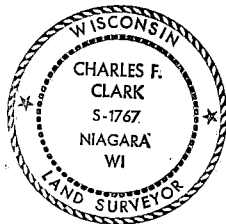

142948

## U. S. PUBLIC LAND SURVEY MONUMENT RECORD

INSTRUCTIONS: This record shall show the location of the corner and shall include all of the following nine elements (a through i).

- (a) Identify the corner by reference to the U.S. public land survey system.  
 O = Corner monument restored.

Corner Common to Sections 12 and 13,  
 T36N-R16E, and Sections 7 and 18, T36N-R17E

Index Number J-25 (T36N-R16E)

Forest County, Wisconsin

Forest County		Marinette County	
T36N	R16E	T36N	R17E
12		7	
13		18	

- (b) Describe any record evidence, monument evidence, occupational evidence, testimonial evidence or any other material evidence you considered, and whether the monument was found or placed.

1857 - Original post by Artemas Curtis, witnessed by 20 Hemlock S58W 25 lks.; 18 Hemlock N32W 17 lks.; 10 Hemlock N33E 89 lks.; 22 Y. Birch S69E 51 lks.  
 1937 - Corner restored with 4" iron pipe and Marinette County Survey brass cap by Gould and Hammes from original evidence.  
 1968 - Corner recovered by J. Resvick, S-802, who marked NBTs: R. Pine 11" S82°E 8.92'; R. Pine 8" S17°W 16.60'; R. Pine 10" N82°W 35.65'. (Forest County Document #96744)  
 1991 - Coleman Engineering Company recovered monument and NBTs of record; established additional corner references.

- (c) In the plan view drawing below, provide reference ties to at least 4 witness monuments, or, if the location is within a municipality, to at least 2 witness monuments. (Witness monuments shall be made of concrete, natural stone, iron, or other equally durable material.)  
 Describe witness monuments.


- (d) Show a plan view drawing depicting the relevant monuments and reference ties which is sufficient in detail to enable accurate relocation of the corner monument if the corner monument is disturbed. Indicate north.

- 4" Iron pipe with Marinette County Survey brass cap stamped with corner position.
- Red Pine 13" N81°W 35.72 feet.
- Red Pine 13" S84°E 8.85 feet.
- Red Pine 14" S18°W 16.62 feet.
- Red Maple 5" N05°E 17.83 feet.
- Steel sign post Northwest 1.84 feet.

REGISTER'S OFFICE  
 Forest County, Wis.

Received for record this 24 day  
 of October, A.D., 1997 at  
2:00 o'clock P.M. and recorded  
 in "of Corner Restoration  
 page 1-25

Register of Deeds

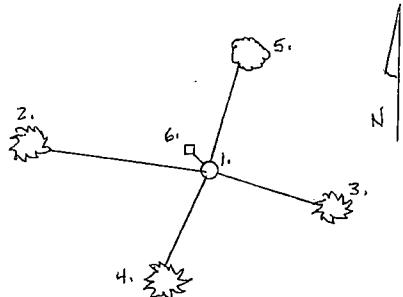

43616120000

J-25

6-25

- (e) Describe any material discrepancy between the location of the corner as restored or reestablished and the location of that corner as previously restored or reestablished by distance and direction. Show the discrepancy on the plan view drawing under (d), above. Show the distances between the corner as previously restored or reestablished and (1) the corner as restored or reestablished, and (2) to at least 2 of the witness monuments shown on the drawing in (d), above.

Accepted found monument as true corner position.

- (f) Was the corner restored through acceptance of (1) an obliterated evidence location, or, (2) a found perpetuated location?

(2) Found perpetuated location.

- (g&h) Was the corner reestablished through lost corner proportionate methods? If so, show the method, including the directions and distances to other public land survey corners used as evidence or used for proportioning in determining the corner location?

No.

- (i) I, Charles F. Clark, Rls 1767  
COLEMAN ENGINEERING COMPANY  
(type or print name) certify that the corner location shown on this record was determined by me or under my direction and control and that this U.S. Public Land Survey Monument Record is correct and complete to the best of my knowledge and belief.

Signature


August 23, 1991

Date

CERTIFICATE READY FOR FILING:

Darrell E. Richard  
Acting District Ranger

Affix Land Surveyor Seal

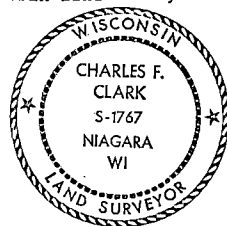

## CERTIFIED LAND CORNER RESTORATION

State of Wisconsin

County of Forest

} ss.

I, Jean F. Resvick, do hereby certify that on the 21th day of September, 1968, I found evidence of the Northeast Section corner of Section 13 Township 36 North, Range 16 East, Fourth Principal Meridian, as described hereon; and that from this evidence I established a new monument and accessories as described hereon to perpetuate the ~~original~~ location of this corner:

## Description of original monument and accessories and subsequent restorations:

Survey in 1857 by Artemas Curtis. 80 chains north between Section 13 and 18, set a post.

A Hemlock, 20", S 58° W, 25 LKs.

A Hemlock 10", N 33° E, 89 LKs.

A Hemlock 18", N 32° W, 17 LKs.

A Yellow Birch 22", S 69° E, 51 LKs.

Marinette County Survey in 1936 and 1937 by F.P. Gould and B.F. Hammes.

Set 4 inch. diam., iron pipe with Marinette County brass cap.

## Description of corner evidence found:

No original evidence found.

Marinette County Survey 4 inch. diam. pipe with brass cap marked:

Marinette County Survey, T 36 N, R 16 E, 12, 13, T 36 N, R 17 E, 7, 18.

Description of ~~monument and~~ accessories I established to perpetuate the ~~original~~ location of this corner:

I blazed and scribed the following new bearing trees for the Marinette County Survey.

A Red Pine, 11", S 82° E, 8.92 ft. or 13.515 LKs.

A Red Pine, 8", S 17° W, 16.60 ft. or 25.151 LKs.

A Red Pine, 10", N 82° W, 35.65 ft. or 54.015 LKs.



Resident witnesses.....

Dated at Rhinelanders, Wisconsin, this 18th day of February, 1969.Signature Jean F. Resvick Title Cadastral Surveyor  
(County Surveyor, Registered Land Surveyor, or other duly authorized official)Surveyors Registration No. S-802DOCUMENT NUMBER 36944Office of Register of Deeds County of ForestI hereby certify that the within instrument was filed in this office for record on the 26th day of August, 1969, and was filed in Book No. I Page No.        of County Records. 8:30 AM.Signature Eugene Stetson Title Register of DeedsTownship 36 North, Range 16 East, Section 13, Index No. J-25, Page No.       

⊗ = Corner monument restored

□ =

J  
25

## CERTIFIED LAND CORNER RESTORATION

State of Wisconsin

County of Forest

ss.

I, Jean F. Resvick, do hereby certify that on the 24th day of September, 19 68, I found evidence of the North one sixteenth corner of Sections 13 and 18 Township 36 North, Range 16 and 17 East, Fourth Principal Meridian, as described hereon; and that from this evidence I established a new monument and accessories as described hereon to perpetuate the original location of this corner:

## Description of original monument and accessories and subsequent restorations:

Surveyed by F.P. Gould and B.F. Hammas Deputy County Surveyors October 1936 and recorded in Marinette County 59.88 chains north between sections 13 and 18  
Set 4 inch squared cedar post for N 1/16 corner.


## Description of corner evidence found:

4 inch squared cedar post, scribed, rotted off.  
Point of post found.

## Description of monument and accessories I established to perpetuate the original location of this corner:

Replaced point of post with a 2 inch inside diameter, galvanized, wrought iron pipe, 5 ft. long, filled with concrete, flanged on bottom with brass cap marked:

From which the following blazed and scribed new bearing tapes bear.  
Basswood 14, N55W, 34.77 ft.  
Elm 6, N75E, 3.09 ft.

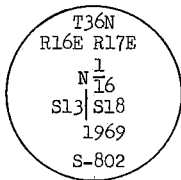

43616133000



Resident witnesses.....

Dated at RhinelandWisconsin, this 3rd day of Feb.19 70Signature Jean F. ResvickTitle Cadastral Surveyor

(County Surveyor, Registered Land Surveyor, or other duly authorized official)

Surveyors Registration No. S-802DOCUMENT No. 98050Office of Register of DeedsCounty of Forest

I hereby certify that the within instrument was filed in this office for record on the 22nd day of May, 19 70, and was filed in Book No. \_\_\_\_\_ Page No. K-25 of County Records.

Signature Eugene Staszynski Title Register of DeedsTownship 36 NorthRange 16 EastSection 13Index No. K-25, Page No. \_\_\_\_\_

K 25

# CERTIFIED LAND CORNER RESTORATION

State of Wisconsin

County of Forest

SS.

I Jean F. Resvick, do hereby certify that on the 11 day of March, 1976, I found evidence of the East quarter corner of Section 18 Township 36 North Range 16 East, Fourth Principal Meridian, as described hereon; and that from this evidence I established a new monument and accessories as described hereon to perpetuate the original location of this corner:

Description of original monument and accessories and subsequent restorations:

Surveyed by James McBride in 1858  
40 chains north between Sections 17 and 18  
Set post  
Tamarack 6, N73E, 69 lks.  
Tamarack 6, S50W, 36 lks.


Description of corner evidence found:

6x6 scribed Tamarack post 7 ft. long  
Tamarack snag 6" when scribed, S40W, 36 lks., scribing visible.  
Tamarack stump, N73E, 69 lks. Scribe over growth of bearing tree.

Description of monument and accessories I established to perpetuate the location of this corner:

Set 2 inch inside diameter, galvanized iron pipe 5 ft. long  
filled with concrete with brass cap stamped:  
T36N, R16E, 1/4, S18, S17, 1976, S-802

Blazed and scribed the following new bearing trees  
Tamarack 3, N88E, 9.77 feet  
Black Spruce 4, S14E, 9.97 feet  
Tamarack 4, N16W, 23.64 feet

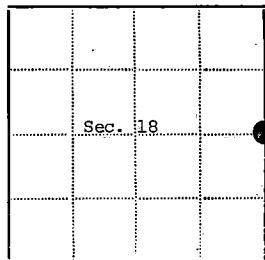

● - Corner monument restored

□ -

43616 182440

Resident witnesses.....

Dated at Rhineland Wisconsin, this 11 day of March 1976.

Signature Jean F. Resvick  
(County Surveyor, Registered Land Surveyor, or other duly authorized official)

Surveyors Registration No. S-802


Office of Register of Deeds

County of Forest

I hereby certify that the within instrument was filed in this office for record on the 2nd day of July 1976, and was filed in Book No.          Page No.          of County Records.

Signature Eugene Statyn Title Register of Deeds

Township 36 North, Range 16 East, Section 18, Index No. L-5, Page No.         

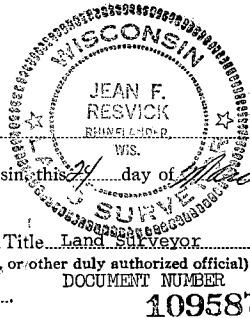

139376

## U. S. PUBLIC LAND SURVEY MONUMENT RECORD.


## INSTRUCTIONS:

This record shall show the location of the corner and shall include all of the following nine elements (a through i).

- (a) Identify the corner by reference to the U.S. public land survey system.

● = Corner monument restored.

Quarter Corner to Sections 16-17,  
T.36N., R.16E., Forest County,  
Wisconsin

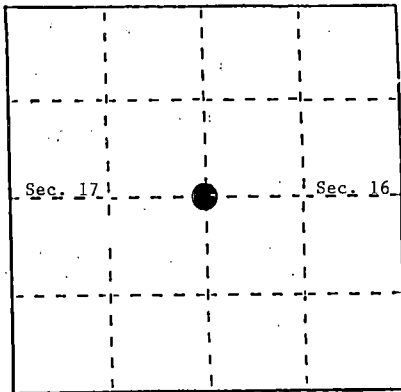

- (b) Describe any record evidence, monument evidence, occupational evidence, testimonial evidence or any other material evidence you considered, and whether the monument was found or placed.

In 1858, James McBride set a wood post with the following B.T.'s: Aspen, 12", S.84°W., 5 links (3.30 feet); Aspen, 12", N.86°E., 6 links (3.96 feet).


In 1928, Goodman Lumber Company found a 5" maple post set by Blackwell Company with no original B.T. evidence from post. Goodman set a flue pipe for the corner.

In 1988, Alan Harrison, RLS, found 2" iron pipe in a rock mound with the following B.T.'s: Birch, 18", North, 19.40 feet; Double Sugar, 14", S.32°W., 7.90 feet. Next to iron pipe found post point on ground. Accepted iron pipe as the corner.

- (c) In the plan view drawing below, provide reference ties to at least 4 witness monuments, or, if the location is within a municipality, to at least 2 witness monuments. (Witness monuments shall be made of concrete, natural stone, iron or other equally durable material.) Describe witness monuments.

- (d) Show a plan view drawing depicting the relevant monument and reference ties which is sufficient in detail to enable accurate relocation of the corner monument if the corner monument is disturbed. Indicate north.

1. 2½" x 36" aluminum monument with tablet stamped to identify the corner.
2. Yellow Birch, 18", North, 19.40 feet. (Dead)
3. Sugar, 7", S.20°E., 31.24 feet.
4. Sugar, 7", S.42°W., 56.58 feet.
5. Steel Sign Post, South, 1.35 feet.
6. Db1. Sugar 14" & 20" S.32°W. 7.78 feet.

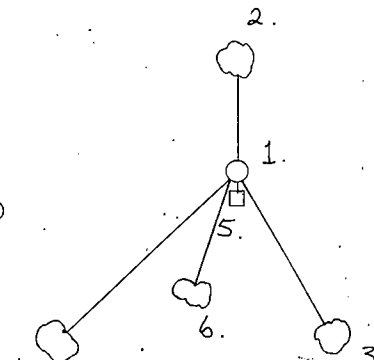

REGISTER'S OFFICE  
Forest County, Wis.

Received for record this 29<sup>th</sup> day  
of March, A.D. 1990 at  
10:00 o'clock A.M. and recorded  
in Vol. CORNER RESTORATIONS  
page 2  
*Paul H. Schenker*  
Register of Deeds

- (e) Describe any material discrepancy between the location of the corner as restored or reestablished and the location of that corner as previously restored or reestablished by distance and direction. Show the discrepancy on the plan view drawing under (d), above. Show the distances between the corner as previously restored or reestablished and (1) the corner as restored or reestablished, and (2) to at least 2 of the witness monuments shown on the drawing in (d), above.


None.

- (f) Was the corner restored through acceptance of (1) an obliterated evidence location, or, (2) a found perpetuated location?

(2) a found perpetuated corner

- (g) Was the corner reestablished through lost corner proportionate methods? If so, show the method, including the directions and distances to other public land survey corners used as evidence or used for proportioning in determining the corner location?

No.

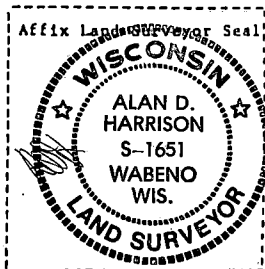

- (1) I, Alan D. Harrison  
(Type or print name) certify that the corner location shown on this record was determined by me or under my direction and control and that this U.S. Public Land Survey Monument Record is correct and complete to the best of my knowledge and belief.

Alan D. Harrison 3/1/90  
Signature Date

CERTIFICATE READY FOR FILING:

Dale B. Stoege  
District Ranger

DOCUMENT NUMBER 133449

## U. S. PUBLIC LAND SURVEY MONUMENT RECORD

INSTRUCTIONS: This record shall show the location of the corner and shall include all of the following nine elements (a through i).


- (a) Identify the corner by reference to the U.S. public land survey system.

O = Corner monument restored.

Quarter Corner to Sections 15 and 16, T.36N., R.16E., Forest County, Wisconsin.

REGISTER'S OFFICE  
Forest County, Wis.  
received for record this 10<sup>th</sup> day  
August A.D., 1987, at  
8:25 o'clock A.M. and recorded  
in Vol. CORNER RESTORATIONS

pg. L-13  
J. A. Schenckner  
Register of Deeds

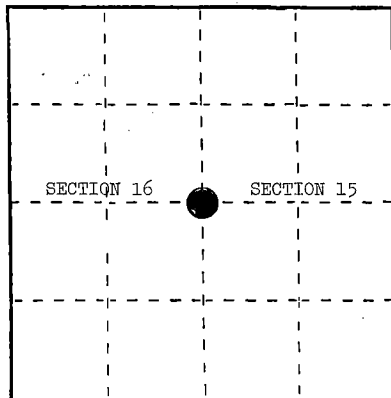

- (b) Describe any record evidence, monument evidence, occupational evidence, testimonial evidence or any other material evidence you considered, and whether the monument was found or placed.

In 1858, James McBride set wood post with the following BTs: Fir, 8", S.80°E., 22 links; Tamarack, 10", N.37°W., 28 links.

In 1928, Goodman Company set 2½" Cedar post and flue pipe 5 feet high. They found original Tamarack (dead stub), N.37°W., 18.48 feet.


In 1934, Laird and White "874" found wood stake and iron pipe. Put a location tag on an 8" Maple 9 chains south of corner.

In 1987, Alan Harrison found iron pipe and post hole. Pulled N.37°W., 18.5 feet and found original Tamarack stump and 2 local Cedar BTs.

- (c) In the plan view drawing below, provide reference ties to at least 4 witness monuments, or, if the location is within a municipality, to at least 2 witness monuments. (Witness monuments shall be made of concrete, natural stone, iron or other equally durable material.)  
Describe witness monuments.

- (d) Show a plan view drawing depicting the relevant monuments and reference ties which is sufficient in detail to enable accurate relocation of the corner monument if the corner monument is disturbed.  
Indicate north.

1. A 2½" x 36" aluminum monument stamped to identify the corner, in a mound of stone.
2. Cedar, 12", N.86°E., 23.93 feet.
3. Cedar, 12", S.54°E., 17.22 feet.
4. Spruce, 8", S.60°W., 30.17 feet.
5. Steel Sign Post, 6', Northwest, 0.71 feet.

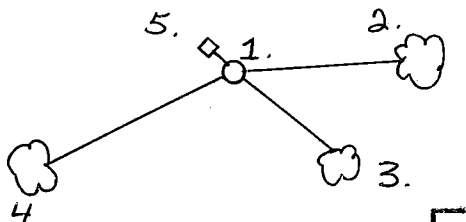

(e) Describe any material discrepancy between the location of the corner as restored or reestablished and the location of that corner as previously restored or reestablished by distance and direction. Show the discrepancy on the plan view drawing under (d), above. Show the distances between the corner as previously restored or reestablished and (1) the corner as restored or reestablished, and (2) to at least 2 of the witness monuments shown on the drawing in (d), above.


None.

(f) Was the corner restored through acceptance of (1) an obliterated evidence location, or, (2) a found perpetuated location?

(2) a found perpetuated location.

(g&h) Was the corner reestablished through lost corner proportionate methods? If so, show the method, including the directions and distances to other public land survey corners used as evidence or used for proportioning in determining the corner location?

No.

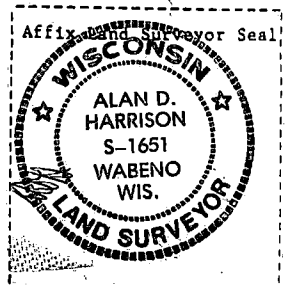

(i) I, Alan D. Harrison  
(Type or print name) certify that the corner location shown on this record was determined by me or under my direction and control and that this U.S. Public Land Survey Monument Record is correct and complete to the best of my knowledge and belief.

Alan D. Harrison  
Signature

8/5/87  
Date

## CERTIFIED LAND CORNER RESTORATION

State of Wisconsin

County of Forest

ss.

I, Jean F. Resvick, do hereby certify that on the 16th day of September, 1968, I found evidence of the West Quarter corner of Section 14 Township 36 North, Range 16 East, Fourth Principal Meridian, as described hereon; and that from this evidence I established a new monument and accessories as described hereon to perpetuate the original location of this corner:

## Description of original monument and accessories and subsequent restorations:

Surveyed in 1858 by James McBride  
40.00 chains North between Section 14 and 15  
Set wood post from which:  
Birch, 12 ins., bears S.  $49^{\circ}$  W., 4 Lks.  
Hemlock, 20 ins., bears S.  $64^{\circ}$  E., 14 Lks.

## Description of corner evidence found:

2 inch iron pipe, 4 ft. long and an old 2 x 2 squared post from which a fallen scribed yellow birch and its stump in place bears S.  $49^{\circ}$  W., 2.6 feet, a hemlock stump bears S.  $64^{\circ}$  E., 9.2 feet. A local scribed yellow birch B.T., 16 in. dia., bears N.  $56^{\circ}$  E., 21.50 feet. A local scribed hemlock B.T., 14 inches in dia., bears N.  $5^{\circ}$  W., 28.77 feet.

## Description of monument and accessories I established to perpetuate the original location of this corner:


I replaced the 2 in. iron pipe with a 2 inch inside diameter galvanized wrought iron pipe, 5 feet long, flanged at the bottom, filled with concrete, with brass cap marked:

from which the local bearing trees found bear:

Yellow Birch, 16 ins., bears N.  $56^{\circ}$  E., 21.50 feet or 32.57 Lks.  
Hemlock, 14 ins., bears N.  $5^{\circ}$  W., 28.77 feet or 43.59 Lks.  
Set old post and pipe alongside of monument. No new bearing trees made.



43616 152000

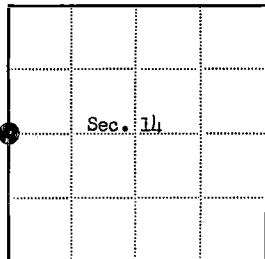

● = Corner monument restored

□ =

Resident witnesses

Dated at Rhineland, Wisconsin, this 20th day of January, 1969.

Signature Jean F. Resvick Title Cadastral Surveyor  
(County Surveyor, Registered Land Surveyor, or other duly authorized official)


Surveyors Registration No. S-802 DOCUMENT NUMBER 96942

Office of Register of Deeds, County of Forest

I hereby certify that the within instrument was filed in this office for record on the 26th day of August, 1969, and was filed in Book No. I Page No. \_\_\_\_\_ of County Records. 8:30 AM.

Signature Eugene Stutzman Title Register of Deeds

Township 36 North, Range 16 East, Section 14, Index No. L-17, Page No. \_\_\_\_\_

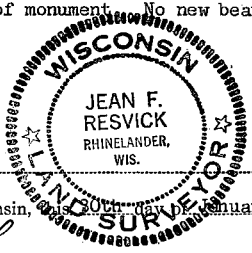

CERTIFIED LAND CORNER RESTORATION

State of Wisconsin }  
County of Forest } ss.

I Milo E. Stefan, do hereby certify that on the 29th day of July, 1982, I found evidence of the East Quarter corner of Section 14 Township 36 North Range 16 East, Fourth Principal Meridian, as described hereon; and that from this evidence I established a new monument and accessories as described hereon to perpetuate the original location of this corner:

Description of original monument and accessories and subsequent restorations:

Surveyed in 1858 by James McBride  
40.00 chains, set wood post  
Birch, 18", S41°E, 25 lks., 16.50 feet  
Fir, 8", N71°W, 16 lks., 10.56 feet

Description of corner evidence found:

No original evidence found  
Local Evidence: Found 2½ foot flue pipe, as set by Goodman Lumber Company in 1926.


Description of monument and accessories I established to perpetuate the location of this corner:

Replaced flue pipe with a 2" x 36" aluminum monument in mound of stone with tablet stamped as follows:  
T36N, R16E, S14, ¼, S13, 1982, RLS-1558  
From which the following bear:  
Black Cherry, 6", N55°E, 29.23 feet  
Black Cherry, 6", S2°W, 23.70 feet  
White Spruce, 6", N23°W, 36.11 feet  
Steel Sign Post, North, 3.90 feet

DOCUMENT NO.  
**124223**



4361614 zppp

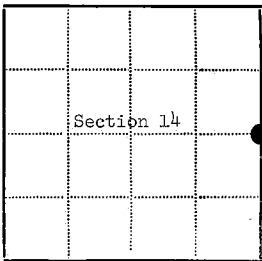

● - Corner monument restored  
□ -

Resident witnesses.....

Dated at Rhinelander Wisconsin, this.....day of 19.83.

Signature Milo E. Stefan Title Land Surveyor  
(County Surveyor, Registered Land Surveyor, or other duly authorized official)

Surveyors Registration No. RLS-1558

Office of Register of Deeds County of Forest

I hereby certify that the within instrument was filed in this office for record on the 14th day of September, 1983, and was filed in Book No. .... Page No. .... of County Records.

Signature Eugene Starynski Title Register of Deeds

Township 36 North, Range 16 East, Section 14, Index No. L-21, Page No. 6

121

CERTIFIED LAND CORNER RESTORATION

State of Wisconsin

County of Forest

ss.

I Jean F. Resvick, do hereby certify that on the 22nd day of July, 1968, I found evidence of the East Quarter corner of Section 13 Township 36 North, Range 16 East, Fourth Principal Meridian, as described hereon; and that from this evidence I established a new ~~monument~~ accessories as described hereon to perpetuate the ~~original~~ location of this corner:

Description of original monument and accessories and subsequent restorations:  
 Surveyed in 1857 by Artemas Curtis. 40 chains north set post for quarter corner between sections 13 and 18.  
 Cedar 7", bears S18°W, 26 lks. Cedar 10", bears S38°E, 35 lks.  
 1 chain south leave swamp. 3 chains north leave swamp.  
 Marinette County survey in 1936 and 1937 by F. P. Gould and B. F. Hammes.  
 Set 4 inch diameter iron post with Marinette County brass cap.  
 from which: Ash 6", bears S42°E, 58.5 lks.  
 Hemlock 7", bears N83°E, 42.6 lks.  
 1.77 chains south leave swamp  
 4.78 chains north leave swamp


Description of corner evidence found:

Marinette County brass cap on 4 inch diameter iron post.  
 Fallen Hemlock, scribing visible, bears N83°E, 28.1 ft.


Description of ~~monument and~~ accessories I established to perpetuate the ~~original~~ location of this corner:

I drove more stobs around monument to hold it in swamp.  
 Blazed and scribed the following new bearing trees:

Ash 5", bears N36°W, 34.90 ft. or 52.879 lks.  
 Spruce 9", bears N22°E, 44.13 ft. or 66.864 lks.  
 Set 4 x 4 cedar post N34°E, a distance of 1.2 feet from monument.

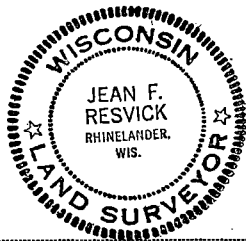

43616132094

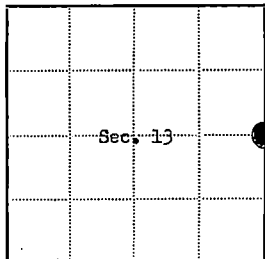

⊙ = Corner monument restored

□ =

Resident witnesses

Dated at Rhinelander, Wisconsin, this 18th day of Feb. 1969.

Signature *Jean F. Resvick* Title Cadastral Surveyor  
 (County Surveyor, Registered Land Surveyor, or other duly authorized official)

Surveyors Registration No. S-802 DOCUMENT NUMBER 96943

Office of Register of Deeds County of Forest

I hereby certify that the within instrument was filed in this office for record on the 26th day of August 1969, and was filed in Book No. I Page No. of County Records. 8:30 AM.

Signature *Eugene Stegny* Title Register of Deeds

Township 36 North, Range 16 East, Section 13, Index No. L-25, Page No.

25

DOCUMENT NUMBER

139377


U. S. PUBLIC LAND SURVEY MONUMENT RECORD.

INSTRUCTIONS: This record shall show the location of the corner and shall include all of the following nine elements (a through i).

- (a) Identify the corner by reference to the U.S. public land survey system.

● = Corner monument restored.

Section Corner to Sections 17-18-19-20,  
T.36N., R.16E., Forest County, Wisconsin.

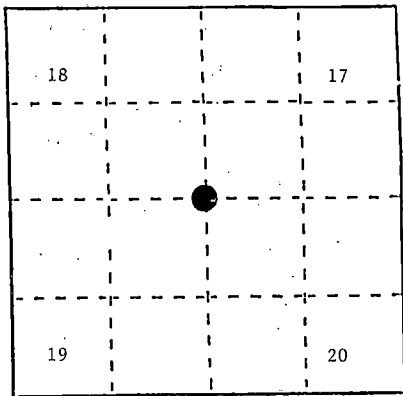

- (b) Describe any record evidence, monument evidence, occupational evidence, testimonial evidence or any other material evidence you considered, and whether the monument was found or placed.

In 1858 James McBride set a wood post with the following B.T.'s:

Elm	24"	N.21°W.	33 links	(21.78 feet)
Birch	8"	N.65°E.	39 links	(25.74 feet)
Linden	10"	S.35°E.	33 links	(21.78 feet)
Sugar	14"	S.21°W.	8 links	( 5.28 feet)

In 1917 J. Melendy found original B.T.'s with the elm being a stump. Set a 4" x 4" elm post and made the following B.T.'s:


Maple	12"	S.42½°W.	32 links	(21.12 feet)
Elm	14"	S.34½°W.	49½ links	(32.505 feet)
Elm	16"	N.29½°W.	56 ¾ links	(37.455 feet)

In 1988 Alan Harrison found original basswood evidence and Melandy's SE elm as a decayed stump, ±300 feet south found a 30" hemlock with overgrowth from blazes. The point at record direction and distance from the found bearing trees is accepted as the best available evidence of the corner location.

- (c) In the plan view drawing below, provide reference ties to at least 4 witness monuments, or, if the location is within a municipality, to at least 2 witness monuments. (Witness monuments shall be made of concrete, natural stone, iron or other equally durable material.) Describe witness monuments.

- (d) Show a plan view drawing depicting the relevant monuments and reference ties which is sufficient in detail to enable accurate relocation of the corner monument if the corner monument is disturbed. Indicate north.

1. 2½" x 36½" aluminum monument with tablet stamped to identify the corner.
2. Basswood, 10", N.89°E., 39.59 feet.
3. Sugar, 12", S.20°E., 41.60 feet.
4. Sugar, 10", S.72°W., 68.51 feet.
5. Sugar, 9", N.44°W., 93.49 feet.
6. Steel Sign Post, East, 0.79 feet.

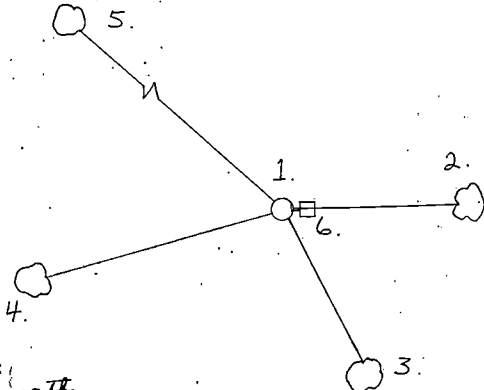

REGISTER'S OFFICE  
Forest County, Wis.

Received for record this 29th day  
of March A.D. 1990 at  
10:00 o'clock A.M. and recorded  
in Vol. CORNER RESTORATIONS  
page 5

*Paul A. Schenck*  
Register of Deeds

43616180000

- (e) Describe any material discrepancy between the location of the corner as restored or reestablished and the location of that corner as previously restored or reestablished by distance and direction. Show the discrepancy on the plan view drawing under (d), above. Show the distances between the corner as previously restored or reestablished and (1) the corner as restored or reestablished, and (2) to at least 2 of the witness monuments shown on the drawing in (d), above.


None.

- (f) Was the corner restored through acceptance of (1) an obliterated evidence location, or, (2) a found perpetuated location?

(2) a found perpetuated location

- (g) Was the corner reestablished through lost corner proportionate methods? If so, show the method, including the directions and distances to other public land survey corners used as evidence or used for proportioning in determining the corner location?

No.

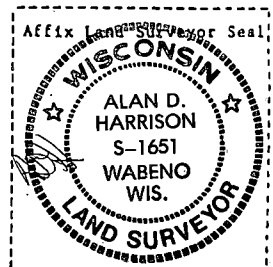

- (1) I, Alan D. Harrison (type or print name) certify that the corner location shown on this record was determined by me or under my direction and control and that this U.S. Public Land Survey Monument Record is correct and complete to the best of my knowledge and belief.

Alan D. Harrison 3/1/90  
Signature Date

CERTIFICATE READY FOR FILING:

Paul B. Itzge  
District Ranger

## U. S. PUBLIC LAND SURVEY MONUMENT RECORD.


## INSTRUCTIONS:

This record shall show the location of the corner and shall include all of the following nine elements (a through i).

- (a) Identify the corner by reference to the U.S. public land survey system.

⊙ = Corner monument restored.

Quarter Corner to Sections 17-20,  
T.36N., R.16E., Forest County,  
Wisconsin.

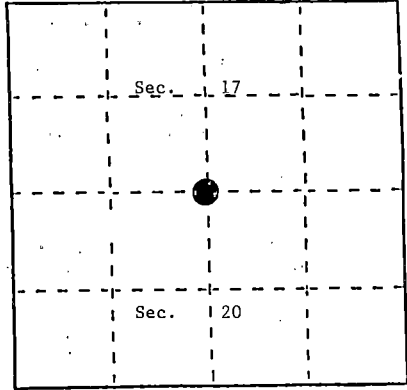

- (b) Describe any record evidence, monument evidence, occupational evidence, testimonial evidence or any other material evidence you considered, and whether the monument was found or placed.


In 1858, James McBride set a wood post with the following B.T.'s: Aspen, 10", N.40°W., 28 links (18.48 feet); Birch, 8", S.13°E., 10 links (6.60 feet).

In 1911, J. Melandy found original Birch, 14", and decayed original Aspen stump from which he set a 4" x 4" Elm post and the following new B.T.'s: Birch, 8", N.66 3/4°W., 30 1/4 links (19.965 feet); Basswood, 14", S.47 3/4°W., 34 2/4 links (22.77 feet); Birch, 9", S.73 1/4°E., 17 links (11.22 feet).

In 1989, Alan Harrison, RLS, found no evidence of original or Melandy's corner or accessories. Set corner by proportionate measure.

- (c) In the plan view drawing below, provide reference ties to at least 4 witness monuments, or, if the location is within a municipality, to at least 2 witness monuments. (Witness monuments shall be made of concrete, natural stone, iron or other equally durable material.) Describe witness monuments.

- (d) Show a plan view drawing depicting the relevant monuments and reference ties which is sufficient in detail to enable accurate relocation of the corner monument if the corner monument is disturbed. Indicate north.

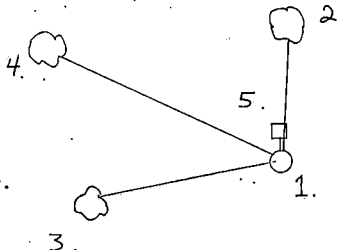

- 2 1/2" x 36" aluminum monument with tablet stamped to identify the corner.
- Sugar, 11", N.04°E., 19.34 feet.
- Sugar, 9", S.76°W., 32.21 feet.
- Sugar, 12", N.61°W., 47.68 feet.
- Steel Sign Post, North, 0.43 feet.

REGISTER'S OFFICE  
Forest County, Wis.

Received for record this 29<sup>th</sup> day  
of March A.D., 1990 at  
10:00 o'clock A.M. and recorded  
in Vol. CORNER RESTORATIONS  
page N-7

*Paul Aschenbrenner*  
Register of Deeds

- (e) Describe any material discrepancy between the location of the corner as restored or reestablished and the location of that corner as previously restored or reestablished by distance and direction. Show the discrepancy on the plan view drawing under (d), above. Show the distances between the corner as previously restored or reestablished and (1) the corner as restored or reestablished, and (2) to at least 2 of the witness monuments shown on the drawing in (d), above.


None.

- (f) Was the corner restored through acceptance of (1) an obliterated evidence location, or, (2) a found perpetuated location?

No.


- (g&h) Was the corner reestablished through lost corner proportionate methods? If so, show the method, including the directions and distances to other public land survey corners used as evidence or used for proportioning in determining the corner location?

Yes.

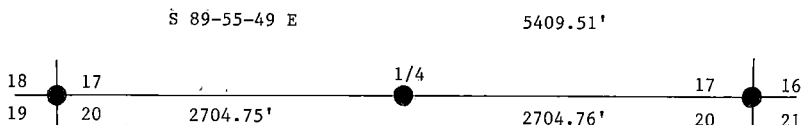

- (i) I, Alan D. Harrison (type or print name) certify that the corner location shown on this record was determined by me or under my direction and control and that this U.S. Public Land Survey Monument Record is correct and complete to the best of my knowledge and belief.

Alan D. Harrison 3/1/90  
Signature Date

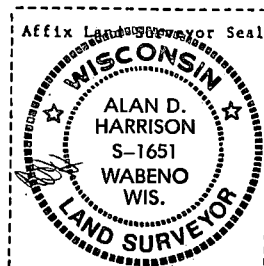

CERTIFICATE READY FOR FILING:

Dale B. Staeg  
District Ranger

CERTIFIED LAND CORNER RESTORATION

State of Wisconsin

County of Forest

ss.

I Milo E. Stefan, do hereby certify that on the 22nd day of September, 1982, I found evidence of the Northwest corner of Section 21 Township 36N, Range 16E, Fourth Principal Meridian, as described hereon; and that from this evidence I established a new monument and accessories as described hereon to perpetuate the original location of this corner:

Description of original monument and accessories and subsequent restorations:

Surveyed in 1858 by James McBride  
80.00, set wood post  
Fir, 12", N76°E, 112 lks., 73.92'  
Tamarack, 6", S9°E, 26 lks., 17.16'  
Fir, 10", S84°W, 76 lks., 50.16'  
Tamarack, 6", N34°W, 36 lks., 23.76'

Description of corner evidence found:

Stump hole, N76°E, 74'  
Tamarack roots, S9°E, 17'  
Stump hole, S84°W, 50'  
Tamarack stump, 6"-8", N34°W, 23.8'  
Local Evidence: 8" x 8" x 5' Cedar post with another rotted off post alongside  
Blazed line, north, east, and west.


Description of monument and accessories I established to perpetuate the location of this corner:

Replaced post with a 2" x 60" aluminum monument with tablet stamped as follows:  
T36N, R16E, S17, S16, S20, S21, 1982, RLS-1558  
From which the following bear:  
Yellow Birch, 8", N78°E, 77.89'  
Hemlock, 18", S58°E, 49.46'  
Red Maple, 10", S74°W, 48.47'  
Hemlock, 18", N51°W, 76.35'  
Steel Sign Post, East, 2.0'

DOCUMENT NO.

**124224**

43616170000

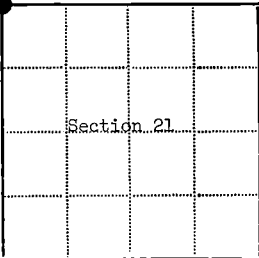

● - Corner monument restored

□ -

Resident witnesses.....

Dated at Rhineland Wisconsin, this 2 day of May, 1982

Signature Milo E. Stefan Title Land Surveyor  
(County Surveyor, Registered Land Surveyor, or other duly authorized official)

Surveyors Registration No. RLS-1558

Office of Register of Deeds County of Forest

I hereby certify that the within instrument was filed in this office for record on the 14th day of September, 1982, and was filed in Book No. \_\_\_\_\_ Page No. \_\_\_\_\_ of County Records.

Signature Eugene Stangoray Title Register of Deeds

Township 36 North, Range 16 East, Section 21, Index No. N-9, Page No. 9

CERTIFIED LAND CORNER RESTORATION

State of Wisconsin }  
County of Forest } ss.

I, Milo E. Stefan, do hereby certify that on the 22nd day of September, 1982, I found evidence of the North Quarter corner of Section 21 Township 36N, Range 16E, Fourth Principal Meridian, as described hereon; and that from this evidence I established a new monument and accessories as described hereon to perpetuate the original location of this corner:

Description of original monument and accessories and subsequent restorations:

Surveyed in 1858 by James McBride  
40.20 chains, set wood post  
Aspen, 10", S59°E, 16 lks., 10.56'  
Aspen, 10", N4°W, 20 lks., 13.2'

Description of corner evidence found:

Stump hole depression, S59°E, 10.0'  
Stump hole depression, N4°W, 13.2'  
Local Evidence: Aspen, 10", S28°W, Live  
Aspen, 10", N .E, Dead  
Ribbon line south and west


Description of monument and accessories I established to perpetuate the location of this corner:

Placed a 2" x 36" aluminum monument in post hole with mound of stone with tablet stamped as follows:  
T36N, R16E, S10E, S11, S15, S14, 1981, RLS-1558  
From which the following bear:  
Sugar, 6", N51°E, 27.14'  
Sugar, 6", S41°W, 25.28'  
Sugar, 6", N60°W, 25.33'  
Steel Sign Post, West, 3.5'

DOCUMENT NO.  
**124225**



436166020

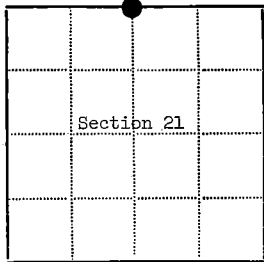

● - Corner monument restored  
□ -

Resident witnesses.....

Dated at Rhinelander, Wisconsin, this 2 day of MAY, 1982.

Signature Milo E. Stefan Title Land Surveyor  
(County Surveyor, Registered Land Surveyor, or other duly authorized official)

Surveyors Registration No. RLS-1558

Office of Register of Deeds County of Forest

I hereby certify that the within instrument was filed in this office for record on the 14th day of September, 1982, and was filed in Book No. \_\_\_\_\_ Page No. \_\_\_\_\_ of County Records.

Signature Eugene J. Staszny Title Register of Deeds


Township 36 North, Range 16 East, Section 21, Index No. N-11, Page No. 7

## U. S. PUBLIC LAND SURVEY MONUMENT RECORD

INSTRUCTIONS: This record shall show the location of the corner and shall include all of the following nine elements (a through i).

- (a) Identify the corner by reference to the U.S. public land survey system.  
 O = Corner monument restored.

Section Corner to Sections 16, 15, 21, and 22,  
 Township 36 North, Range 16 East, Forest  
 County, Wisconsin.

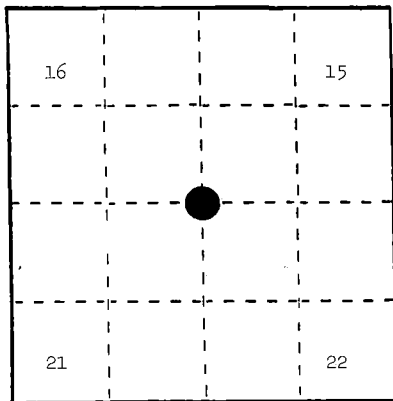

REGISTER'S OFFICE  
 Forest County, Wis.

Received for record this 21st day  
 of April, A.D., 1987 at  
9:20 o'clock A.M. and recorded  
 in Vol. CORNER RESTORATIONS  
 page N-13

Paul Fischmanner  
 Register of Deeds

- (b) Describe any record evidence, monument evidence, occupational evidence, testimonial evidence or any other material evidence you considered, and whether the monument was found or placed.

In 1858, James McBride set a wood post with the following BTs: Fir, 8", N.34°W., 12 links; Aspen, 12", N.58°W., 22 links; White Pine, 8", S.79°E., 30 links; Fir, 7", S.61°W., 20 links.


In 1926, Goodman Lumber Company found 5" Cedar post; rotted stump of Fir, N.34°W., 12 links; White Pine, 14", S.79°E., 30 links--blazes on Pine very plain. Set flue pipe 16" above ground level.

In 1987, Alan Harrison (RLS) found the following: 2" iron pipe (flue pipe) as set by Goodman; original Pine BT stump at S.79°E., 19.80 feet from pipe. Accepted this pipe as the true perpetuated location of corner. Replaced pipe with a 2" x 36" aluminum monument with tablet stamped to identify corner.

- (c) In the plan view drawing below, provide reference ties to at least 4 witness monuments, or, if the location is within a municipality, to at least 2 witness monuments. (Witness monuments shall be made of concrete, natural stone, iron or other equally durable material.)  
 Describe witness monuments.

- (d) Show a plan view drawing depicting the relevant monuments and reference ties which is sufficient in detail to enable accurate relocation of the corner monument if the corner monument is disturbed. Indicate north.

1. 2" x 36" aluminum monument with tablet stamped to identify corner.
2. Balsam, 6", N.12°E., 28.15 feet
3. Spruce, 9", S.74°E., 59.78 feet
4. Red Maple, 6", S.21°W., 23.13 feet
5. Spruce, 7", N.89°W., 36.13 feet
6. Steel Sign Post, Southeast, 1.06 feet

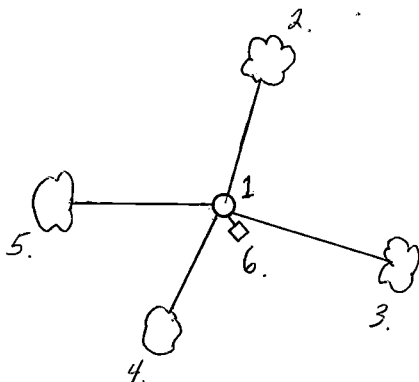

43616160000

- (e) Describe any material discrepancy between the location of the corner as restored or reestablished and the location of that corner as previously restored or reestablished by distance and direction. Show the discrepancy on the plan view drawing under (d), above. Show the distances between the corner as previously restored or reestablished and (1) the corner as restored or reestablished, and (2) to at least 2 of the witness monuments shown on the drawing in (d), above.


None.

- (f) Was the corner restored through acceptance of (1) an obliterated evidence location, or, (2) a found perpetuated location?

(2) a found perpetuated location.

- (g&h) Was the corner reestablished through lost corner proportionate methods? If so, show the method, including the directions and distances to other public land survey corners used as evidence or used for proportioning in determining the corner location?

No.

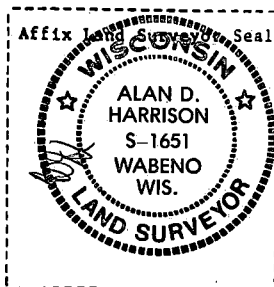

- (1) I, Alan D. Harrison  
(Type or print name) certify that the corner location shown on this record was determined by me or under my direction and control and that this U.S. Public Land Survey Monument Record is correct and complete to the best of my knowledge and belief.

Alan D. Harrison  
Signature

4/16/87  
Date

## DOCUMENT NUMBER

136613

## U. S. PUBLIC LAND SURVEY MONUMENT RECORD

INSTRUCTIONS: This record shall show the location of the corner and shall include all of the following nine elements (a through i).

- (a) Identify the corner by reference to the U.S. public land survey system.

○ = Corner monument restored.


Quarter Corner Common to Sections 15 and 22,  
T36N, R16E, Forest County, Wisconsin.

REGISTER'S OFFICE  
Forest County, Wis.

Received for record this 9th day  
of December A.D., 1988 at

2:50 o'clock P. M. and recorded  
in Vol. CORNER RESTORATIONS  
page N-15

Paul Heckenbroner  
Register of Deeds

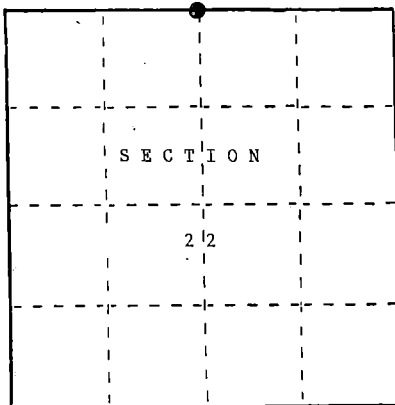

- (b) Describe any record evidence, monument evidence, occupational evidence, testimonial evidence or any other material evidence you considered, and whether the monument was found or placed.

In 1858, James McBride set a wood post for the corner and the following corner references:  
Birch 10" S22°E 25 lks. Basswood 7" N46°E 24 lks.


In 1926, Goodman Lumber Company set a wood post by proportional measurement and replaced it with flue pipe extending 15" high above the ground.

In 1988, John Schulke found the iron pipe but did not accept it. Placed 2 1/2" X 36" aluminum monument. The 1 1/2" dia. iron pipe is S86°E 6.85 feet from the monument.

- (c) In the plan view drawing below, provide reference ties to at least 4 witness monuments, or, if the location is within a municipality, to at least 2 witness monuments. (Witness monuments shall be made of concrete, natural stone, iron or other equally durable material.)  
Describe witness monuments.

- (d) Show a plan view drawing depicting the relevant monuments and reference ties which is sufficient in detail to enable accurate relocation of the corner monument if the corner monument is disturbed. Indicate north.

- 2 1/2" dia. X 36" aluminum magnetic cap monument stamped to identify the corner.
- Hemlock 6" N74°W 41.00 feet
- Basswood 17" N86°E 45.35 feet
- Hemlock 13" S52°E 57.89 feet
- Sugar Maple 8" S17°W 45.07 feet
- Steel sign post Southwest 1.0 feet

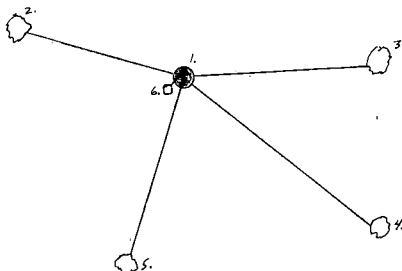

43616150020

(e) Describe any material discrepancy between the location of the corner as restored or reestablished and the location of that corner as previously restored or reestablished, by distance and direction. Show the discrepancy on the plan view drawing under (d), above. Show the distances between the corner as previously restored or reestablished and (1) the corner as restored or reestablished, and (2) to at least 2 of the witness monuments shown on the drawing in (d), above.


No discrepancy, first corner restoration.

(f) Was the corner restored through acceptance of (1) an obliterated evidence location, or, (2) a found perpetuated location?

No, see g and h.

(g&h) Was the corner reestablished through lost corner proportionate methods? If so, show the method, including the directions and distances to other public land survey corners used as evidence or used for proportioning in determining the corner location?

Corner restored by proportionate method.

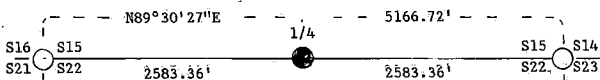

(1) I, John Schulke


(type or print name) certify that the corner location shown on this record was determined by me or under my direction and control and that this U.S. Public Land Survey Monument Record is correct and complete to the best of my knowledge and belief.

John Schulke  
Signature

Dec 3 1988  
Date

Certificate ready for filing:

Dale S. Stage  
District Ranger

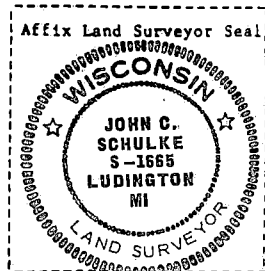

## U. S. PUBLIC LAND SURVEY MONUMENT RECORD


## INSTRUCTIONS:

This record shall show the location of the corner and shall include all of the following nine elements (a through i).

- (a) Identify the corner by reference to the U.S. public land survey system.

○ = Corner monument restored.

Section Corner to Sections 14, 15, 22, and 23,  
T.36N., R.16E.

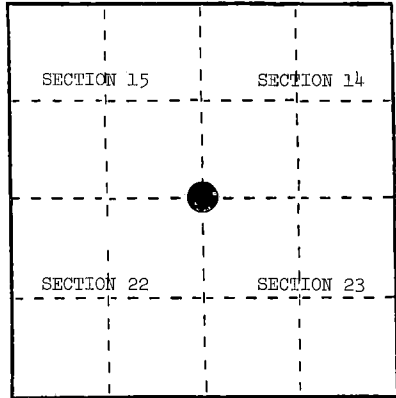

REGISTER'S OFFICE  
Forest County, Wis.

Received for record this 17<sup>th</sup> day

of February, D., 1988 at

10:00 o'clock A.M. and recorded

In Vol. CORNER RESTORATION

page N-17

Paul Aschenhauer

Register of Deeds

- (b) Describe any record evidence, monument evidence, occupational evidence, testimonial evidence or any other material evidence you considered, and whether the monument was found or placed.

In 1850, James McBride set wood post with the following BTs: Fir, 10", N.5°W., 40 links; White Pine, 10", N.21°E., 53 links; Aspen, 8", S.29°E., 30 links; Aspen, 12", S.47°W., 48 links.

In 1925, Goodman Co. found 4" Cedar post (recently set) but no BTs. Set flue pipe 2'-10" above ground.

In 1934, White and Laird found wood stake and iron pipe. Placed a location poster on 14" Cedar stump on west side, corner bears south 3½ chains.


In 1967, Novak and Resvick found an iron pipe and squared post. Also found a fallen Cedar with location poster, south, 12 links to corner.

In 1987, Alan Harrison found location poster on fallen 10" Cedar as per Resvick and Novak. From this corner position also found a Wisconsin Conservation tag from 1940 on 12" Cedar, SSW, 18.66 feet. Could find no evidence of post and iron pipe. Accepted position 12 links south of fallen Cedar with tag as best corner evidence and placed a 2" x 36" aluminum monument.

- (c) In the plan view drawing below, provide reference ties to at least 4 witness monuments, if the location is within a municipality, to at least 2 witness monuments. (Witness monuments shall be made of concrete, natural stone, iron or other equally durable material.)  
Describe witness monuments.

- (d) Show a plan view drawing depicting the relevant monuments and reference ties which is sufficient in detail to enable accurate relocation of the corner monument if the corner monument is disturbed. Indicate north.

1. 2" x 36" aluminum monument stamped to identify the corner.
2. Spruce, 14", N.07°E., 55.65 feet
3. Hemlock, 16", S.24°E., 49.41 feet
4. Cedar, 12", S.49°W., 32.80 feet
5. Cedar, 10", N.53°W., 19.30 feet
6. Steel Sign Post, Northeast, 1.54 feet

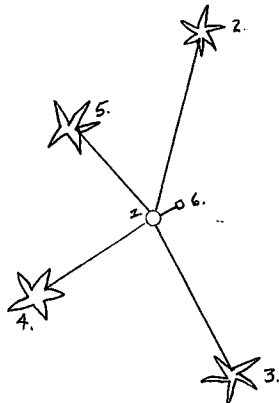

436161500000

- (e) Describe any material discrepancy between the location of the corner as restored or reestablished and the location of that corner as previously restored or reestablished by distance and direction. Show the discrepancy on the plan view drawing under (d), above. Show the distances between the corner as previously restored or reestablished and (1) the corner as restored or reestablished, and (2) to at least 2 of the witness monuments shown on the drawing in (d), above.

None.

- (f) Was the corner restored through acceptance of (1) an obliterated evidence location, or, (2) a found perpetuated location?

(1) an obliterated evidence location.

- (g&h) Was the corner reestablished through lost corner proportionate methods? If so, show the method, including the directions and distances to other public land survey corners used as evidence or used for proportioning in determining the corner location?


No.

- (i) I, Alan D. Harrison  
(Type or print name) certify that the corner location shown on this record was determined by me or under my direction and control and that this U.S. Public Land Survey Monument Record is correct and complete to the best of my knowledge and belief.

Signature

Date

2/11/88

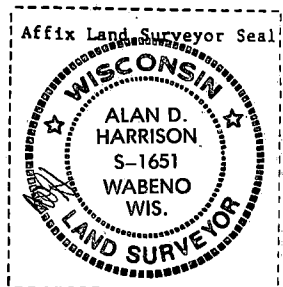


U. S. PUBLIC LAND SURVEY MONUMENT RECORD.

INSTRUCTIONS: This record shall show the location of the corner and shall include all of the following nine elements (a through i).

- (a) Identify the corner by reference to the U.S. public land survey system.

○ = Corner monument restored.

Quarter Corner Common to Sections 14. and 23, T36N, R16E, Forest County, Wisconsin.

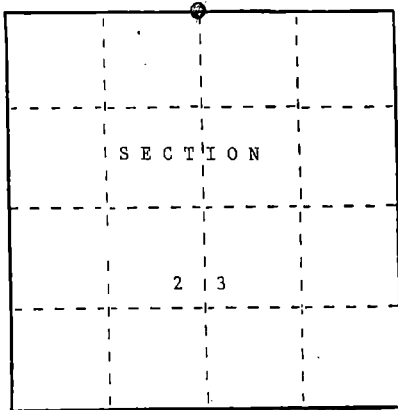

REGISTER'S OFFICE  
Forest County, Wis.  
Received for record this 7th day  
of December A.D. 1988 at  
2:50 o'clock P.M. and recorded  
in Vol. 19 CORNER RESTORATIONS  
page 1  
*Paul Hochstetler*  
Register of Deeds

- (b) Describe any record evidence, monument evidence, occupational evidence, testimonial evidence or any other material evidence you considered, and whether the monument was found or placed.


In 1858, James McBride set a wood post for the corner and the following corner references:  
Aspen 10" N55°E 10 lks. Aspen 8" S21°E 17 lks.

In 1988, John Schulke found no evidence. Placed 2 1/2" dia. X 36" aluminum monument.  
The center of a two track road is South 89 feet from the monument.

- (c) In the plan view drawing below, provide reference ties to at least 4 witness monuments, or, if the location is within a municipality, to at least 2 witness monuments. (Witness monuments shall be made of concrete, natural stone, iron or other equally durable material.)  
Describe witness monuments.

- (d) Show a plan view drawing depicting the relevant monuments and reference ties which is sufficient in detail to enable accurate relocation of the corner monument if the corner monument is disturbed.  
Indicate north.

1. 2 1/2" dia. X 36" aluminum magnetic cap monument stamped to identify the corner.
2. Iron pipe 1 1/2" X 2 1/2' N40°E 24.45 feet
3. Iron pipe 1 1/2" X 2 1/2' S50°E 15.15 feet
4. Chiseled an "X" on rock 3 1/2' X 3 1/2' S12°W 77.22 feet
5. Chiseled an "X" on rock 3' X 1 1/2' N49°W 29.91 feet
6. Steel sign post West 1.5 feet

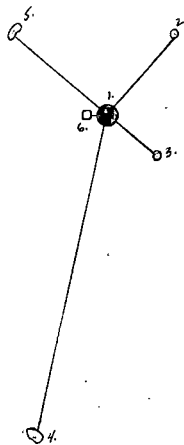

43616140020

- (e) Describe any material discrepancy between the location of the corner as restored or reestablished and the location of that corner as previously restored or reestablished by distance and direction. Show the discrepancy on the plan view drawing under (d), above. Show the distances between the corner as previously restored or reestablished and (1) the corner as restored or reestablished, and (2) to at least 2 of the witness monuments shown on the drawing in (d), above.


No discrepancy, first corner restoration.

- (f) Was the corner restored through acceptance of (1) an obliterated evidence location, or, (2) a found perpetuated location?

No, see g and h.

- (g,h) Was the corner reestablished through lost corner proportionate methods? If so, show the method, including the directions and distances to other public land survey corners used as evidence or used for proportioning in determining the corner location?


Corner restored by proportionate method.

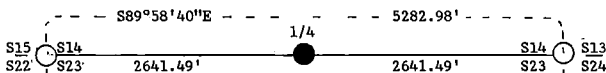

- (i) I, John Schulke

(type or print name) certify that the corner location shown on this record was determined by me or under my direction and control and that this U.S. Public Land Survey Monument Record is correct and complete to the best of my knowledge and belief.

John Schulke 12/2/88  
Signature Date  
Certificate ready for filing: Dale B. Staeger  
District Ranger

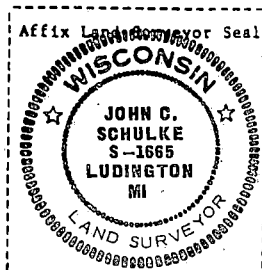

136615

## U. S. PUBLIC LAND SURVEY MONUMENT RECORD.

INSTRUCTIONS: This record shall show the location of the corner and shall include all of the following nine elements (a through i).


- (a) Identify the corner by reference to the U.S. public land survey system.

○ = Corner monument restored.

Section Corner to Sections 13, 14, 23 and 24,  
T36N, R16E, Forest County, Wisconsin.

REGISTER'S OFFICE  
Forest County, Wis.

Received for record this 9th day  
of December, 1988, at  
2:50 o'clock P.M., and recorded  
in Vol. CORNER RESTORATIONS  
Page N-81  
Paul Aschenbrenner  
Register of Deeds

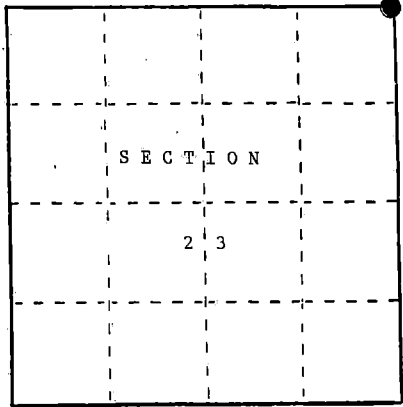

- (b) Describe any record evidence, monument evidence, occupational evidence, testimonial evidence or any other material evidence you considered, and whether the monument was found or placed.


In 1858, James McBride set a wood post for the corner and the following corner references:  
Hemlock 30" S38°E 30 lks. Sugar 10" S30°E 48 lks. Sugar 12" S63°W 36 lks.  
Sugar 12" N24°W 43 lks.

In 1926, Goodman Lumber Company set a Elm post and an iron bolt  
In 1982, Milo Stefan found an iron bolt and replaced it with 2 1/2" X36" aluminum monument.  
the following corner references: Basswood 18" N08°E 46.8 ft. Sugar 6" N89°E 9.64 ft.  
Sugar 5" N48°W 37.55 ft. Steel sign post West 1.3 ft.  
In 1988, John Schulke found the corner as described in Stefan field notes.

- (c) In the plan view drawing below, provide reference ties to at least 4 witness monuments, or, if the location is within a municipality, to at least 2 witness monuments. (Witness monuments shall be made of concrete, natural stone, iron or other equally durable material.)  
Describe witness monuments.

- (d) Show a plan view drawing depicting the relevant monuments and reference ties which is sufficient in detail to enable accurate relocation of the corner monument if the corner monument is disturbed. Indicate north.

1. 2 1/2" dia. X 36" aluminum magnetic cap monument stamped to identify the corner.
2. Basswood 20" N15°E 46.78 ft.
3. Sugar Maple 7" N89°E 9.57 ft.
4. Sugar Maple 6" N39°W 37.45 ft.
5. Sugar Maple 6" N45°E 43.85 ft.
6. Steel sign post West 1.3 ft.

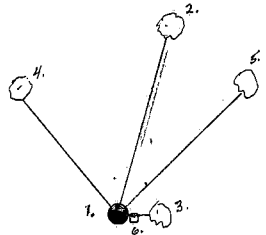

4361640000

- (e) Describe any material discrepancy between the location of the corner as restored or reestablished and the location of that corner as previously restored or reestablished by distance and direction. Show the discrepancy on the plan view drawing under (d), above. Show the distances between the corner as previously restored or reestablished and (1) the corner as restored or reestablished, and (2) to at least 2 of the witness monuments shown on the drawing in (d), above.

The corner references are for a different corner on the certificate (Doc. #119862) filed in the Forest County Register of Deed's Office.

- (f) Was the corner restored through acceptance of (1) an obliterated evidence location, or, (2) a found perpetuated location?

(2) found perpetuated location.

- (g&h) Was the corner reestablished through lost corner proportionate methods? If so, show the method, including the directions and distances to other public land survey corners used as evidence or used for proportioning in determining the corner location?

(1) I, John Schulke


(Type or print name) certify that the corner location shown on this record was determined by me or under my direction and control and that this U.S. Public Land Survey Monument Record is correct and complete to the best of my knowledge and belief.

John Schulke  
Signature

12/2/88  
Date

Certificate ready for filing:

Dale S. Staeger  
District Ranger

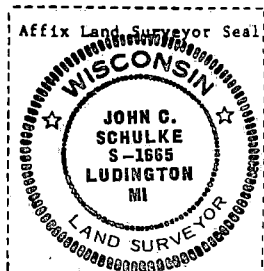

CERTIFIED LAND CORNER RESTORATION

State of Wisconsin }  
County of Forest } ss.

I Milo E. Stefan, do hereby certify that on the 24th day of June, 1982, I found evidence of the Northwest corner of Section 24 Township 36 North Range 16 East Fourth Principal Meridian, as described hereon; and that from this evidence I established a new monument and accessories as described hereon to perpetuate the original location of this corner:

Description of original monument and accessories and subsequent restorations:

Surveyed in 1858 by James McBride  
80.00 chains, set wood post  
Birch, 8", N78°W, 16 lks., 10.56 feet  
Birch, 16", N28°E, 60 lks., 39.60 feet  
Sugar, 10", S52°E, 40 lks., 26.40 feet  
Birch, 14", S16°W, 35 lks., 23.10 feet


Description of corner evidence found:

Sugar stump hole, S52°E, 26 feet  
Birch stump hole, S16°W, 23 feet  
Local Evidence: 2" x 2" squared post rotted off, paint in ground, drift pin alongside of post. 3/4" bolt placed by Goodman Lumber Company

Description of monument and accessories I established to perpetuate the location of this corner:

We replaced 3/4" x 16" iron bolt with a 2" x 36" aluminum monument in mound of stone with tablet stamped as follows:  
T36N, R16E, S14, S13, S23, S24, 1982, RLS-1558  
From which the following bear:  
Basswood, 18", N8°E, 46.80 feet  
Sugar, 6", N89°E, 9.64 feet  
Sugar, 5", N48°W, 37.55 feet  
Steel Sign Post, West, 1.30 feet

DOCUMENT NO.  
**124226**

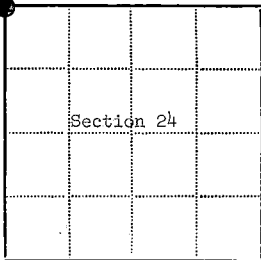

● - Corner monument restored  
□ -

Resident witnesses \_\_\_\_\_

Dated at Rhinelander Wisconsin, this \_\_\_\_\_ day of 1983

Signature Milo E. Stefan Title Land Surveyor  
(County Surveyor, Registered Land Surveyor, or other duly authorized official)

Surveyors Registration No. RLS-1558

Office of Register of Deeds County of Forest

I hereby certify that the within instrument was filed in this office for record on the 14th day of September, 1983, and was filed in Book No. \_\_\_\_\_ Page No. \_\_\_\_\_ of County Records.

Signature Eugene D. Stangor Title Register of Deeds

Township 36 North, Range 16 East, Section 24, Index No. N-21, Page No. 3

43616190000

N21

CERTIFIED LAND CORNER RESTORATION

State of Wisconsin }  
County of Forest } ss.

I Milo E. Stefan, do hereby certify that on the 22 day of October, 1980, I found evidence of the Northwest corner of Section 24 Township 36 North, Range 16 East, Fourth Principal Meridian, as described hereon; and that from this evidence I established a new monument and accessories as described hereon to perpetuate the original location of this corner:

Description of original monument and accessories and subsequent restorations:

Surveyed by James McBride in August 1858.  
Set Wood Post  
Hemlock, 30", N38°E, 30 links  
Sugar, 10", S30°E, 48 links  
Sugar, 12", S63°W, 36 links  
Sugar, 12", N24°W, 43 links.

Description of corner evidence found:


6" X 6" X 24" Cedar post with location poster attached  
Large hemlock stump hole N38°E, 19.8 feet  
Stump hole N24°W, 28.4 feet  
Stump hole S63°W, 23.8 feet.

Description of monument and accessories I established to perpetuate the location of this corner:

At corner position set a 2 inch by 30 inch aluminum pipe with cap stamped:  
T36N, R16E, S13, S14, S23, S24, 1980, R.L.S. 1558.

From which the following bear:  
Sugar Maple, 8", N25°E, 23.42 feet  
White Ash, 8", S37°E, 31.95 feet  
Sugar Maple, 8", S52°W, 20.93 feet  
Sugar Maple, 6", N43°W, 47.81 feet.

DOCUMENT NO.  
**119862**

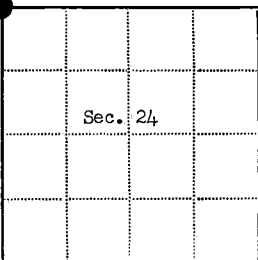

● - Corner monument restored  
□ -

Resident witnesses.....

Dated at Laona, Wisconsin, this 4 day of November 19 80.

Signature Milo E. Stefan Title Land Surveyor  
(County Surveyor, Registered Land Surveyor, or other duly authorized official)

Surveyors Registration No. 1558

Office of Register of Deeds County of Forest

I hereby certify that the within instrument was filed in this office for record on the 2nd day of June, 19 81, and was filed in Book No. \_\_\_\_\_ Page No. \_\_\_\_\_ of County Records.

Signature Eugene Stagnary Title Register of Deeds

Township 36N, Range 16E, Section 24, Index No. N-21, Page No. \_\_\_\_\_

43616140000

N21

# CERTIFIED LAND CORNER RESTORATION

State of Wisconsin

County of Forest

ss.

I Milo E. Stefan, do hereby certify that on the 29th day of July, 1982, I found evidence of the South Quarter corner of Section 13 Township 36 North Range 16 East, Fourth Principal Meridian, as described hereon; and that from this evidence I established a new monument and accessories as described hereon to perpetuate the original location of this corner:

Description of original monument and accessories and subsequent restorations:

Surveyed in 1858 by James McBride  
40.12½ chains, set wood post  
Hemlock, 16", S13°W, 40 lks., 26.40 feet  
Hemlock, 24", N15°W, 37 lks., 24.42 feet

Description of corner evidence found:


No original evidence found  
Local Evidence: 3/4" x 36" iron rod in mound of stone. Stump holes at bearing and distance to each original BT look very good.

Description of monument and accessories I established to perpetuate the location of this corner:

Replaced iron rod with a 2" x 36" aluminum monument in mound of stone with tablet stamped as follows:  
T36N, R16E, S13, ¼, S24; 1982, RLS-1558  
From which the following bear:  
Sugar, 6", S01°E, 11.20 feet  
Sugar, 6", S53°W, 21.81 feet  
Yellow Birch, 8", N30°W, 29.62 feet  
Steel Sign Post, West, 1.5 feet

DOCUMENT NO.

**124221**

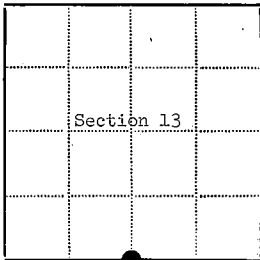

● - Corner monument restored

□ -

Resident witnesses.....

Dated at Rhinelander, Wisconsin, this 19 day of 83.

Signature Milo E. Stefan Title Land Surveyor  
(County Surveyor, Registered Land Surveyor, or other duly authorized official)

Surveyors Registration No. RLS-1558

Office of Register of Deeds County of Forest

I hereby certify that the within instrument was filed in this office for record on the 14th day of September, 1983, and was filed in Book No.        Page No.        of County Records.

Signature Eugene J. Staty Title Register of Deeds

Township 36 North, Range 16 East, Section 13, Index No. N-23, Page No. 1

43616130020

N23

# CERTIFIED LAND CORNER RESTORATION

State of Wisconsin

County of Forest

ss.

I, Jean F. Resvick, do hereby certify that on the 11 day of March, 19 76, I found evidence of the West quarter corner of Section 19 Township 36 North, Range 16 East, Fourth Principal Meridian, as described hereon; and that from this evidence I established a new monument and accessories as described hereon to perpetuate the original location of this corner:

## Description of original monument and accessories and subsequent restorations:


Surveyed in 1857 by Artemas Curtis  
40.00 chains north between sections 19 and 24  
Set post  
Elm 8, S54W, 26 lks.  
Hemlock 10, N61E, 55 lks.  
12 chains north, enter swamp bears east  
15.75 chains north, stream, 4 lks. wide runs SW

## Description of corner evidence found:

6x6 squared post scribed, has rotted off a couple of times  
1 1/2 inch diameter iron pipe 34 inches long along side post  
Elm 17, bears S54W, 26 lks., has over growth of old blazes.  
Hemlock stump bears N69E, 58 lks.

## Description of monument and accessories I established to perpetuate the location of this corner:

Set 2 inch inside diameter, galvanized iron pipe, 3 feet long, filled with concrete, with brass cap stamped:  
T36N, R15E, R16E, 1/4, S24, S19, 1976, S-802  
Blazed and scribed the following new bearing trees  
Maple 7, S31E, 8.33 feet  
Maple 4, N56W, 7.74 feet  
Set steel sign post 0.5 feet northwest of monument.

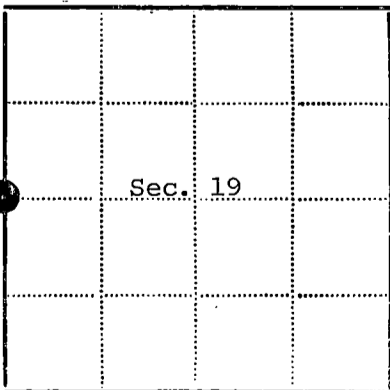

● - Corner monument restored  
□ -

Resident witnesses

Dated at Rhineland Wisconsin, this 11 day of March, 19 76.

Signature Jean F. Resvick Title Surveyor  
(County Surveyor, Registered Land Surveyor, or other duly authorized official)

Surveyors Registration No. S-802

DOCUMENT NUMBER  
**109588**


Office of Register of Deeds County of FOREST

I hereby certify that the within instrument was filed in this office for record on the 2nd day of July, 19 76, and was filed in Book No.          Page No.          of County Records.

Signature Eugene Staszny Title Register of Deeds

Township 36 North, Range 16 East, Section 19, Index No. P-1, Page No.         

43615 24 2000

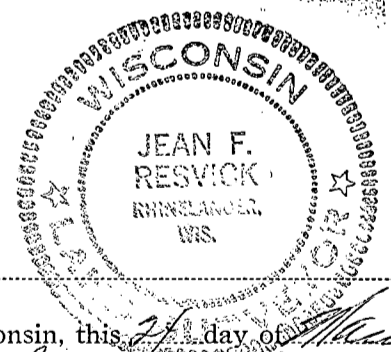

## DOCUMENT NUMBER

136616

## U. S. PUBLIC LAND SURVEY MONUMENT RECORD

INSTRUCTIONS: This record shall show the location of the corner and shall include all of the following nine elements (a through i).

- (a) Identify the corner by reference to the U.S. public land survey system.  
 O = Corner monument restored.

Quarter Corner Common to Sections 21 and 22,  
 T36N, R16E, Forest County, Wisconsin.


REGISTER'S OFFICE  
 Forest County, Wis.

Received for record this 9th day  
 of December A.D., 1988 at

2:50 o'clock P.M. and recorded  
 in Vol. 23 **CORNER RESTORATIONS**

page 23

Paul Aschenbrenner  
 Register of Deeds

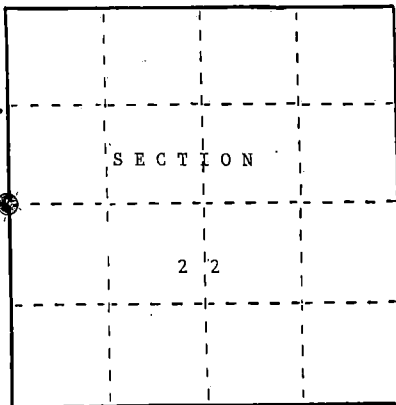

- (b) Describe any record evidence, monument evidence, occupational evidence, testimonial evidence or any other material evidence you considered, and whether the monument was found or placed.

In 1858, James McBride set a wood post for the corner and the following corner references:  
 Aspen 12" N72°E 5 lks. Aspen 12" S54°W 19 lks.

In 1926, Goodman Lumber Company set a wood post by proportional measurement and replaced it with a Flue pipe extending 15" high above the ground.


Found a 20" Maple bearing tree 297 links North and .88 links East of post. Field notes call for two Aspen bearing trees.

In 1988, John Schulke found an iron pipe but did not accept it. The 1 1/2" diameter iron pipe is S70°W 11.02 feet from the monument.  
 Placed 2 1/2" X 36" aluminum monument.

- (c) In the plan view drawing below, provide reference ties to at least 4 witness monuments, or, if the location is within a municipality, to at least 2 witness monuments. (Witness monuments shall be made of concrete, natural stone, iron or other equally durable material.)  
 Describe witness monuments.

- (d) Show a plan view drawing depicting the relevant monuments and reference ties which is sufficient in detail to enable accurate relocation of the corner monument if the corner monument is disturbed. Indicate north.

- 2 1/2" dia. X 36" aluminum magnetic cap monument stamped to identify the corner.
- Sugar Maple 7" N33°E 18.96 feet
- Sugar Maple 7" S44°E 12.33 feet
- Sugar Maple 4" S10°W 8.99 feet
- Sugar Maple 6" N80°W 14.05 feet
- Steel sign post Northwest 1.6 feet

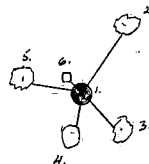

436 1621 2000

- (e) Describe any material discrepancy between the location of the corner as restored or reestablished and the location of that corner as previously restored or reestablished by distance and direction. Show the discrepancy on the plan view drawing under (d), above. Show the distances between the corner as previously restored or reestablished and (1) the corner as restored or reestablished, and (2) to at least 2 of the witness monuments shown on the drawing in (d), above.


No discrepancy, first corner restoration.

- (f) Was the corner restored through acceptance of (1) an obliterated evidence location, or, (2) a found perpetuated location?

No, see g and h.

- (g&h) Was the corner reestablished through lost corner proportionate methods? If so, show the method, including the directions and distances to other public land survey corners used as evidence or used for proportioning in determining the corner location?

Corner restored by proportionate method.

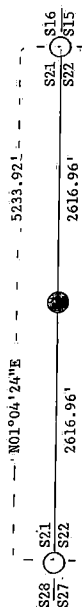


- (1) I, John Schulke  
(type or print name) certify that the corner location shown on this record was determined by me or under my direction and control and that this U.S. Public Land Survey Monument Record is correct and complete to the best of my knowledge and belief.

John Schulke  
Signature

12/2/88  
Date

Certificate ready for filing:

Dale S. Stange  
District Ranger

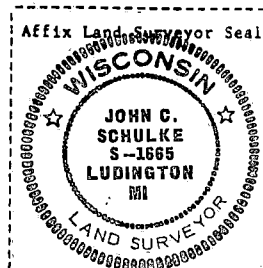

## U. S. PUBLIC LAND SURVEY MONUMENT RECORD.

INSTRUCTIONS: This record shall show the location of the corner and shall include all of the following nine elements (a through i).

- (a) Identify the corner by reference to the U.S. public land survey system.

○ = Corner monument restored.

Quarter Corner Common to Sections 22 and 23,  
T36N, R16E, Forest County, Wisconsin.


REGISTER'S OFFICE  
Forest County, Wis.

Received for record this 19th day  
of December, D.D., 1988, at

2:50 o'clock P.M. and recorded  
in Vol. CORNER RESTORATIONS

Date 12-19

Paul Aschenbrenner  
Register of Deeds

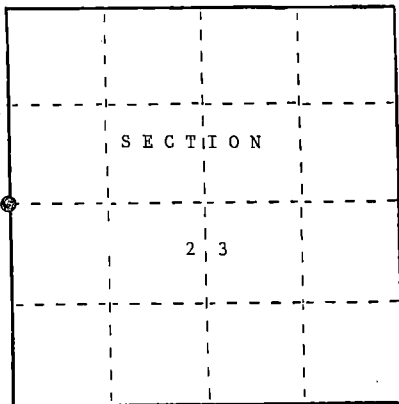

- (b) Describe any record evidence, monument evidence, occupational evidence, testimonial evidence or any other material evidence you considered, and whether the monument was found or placed.

In 1858, James McBride set a wood post for the corner and the following corner references:  
Cedar 10" S22°E 8 lks. Cedar 8" S48°W 18 lks.


In 1926, Goodman Lumber Company set a wood post by proportional measurement and then replaced it with flue pipe. Found an 8" leaning cedar tree 5 paces Southeast with a blaze on it.

In 1988, John Schulke found two Cedar stumps that fit the GLO notes.  
Placed 2 1/2" dia. X 60" aluminum monument.

- (c) In the plan view drawing below, provide reference ties to at least 4 witness monuments, or, if the location is within a municipality, to at least 2 witness monuments. (Witness monuments shall be made of concrete, natural stone, iron or other equally durable material.)  
Describe witness monuments.

- (d) Show a plan view drawing depicting the relevant monuments and reference ties which is sufficient in detail to enable accurate relocation of the corner monument if the corner monument is disturbed. Indicate north.

- 2 1/2" Dia. X 60" aluminum magnetic cap monument stamped to identify the corner.
- Aspen 9" N30°W 64.58 feet
- Black Ash 4" N14°E 49.32 feet
- Black Cherry 6" S19°E 78.12 feet
- Balsam 8" S11°W 76.35 feet
- Steel sign post Southeast 1.0 feet

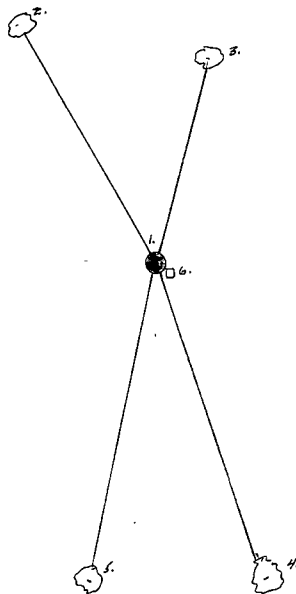

43616222000


- (e) Describe any material discrepancy between the location of the corner as restored or reestablished and the location of that corner as previously restored or reestablished by distance and direction. Show the discrepancy on the plan view drawing under (d), above. Show the distances between the corner as previously restored or reestablished and (1) the corner as restored or reestablished, and (2) to at least 2 of the witness monuments shown on the drawing in (d), above.

No discrepancy, first corner restoration.

- (f) Was the corner restored through acceptance of (1) an obliterated evidence location, or, (2) a found-perpetuated location?

(1) an obliterated evidence location.

- (g&h) Was the corner reestablished through lost corner proportionate methods? If so, show the method, including the directions and distances to other public land survey corners used as evidence or used for proportioning in determining the corner location?

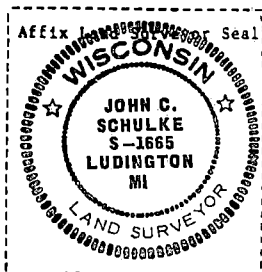

(i) I, John Schulke

(Type or print name) certify that the corner location shown on this record was determined by me or under my direction and control and that this U.S. Public Land Survey Monument Record is correct and complete to the best of my knowledge and belief.

John Schulke  
Signature

12/2/89  
Date

Certificate ready for filing:

Dale B. Staeger  
District Ranger


DOCUMENT NUMBER  
**136618**

## U. S. PUBLIC LAND SURVEY MONUMENT RECORD

INSTRUCTIONS: This record shall show the location of the corner and shall include all of the following nine elements (a through i).

- (a) Identify the corner by reference to the U.S. public land survey system.

O = Corner monument restored.

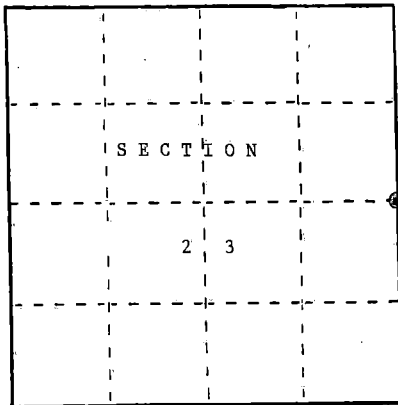Quarter Corner Common to Sections 23 and 24,  
T36N, R16E, Forest County, Wisconsin.REGISTER'S OFFICE  
Forest County, Wis.Received for record this 9th day  
of December, A.D., 1988, at2:50 o'clock P.M. and recorded  
in Vol. CORNER RESTORATIONS  
page 501Paul Ackerschauer  
Register of Deeds


- (b) Describe any record evidence, monument evidence, occupational evidence, testimonial evidence or any other material evidence you considered, and whether the monument was found or placed.

In 1858, James McBride set a wood post for the corner and the following corner references:  
Sugar 10" N79°E 4 lks. Sugar 12" S67°W 39 lks.In 1926, Goodman Lumber Company set 1 5/8" pipe 4" high above the ground. Found a  
10" Sugar tree N79°E 4 lks. Pipe is 8 ft. East of a wagon trail.In 1988, John Schulke found no evidence. Placed 2 1/2" dia. X 36" aluminum monument.  
Forest Service road #2367 is West 135.1 feet from the monument..

- (c) In the plan view drawing below, provide reference ties to at least 4 witness monuments, or, if the location is within a municipality, to at least 2 witness monuments. (Witness monuments shall be made of concrete, natural stone, iron or other equally durable material.)
- 
- Describe witness monuments.

- (d) Show a plan view drawing depicting the relevant monuments and reference ties which is sufficient in detail to enable accurate relocation of the corner monument if the corner monument is disturbed. Indicate north.

- 2 1/2" dia. X 36" aluminum magnetic cap monument stamped to identify the corner.
- Aspen 3" S12°E 5.28 feet
- Chiseled an "X" on rock 3'X4' S86°W 22.10 feet
- Chiseled an "X" on rock 2'X3' N35°E 11.92 feet
- Steel sign post North 0.8 feet

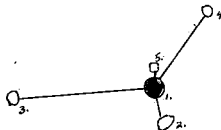

43616232000

- (e) Describe any material discrepancy between the location of the corner as restored or reestablished and the location of that corner as previously restored or reestablished by distance and direction. Show the discrepancy on the plan view drawing under (d), above. Show the distances between the corner as previously restored or reestablished and (1) the corner as restored or reestablished, and (2) to at least 2 of the witness monuments shown on the drawing in (d), above.


No discrepancy, first corner restoration.

- (f) Was the corner restored through acceptance of (1) an obliterated evidence location, or, (2) a found perpetuated location?

No, see g and h.

- (g+h) Was the corner reestablished through lost corner proportionate methods? If so, show the method, including the directions and distances to other public land survey corners used as evidence or used for proportioning in determining the corner location?

Corner restored by proportionate method.

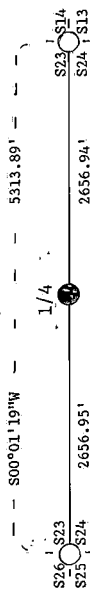

- (1) I, John Schulke


(type or print name) certify that the corner location shown on this record was determined by me or under my direction and control and that this U.S. Public Land Survey Monument Record is correct and complete to the best of my knowledge and belief.

John Schulke  
Signature

12/12/88  
Date

Certificate ready for filing: Dale S. Staeger

District Ranger

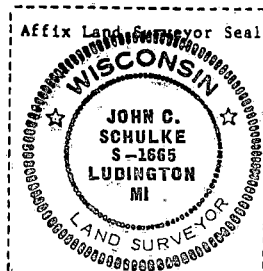

## CERTIFIED LAND CORNER RESTORATION

State of Wisconsin

County of Forest

} ss.

I Milo E. Stefan, do hereby certify that on the 22 day of October, 1980, I found evidence of the Southwest corner of Section 20 Township 36 North, Range 16 East, Fourth Principal Meridian, as described hereon; and that from this evidence I established a new monument and accessories as described hereon to perpetuate the original location of this corner:

Description of original monument and accessories and subsequent restorations:

Surveyed by James McBride in July 1858.

Set Wood Post.

Fir, 6", N37°W, 14 links

Cedar, 12", N80°W, 49 links

Fir, 8", S42°E, 26 links

Fir, 8", S38°W, 11 links.

Description of corner evidence found:

Location poster on fallen Balsam tree

Balsam stump, 12" - 14", N37°W, 9.2 feet

Cedar, 14", N80°W, 32.5 feet

Balsam stump very rotted, S42°E, 15.8 feet

Balsam stump very rotted, S38°W, 7.3 feet.

Description of monument and accessories I established to perpetuate the location of this corner:

At corner position set a 2 inch by 30 inch aluminum monument with cap stamped: T36N, R16E, S19, S20, S30, S29, 1980, R.L.S. 1558.

From which the following bear:

Cedar, 12", S80°E, 6.28 feet

Balsam, 10", S1°E, 10.55 feet

Cedar, 12", S77°W, 72.08 feet


W. Spruce, 9", N60°W, 45.15 feet.

DOCUMENT NO.

119865



43616190000

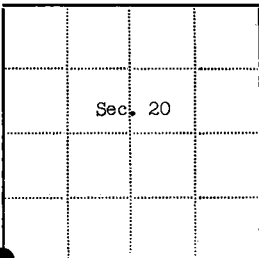

● - Corner monument restored

□ -

Resident witnesses.....

Dated at Laona Wisconsin, this 3 day of November 1980

Signature Milo E. Stefan Title Land Surveyor  
(County Surveyor, Registered Land Surveyor, or other duly authorized official)

Surveyors Registration No. 1558Office of Register of Deeds County of Forest

I hereby certify that the within instrument was filed in this office for record on the 2nd day of June, 1981, and was filed in Book No. \_\_\_\_\_ Page No. \_\_\_\_\_ of County Records.

Signature Regina Stetson Title Register of Deeds

Township 36N, Range 16E, Section 20, Index No. R-5, Page No. \_\_\_\_\_

R 5


## U. S. PUBLIC LAND SURVEY MONUMENT RECORD

**INSTRUCTIONS:** This record shall show the location of the corner and shall include all of the following nine elements (a through i).

- (a) Identify the corner by reference to the U.S. public land survey system.

○ = Corner monument restored.

Section corner to Sections 20, 21, 28, and 29,  
T.36N., R.16E.

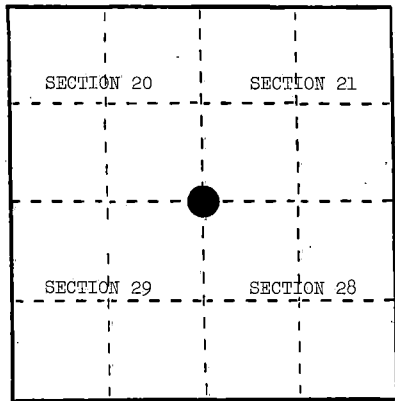

- (b) Describe any record evidence, monument evidence, occupational evidence, testimonial evidence or any other material evidence you considered, and whether the monument was found or placed.

In 1858, James McBride set wood post with the following BTs: Spruce, 10", N.45°W., 14 links; Fir, 6", N.68°E., 28 links; Cedar, 10", S.62°E., 19 links; Cedar, 10", S.48°W., 10 links.


In 1926, Goodman Company found 4" Cedar post. They set a flue pipe 16" above ground. Spruce stump, N.60°W., 14 links, dead Cedar, S.40°E., 19 links (stumps reversed).

October 24, 1984, Alan Harrison found 4" squared and scribed post; 2" iron pipe; N.60°W., 9.24', found Spruce stump; S.40°E., 12.54', Cedar stump; N.68°E., 18.48' stump depression; S.48°W., 6.6', stump mound.

- (c) In the plan view drawing below, provide reference ties to at least 4 witness monuments, or, if the location is within a municipality, to at least 2 witness monuments. (Witness monuments shall be made of concrete, natural stone, iron or other equally durable material.)  
Describe witness monuments.

- (d) Show a plan view drawing depicting the relevant monuments and reference ties which is sufficient in detail to enable accurate relocation of the corner monument if the corner monument is disturbed. Indicate north.

- 2" x 36" aluminum monument stamped to identify the corner.
- White Birch, 6", N.48°E., 48.13'
- Black Ash, 4", N.85°E., 29.84'
- Balsam, 7", S.88°W., 4.55'
- Cedar, 12", N.27°W., 16.68'
- Steel Sign Post, South, 1.45'

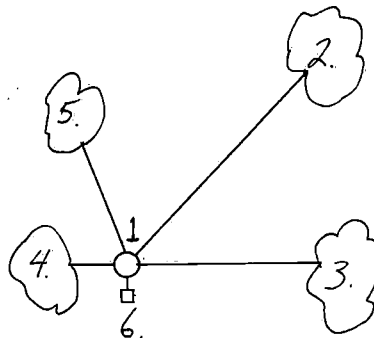

REGISTER'S OFFICE }  
Forest County, Wis. }

Received for record this... 23rd day  
of January... A.D., 1985  
at 9:00 o'clock... A.M. and

recorded in Vol. CORNER RESTORATION  
on page R-9

*John H. Mecklenheimer*  
REGISTER

43616200000

- (e) Describe any material discrepancy between the location of the corner as restored or reestablished and the location of that corner as previously restored or reestablished by distance and direction. Show the discrepancy on the plan view drawing under (d), above. Show the distances between the corner as previously restored or reestablished and (1) the corner as restored or reestablished, and (2) to at least 2 of the witness monuments shown on the drawing in (d), above.


None.

- (f) Was the corner restored through acceptance of (1) an obliterated evidence location, or, (2) a found perpetuated location?

(2) a found perpetuated location.

- (g) Was the corner reestablished through lost corner proportionate methods? If so, show the method, including the directions and distances to other public land survey corners used as evidence or used for proportioning in determining the corner location?

No.

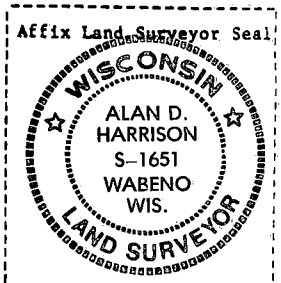

- (1) I, Alan D. Harrison  
(Type or print name) certify that the corner location shown on this record was determined by me or under my direction and control and that this U.S. Public Land Survey Monument Record is correct and complete to the best of my knowledge and belief.

Alan D. Harrison 12/14/84  
Signature Date


Register

U. S. PUBLIC LAND SURVEY MONUMENT RECORD

INSTRUCTIONS: This record shall show the location of the corner and shall include all of the following nine elements (a through i).

- (a) Identify the corner by reference to the U.S. public land survey system.  
O = Corner monument restored.

Quarter Corner to Sections 21 and 28, T.36N., R.16E.

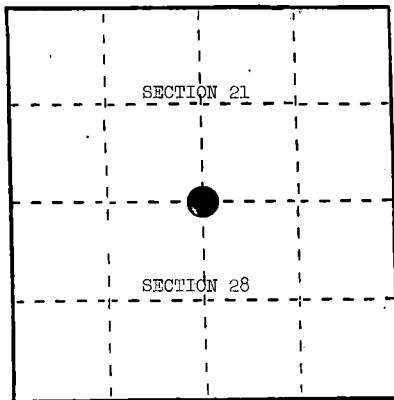

REGISTER'S OFFICE  
Forest County, Wis.

Received for record this 17th day

of March, A.D., 1986, at

10:40 o'clock A.M. and recorded

in Vol. CORNER RESTORATIONS

page 8-11

*Paul Hochstetler*  
Register of Deeds

- (b) Describe any record evidence, monument evidence, occupational evidence, testimonial evidence or any other material evidence you considered, and whether the monument was found or placed.

In 1858, James McBride set wood post with the following BTs: Sugar, 10", S.65°E., 32 links; Sugar, 6", N.24°W., 13 links.

In 1926, Goodman Lumber Company set a flue pipe 20" high in place of 4" Maple post set by Blackwell Company. Maple stump, 11", N.20°W., 10 links.


February, 1985, H. Neider found flue pipe and a Basswood, southeast, with old Forest Service tag.

June 10, 1985, Alan Harrison found a 2" iron pipe with post hole alongside. At S.65°E., 21.21 feet is a Sugar stump and at N.24°W., 8.58 feet is a stump depression.

- (c) In the plan view drawing below, provide reference ties to at least 4 witness monuments, or, if the location is within a municipality, to at least 2 witness monuments. (Witness monuments shall be made of concrete, natural stone, iron or other equally durable material.)  
Describe witness monuments.

- (d) Show a plan view drawing depicting the relevant monuments and reference ties which is sufficient in detail to enable accurate relocation of the corner monument if the corner monument is disturbed. Indicate north.

1. 2" x 36" aluminum monument stamped to identify the corner.
2. Sugar, 7", N.54°E., 25.70 feet
3. Sugar, 6", S.87°W., 59.81 feet
4. Sugar, 7", N.30°W., 57.36 feet
5. Steel Sign Post, Southeast, 1.40 feet

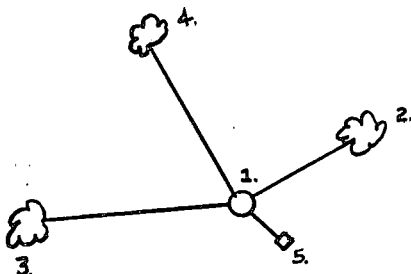

(e) Describe any material discrepancy between the location of the corner as restored or reestablished and the location of that corner as previously restored or reestablished by distance and direction. Show the discrepancy on the plan view drawing under (d), above. Show the distances between the corner as previously restored or reestablished and (1) the corner as restored or reestablished, and (2) to at least 2 of the witness monuments shown on the drawing in (d), above.

None.

(f) Was the corner restored through acceptance of (1) an obliterated evidence location, or, (2) a found perpetuated location?

(2) a found perpetuated location.

(g&h) Was the corner reestablished through lost corner proportionate methods? If so, show the method, including the directions and distances to other public land survey corners used as evidence or used for proportioning in determining the corner location?


No.

(i) I, Alan D. Harrison

(Type or print name) certify that the corner location shown on this record was determined by me or under my direction and control and that this U.S. Public Land Survey Monument Record is correct and complete to the best of my knowledge and belief.

Alan D. Harrison  
Signature

1/3/86  
Date

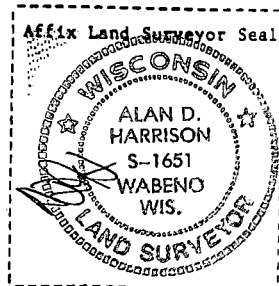

## U. S. PUBLIC LAND SURVEY MONUMENT RECORD

INSTRUCTIONS: This record shall show the location of the corner and shall include all of the following nine elements (a through i).

- (a) Identify the corner by reference to the U.S. public land survey system.

O = Corner monument restored.


Section corner to Sections 21, 22, 27, and 28,  
T.36N., R.16E.

REGISTER'S OFFICE }  
Forest County, Wis.

Received for record this 17<sup>th</sup> day  
of March, A.D., 1986, at  
10:42 o'clock A.M. and recorded  
in Vol. CORNER RESTORATIONS

page R-13

Sail Aschenbrenner  
Register of Deeds

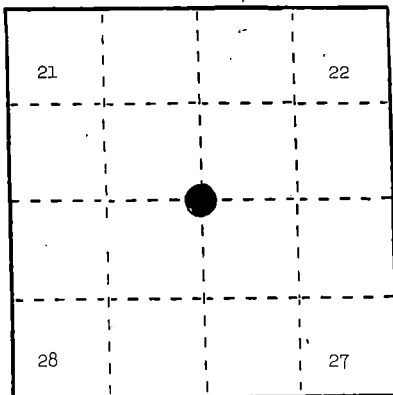

- (b) Describe any record evidence, monument evidence, occupational evidence, testimonial evidence or any other material evidence you considered, and whether the monument was found or placed.

In 1858, James McBride set wood post with the following BTs: Birch, 7", N.36°W., 36 links; Birch, 7", N.49°E., 24 links; Birch, 8", S.38°E., 26 links; Sugar, 10", S.37°W., 24 links.


May, 1925, Goodman Lumber Company found corner and set 5" Cedar post and flue pipe. Found original BTs as follows: Birch, 10", S.38°E., 26 links; Sugar, 16", S.37°W., 24 links.

June 10, 1985, Alan Harrison found 2" flue pipe in rock pile from which the following bear: stump hole, N.49°E., 15.84 feet; Birch stump, 12-14", S.38°E., 17.16 feet; Sugar stump, 20", S.37°W., 15.84 feet.

- (c) In the plan view drawing below, provide reference ties to at least 4 witness monuments, or, if the location is within a municipality, to at least 2 witness monuments. (Witness monuments shall be made of concrete, natural stone, iron or other equally durable material.)  
Describe witness monuments.

- (d) Show a plan view drawing depicting the relevant monuments and reference ties which is sufficient in detail to enable accurate relocation of the corner monument if the corner monument is disturbed. Indicate north.

1. 2" x 36" aluminum monument stamped to identify the corner.
2. Basswood, 9", N.28°E., 29.46 feet
3. Basswood, 6", S.65°E., 17.12 feet
4. Sugar, 8", S.12°W., 34.60 feet
5. Sugar, 6", N.44°W., 49.83 feet
6. Steel Sign Post, South, 1.64 feet

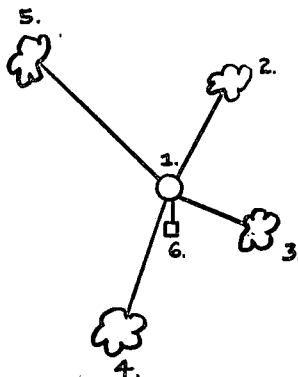

(e) Describe any material discrepancy between the location of the corner as restored or reestablished and the location of that corner as previously restored or reestablished by distance and direction. Show the discrepancy on the plan view drawing under (d), above. Show the distances between the corner as previously restored or reestablished and (1) the corner as restored or reestablished, and (2) to at least 2 of the witness monuments shown on the drawing in (d), above.

None.

(f) Was the corner restored through acceptance of (1) an obliterated evidence location, or, (2) a found perpetuated location?

(2) a found perpetuated location.


(g&h) Was the corner reestablished through lost corner proportionate methods? If so, show the method, including the directions and distances to other public land survey corners used as evidence or used for proportioning in determining the corner location?

No.

(1) I, Alan D. Harrison

(type or print name) certify that the corner location shown on this record was determined by me or under my direction and control and that this U.S. Public Land Survey Monument Record is correct and complete to the best of my knowledge and belief.

Alan D. Harrison 1/3/86  
Signature Date

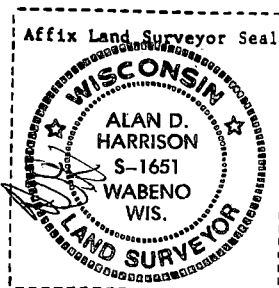

DOCUMENT NUMBER 132696


## U. S. PUBLIC LAND SURVEY MONUMENT RECORD

INSTRUCTIONS: This record shall show the location of the corner and shall include all of the following nine elements (a through i).

- (a) Identify the corner by reference to the U.S. public land survey system.

○ = Corner monument restored.

Witness Corner to Quarter Corner to Sections 22 and 27, Township 36 North, Range 16 East, Forest County, Wisconsin.

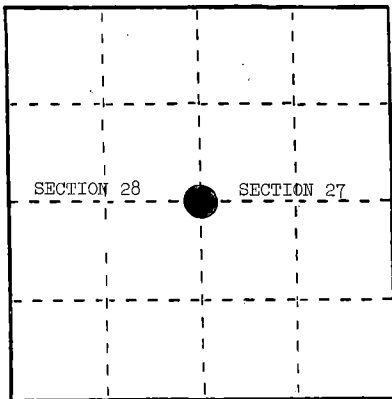

REGISTER'S OFFICE  
Forest County, Wis.

Received for record this 1st day  
of April A.D., 1987, at  
9:30 o'clock A.M. and recorded  
in Vol. CORNER RESTORATIONS

Page R-15

Paul Aschenbrenner  
Register of Deeds

- (b) Describe any record evidence, monument evidence, occupational evidence, testimonial evidence or any other material evidence you considered, and whether the monument was found or placed.

In 1858, James McBride set a wood post with the following B.T.s: Cedar, 8", S.24°E., 10 links; Cedar, 8", N.6°E., 13 links.


In 1925, Goodman Lumber Company found the following: dead Cedar, 8", S.24°E., 9 links; dead Cedar, 8", N.6°E., 13 links. Set 3" Cedar post and 1½" x 32" lead pipe 2 feet from water's edge.

In 1987, Alan Harrison (RLS) found the following: 1½" iron pipe lying in water; blazed, dead Cedar lying on ground with Conservation Department tag, which is probably an original Cedar; 40" Pine stump scribed S½ W.C. B.T. Set corner position at S.6°W., 8.58 feet from Cedar with Conservation Department tag attached.

- (c) In the plan view drawing below, provide reference ties to at least 4 witness monuments, or, if the location is within a municipality, to at least 2 witness monuments. (Witness monuments shall be made of concrete, natural stone, iron or other equally durable material.)  
Describe witness monuments.

- (d) Show a plan view drawing depicting the relevant monuments and reference ties which is sufficient in detail to enable accurate relocation of the corner monument if the corner monument is disturbed. Indicate north.

- 2" x 36" aluminum monument with tablet stamped to identify corner.
- Red Maple, 8", N.51°E., 28.48 feet
- Balsam, 9", N.88°E., 5.53 feet
- Red Maple, 6", S.18°E., 22.68 feet
- Steel Sign Post, Northwest, 0.92 feet

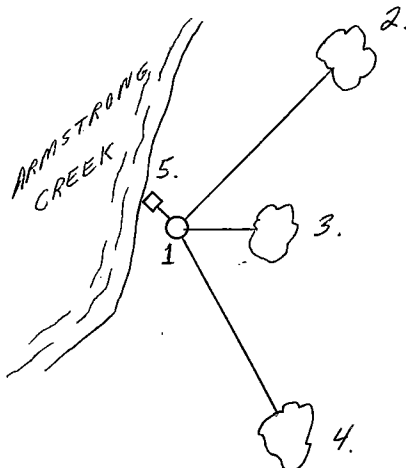

- (e) Describe any material discrepancy between the location of the corner as restored or reestablished and the location of that corner as previously restored or reestablished by distance and direction. Show the discrepancy on the plan view drawing under (d), above. Show the distances between the corner as previously restored or reestablished and (1) the corner as restored or reestablished, and (2) to at least 2 of the witness monuments shown on the drawing in (d), above.

None.

- (f) Was the corner restored through acceptance of (1) an obliterated evidence location, or, (2) a found perpetuated location?

(2) a found perpetuated location.

- (g&h) Was the corner reestablished through lost corner proportionate methods? If so, show the method, including the directions and distances to other public land survey corners used as evidence or used for proportioning in determining the corner location?


No.

- (i) I, Alan D. Harrison  
(type or print name) certify that the corner location shown on this record was determined by me or under my direction and control and that this U.S. Public Land Survey Monument Record is correct and complete to the best of my knowledge and belief.

Signature

Date

Alan D. Harrison 4/16/87

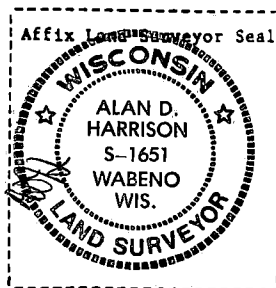

## U. S. PUBLIC LAND SURVEY MONUMENT RECORD

## INSTRUCTIONS:

This record shall show the location of the corner and shall include all of the following nine elements (a through i).

- (a) Identify the corner by reference to the U.S. public land survey system.

○ = Corner monument restored.

Section corner to Sections 22, 23, 26 & 27  
T. 36N. R. 16E.  
Forest Co. Wisconsin

REGISTER'S OFFICE  
Forest County, Wis.

Received for record this 29<sup>th</sup> day

of March A.D. 1987 at


9:00 o'clock A.M. and recorded

in Vol. CORNER RESTORATIONS

page 17

Paul Hochstetler

Register of Deeds

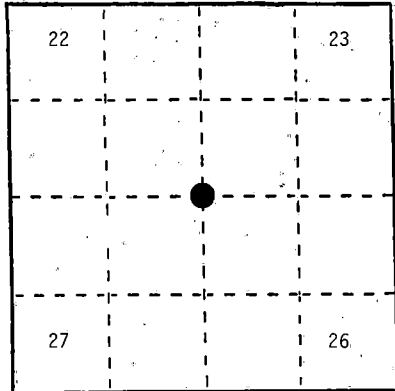

- (b) Describe any record evidence, monument evidence, occupational evidence, testimonial evidence or any other material evidence you considered, and whether the monument was found or placed.

In 1858, James McBride set a wood post with the following BTs: Hemlock, 12", N.30W., 17.82 feet; Tamarack, 8", N.40E., 21.12 feet; Birch, 10", S.32E., 30.36 feet; Hemlock, 8", S.13W., 25.00 feet.

In 1923, Goodman Company Set 5" Hemlock post, original Birch is alive, other BTs dead. Set 5 foot flue pipe.

In 1934, John Laird found iron pipe. Put location poster on a Maple stump 26" from which the corner bears S.30E., 1.5 chains.

In 1987, Al Harrison found "874" tag and flue pipe laying by a large Maple stump remains.


Pulled S30E 99' to corner location, found a post hole. From post hole S. 32E., 30.4 feet, Found a Birch stump 15"+. At N. 40E., 21.1 feet a Tamarack stump. Accept as corner location.

In 1988, Don Huettl found Northeast BT tipped out, added new BT. Aspen, 5", N.12W., 17.53 feet.

- (c) In the plan view drawing below, provide reference ties to at least 4 witness monuments, or, if the location is within a municipality, to at least 2 witness monuments. (Witness monuments shall be made of concrete, natural stone, iron or other equally durable material.)  
Describe witness monuments.

- (d) Show a plan view drawing depicting the relevant monuments and reference ties which is sufficient in detail to enable accurate relocation of the corner monument if the corner monument is disturbed. Indicate north.

1. A 2 1/2 x 36" aluminum monument stamped to identify the corner.
2. Spruce, 3", S.48E., 29.18 feet.
3. Aspen, 8", S.05E., 4.04 feet.
4. Aspen, 7", S.68W., 7.95 feet.
5. Aspen, 5", N.12W., 17.53 feet.
6. Steel Sign Post, Northwest, 1.15 feet.

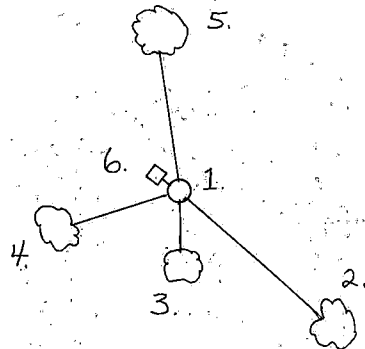

- (e) Describe any material discrepancy between the location of the corner as restored or reestablished and the location of that corner as previously restored or reestablished by distance and direction. Show the discrepancy on the plan view drawing under (d), above. Show the distances between the corner as previously restored or reestablished and (1) the corner as restored or reestablished, and (2) to at least 2 of the witness monuments shown on the drawing in (d), above.


None

- (f) Was the corner restored through acceptance of (1) an obliterated evidence location, or, (2) a found perpetuated location?

(2) A found perpetuated location.

- (g&h) Was the corner reestablished through lost corner proportionate methods? If so, show the method, including the directions and distances to other public land survey corners used as evidence or used for proportioning in determining the corner location?

No.

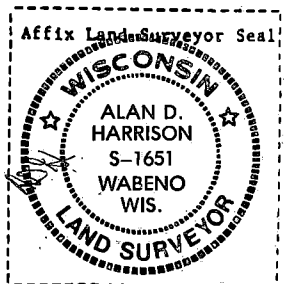

- (i) I, Alan D. Harrison  
(Type or print name) certify that the corner location shown on this record was determined by me or under my direction and control and that this U.S. Public Land Survey Monument Record is correct and complete to the best of my knowledge and belief.

Signature

Date

Certificate ready for filing:

Doris Hagg  
District Ranger

DOCUMENT NUMBER 133450

## U. S. PUBLIC LAND SURVEY MONUMENT RECORD

INSTRUCTIONS: This record shall show the location of the corner and shall include all of the following nine elements (a through i).

- (a) Identify the corner by reference to the U.S. public land survey system.

○ = Corner monument restored.


Section Corner to Sections 22-23-26-27, T.36N., R.16E., Forest County, Wisconsin.

REGISTER'S OFFICE  
Forest County, Wis.

Received for record this 10<sup>th</sup> day  
of August A.D., 1987 at  
8:45 o'clock A.M. and recorded  
in Vol. CORNER RESTORATIONS

PAGE R-17

Paul R. Schenck  
Register of Deeds

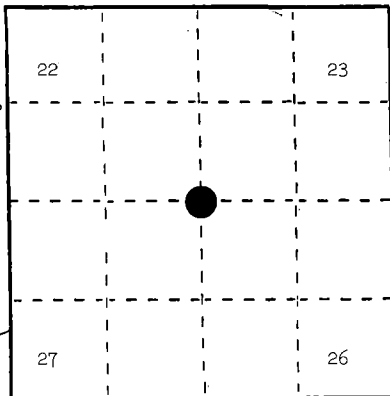

- (b) Describe any record evidence, monument evidence, occupational evidence, testimonial evidence or any other material evidence you considered, and whether the monument was found or placed.

In 1858, James McBride set wood post with the following BTs: Hemlock, 12", N.30°W., 27 links; Tamarack, 8", N.40°E., 32 links; Birch, 10", N.32°E., 46 links; Hemlock, 8", S.13°W., 38 links.

In 1923, Goodman Company set 5" Hemlock post and flue pipe 5' high. Original Birch BT alive, but all others dead.


In 1934, John Laird "874" found iron pipe and put location tag on Maple stump, 26", S.30°E., 99 feet.

In 1987, Alan Harrison found 5' flue pipe and location tag. Pulled to corner position and found post hole. From post hole, pulled S.32°E., 30.36 feet, found 15" Birch stump, pulled N.30°W., 17.8 feet, found root holes of tree, pulled N.40°E., 21.1 feet, found Tamarack stump. Appears someone pulled pipe and set it by location poster years ago.

- (c) In the plan view drawing below, provide reference ties to at least 4 witness monuments, or, if the location is within a municipality, to at least 2 witness monuments. (Witness monuments shall be made of concrete, natural stone, iron or other equally durable material.)  
Describe witness monuments.

- (d) Show a plan view drawing depicting the relevant monuments and reference ties which is sufficient in detail to enable accurate relocation of the corner monument if the corner monument is disturbed. Indicate north.

1. A 2½" x 36" aluminum monument stamped to identify the corner.
2. Aspen, 6", N.83°E., 9.51 feet.
3. Spruce, 3", S.48°E., 29.18 feet.
4. Aspen, 8", S.05°E., 4.04 feet.
5. Aspen, 7", S.68°W., 7.95 feet.
6. Steel Sign Post, 6', Northwest, 1.15 feet.

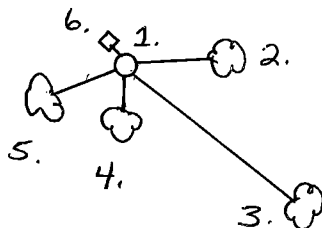

- (e) Describe any material discrepancy between the location of the corner as restored or reestablished and the location of that corner as previously restored or reestablished, by distance and direction. Show the discrepancy on the plan view drawing under (d), above. Show the distances between the corner as previously restored or reestablished and (1) the corner as restored or reestablished, and (2) to at least 2 of the witness monuments shown on the drawing in (d), above.

None.

- (f) Was the corner restored through acceptance of (1) an obliterated evidence location, or, (2) a found perpetuated location?

(2) a found perpetuated location.

- (g&h) Was the corner reestablished through lost corner proportionate methods? If so, show the method, including the directions and distances to other public land survey corners used as evidence or used for proportioning in determining the corner location?


No.

FILED  
JUN 10 1963  
FBI - WABENO

- (i) I, Alan D. Harrison  
(type or print name) certify that the corner location shown on this record was determined by me or under my direction and control and that this U.S. Public Land Survey Monument Record is correct and complete to the best of my knowledge and belief.

Alan D. Harrison  
Signature

8/5/87  
Date

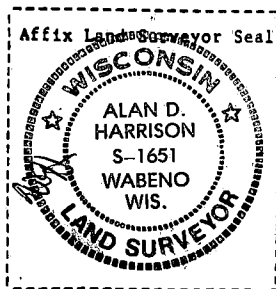

# U. S. PUBLIC LAND SURVEY MONUMENT RECORD.


## INSTRUCTIONS:

This record shall show the location of the corner and shall include all of the following nine elements (a through i).

- (a) Identify the corner by reference to the U.S. public land survey system.

○ = Corner monument restored.

Quarter Corner Common to Sections 23 and 26,  
T36N, R16E, Forest County, Wisconsin.

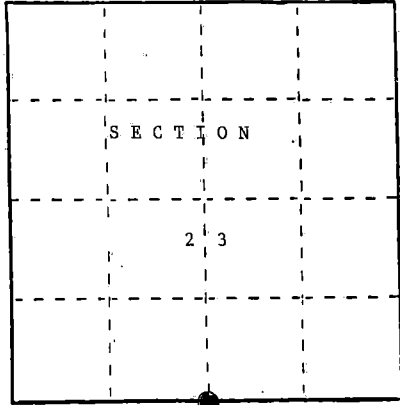

REGISTER'S OFFICE  
Forest County, Wis.

Received for record this 9th day  
of December, A.D., 1988 at

2:50 o'clock P. M. and recorded  
in Vol. CORNER RESTORATIONS

page R-19

Paul A. Schaeffer  
Register of Deeds

- (b) Describe any record evidence, monument evidence, occupational evidence, testimonial evidence or any other material evidence you considered, and whether the monument was found or placed.

In 1858, James McBride set a wood post for the corner and the following corner references:  
Ironwood 8" N17°E 28 lks. Elm 6" S27°W 31 lks.


In 1926, Goodman Lumber Company found no evidence.

In 1988, John Schulke found no evidence. Placed 2 1/2" dia. X 36" aluminum monument.

- (c) In the plan view drawing below, provide reference ties to at least 4 witness monuments, or, if the location is within a municipality, to at least 2 witness monuments. (Witness monuments shall be made of concrete, natural stone, iron or other equally durable material.)  
Describe witness monuments.

- (d) Show a plan view drawing depicting the relevant monuments and reference ties which is sufficient in detail to enable accurate relocation of the corner monument if the corner monument is disturbed.  
Indicate north.

1. 2 1/2" dia. X 36" aluminum magnetic cap monument stamped to identify the corner.
2. Sugar Maple 7" S04°E 12.66 feet
3. Sugar Maple 9" N77°W 24.55 feet
4. Sugar Maple 7" S46°W 35.67 feet
5. Sugar Maple 10" N67°E 22.05 feet
6. Steel sign post Southwest 1.0 feet

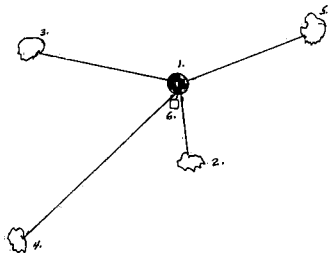

43616230020

36-26

R-19

- (e) Describe any material discrepancy between the location of the corner as restored or reestablished and the location of that corner as previously restored or reestablished by distance and direction. Show the discrepancy on the plan view drawing under (d), above. Show the distances between the corner as previously restored or reestablished and (1) the corner as restored or reestablished, and (2) to at least 2 of the witness monuments shown on the drawing in (d), above.



NO Discrepancy, first corner restoration.

- (f) Was the corner restored through acceptance of (1) an obliterated evidence location, or, (2) a found perpetuated location?

No, see g and h.

- (g&h) Was the corner reestablished through lost corner proportionate methods? If so, show the method, including the directions and distances to other public land survey corners used as evidence or used for proportioning in determining the corner location?

Corner restored by proportionate method.

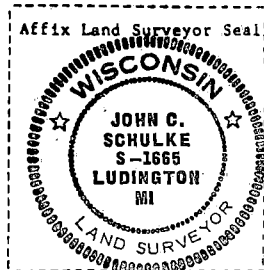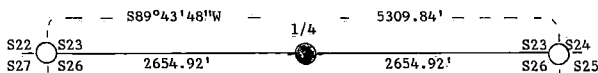

- (1) I, John Schulke  
(Type or print name) certify that the corner location shown on this record was determined by me or under my direction and control and that this U.S. Public Land Survey Monument Record is correct and complete to the best of my knowledge and belief.

John Schulke 12/2/88  
Signature Date  
Certificate ready for filing: Dale S. Stange  
District Ranger

## U. S. PUBLIC LAND SURVEY MONUMENT RECORD


## INSTRUCTIONS:

This record shall show the location of the corner and shall include all of the following nine elements (a through i).

- (a) Identify the corner by reference to the U.S. public land survey system.

O = Corner monument restored.

Section corner to Sections 23, 24, 25, and 26,  
T.36N., R.16E.

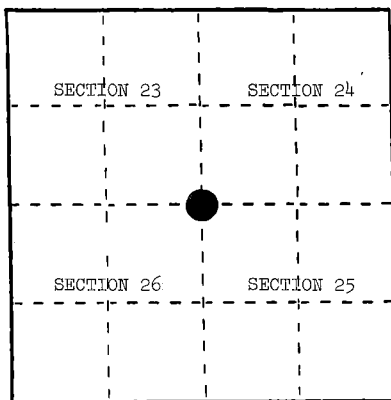

- (b) Describe any record evidence, monument evidence, occupational evidence, testimonial evidence or any other material evidence you considered, and whether the monument was found or placed.


In 1858, James McBride set post with the following BTs: Sugar, 8", N.12°W., 9 links; Birch, 10", N.48°E., 50 links; Sugar, 10", S.78°E., 35 links; Linn, 10", S.33°W., 49 links. October, 1925, Goodman Company found Elm post by J. Jenkins, set flue pipe 15" high, Sugar, 17", N.12°W., 9 links.

October 11, 1984, Alan Harrison found iron pipe, as per Goodman notes and 3" x 4" scribed Cedar post. From pipe, found the following: Stump hole, N.12°W., 5.94'; stump hole, S.78°E., 23.10', stump hole, S.33°W., 32.3'; nothing found at N.48°E., 33.0'.

- (c) In the plan view drawing below, provide reference ties to at least 4 witness monuments, or, if the location is within a municipality, to at least 2 witness monuments. (Witness monuments shall be made of concrete, natural stone, iron or other equally durable material.) Describe witness monuments.

- (d) Show a plan view drawing depicting the relevant monuments and reference ties which is sufficient in detail to enable accurate relocation of the corner monument if the corner monument is disturbed. Indicate north.

1. 2" x 30" aluminum monument stamped to identify the corner.
2. Sugar, 5", N.26°E., 91.97'
3. Basswood, 6", S.48°E., 50.17'
4. Basswood, 6", S.71°W., 20.24'
5. Basswood, 10", N.14°W., 74.49'
6. Steel Sign Post, East, 1.48'

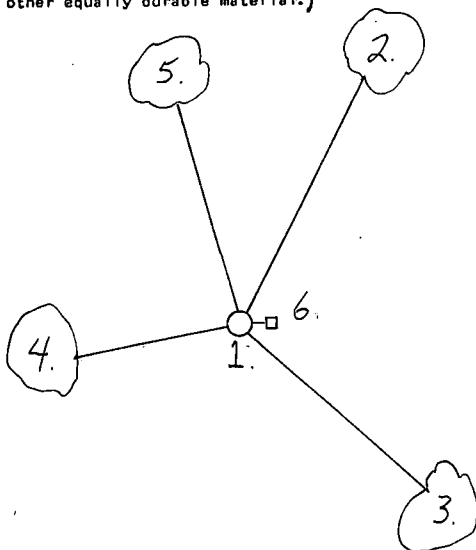

REGISTER'S OFFICE }  
Forest County, Wis. }

Received for record this... 23rd day

of... January... A.D., 1985

at... 9:00 o'clock... A.M. and

recorded in Vol. 21, CORNER... RESTORATION

on page 10

By: [Signature] REGISTER

43616230000

R-21

R21

- (e) Describe any material discrepancy between the location of the corner as restored or reestablished and the location of that corner as previously restored or reestablished by distance and direction. Show the discrepancy on the plan view drawing under (d), above. Show the distances between the corner as previously restored or reestablished and (1) the corner as restored or reestablished, and (2) to at least 2 of the witness monuments shown on the drawing in (d), above.

None.

- (f) Was the corner restored through acceptance of (1) an obliterated evidence location, or, (2) a found perpetuated location?

(2) a found perpetuated location.

- (g&h) Was the corner reestablished through lost corner proportionate methods? If so, show the method, including the directions and distances to other public land survey corners used as evidence or used for proportioning in determining the corner location?


No.

(1) Alan D. Harrison

(Type or print name) certify that the corner location shown on this record was determined by me or under my direction and control and that this U.S. Public Land Survey Monument Record is correct and complete to the best of my knowledge and belief.

Alan D. Harrison  
Signature

12/14/84  
Date

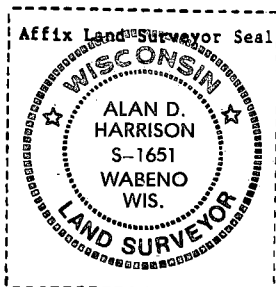

# U.S. PUBLIC LAND SURVEY MONUMENT RECORD


Index No. R-23

State of Wisconsin }  
County of Forest } ss.

I, Gary L. Pisoni, do hereby certify that on the 30th day of March, 1994, I found evidence of the South Quarter corner of Section 24 Township 36, North, Range 16 East, Fourth Principal Meridian, as described hereon; and that from this evidence I established a new monument and accessories as described hereon to perpetuate the original location of this corner.

Resident witnesses:

.....  
.....  
.....

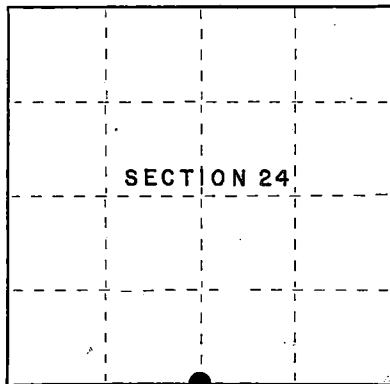

● = Corner monument restored.

History of original corner establishment:

Original Government Survey in 1858 by James McBride. West corrected between Sections 24 and 25 at 40.00 chains, set Quarter Section post from which the following bear: Sugar, 10", S 10°E, 20 lks; Sugar, 12", N 06°E, 27 lks.

Description of corner evidence found:

No original corner evidence found.

I re-established the corner position at proportionate distance and on line between the Southwest and Southeast Section corners of Section 24.

Description of monument and accessories I established to perpetuate the original location of this corner.

At the corner position, set a 2½" x 36" aluminum pipe monument with an aluminum cap stamped; T36N, R16E, 1/4, S.24, S.25, 1994, S-1634; from which the following new blazed and scribed bearing trees bear: (all measurement taken to a nail in side of tree)

Sugar Maple	7"	N 20°W.	24.48 feet
Sugar Maple	7"	N 39°E	18.66 feet
White Ash	8"	S 60°E	29.19 feet
Basswood	6"	S 10°E	43.90 feet
Steel sign post		S 38°W	0.94 feet

Dated at Iron River, MI, Wis., this 26th day of May, 1995

Signature Gary L. Pisoni Title Land Surveyor Registration No. S-1634  
(County Surveyor, Registered Land Surveyor, or other duly authorized official)

Office of Register of Deeds, County of Forest, I hereby certify that the within instrument was filed in this office for record on the 10th day of March, 1997 at 1:30 o'clock P M.

(Register of Deeds)


By Gail Trevising Deputy

(e) Describe any material discrepancy between the location of the corner as restored or reestablished and the location of that corner as previously restored or reestablished by distance and direction. Show the discrepancy on the plan view drawing under (d), above. Show the distances between the corner as previously restored or reestablished and (1) the corner as restored or reestablished, and (2) to at least 2 of the witness monuments shown on the drawing in (d), above.

None

(f) Was the corner restored through acceptance of (1) an obliterated evidence location, or, (2) a found perpetuated location?

(g&h) Was the corner reestablished through lost corner proportionate methods? If so, show the method, including the directions and distances to other public land survey corners used as evidence or used for proportioning in determining the corner location?  
Re-established through lost corner proportionate methods.

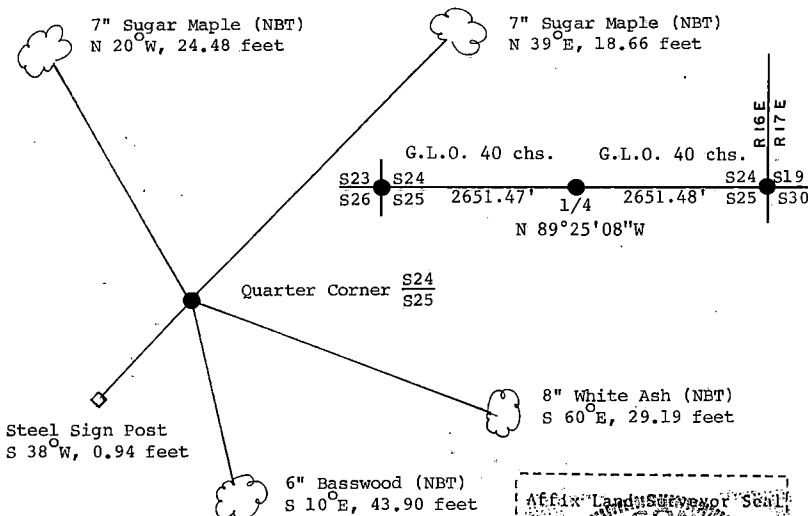

Gary L. Pisoni

(i) I, Gary L. Pisoni (type or print name) certify that the corner location shown on this record was determined by me or under my direction and control and that this U.S. Public Land Survey Monument Record is correct and complete to the best of my knowledge and belief.



Signature

Date

10-2-95

## U. S. PUBLIC LAND SURVEY MONUMENT RECORD


## INSTRUCTIONS:

This record shall show the location of the corner and shall include all of the following nine elements (a through i).

- (a) Identify the corner by reference to the U.S. public land survey system.

○ = Corner monument restored.

Section Corner to Sections 19-30-24-25,  
Township 36 North, Ranges 16-17 East,  
Forest-Marinette Counties, Wisconsin.

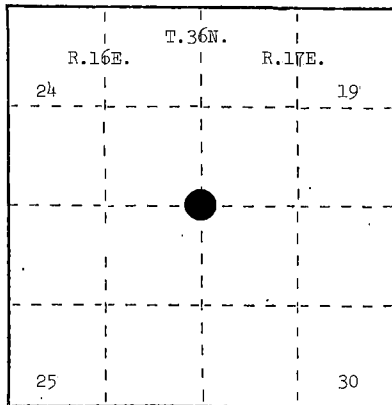


- (b) Describe any record evidence, monument evidence, occupational evidence, testimonial evidence or any other material evidence you considered, and whether the monument was found or placed.

Corner position found marked by a 4" iron pipe with Marinette County brass cap, as set by Frank Gould and Bernard Hammes in 1936-1937. They found the original bearing trees burnt out and an old post.

- (c) In the plan view drawing below, provide reference ties to at least 4 witness monuments, or, if the location is within a municipality, to at least 2 witness monuments. (Witness monuments shall be made of concrete, natural stone, iron or other equally durable material.)  
Describe witness monuments.

- (d) Show a plan view drawing depicting the relevant monuments and reference ties which is sufficient in detail to enable accurate relocation of the corner monument if the corner monument is disturbed. Indicate north.

1. Aspen, 4", N.79°E., 94.81 feet
2. Spruce, 8", S.72°E., 128.00 feet
3. Cherry, 3", S.70°W., 102.56 feet
4. Cherry, 10", N.34°W., 73.45 feet
5. Steel Sign Post, South, 1.85 feet

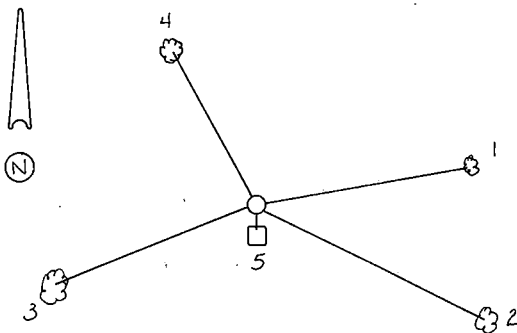

REGISTER'S OFFICE }  
Forest County, Wis. }

Received for record this 1st day  
of April 1935 A.D., 1935 at  
2:05 o'clock P.M. and

recorded in Vol. CORNER RESTORATIONS  
on page R-25

Paul A. Schrammer  
REGISTER

e) Describe any material discrepancy between the location of the corner as restored or reestablished and the location of that corner as previously restored or reestablished by distance and direction. Show the discrepancy on the plan view drawing under (d), above. Show the distances between the corner as previously restored or reestablished and (1) the corner as restored or reestablished, and (2) to at least 2 of the witness monuments shown on the drawing in (d), above.

None.

(f) Was the corner restored through acceptance of (1) an obliterated evidence location, or, (2) a found perpetuated location?

Found perpetuated location.

(g&h) Was the corner reestablished through lost corner proportionate methods? If so, show the method, including the directions and distances to other public land survey corners used as evidence or used for proportioning in determining the corner location?

No.

(i) I, Milo E. Stefan  
(type or print name) certify that the corner location shown on this record was determined by me or under my direction and control and that this U.S. Public Land Survey Monument Record is correct and complete to the best of my knowledge and belief.

Milo E. Stefan  
Signature

12/31/84  
Date




## U. S. PUBLIC LAND SURVEY MONUMENT RECORD

## INSTRUCTIONS:

This record shall show the location of the corner and shall include all of the following nine elements (a through i).

- (a) Identify the corner by reference to the U.S. public land survey system.  
 O = Corner monument restored.

Quarter corner common to sections 29 and 30,  
 T.36N., R.16E. Forest County, Wisconsin.

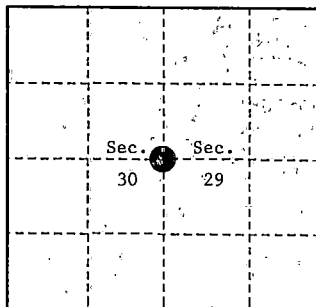

- (b) Describe any record evidence, monument evidence, occupational evidence, testimonial evidence or any other material evidence you considered, and whether the monument was found or placed.

In 1858 James McBride set a wood post with the following B.T.'s: Aspen, 10", N.59°E., 13 links (8.58 feet), Aspen, 10", N.57°W., 12 links (7.92 feet), 1.90 chains North, stream 100 links wide, runs East.

In 1911 J. Melindy found the corner position and set a 4"x4" Hemlock Post. Original bearing trees are down and decayed. Made new B.T.'s: Maple, 14", S.62-3/4W., 22 5/8 links (14.93 feet); Birch, 13", N.22°E., 36 1/4 links (23.925 feet), Birch, 10", S. 42 1/2 E., 41 1/2 links (27.39 feet) called Peshtigo River, North, 1.41 chains to South Bank, 2.41 chains wide, runs East.


On July 28, 1993, Alan D. Harrison (RLS) restored the corner position at proportionate distance and on line between the Northwest and Southwest Section Corners of Section 29.

No corner evidence was recovered.

- (c) In the plan view drawing below, provide reference ties to at least 4 witness monuments, or, if the location is within a municipality, to at least 2 witness monuments. (witness monuments shall be made of concrete, natural stone, iron or other equally durable material.)

- (d) Show a plan view drawing depicting the relevant monuments and reference ties which is sufficient in detail to enable accurate relocation of the corner monument if the corner monument is disturbed. Indicate north.

- 2 1/2"x36" Aluminum monument with tablet stamped to identify the corner.
- Balsam, 11", S.44°E., 3.74 feet.
- Sugar, 4", S.50°W., 25.92 feet.
- Cherry, 7", N.14°W., 27.27 feet.
- Steel Sign Post, North, 1.13 feet.

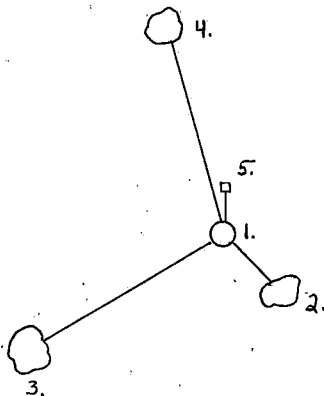

(e) Describe any material discrepancy between the location of the corner as restored or reestablished and the location of that corner as previously restored or reestablished by distance and direction. Show the discrepancy on the plan view drawing under (d), above. Show the distances between the corner as previously restored or reestablished and (1) the corner as restored or reestablished, and (2) to at least 2 of the witness monuments shown on the drawing in (d), above.


None

(f) Was the corner restored through acceptance of (1) an obliterated evidence location, or, (2) a found perpetuated location?

No

(g & h) Was the corner reestablished through lost corner proportionate methods? If so, show the method, including the directions and distances to other public land survey corners used as evidence or used for proportioning in determining the corner location?


Yes

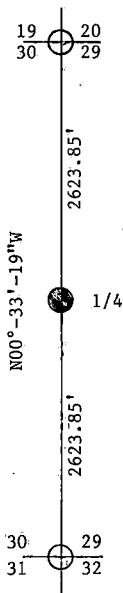

REGISTER'S OFFICE  
Forest County, Wis.

Received for record this 15th day  
of September, A.D., 19 94, at  
1:00 o'clock P.M. and recorded  
in Vol. Casey Restoration  
page 155

*Paul C. H. Deputy*  
Register of Deeds

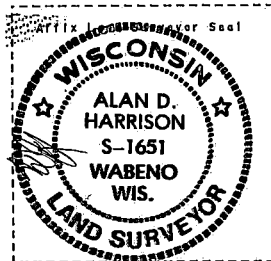

(1) I, Alan D. Harrison

(type or print name) certify that the corner location shown on this record was determined by me or under my direction and control and that this U.S. Public Land Survey Monument Record is correct and complete to the best of my knowledge and belief.

*Alan D. Harrison*  
Signature

8/17/94  
Date

CERTIFICATE READY FOR FILING:

*Sue Vap*  
District Ranger

136820


R.O.D.

## U. S. PUBLIC LAND SURVEY MONUMENT RECORD.

INSTRUCTIONS: This record shall show the location of the corner and shall include all of the following nine elements (a through i).

- (a) Identify the corner by reference to the U.S. public land survey system.  
 O = Corner monument restored.

Quarter Corner Common to Sections 27 and 28,  
 T36N, R16E, Forest County, Wisconsin.

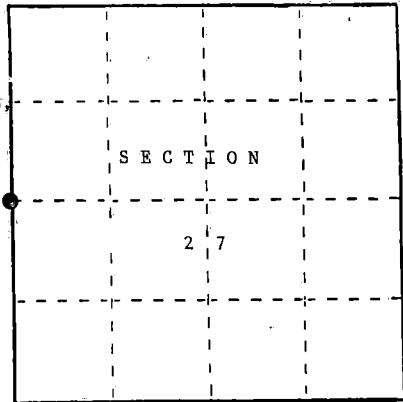

REGISTER'S OFFICE  
 Forest County, Wis.

Received for record this 9th day

of December A.D. 1988 at

2:50 o'clock P.M. and recorded

in Volume 13

page 13

Paul Hochstetler

Register of Deeds

- (b) Describe any record evidence, monument evidence, occupational evidence, testimonial evidence or any other material evidence you considered, and whether the monument was found or placed.

In 1858, James McBride set a wood post for the corner and the following corner references:  
 Sugar 6" S88°W 9 lks. Elm 9" S53°E 8 lks.


In 1926, Goodman Lumber Co. set a flue pipe and found 10" Elm tree S53°E 8 lks.

In 1988, John Schulke found iron pipe laying on the ground apparently it was removed due to road construction. Placed 2 1/2" dia. X 36" aluminum monument.

- (c) In the plan view drawing below, provide reference ties to at least 4 witness monuments, or, if the location is within a municipality, to at least 2 witness monuments. (Witness monuments shall be made of concrete, natural stone, iron or other equally durable material.)  
 Describe witness monuments.

- (d) Show a plan view drawing depicting the relevant monuments and reference ties which is sufficient in detail to enable accurate relocation of the corner monument if the corner monument is disturbed. Indicate north.

- 2 1/2" dia. X 36" aluminum magnetic cap monument stamped to identify the corner.
- Spruce 4" N25°W 21.91 feet
- Cherry 8" Due East 51.01 feet
- Cherry 10" S07°E 70.33 feet
- chiseled an "X" on rock 4'X2 1/2' S83°W 44.02 feet
- Steel sign post West 0.6 feet

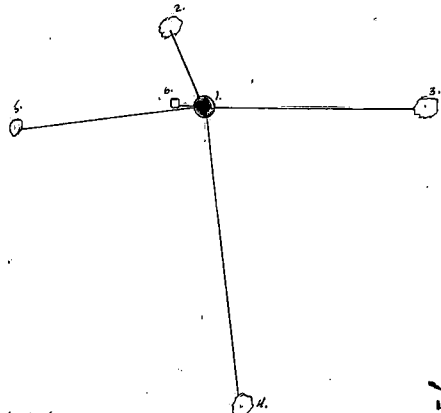

43616282000

- (e) Describe any material discrepancy between the location of the corner as restored or reestablished and the location of that corner as previously restored or reestablished by distance and direction. Show the discrepancy on the plan view drawing under (d), above. Show the distances between the corner as previously restored or reestablished and (1) the corner as restored or reestablished, and (2) to at least 2 of the witness monuments shown on the drawing in (d), above.



No discrepancy, first corner restoration.

- (f) Was the corner restored through acceptance of (1) an obliterated evidence location, or, (2) a found perpetuated location?

No, see g and h.

- (g&h) Was the corner reestablished through lost corner proportionate methods? If so, show the method, including the directions and distances to other public land survey corners used as evidence or used for proportioning in determining the corner location?

Corner restored by proportionate method.

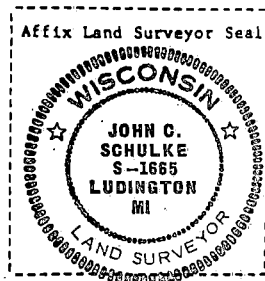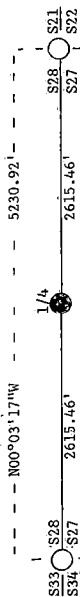

- (i) I, John Schulke  
(Type or print name) certify that the corner location shown on this record was determined by me or under my direction and control and that this U.S. Public Land Survey Monument Record is correct and complete to the best of my knowledge and belief.

John Schulke 12/2/88  
Signature Date

Certificate ready for filing: Dale S. Staeger  
District Ranger

DOCUMENT NUMBER  
**136621**

U. S. PUBLIC LAND SURVEY MONUMENT RECORD.

INSTRUCTIONS:

This record shall show the location of the corner and shall include all of the following nine elements (a through i).


- (a) Identify the corner by reference to the U.S. public land survey system.

○ = Corner monument restored.

Quarter Corner Common to Sections 26 and 27,  
T36N, R16E, Forest County, Wisconsin.

REGISTER'S OFFICE  
Forest County, Wis.  
Received for record this 9th day  
of December, A.D., 1988 at  
2:50 o'clock P.M. and recorded  
in Vol. CORNER RESTORATIONS  
Page 11

Paul Aschauer  
Register of Deeds

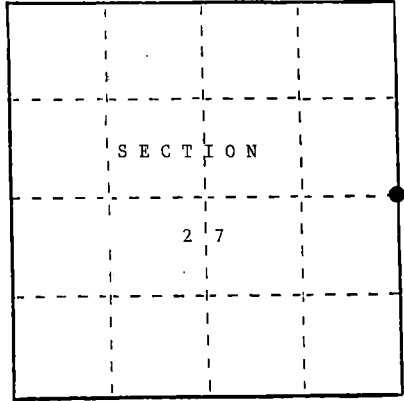

- (b) Describe any record evidence, monument evidence, occupational evidence, testimonial evidence or any other material evidence you considered, and whether the monument was found or placed.

In 1858, James McBride set a wood post for the corner and the following corner references:  
Sugar 8" S33°W 35 lks. Elm 10" S20°E 25 lks.


In 1926, Goodman Lumber Company found no evidence.

In 1988, John Schulke found no evidence. Placed 2 1/2" dia. X 36" aluminum monument.  
The center of a two track road is Northeast 41 feet from the monument.

- (c) In the plan view drawing below, provide reference ties to at least 4 witness monuments, or, if the location is within a municipality, to at least 2 witness monuments. (Witness monuments shall be made of concrete, natural stone, iron or other equally durable material.)  
Describe witness monuments.

- (d) Show a plan view drawing depicting the relevant monuments and reference ties which is sufficient in detail to enable accurate relocation of the corner monument if the corner monument is disturbed. Indicate north.

1. 2 1/2" dia. X 36" aluminum magnetic cap monument stamped to identify the corner.
2. Aspen 6" N10°E 13.57 feet
3. Black Cherry 6" S60°E 32.53 feet
4. Spruce 3" S40°E 52.39 feet
5. Aspen 10" N56°W 75.47 feet
6. Steel sign post Southwest 1.1 feet

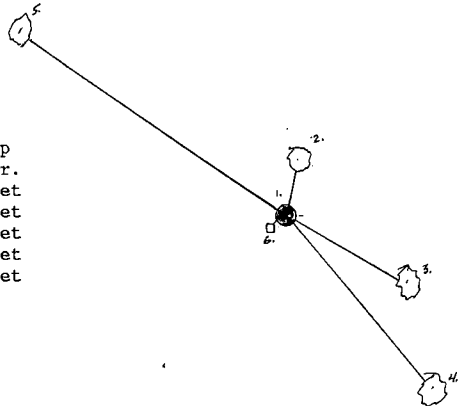

43616272000

- (e) Describe any material discrepancy between the location of the corner as restored or reestablished and the location of that corner as previously restored or reestablished by distance and direction. Show the discrepancy on the plan view drawing under (d), above. Show the distances between the corner as previously restored or reestablished and (1) the corner as restored or reestablished, and (2) to at least 2 of the witness monuments shown on the drawing in (d), above.


No discrepancy, first corner restoration.

- (f) Was the corner restored through acceptance of (1) an obliterated evidence location, or, (2) a found perpetuated location?

No, see g and h.

- (g&h) Was the corner reestablished through lost corner proportionate methods? If so, show the method, including the directions and distances to other public land survey corners used as evidence or used for proportioning in determining the corner location?

Corner restored by proportionate method.

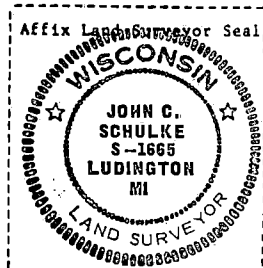

- (1) I, John Schulke

(type or print name) certify that the corner location shown on this record was determined by me or under my direction and control and that this U.S. Public Land Survey Monument Record is correct and complete to the best of my knowledge and belief.

Signature

Date

Certificate ready for filing:

Dale R. Stacey  
District Ranger


## U. S. PUBLIC LAND SURVEY MONUMENT RECORD

INSTRUCTIONS: This record shall show the location of the corner and shall include all of the following nine elements (a through i).

- (a) Identify the corner by reference to the U.S. public land survey system.

O = Corner monument restored.

Quarter Corner to Sections 25 and 30, T.36N., R.16-17E., Forest-Marinette Counties, Wisconsin.

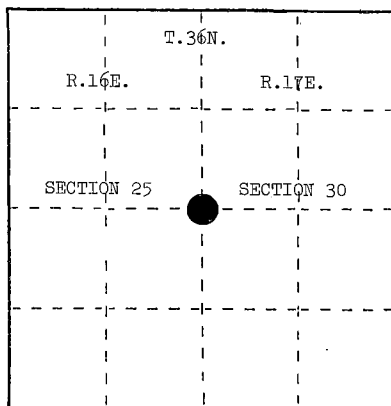


- (b) Describe any record evidence, monument evidence, occupational evidence, testimonial evidence or any other material evidence you considered, and whether the monument was found or placed.

Corner found marked by a 4" iron pipe with a Marinette County brass cap, as set by Frank Gould and Bernard Hammes in 1936-1937.

- (c) In the plan view drawing below, provide reference ties to at least 4 witness monuments, or, if the location is within a municipality, to at least 2 witness monuments. (Witness monuments shall be made of concrete, natural stone, iron or other equally durable material.) Describe witness monuments.

- (d) Show a plan view drawing depicting the relevant monuments and reference ties which is sufficient in detail to enable accurate relocation of the corner monument if the corner monument is disturbed. Indicate north.

1. Basswood, 10", N.82°E., 20.10 feet
2. Ironwood, 4", S.70°W., 14.43 feet
3. Basswood, 6", N.28°W., 29.37 feet
4. Steel Sign Post, North, 1.60 feet

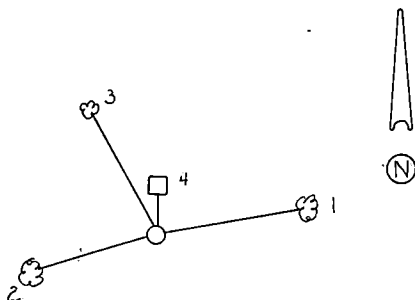

REGISTER'S OFFICE }  
Forest County, Wis. }

Received for record this 1st day

of April, A.D., 1985 at

2:05 o'clock P.M. and

recorded in Vol. CARNER RESTORATIONS

on page 1 of 5

Paul A. Acklesommer  
REGISTER

43616 25 2000

(e) Describes any material discrepancy between the location of the corner as restored or reestablished and the location of that corner as previously restored or reestablished by distance and direction. Show the discrepancy on the plan view drawing under (d), above. Show the distances between the corner as previously restored or reestablished and (1) the corner as restored or reestablished, and (2) to at least 2 of the witness monuments shown on the drawing in (d), above.

None.

(f) Was the corner restored through acceptance of (1) an obliterated evidence location, or, (2) a found perpetuated location?

(g&h) Was the corner reestablished through lost corner proportionate methods? If so, show the method, including the directions and distances to other public land survey corners used as evidence or used for proportioning in determining the corner location?


This corner was restored by single proportionate measure by Frank Gould and Bernard Hammes in 1936-1937.

(i) I, Milo E. Stefan

(type or print name) certify that the corner location shown on this record was determined by me or under my direction and control and that this U.S. Public Land Survey Monument Record is correct and complete to the best of my knowledge and belief.

Milo E. Stefan  
Signature

12/31/84  
Date

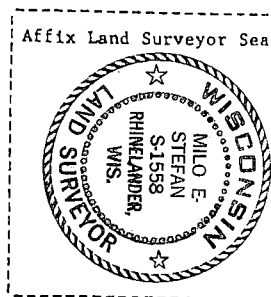


## U. S. PUBLIC LAND SURVEY MONUMENT RECORD

## INSTRUCTIONS:

This record shall show the location of the corner and shall include all of the following nine elements (a through i).

- (a) Identify the corner by reference to the U.S. public land survey system.  
O = Corner monument restored.

Quarter Quarter Common to Sections 30 and 31,  
T.36N., R16E., Forest County, Wisconsin.

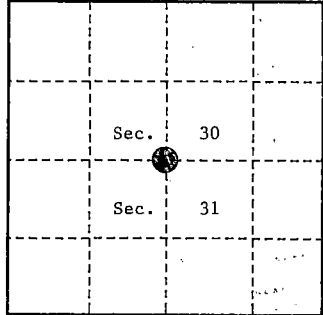

- (b) Describe any record evidence, monument evidence, occupational evidence, testimonial evidence, or any other material evidence you considered, and whether the monument was found or placed.

In 1858, James McBride set a wood post with the following B.T.'s: Fir, 8", S.10°E., 12 links (7.92 feet), Sugar, 20", N.48°E., 14 links (9.24 feet) West, 11.81 chains leave cedar swamp, N & S. West, 14.01 chains, stream, 4 links wide runs North. West 22.81 chains, spring pond, 100 links wide. West 25.01 chains enter cedar swamp, NW & SE.

In 1911, J. Melindy found  $\frac{1}{2}$  post. Set on elm post 5"x5"x50" in original post hole. Original Maple, 28", N.48°E., 14 links, Original Fir, 11", S.16°E., 12 links.


On July 28, 1993 Alan D. Harrison (RLS) restored the corner position at proportionate distance and on line between the Northwest and Northeast Section Corners of Section 31.

No corner evidence was recovered.

- (c) In the plan view drawing below, provide reference ties to at least 4 witness monuments, or, if the location is within a municipality, to at least 2 witness monuments. (witness monuments shall be made of concrete, natural stone, iron or other equally durable material.)

- (d) Show a plan view drawing depicting the relevant monuments and reference ties which is sufficient in detail to enable accurate relocation of the corner monument if the corner monument is disturbed. Indicate north.

1. 2½"x36" Aluminum monument with tablet stamped to identify the corner.
2. Spruce, 14", N.04°E., 28.84 feet.
3. Sugar, 3", N.66°E., 17.10 feet.
4. Red Pine, 7", South, 20.37 feet.
5. Steel Sign Post, Northwest, 0.94 feet.

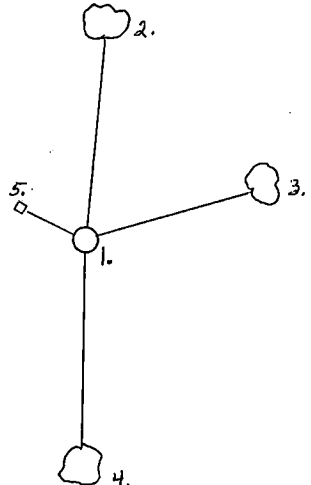

43616 300020

(e) Describe any material discrepancy between the location of the corner as restored or reestablished and the location of that corner as previously restored or reestablished by distance and direction. Show the discrepancy on the plan view drawing under (d), above. Show the distances between the corner as previously restored or reestablished and (1) the corner as restored or reestablished, and (2) to at least 2 of the witness monuments shown on the drawing in (d), above.

None

(f) Was the corner restored through acceptance of (1) an obliterated evidence location, or, (2) a found perpetuated location?

No

(g & h) Was the corner reestablished through lost corner proportionate methods? If so, show the method, including the directions and distances to other public land survey corners used as evidence or used for proportioning in determining the corner location?


Yes

REGISTER'S OFFICE  
Forest County, Wis.

Received for record this 15th day  
of September, A.D., 1994, at  
1:00 o'clock P.M. and recorded  
in Vol. 334 Restoration  
page 1

Robert Ch. Ho. Deputy  
Register of Deeds

Affix Land Surveyor Seal

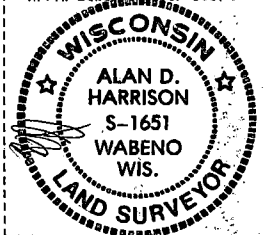

(1) I, Alan D. Harrison

(type or print name) certify that the corner location shown on this record was determined by me or under my direction and control and that this U.S. Public Land Survey Monument Record is correct and complete to the best of my knowledge and belief.

Alan D. Harrison  
Signature

8/17/94  
Date

CERTIFICATE READY FOR FILING:

Steve Vap  
District Ranger


## U. S. PUBLIC LAND SURVEY MONUMENT RECORD

## INSTRUCTIONS:

This record shall show the location of the corner and shall include all of the following nine elements (a through i).

- (a) Identify the corner by reference to the U.S. public land survey system.  
 O = Corner monument restored.

Section Corner Common to Sections 29, 30, 31 & 32,  
 T.36N., R.16E., Forest County, Wisconsin.

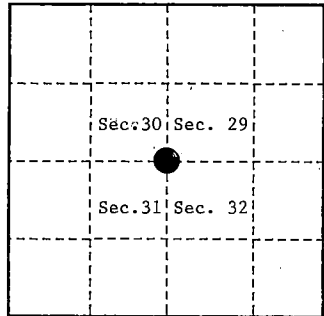

- (b) Describe any record evidence, monument evidence, occupational evidence, testimonial evidence or any other material evidence you considered, and whether the monument was found or placed.

In 1858, James McBride set a wood post and the following B.T.'s: Sugar, 12", N.27°E., 10 links (6.60 feet), Linden, 20", N.48°W., 30 links (19.80 feet), Sugar, 14", S.32°E., 41 links (27.06 feet), Hemlock, 24", S.77°W., 38 links (25.08 feet). North, 41.90 chains, stream 100 links wide, runs East.


In 1911, J. Melindy found the corner and all of the original bearing trees. Sugar, 20", N.27°E., 6.60 feet, Linden, 30", N.43°W., 19.80 feet, Sugar, 20", S.32°E., 27.06 feet, Hemlock (stump) 30", S.77°W., 25.08 feet. Set 4"x4"x48" ironwood post.

On May 4, 1993, Alan D. Harrison (RLS) found a large Basswood stump with 4 progenies growing out. Two progenies still alive with 16" and 18" live trees. From center of Basswood pulled S.43°E., 19.80 feet and found posthole and post remains from which the following bear; Sugar stump, N.27°E., 6.60 feet, stump depression, S.32°E., 27.06 feet, stump depression, S.77°W., 25.08 feet. Accepted post hole and accessories as best evidence of corner location.

- (c) In the plan view drawing below, provide reference ties to at least 4 witness monuments, or, if the location is within a municipality, to at least 2 witness monuments. (witness monuments shall be made of concrete, natural stone, iron or other equally durable material.)

- (d) Show a plan view drawing depicting the relevant monuments and reference ties which is sufficient in detail to enable accurate relocation of the corner monument if the corner monument is disturbed. Indicate north.

1. 2½"x36" Aluminum monument with tablet stamped to identify the corner.
2. Sugar, 9", S.85°E., 12.04 feet.
3. Basswood, 7", S.20°E., 39.46 feet.
4. Sugar, 15", S.69°W., 43.34 feet.
5. Sugar, 6", N.30°W., 8.11 feet.
6. Steel Sign Post, South, 1.43 feet.

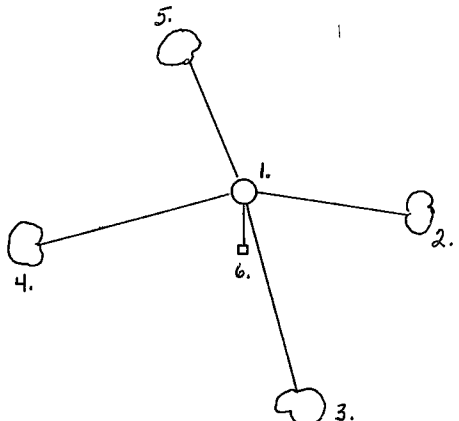

(e) Describe any material discrepancy between the location of the corner as restored or reestablished and the location of that corner as previously restored or reestablished by distance and direction. Show the discrepancy on the plan view drawing under (d), above. Show the distances between the corner as previously restored or reestablished and (1) the corner as restored or reestablished, and (2) to at least 2 of the witness monuments shown on the drawing in (d), above.

None

(f) Was the corner restored through acceptance of (1) an obliterated evidence location, or, (2) a found perpetuated location?

Restored from accepted bearing tree evidence.

(g & h) Was the corner reestablished through lost corner proportionate methods? If so, show the method, including the directions and distances to other public land survey corners used as evidence or used for proportioning in determining the corner location?

No

REGISTER'S OFFICE  
Forest County, Wis.

Received for record this 15<sup>th</sup> day  
of September, A.D., 19 94 at  
1:00 o'clock P.M. and recorded  
in Vol. County Restorations  
page 1-5

*Paul Chittlo, Deputy*  
Register of Deeds


(1) I, Alan D. Harrison  
(type or print name) certify that the corner location shown  
on this record was determined by me or under my direction and  
control and that this U.S. Public Land Survey Monument Record is  
correct and complete to the best of my knowledge and belief.

Alan D. Harrison  
Signature

8/17/94  
Date

CERTIFICATE READY FOR FILING:

Sue Vap  
District Ranger

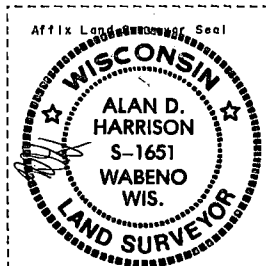

## U. S. PUBLIC LAND SURVEY MONUMENT RECORD

INSTRUCTIONS: This record shall show the location of the corner and shall include all of the following nine elements (a. through i.).

- (a) Identify the corner by reference to the U.S. public land survey system.  
 O = Corner monument restored.


Quarter Corner to Sections 29 and 32, T.36N., R.16E., Forest County, Wisconsin.

REGISTER'S OFFICE  
 Forest County, Wis.

Received for record this 10<sup>th</sup> day  
 of August A.D. 1987 at

8:25 o'clock A.M. and recorded  
 in Vol. CORNER RESTORATIONS

Page 1  
 Paul A. Schaeffer  
 Register of Deeds

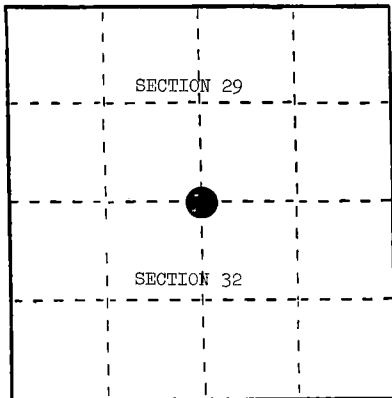

- (b) Describe any record evidence, monument evidence, occupational evidence, testimonial evidence or any other material evidence you considered, and whether the monument was found or placed.

In 1858, James McBride set quarter post and made the following BTs: Sugar, 14", N.5°W., 31 links; Sugar, 14", S.34°W., 13 links.


In 1911, J. Melendy set new 4" x 4" Elm post. Original Maple a decayed stump, N5 3/4°W., 31 links. Original Maple, 18", (green), S40 1/2°W., 13 links. Made new references: "X" on stone, 4' x 7', S.58°W., 27 links; Maple, 14", N.43°E., 65 1/4 links.

In 1987, Alan Harrison, from air photo, located search area north and west of roads. Found Melendy's rock with "X" 4' x 7', pulled for post and found live 4" Sugar growing in place. Original Sugar stump, S.40°W., 8.6 feet. Other BTs fall in road clearing.

- (c) In the plan view drawing below, provide reference ties to at least 4 witness monuments, or, if the location is within a municipality, to at least 2 witness monuments. (Witness monuments shall be made of concrete, natural stone, iron or other equally durable material.)  
 Describe witness monuments.

- (d) Show a plan view drawing depicting the relevant monuments and reference ties which is sufficient in detail to enable accurate relocation of the corner monument if the corner monument is disturbed. Indicate north.

1. 2 1/2" x 36" aluminum monument stamped to identify corner location.
2. Sugar, 6", S.16°W., 12.45 feet.
3. "X" on stone, 4' x 7', S.55°W., 17.82 feet.
4. Sugar, 7", N.63°W., 26.07 feet.
5. Steel Sign Post, Northwest, 1.00 feet.

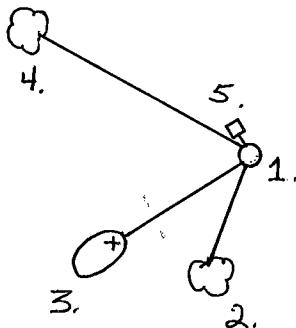

- (e) Describe any material discrepancy between the location of the corner as restored or reestablished and the location of that corner as previously restored or reestablished by distance and direction. Show the discrepancy on the plan view drawing under (d), above. Show the distances between the corner as previously restored or reestablished and (1) the corner as restored or reestablished, and (2) to at least 2 of the witness monuments shown on the drawing in (d), above.

None.

- (f) Was the corner restored through acceptance of (1) an obliterated evidence location, or, (2) a found perpetuated location?

(1) an obliterated evidence location.


- (g&h) Was the corner reestablished through lost corner proportionate methods? If so, show the method, including the directions and distances to other public land survey corners used as evidence or used for proportioning in determining the corner location?

No.

- (1) I, Alan D. Harrison  
[Type or print name] certify that the corner location shown on this record was determined by me or under my direction and control and that this U.S. Public Land Survey Monument Record is correct and complete to the best of my knowledge and belief.

Alan D. Harrison  
Signature

8/5/87  
Date

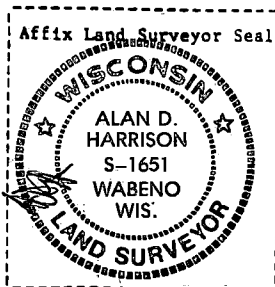

## U. S. PUBLIC LAND SURVEY MONUMENT RECORD

INSTRUCTIONS: This record shall show the location of the corner and shall include all of the following nine elements (a through i).

- (a) Identify the corner by reference to the U.S. public land survey system.

○ = Corner monument restored.


Section Corner to Sections 28, 29, 32, and 33,  
T.36N., R.16E., Forest County, Wisconsin.

REGISTER'S OFFICE  
Forest County, Wis.

Received for record this 10<sup>th</sup> day  
of August A.D. 1987 at  
8:25 o'clock A.M. and recorded  
in Vol. CORNER RESTORATIONS

PAGE 9

Paul Aschenbrenner  
Register of Deeds

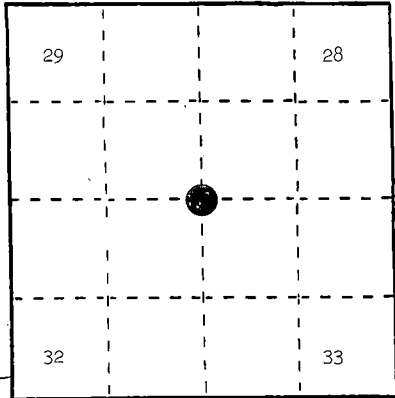

- (b) Describe any record evidence, monument evidence, occupational evidence, testimonial evidence or any other material evidence you considered, and whether the monument was found or placed.

In 1858, James McBride set wood post and made the following BTs: Sugar, 10", N.60°W., 12 links; Lind, 8", N.66°E., 19 links; Birch, 20", S.43°E., 48 links; Sugar, 10", S.40°W., 44 links.

In 1911, J. Melendy set Elm post and made new BTs: Maple, 16", N.44°W., 31.68 feet; Maple, 12", N.50°E., 30.36 feet.


In 1927, Goodman Company found hardwood post, original Birch (dead), and dried stump. Sugar is still alive. Set 2" flue pipe.

In 1987, Alan Harrison found flue pipe lying on ground, post hole with wood remains, Sugar stump, N.50°E., 30.4 feet, root holes, N.44°W., 31.7 feet, Sugar regrowth, S.40°W., 26.3 feet.

- (c) In the plan view drawing below, provide reference ties to at least 4 witness monuments, or, if the location is within a municipality, to at least 2 witness monuments. (Witness monuments shall be made of concrete, natural stone, iron or other equally durable material.)  
Describe witness monuments.

- (d) Show a plan view drawing depicting the relevant monuments and reference ties which is sufficient in detail to enable accurate relocation of the corner monument if the corner monument is disturbed. Indicate north.

1. A 2½" x 36" aluminum monument stamped to identify the corner, in a mound of stone.
2. Sugar, 7", N.15°E., 32.07 feet.
3. Sugar, 7", S.23°E., 37.53 feet.
4. Sugar, 7", S.40°W., 27.22 feet.
5. Sugar, 7", N.77°W., 20.71 feet.
6. Steel Sign Post, 6', Southeast, 1.07 feet.

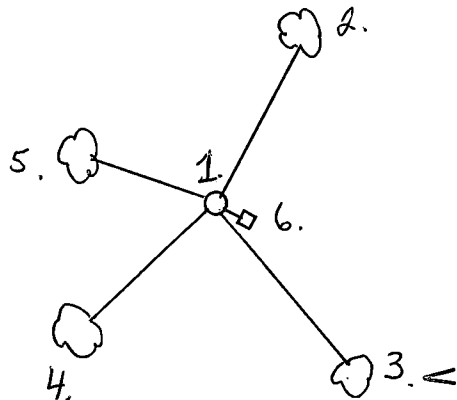

- (e) Describe any material discrepancy between the location of the corner as restored or reestablished and the location of that corner as previously restored or reestablished by distance and direction. Show the discrepancy on the plan view drawing under (d), above. Show the distances between the corner as previously restored or reestablished and (1) the corner as restored or reestablished, and (2) to at least 2 of the witness monuments shown on the drawing in (d), above.

None.

- (f) Was the corner restored through acceptance of (1) an obliterated evidence location, or, (2) a found perpetuated location?

(2) a found perpetuated location.


- (g&h) Was the corner reestablished through lost corner proportionate methods? If so, show the method, including the directions and distances to other public land survey corners used as evidence or used for proportioning in determining the corner location?

No.

- (1) I, Alan D. Harrison  
(Type or print name) certify that the corner location shown on this record was determined by me or under my direction and control and that this U.S. Public Land Survey Monument Record is correct and complete to the best of my knowledge and belief.

Alan D. Harrison  
Signature

8/5/87  
Date

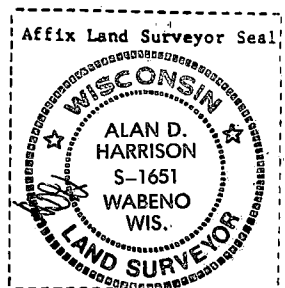

## U. S. PUBLIC LAND SURVEY MONUMENT RECORD


## INSTRUCTIONS:

This record shall show the location of the corner and shall include all of the following nine elements (a through i).

- (a) Identify the corner by reference to the U.S. public land survey system.

O = Corner monument restored.

Corner to Sections 27, 28, 33, and 34, T.36N., R.16E.

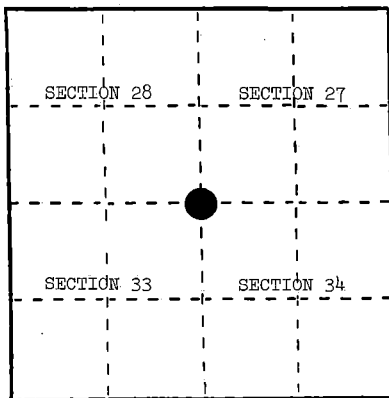

- (b) Describe any record evidence, monument evidence, occupational evidence, testimonial evidence or any other material evidence you considered, and whether the monument was found or placed.

In 1858, James McBride set wood post with the following BTs: Fir, 6", N.31°W., 15 links; Hemlock, 14", N.48°E., 13 links; Fir, 6", S.41°E., 17 links; Hemlock, 20", S.28°W., 13 links.


In 1925, Goodman Company found Cedar post and both Hemlock BTs. Set 1 5/8" iron pipe, 3' high.

October 11, 1984, Alan Harrison found iron pipe, as per Goodman notes, pulled N.48°E., 8.6', to Hemlock stump, and S.28°W., 8.6', to stump hole.

- (c) In the plan view drawing below, provide reference ties to at least 4 witness monuments, or, if the location is within a municipality, to at least 2 witness monuments. (Witness monuments shall be made of concrete, natural stone, iron or other equally durable material.)  
Describe witness monuments.

- (d) Show a plan view drawing depicting the relevant monuments and reference ties which is sufficient in detail to enable accurate relocation of the corner monument if the corner monument is disturbed. Indicate north.

1. 2" x 30" aluminum monument stamped to identify the corner.
2. Balsam, 7", N.48°E., 58.33'
3. Black Cherry, 4", S.84°E., 76.30'
4. Balsam, 7", S.7°W., 69.19'
5. Balsam, 5", S.69°W., 59.37'
6. Steel Sign Post, Northwest, 1.05'

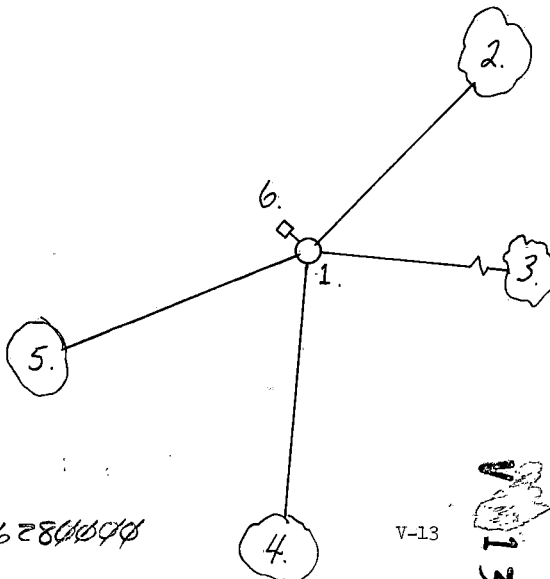

REGISTER'S OFFICE  
Forest County, Wis.

Received for record this 23rd day

of January 1985 at

9:00 o'clock A.M. and

recorded in Vol. CORNER RESTORATION

on page 13

REGISTER

43616280000

V-13

V-13

- (e) Describe any material discrepancy between the location of the corner as restored or reestablished and the location of that corner as previously restored or reestablished by distance and direction. Show the discrepancy on the plan view drawing under (d), above. Show the distances between the corner as previously restored or reestablished and (1) the corner as restored or reestablished, and (2) to at least 2 of the witness monuments shown on the drawing in (d), above.

None.

- (f) Was the corner restored through acceptance of (1) an obliterated evidence location, or, (2) a found perpetuated location?


(2) a found perpetuated location.

- (g&h) Was the corner reestablished through lost corner proportionate methods? If so, show the method, including the directions and distances to other public land survey corners used as evidence or used for proportioning in determining the corner location?

No.

- (1) I, Alan D. Harrison  
(type or print name) certify that the corner location shown on this record was determined by me or under my direction and control and that this U.S. Public Land Survey Monument Record is correct and complete to the best of my knowledge and belief.

Alan D. Harrison 12/14/84  
Signature Date

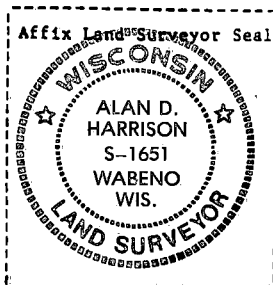

## U. S. PUBLIC LAND SURVEY MONUMENT RECORD.

INSTRUCTIONS: This record shall show the location of the corner and shall include all of the following nine elements (a through i).

- (a) Identify the corner by reference to the U.S. public land survey system.

O = Corner monument restored.

Quarter Corner Common to Sections 27 and 34,  
T36N, R16E, Forest County, Wisconsin.

REGISTER'S OFFICE  
Forest County, Wis.

Received for record this 9th day


of December A.D., 1988 at

2:50 o'clock P.M. and recorded

in Vol. CORNER RESTORATIONS

page 1-15

Paul Aschenbrenner  
Register of Deeds

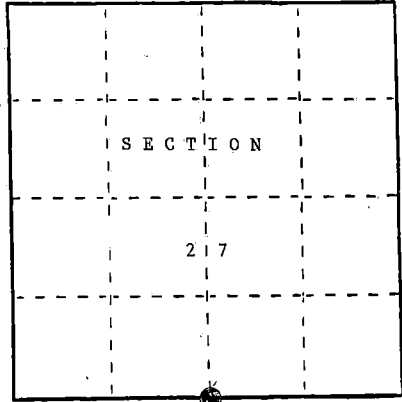

- (b) Describe any record evidence, monument evidence, occupational evidence, testimonial evidence or any other material evidence you considered, and whether the monument was found or placed.


In 1858, James McBride set a wood post for the corner and the following corner references:  
Fir 8" S05°W 11 lks. Fir 6" N04°W 28 lks.

In 1988, John Schulke found no evidence due to timber cutting in the area.  
Placed 2 1/2" X 36" aluminum monument.

- (c) In the plan view drawing below, provide reference ties to at least 4 witness monuments, or, if the location is within a municipality, to at least 2 witness monuments. (Witness monuments shall be made of concrete, natural stone, iron or other equally durable material.)  
Describe witness monuments.

- (d) Show a plan view drawing depicting the relevant monuments and reference ties which is sufficient in detail to enable accurate relocation of the corner monument if the corner monument is disturbed.  
Indicate north.

- 2 1/2" dia. X 36" aluminum magnetic cap monument stamped to identify the corner.
- Sugar Maple 7" S20°E 118.42 feet
- Sugar Maple 5" S10°E 119.49 feet
- Basswood 6" S08°W 105.98 feet
- Chiseled an "X" on rock 7' X 5 1/2' S05°E 45.45 feet
- Steel sign post West 1.0 feet

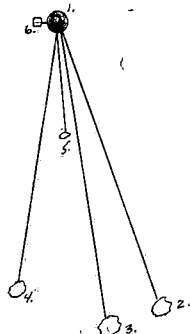

43616270024

- (e) Describe any material discrepancy between the location of the corner as restored or reestablished and the location of that corner as previously restored or reestablished by distance and direction. Show the discrepancy on the plan view drawing under (d), above. Show the distances between the corner as previously restored or reestablished and (1) the corner as restored or reestablished, and (2) to at least 2 of the witness monuments shown on the drawing in (d), above.


No discrepancy, first corner restoration.

- (f) Was the corner restored through acceptance of (1) an obliterated evidence location, or, (2) a found perpetuated location?

No, see g and h.

- (g&h) Was the corner reestablished through lost corner proportionate methods? If so, show the method, including the directions and distances to other public land survey corners used as evidence or used for proportioning in determining the corner location?

Corner restored by proportionate method.

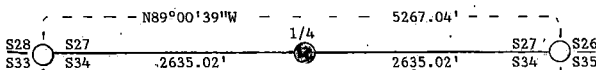


(1) I, John Schulke

(Type or print name) certify that the corner location shown on this record was determined by me or under my direction and control and that this U.S. Public Land Survey Monument Record is correct and complete to the best of my knowledge and belief.

John Schulke 12/2/88  
Signature Date

Certificate ready for filing:

Dale S. Staeg  
District Ranger

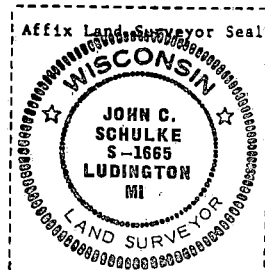

## U. S. PUBLIC LAND SURVEY MONUMENT RECORD


## INSTRUCTIONS:

This record shall show the location of the corner and shall include all of the following nine elements (a through i).

- (a) Identify the corner by reference to the U.S. public land survey system.

○ = Corner monument restored.

Corner to Sections 26, 27, 34, and 35, T.36N., R.16E.

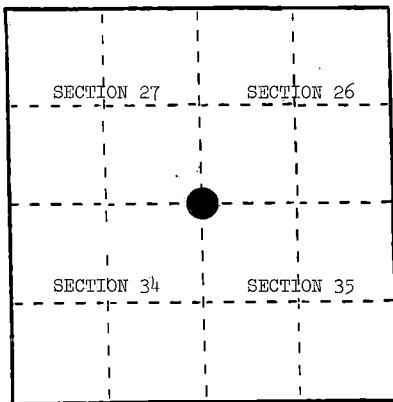

- (b) Describe any record evidence, monument evidence, occupational evidence, testimonial evidence or any other material evidence you considered, and whether the monument was found or placed.

In 1858, James McBride set wood post with the following BTs: Sugar, 12", N.16°E., 32 links; Ironwood, 8", N.54°W., 5 links; Sugar, 16", S.10°E., 15 links; Fir, 8", S.27°W., 17 links.


In 1926, Goodman Company found a 3½" Elm post by Dahl. They set 1½" iron pipe, 9" high. Sugar, 14", N.16°E., 32 links--plainly scribe marked.

October 11, 1984, Alan Harrison found corner, as found by Goodman in 1926.

- (c) In the plan view drawing below, provide reference ties to at least 4 witness monuments, or, if the location is within a municipality, to at least 2 witness monuments. (Witness monuments shall be made of concrete, natural stone, iron or other equally durable material.) Describe witness monuments.

- (d) Show a plan view drawing depicting the relevant monuments and reference ties which is sufficient in detail to enable accurate relocation of the corner monument if the corner monument is disturbed. Indicate north.

1. 2" x 30" aluminum monument stamped to identify the corner.
2. Sugar, 8", N.73°E., 11.06'
3. Sugar, 6", S.52°E., 20.50'
4. Sugar, 8", S.66°W., 35.65'
5. Sugar, 10", N.27°W., 69.68'
6. Steel Sign Post, South, 2.09'

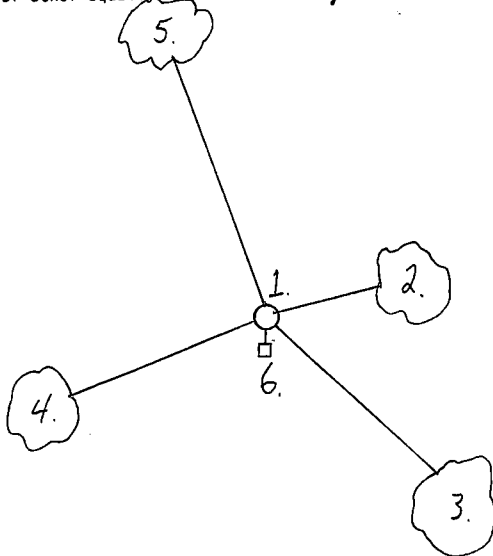

REGISTER'S OFFICE }  
Forest County, Wis.

Received for record this... 23rd day

of... January... A. D., 1985 at

9:00 o'clock... A... M. and

recorded in Vol. CORNER RESTORATIONS

on page 17  
J. A. Schenck  
REGISTER

43616270000

V-17

V17

- (e) Describe any material discrepancy between the location of the corner as restored or reestablished and the location of that corner as previously restored or reestablished by distance and direction. Show the discrepancy on the plan view drawing under (d), above. Show the distances between the corner as previously restored or reestablished and (1) the corner as restored or reestablished, and (2) to at least 2 of the witness monuments shown on the drawing in (d), above.

None.

- (f) Was the corner restored through acceptance of (1) an obliterated evidence location, or, (2) a found perpetuated location?


(2) a found perpetuated location.

- (g&h) Was the corner reestablished through lost corner proportionate methods? If so, show the method, including the directions and distances to other public land survey corners used as evidence or used for proportioning in determining the corner location?

No.

- (1) I, Alan D. Harrison  
(type or print name) certify that the corner location shown on this record was determined by me or under my direction and control and that this U.S. Public Land Survey Monument Record is correct and complete to the best of my knowledge and belief.

Alan D. Harrison 12/14/84  
Signature Date

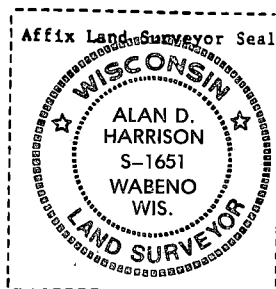


## U. S. PUBLIC LAND SURVEY MONUMENT RECORD

INSTRUCTIONS: This record shall show the location of the corner and shall include all of the following nine elements (a through i).

- (a) Identify the corner by reference to the U.S. public land survey system.

○ = Corner monument restored.

Section Corner to Sections 25-30-31-36,  
Township 36 North, Ranges 16-17 East,  
Forest-Marinette Counties, Wisconsin.

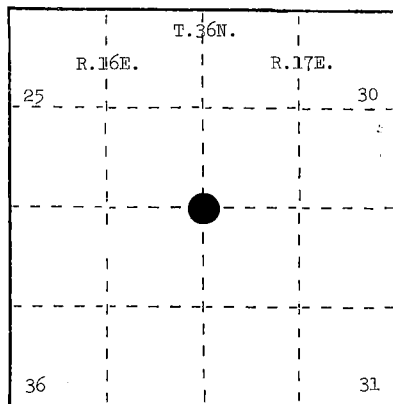


- (b) Describe any record evidence, monument evidence, occupational evidence, testimonial evidence or any other material evidence you considered, and whether the monument was found or placed.

Corner position found marked by a 4" iron pipe with a Marinette County brass cap, as set by Frank Gould and Bernard Hammes in 1936-1937.

- (c) In the plan view drawing below, provide reference ties to at least 4 witness monuments, or, if the location is within a municipality, to at least 2 witness monuments. (Witness monuments shall be made of concrete, natural stone, iron or other equally durable material.)  
Describe witness monuments.

- (d) Show a plan view drawing depicting the relevant monuments and reference ties which is sufficient in detail to enable accurate relocation of the corner monument if the corner monument is disturbed. Indicate north.

1. Cherry, 12", N.60°E., 25.67 feet
2. Ironwood, 3", S.38°E., 15.20 feet
3. Maple, 26", N.82°E., 176.22 feet
4. Ironwood, 4", S.28°W., 23.35 feet
5. Maple, 26", S.16°W., 129.36 feet
6. Aspen, 4", N.22°W., 17.12 feet
7. Steel Sign Post, South, 2.60 feet

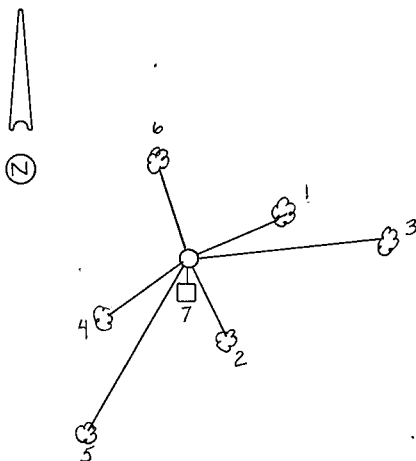

REGISTER'S OFFICE }  
Forest County, Wis. }  
Received for record this 1st day  
of April A.D., 1935 at  
2:05 o'clock P. M. and  
recorded in Vol. CORNER RESTORATIONS  
on page 125  
Paul Aschenbrenner

43616 250000

- ) Describe any material discrepancy between the location of the corner as restored or reestablished and the location of that corner as previously restored or reestablished by distance and direction. Show the discrepancy on the plan view drawing under (d), above. Show the distances between the corner as previously restored or reestablished and (1) the corner as restored or reestablished, and (2) to at least 2 of the witness monuments shown on the drawing in (d), above.

None.

- (f) Was the corner restored through acceptance of (1) an obliterated evidence location, or, (2) a found perpetuated location?


- (g&h) Was the corner reestablished through lost corner proportionate methods? If so, show the method, including the directions and distances to other public land survey corners used as evidence or used for proportioning in determining the corner location?

This corner was restored by single proportionate measure by Frank Gould and Bernard Hammes in 1936-1937.

- (i) I, Milo E. Stefan  
(type or print name) certify that the corner location shown on this record was determined by me or under my direction and control and that this U.S. Public Land Survey Monument Record is correct and complete to the best of my knowledge and belief.

Milo E. Stefan  
Signature

12/31/84  
Date

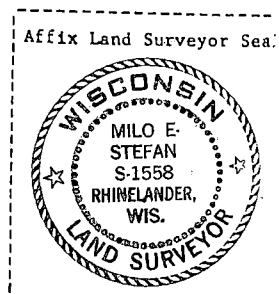


## U. S. PUBLIC LAND SURVEY MONUMENT RECORD

## INSTRUCTIONS:

This record shall show the location of the corner and shall include all of the following nine elements (a through i).

- (a) Identify the corner by reference to the U.S. public land survey system.  
 O = Corner monument restored.

Quarter Corner Common to Sections 31 & 32,  
 T.36N., R.16E., Forest County, Wisconsin.

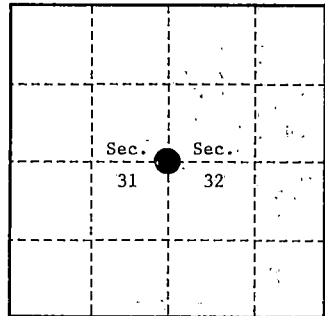

- (b) Describe any record evidence, monument evidence, occupational evidence, testimonial evidence or any other material evidence you considered, and whether the monument was found or placed.

In 1858, James McBride set a wood post and the following B.T.'s: Linden, 10", S.43°E., 21 links (13.86 feet), Elm, 7", S.85°W., 20 links (13.20 feet).

In 1911, J. Melindy found corner at 40.07½ chains from South. He did not say what else he found or what he set.


On July 28, 1993, Alan D. Harrison (RLS) restored the corner position at proportionate distance on and line between the Northwest and Southwest Section Corners of Section 32.

No corner evidence was recovered.

- (c) In the plan view drawing below, provide reference ties to at least 4 witness monuments, or, if the location is within a municipality, to at least 2 witness monuments. (Witness monuments shall be made of concrete, natural stone, iron or other equally durable material.)

- (d) Show a plan view drawing depicting the relevant monuments and reference ties which is sufficient in detail to enable accurate relocation of the corner monument if the corner monument is disturbed. Indicate north.

1. 2½"x36" Aluminum pipe monument with tablet stamped to identify the corner.
2. Hemlock, 11", S.28°E., 51.90 feet.
3. Balsam, 9", S.40°W., 50.62 feet.
4. Aspen, 4", N.23°W., 9.06 feet.
5. Steel Sign Post, East, 0.89 feet.

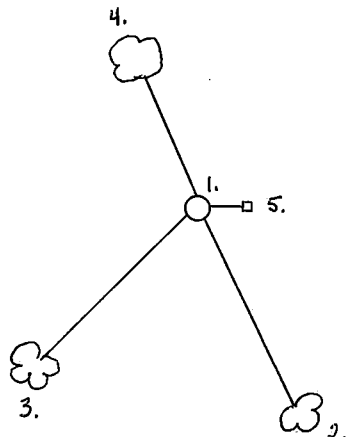

(e) Describe any material discrepancy between the location of the corner as restored or reestablished and the location of that corner as previously restored or reestablished by distance and direction. Show the discrepancy on the plan view drawing under (d), above. Show the distances between the corner as previously restored or reestablished and (1) the corner as restored or reestablished, and (2) to at least 2 of the witness monuments shown on the drawing in (d), above.


None

(f) Was the corner restored through acceptance of (1) an obliterated evidence location, or, (2) a found perpetuated location?

No


(g & h) Was the corner reestablished through lost corner proportionate methods? If so, show the method, including the directions and distances to other public land survey corners used as evidence or used for proportioning in determining the corner location?

Yes

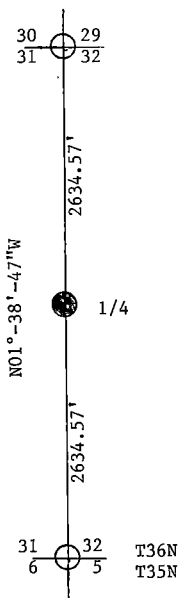

REGISTER'S OFFICE  
Forest County, Wis.

Received for record this 15<sup>th</sup> day  
of September, A.D., 1994 at  
1:00 o'clock P.M. and recorded  
in Vol. Case Restorations  
page 85  
Paul White, Deputy  
Register of Deeds

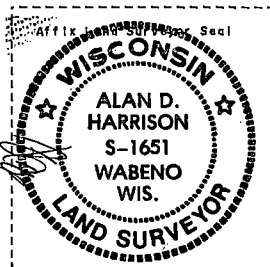

(1) I, Alan D. Harrison

(type or print name) certify that the corner location shown on this record was determined by me or under my direction and control and that this U.S. Public Land Survey Monument Record is correct and complete to the best of my knowledge and belief.

Alan D. Harrison

Signature

8/17/94

Date

CERTIFICATE READY FOR FILING:

Sue Vas  
District Ranger

## U. S. PUBLIC LAND SURVEY MONUMENT RECORD

## INSTRUCTIONS:


This record shall show the location of the corner and shall include all of the following nine elements (a through i).

- (a) Identify the corner by reference to the U.S. public land survey system.

○ = Corner monument restored.

Quarter Corner to Sections 32 and 33, T.36N., R.16E., Forest County, Wisconsin.

REGISTER'S OFFICE  
Forest County, Wis.  
Received for record this 10th day  
of August A.D. 1987 at  
8:30 o'clock A.M. and recorded  
in Vol. 9 CORNER RESTORATIONS  
pages 1-2  
Paul Aschenbrenner  
Register of Deeds

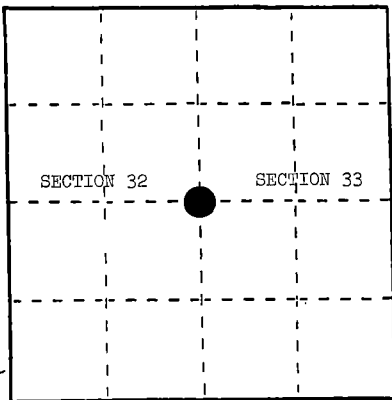

- (b) Describe any record evidence, monument evidence, occupational evidence, testimonial evidence or any other material evidence you considered, and whether the monument was found or placed.

In 1858, James McBride set wood post with the following BTs: Cedar, 10", N. <sup>43°</sup>34'W., 16 links; Fir, 8", N.50°E., 7 links.


In 1926, Goodman Company set 4" Cedar post and 1 5/8" pipe 16" high. Dead Cedar (leaning), blazed but no scribe marks visible. Small Balsam, squared, nearby.

In 1987, Alan Harrison found cut line in swamp. A squared Balsam post and a location tag, WNW, 22 feet from post on 20" Cedar. From post at N.43°W., 10.6 feet, is a large Cedar fallen over. Did not find Goodman's pipe.

- (c) In the plan view drawing below, provide reference ties to at least 4 witness monuments, or, if the location is within a municipality, to at least 2 witness monuments. (Witness monuments shall be made of concrete, natural stone, iron or other equally durable material.)  
Describe witness monuments.

- (d) Show a plan view drawing depicting the relevant monuments and reference ties which is sufficient in detail to enable accurate relocation of the corner monument if the corner monument is disturbed. Indicate north.

1. A 2 1/2" x 60" aluminum monument stamped to identify the corner.
2. Spruce, 10", N.86°E., 19.44 feet.
3. Spruce, 6", S.04°E., 30.63 feet.
4. Cedar, 18", N.13°W., 40.36 feet.
5. Steel Sign Post, 6', Southwest, 0.70 feet.

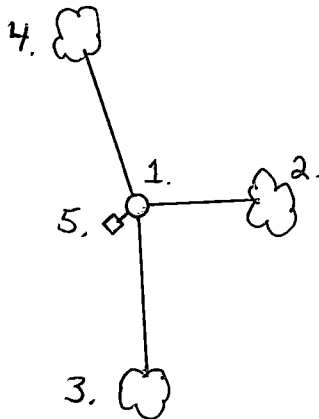

- (e) Describe any material discrepancy between the location of the corner as restored or reestablished and the location of that corner as previously restored or reestablished by distance and direction. Show the discrepancy on the plan view drawing under (d), above. Show the distances between the corner as previously restored or reestablished and (1) the corner as restored or reestablished, and (2) to at least 2 of the witness monuments shown on the drawing in (d), above.

None.

- (f) Was the corner restored through acceptance of (1) an obliterated evidence location, or, (2) a found perpetuated location?

(2) a found perpetuated location.


- (g&h) Was the corner reestablished through lost corner proportionate methods? If so, show the method, including the directions and distances to other public land survey corners used as evidence or used for proportioning in determining the corner location?

No.

- (1) Alan D. Harrison  
(Type or print name) certify that the corner location shown on this record was determined by me or under my direction and control and that this U.S. Public Land Survey Monument Record is correct and complete to the best of my knowledge and belief.

Alan D. Harrison  
Signature

8/5/87  
Date

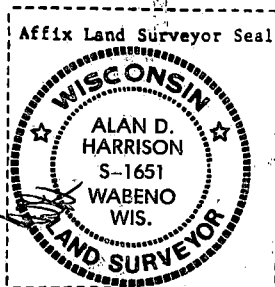

## U. S. PUBLIC LAND SURVEY MONUMENT RECORD


## INSTRUCTIONS:

This record shall show the location of the corner and shall include all of the following nine elements (a through i).

- (a) Identify the corner by reference to the U.S. public land survey system.

○ = Corner monument restored.

Quarter Corner to Sections 36 and 31, T.36N., R.16-17E., Forest and Marinette Counties, Wisconsin.

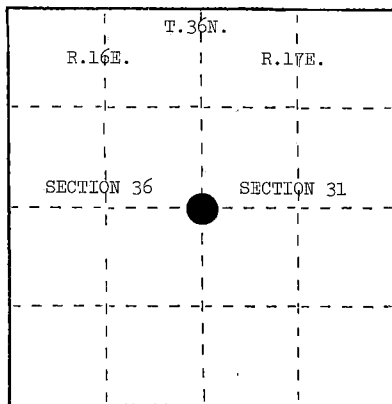


- (b) Describe any record evidence, monument evidence, occupational evidence, testimonial evidence or any other material evidence you considered, and whether the monument was found or placed.

Corner found marked by a 4" iron pipe with a Marinette County brass cap, as set by Frank Gould and Bernard Hammes in 1936-1937.

- (c) In the plan view drawing below, provide reference ties to at least 4 witness monuments, or, if the location is within a municipality, to at least 2 witness monuments. (Witness monuments shall be made of concrete, natural stone, iron or other equally durable material.) Describe witness monuments.

- (d) Show a plan view drawing depicting the relevant monuments and reference ties which is sufficient in detail to enable accurate relocation of the corner monument if the corner monument is disturbed. Indicate north.

1. Balsam, 3", S.88°E., 9.68 feet
2. Maple, 14", S.29°W., 15.94 feet
3. Maple, 10", S.19°E., 17.82 feet
4. Elm, 14", N.60°W., 38.78 feet
5. Ironwood, 7", N.34°W., 74.58 feet
6. Steel Sign Post, South, 3.90 feet

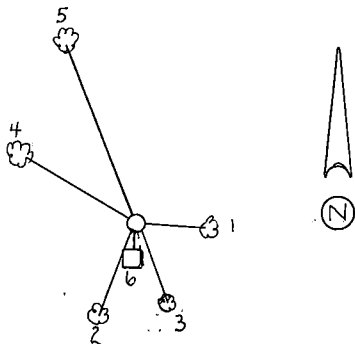

REGISTER'S OFFICE }  
Forest County, Wis. }

Received for record this... day

of April 1st, 1985

at 2:25 P.M. and

recorded in Vol. 100, CORNER RESTORATIONS

on page 1 of 1  
Paul Aschenbrenner  
REGISTER

43616362000

X-25

X25

Describe any material discrepancy between the location of the corner as restored or reestablished and the location of that corner as previously restored or reestablished by distance and direction. Show the discrepancy on the plan view drawing under (d), above. Show the distances between the corner as previously restored or reestablished and (1) the corner as restored or reestablished, and (2) to at least 2 of the witness monuments shown on the drawing in (d), above.

None.

(f) Was the corner restored through acceptance of (1) an obliterated evidence location, or, (2) a found perpetuated location?

(g&h) Was the corner reestablished through lost corner proportionate methods? If so, show the method, including the directions and distances to other public land survey corners used as evidence or used for proportioning in determining the corner location?

This corner was restored by single proportionate measure by Frank Gould and Bernard Hammes in 1936-1937.

(1) I, Milo E. Stefan  
(type or print name) certify that the corner location shown on this record was determined by me or under my direction and control and that this U.S. Public Land Survey Monument Record is correct and complete to the best of my knowledge and belief.

Milo E. Stefan  
Signature

12/31/84  
Date

Affix Land Surveyor Seal




## U. S. PUBLIC LAND SURVEY MONUMENT RECORD

## INSTRUCTIONS:

This record shall show the location of the corner and shall include all of the following nine elements (a through i).

- (a) Identify the corner by reference to the U.S. public land survey system.  
 O = Corner monument restored.

Quarter Corner to Section 36,  
 T.36N., R.16E. and Section 31,  
 T.36N., R.17E., 4th P.M.

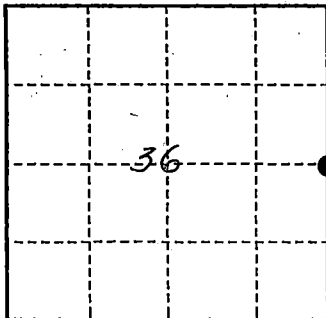

- (b) Describe any record evidence, monument evidence, occupational evidence, testimonial evidence or any other material evidence you considered, and whether the monument was found or placed.


Found Quarter Corner monument by Marinette County and three BTs in good condition.  
 Elm BT dead. Made one new BT: Sugar Maple, 12", S.77°W., 12.84'

This corner was restored by Gould and Hammes in 1937.

- (c) In the plan view drawing below, provide reference ties to at least 4 witness monuments, or, if the location is within a municipality, to at least 2 witness monuments. (witness monuments shall be made of concrete, natural stone, iron or other equally durable material.)

- (d) Show a plan view drawing depicting the relevant monuments and reference ties which is sufficient in detail to enable accurate relocation of the corner monument if the corner monument is disturbed. Indicate north.

1. 4" Iron pipe with brass cap.
2. Balsam Fir, 3", S.88°E., 9.68'.
3. Sugar Maple, 18", S.19°E., 17.82'.
4. Sugar Maple, 14", S.29°W., 15.94'.
5. Sugar Maple, 12", S.77°W., 12.84'.
6. Ironwood, 10", N.34°W., 74.58'.
7. Steel sign post, South, 3.94'.

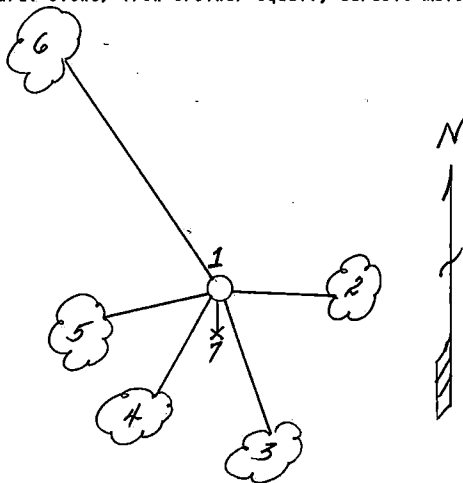

REGISTER'S OFFICE  
 Forest County, Wis.

Received for record this 24 day  
 of March, A.D., 1937 at  
2:15 o'clock P.M. and recorded  
 in Vol. 36-16, Chas. Restorations  
 page 125

John D. H. Deputy  
 Register of Deeds

43616362090

- (a) Describe any material discrepancy between the location of the corner as restored or reestablished and the location of that corner as previously restored or reestablished by distance and direction. Show the discrepancy on the plan view drawing under (d), above. Show the distances between the corner as previously restored or reestablished and (1) the corner as restored or reestablished, and (2) to at least 2 of the witness monuments shown on the drawing in (d), above.

N/A

- (f) Was the corner restored through acceptance of (1) an obliterated evidence location, or, (2) a found perpetuated location?

(2)

- (g & h) Was the corner reestablished through lost corner proportionate methods? If so, show the method, including the directions and distances to other public land survey corners used as evidence or used for proportioning in determining the corner location?

N/A

(i) I, Milo E. Stefan

(type or print name) certify that the corner location shown on this record was determined by me or under my direction and control and that this U.S. Public Land Survey Monument Record is correct and complete to the best of my knowledge and belief.



Milo E. Stefan  
Signature

November 20, 1992

Date

CERTIFICATE READY FOR FILING:

Dale R. Covey  
Acting District Ranger

CERTIFIED LAND CORNER RESTORATION

State of Wisconsin

County of Forest

ss.

I, Jean F. Resvick, do hereby certify that on the 11 day of March, 1976, I found evidence of the Southwest section corner of Section 31 Township 36 North Range 16 East, Fourth Principal Meridian, as described hereon; and that from this evidence I established a new monument and accessories as described hereon to perpetuate the original location of this corner:

Description of original monument and accessories and subsequent restorations:

Survey in 1857 by Artemas Curtis  
91.41 chains west between Sections 6 and 31 set post  
Sugar 15, N18W, 19 lks.  
Yellow Birch, 12, N62E, 55 lks.  
Sugar 10, S70W, 26 lks.  
Lynn 12, S10E, 50 lks. (note for range line records this as being a Sugar)  
North, 17 chains enter swamp NE NW


Description of corner evidence found:

Maple post in mound of rock  
Old post lying by mound.  
Yellow Birch 26, bears N62E, 53 lks.  
Location poster dated 6/11/36 by J.H.

Description of monument and accessories I established to perpetuate the location of this corner:

Set 2 inch inside diameter, galvanized iron pipe, 3 feet long, filled with concrete with brass cap stamped:  
T36N, R15E, R16E, S36, S31, S1, S6, T35N, 1976, S-802  
Blazed and scribed the following new bearing trees,  
Maple 13, N63E, 10.10 ft.  
Basswood 9, S33W, 25.37 ft.  
Basswood 9, N59W, 12.96 ft.  
Set steel sign post 0.5 ft. west of monument

43615367777

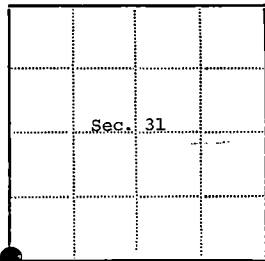

● - Corner monument restored

□ -

Resident witnesses.....

Dated at Rhineland Wisconsin, this 11 day of March, 1976.

Signature Jean F. Resvick Title Land Surveyor  
(County Surveyor, Registered Land Surveyor, or other duly authorized official)

Surveyors Registration No. S-802


DOCUMENT NUMBER  
**109589**

Office of Register of Deeds County of Forest

I hereby certify that the within instrument was filed in this office for record on the 2nd day of July, 1976, and was filed in Book No.        Page No.        of County Records.

Signature Eugene Stating Title Register of Deeds

Township 36 North, Range 16 East, Section 31, Index No. 2-1, Page No.       

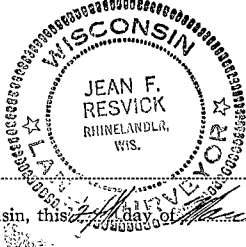


## U. S. PUBLIC LAND SURVEY MONUMENT RECORD

## INSTRUCTIONS:

This record shall show the location of the corner and shall include all of the following nine elements (a through i).

- (a) Identify the corner by reference to the U.S. public land survey system.  
O = Corner monument restored.

Quarter Corner Common to Sections 31 and 6,  
T.35-36N., R.16E., Forest County, Wisconsin.

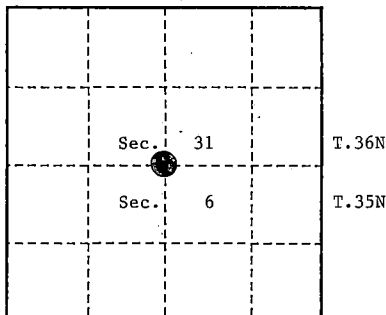

- (b) Describe any record evidence, monument evidence, occupational evidence, testimonial evidence or any other material evidence you considered, and whether the monument was found or placed.

In 1857, Artemas Curtis set a wood post and the following bearing trees; Yellow Birch, 18", N.15°W., 24 links (15.84 feet), Sugar, 6", S.21°E., 25 links (16.50 feet).


In 1911, J. Melindy found Quarter Post and the following original bearing trees; Yellow Birch, marked, N.15°W., 15.18 feet, Maple, 14", marked, S.20°E., 16.50 feet. Replaced old post with a 4"x4"x48" cedar post.

On May 4, 1993, Alan D. Harrison (RLS) found a metal location poster and a one foot length of old cedar post just East of a post hole. No original or J. Melindy bearing tree evidence was recovered. Accepted post hole and accessories as the best evidence of the corner position.

- (c) In the plan view drawing below, provide reference ties to at least 4 witness monuments, or, if the location is within a municipality, to at least 2 witness monuments. (witness monuments shall be made of concrete, natural stone, iron or other equally durable material.)

- (d) Show a plan view drawing depicting the relevant monuments and reference ties which is sufficient in detail to enable accurate relocation of the corner monument if the corner monument is disturbed. Indicate north.

1. 2½"x36" Aluminum monument with tablet stamped to identify the corner.
2. Basswood, 7", S.40°E., 47.55 feet.
3. Sugar, 8", S.55°W., 25.52 feet.
4. Large Rock, 5'x3", N.42°W., 17.28 feet.
5. Steel Sign Post, East, 0.97 feet.

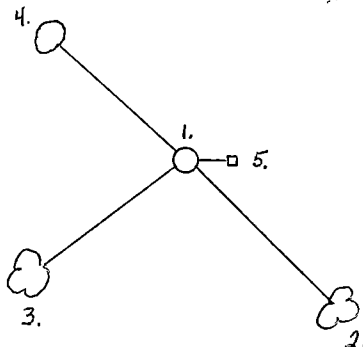

4 361631 Ø Ø 2 Ø

(e) Describe any material discrepancy between the location of the corner as restored or reestablished and the location of that corner as previously restored or reestablished by distance and direction. Show the discrepancy on the plan view drawing under (d), above. Show the distances between the corner as previously restored or reestablished and (1) the corner as restored or reestablished, and (2) to at least 2 of the witness monuments shown on the drawing in (d), above.

None

(f) Was the corner restored through acceptance of (1) an obliterated evidence location, or, (2) a found perpetuated location?

Restored from accepted evidence.


(g & h) Was the corner reestablished through lost corner proportionate methods? If so, show the method, including the directions and distances to other public land survey corners used as evidence or used for proportioning in determining the corner location?

No

REGISTER'S OFFICE  
Forest County, Wis.

Received for record this 15<sup>th</sup> day  
of September A.D. 1994 at  
1:00 o'clock P.M. and recorded  
in Vol. Case Restoration  
page 2-3

Shel Chubb  
Register of Deeds

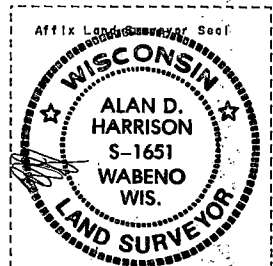

(4) I, Alan D. Harrison

(type or print name) certify that the corner location shown on this record was determined by me or under my direction and control and that this U.S. Public Land Survey Monument Record is correct and complete to the best of my knowledge and belief.

Alan D. Harrison

Signature

8/17/94

Date

CERTIFICATE READY FOR FILING:

Shel Vap  
District Ranger


## U. S. PUBLIC LAND SURVEY MONUMENT RECORD

## INSTRUCTIONS:

This record shall show the location of the corner and shall include all of the following nine elements (a through i).

- (a) Identify the corner by reference to the U.S. public land survey system.  
O = Corner monument restored.

Section Corner Common to Sections  
31, 32, 5 and 6, T.35-36N., R.16E.,  
Forest County, Wisconsin.

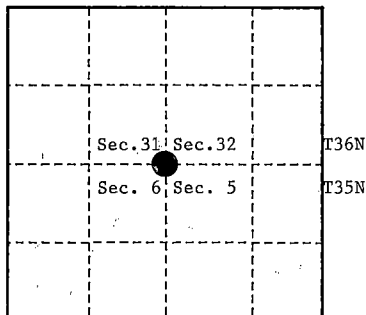

- (b) Describe any record evidence, monument evidence, occupational evidence, testimonial evidence or any other material evidence you considered, and whether the monument was found or placed.

In 1857, Artemas Curtis set a wood post and the following bearing trees; Sugar, 12", N.41°W., 13 links (8.58 feet), Sugar, 16", N.38°E., 33 links (21.78 feet), Elm, 10", S.56°E., 63 links (41.58 feet), Elm, 10", S.57°W., 46 links (30.36 feet).

In 1911, J. Melindy found the original corner and the following original B.T.'s; Maple, 16", N.41½°W., 13½ links (8.745 feet), Sugar, 20", N.38°E., 32½ links (21.45 feet), Elm, 14", S.56°W., 46½ links (30.69 feet), Elm, 16", S.57°E., 63½ links (41.91 feet).


On May 12, 1993, Alan D. Harrison (RLS) restored the corner position at proportionate distance and on line between the South Quarter Corner of Section 31 and the Southeast Section Corner of Section 32.

No corner evidence was recovered.

- (c) In the plan view drawing below, provide reference ties to at least 4 witness monuments, or, if the location is within a municipality, to at least 2 witness monuments. (witness monuments shall be made of concrete, natural stone, iron or other equally durable material.)

- (d) Show a plan view drawing depicting the relevant monuments and reference ties which is sufficient in detail to enable accurate relocation of the corner monument if the corner monument is disturbed. Indicate north.

1. 2½"x36" Aluminum monument with tablet stamped to identify the corner.
2. Sugar, 8", North, 42.05 feet.
3. Sugar, 8", East, 38.13 feet.
4. Basswood, 7", S.50°W., 19.90 feet.
5. Sugar, 5", N.58°W., 44.62 feet.
6. Steel Sign Post, West, 0.97 feet.

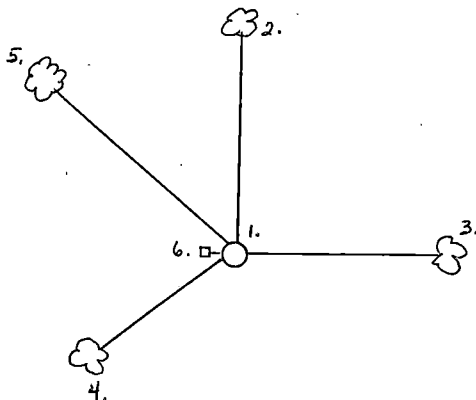

43616310000

(e) Describe any material discrepancy between the location of the corner as restored or reestablished and the location of that corner as previously restored or reestablished by distance and direction. Show the discrepancy on the plan view drawing under (d), above. Show the distances between the corner as previously restored or reestablished and (1) the corner as restored or reestablished, and (2) to at least 2 of the witness monuments shown on the drawing in (d), above.


None

(f) Was the corner restored through acceptance of (1) an obliterated evidence location, or, (2) a found perpetuated location?

No


(g & h) Was the corner reestablished through lost corner proportionate methods? If so, show the method, including the directions and distances to other public land survey corners used as evidence or used for proportioning in determining the corner location?

Yes

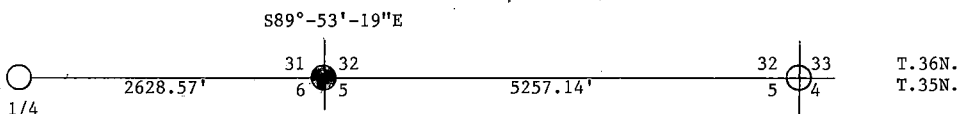

REGISTER'S OFFICE  
Forest County, Wis.

Received for record this 15 day  
of September A.D., 19 94 at  
2:00 o'clock P.M. and recorded  
in Vol. Logan Restorations  
page 7-5  
*Alan D. Harrison*  
Register of Deeds

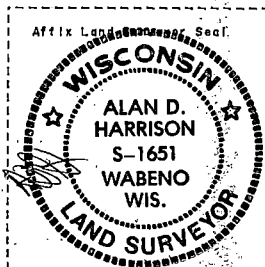

(1) I, Alan D. Harrison

(type or print name) certify that the corner location shown on this record was determined by me or under my direction and control and that this U.S. Public Land Survey Monument Record is correct and complete to the best of my knowledge and belief.

Signature

Date

CERTIFICATE READY FOR FILING:

District Ranger


## U. S. PUBLIC LAND SURVEY MONUMENT RECORD

## INSTRUCTIONS:

This record shall show the location of the corner and shall include all of the following nine elements (a through i).

- (a) Identify the corner by reference to the U.S. public land survey system.  
 O = Corner monument restored.

Quarter Corner Common to Sections 32 and 5,  
 T.35N.-36N., R.16E., Forest County, Wisconsin.

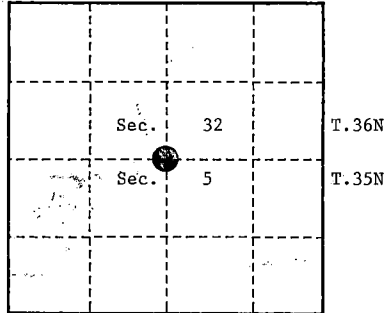

- (b) Describe any record evidence, monument evidence, occupational evidence, testimonial evidence or any other material evidence you considered, and whether the monument was found or placed.

In 1857, Artemas Curtis set a wood post and the following bearing trees; Tamarack, 16", N.58°W., 25 links (16.50 feet), Spruce, 5", S.34°E., 19 links (12.54 feet) East 29.55 chains, stream 10 links wide, runs East-Northeast. East 29.10 chains stream 10 links wide, runs Southeast. West 10.00 chains stream 10 links wide runs Northeast.


On July 27, 1993, Alan D. Harrison (RLS) restored the corner position at proportionate distance and on line between the Southwest and South east Section Corners of Section 32.

No corner evidence was recovered.

- (c) In the plan view drawing below, provide reference ties to at least 4 witness monuments, or, if the location is within a municipality, to at least 2 witness monuments. (witness monuments shall be made of concrete, natural stone, iron or other equally durable material.)

- (d) Show a plan view drawing depicting the relevant monuments and reference ties which is sufficient in detail to enable accurate relocation of the corner monument if the corner monument is disturbed. Indicate north.

1. 2½"x60" Aluminum monument with tablet stamped to identify the corner.
2. Spruce, 4", N.50°E., 10.88 feet.
3. Spruce, 5", S.02°E., 7.49 feet.
4. Spruce, 6", N.85°W., 8.64 feet.
5. Steel Sign Post, North, 1.22 feet.

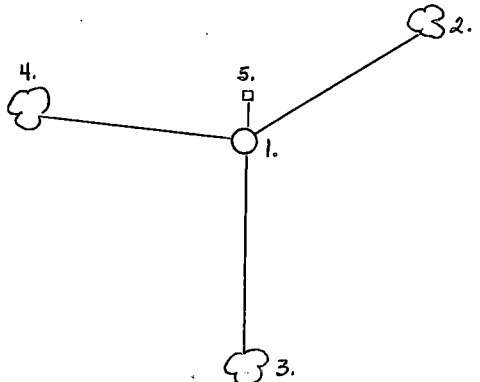

43616320020

(e) Describe any material discrepancy between the location of the corner as restored or reestablished and the location of that corner as previously restored or reestablished by distance and direction. Show the discrepancy on the plan view drawing under (d), above. Show the distances between the corner as previously restored or reestablished and (1) the corner as restored or reestablished, and (2) to at least 2 of the witness monuments shown on the drawing in (d), above.


None

(f) Was the corner restored through acceptance of (1) an obliterated evidence location, or, (2) a found perpetuated location?

No

(g & h) Was the corner reestablished through lost corner proportionate methods? If so, show the method, including the directions and distances to other public land survey corners used as evidence or used for proportioning in determining the corner location?


Yes

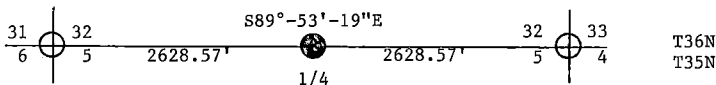

REGISTER'S OFFICE  
Forest County, Wis.

Received for record this 15 day  
of September, A.D. 19 97, at  
Five o'clock P. M. and recorded  
in Vol. Capex Restorations  
page 74

*John Chubb, Deputy*  
Register of Deeds

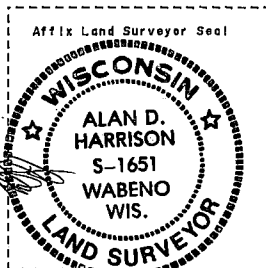

(1) I, Alan D. Harrison

(type or print name) certify that the corner location shown on this record was determined by me or under my direction and control and that this U.S. Public Land Survey Monument Record is correct and complete to the best of my knowledge and belief.

*Alan D. Harrison*  
Signature

8/17/94  
Date

CERTIFICATE READY FOR FILING:

*Sue Vap*  
District Ranger


## U. S. PUBLIC LAND SURVEY MONUMENT RECORD

INSTRUCTIONS: This record shall show the location of the corner and shall include all of the following nine elements (a through i).

- (a) Identify the corner by reference to the U.S. public land survey system.

○ = Corner monument restored.

Section corner to Sections 4, 5, 32, and 33, T.35-36N., R.16E., Fourth Principal Meridian, Forest County, Wisconsin.

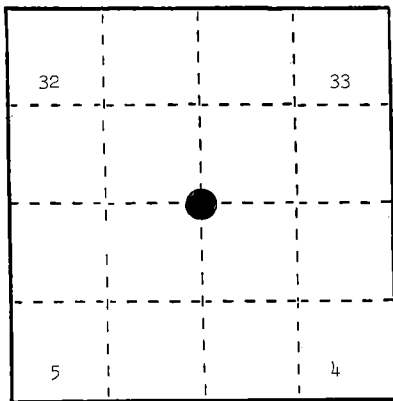

- (b) Describe any record evidence, monument evidence, occupational evidence, testimonial evidence or any other material evidence you considered, and whether the monument was found or placed.


In 1857, Artemas Curtis set post at 80.00 chains with the following BTs: Yellow Birch, 7", N.37°E., 26 links, 17.16 feet; Yellow Birch, 16", S.48°E., 29 links, 19.14 feet; Yellow Birch, 16", S.60°W., 18 links, 11.88 feet; Tamarack, 15", N.69°W., 44 links, 29.04 feet.

June 24, 1981, Milo Stefan found a fallen 4" x 4" x 30" Cedar post with location poster attached--from which he found the following: Stump hole, N.37°E., 17.2 feet; Yellow Birch stump remains, N.48°E., 19.1 feet; Yellow Birch stump, 18"-20" D.B.H., S.60°W., 11.9 feet; Tamarack stump, 14"-16" D.B.H., N.69°W., 29.0 feet. He replaced the wooden post with a 2" x 30" aluminum monument.

- (c) In the plan view drawing below, provide reference ties to at least 4 witness monuments, or, if the location is within a municipality, to at least 2 witness monuments. (Witness monuments shall be made of concrete, natural stone, iron or other equally durable materials.) Describe witness monuments.

- (d) Show a plan view drawing depicting the relevant monuments and reference ties which is sufficient in detail to enable accurate relocation of the corner monument if the corner monument is disturbed. Indicate north.

1. White Spruce, 6", N.16°E., 26.72 feet
2. White Spruce, 6", S.63°E., 13.32 feet
3. White Spruce, 8", S.75°W., 15.58 feet
4. White Spruce, 6", N.30°W., 13.67 feet
5. Steel Sign Post, North, 1.6 feet
6. Location poster on 8" Black Spruce, S.56°E., 6.5 feet

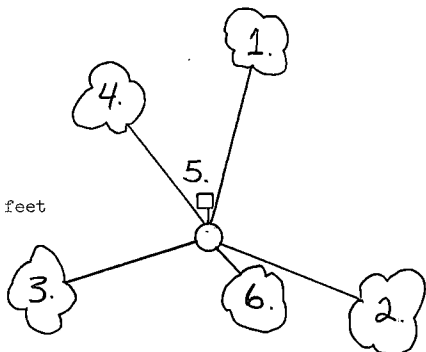

REGISTER'S OFFICE

Forest County, Wis.

Received for record this 1st day

of April, 1985, A.D., 1985

at 10:05 o'clock, P.M. and

recorded in Vol. CORNER RESTORATIONS

on page 3-9

Paul Aschendorfer

REGISTER

- (e) Describe any material discrepancy between the location of the corner as restored or reestablished and the location of that corner as previously restored or reestablished by distance and direction. Show the discrepancy on the plan view drawing under (d), above. Show the distances between the corner as previously restored or reestablished and (1) the corner as restored or reestablished, and (2) to at least 2 of the witness monuments shown on the drawing in (d), above.

None.

- (f) Was the corner restored through acceptance of (1) an obliterated evidence location, or, (2) a found perpetuated location?

(2) a found perpetuated location.

- (g&h) Was the corner reestablished through lost corner proportionate methods? If so, show the method, including the directions and distances to other public land survey corners used as evidence or used for proportioning in determining the corner location?

No.

- (1) I, Milo E. Stefan  
(type or print name) certify that the corner location shown on this record was determined by me or under my direction and control and that this U.S. Public Land Survey Monument Record is correct and complete to the best of my knowledge and belief.

Milo E. Stefan  
Signature

2/14/85  
Date

Affix Land Surveyor Seal




# U. S. PUBLIC LAND SURVEY MONUMENT RECORD

**INSTRUCTIONS:** This record shall show the location of the corner and shall include all of the following nine elements (a through i).

- (a) Identify the corner by reference to the U.S. public land survey system.

O = Corner monument restored.

Quarter corner to Sections 4 and 33, T.35-36N., R.16E., Fourth Principal Meridian, Forest County, Wisconsin.

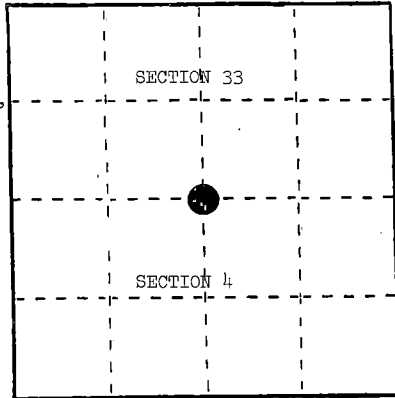

- (b) Describe any record evidence, monument evidence, occupational evidence, testimonial evidence or any other material evidence you considered, and whether the monument was found or placed.

In 1857, Artemas Curtis set post at 40.00 chains with the following BTs: Sugar, 18", N.40°E., 47 links, 31.02 feet; Sugar, 16", S.37°W., 8 links, 5.28 feet.


August, 1925, Goodman Lumber Company restored this corner by lost methods and set a 4" Cedar post and a 1 1/4" iron pipe.

June, 1984, Milo Stefan found Goodman's 1 1/4" iron pipe, which fits very close to the lost corner position. He replaced the 1 1/4" iron pipe with a 2" x 36" aluminum monument.

- (c) In the plan view drawing below, provide reference ties to at least 4 witness monuments, or, if the location is within a municipality, to at least 2 witness monuments. (Witness monuments shall be made of concrete, natural stone, iron or other equally durable material.) Describe witness monuments.

- (d) Show a plan view drawing depicting the relevant monuments and reference ties which is sufficient in detail to enable accurate relocation of the corner monument if the corner monument is disturbed. Indicate north.

1. Sugar Maple, 6", N.7°E., 36.43 feet
2. Sugar Maple, 6", S.31°E., 6.72 feet
3. Sugar Maple, 10", N.65°W., 44.02 feet
4. Steel Sign Post, 7', Northeast, 1.1 feet

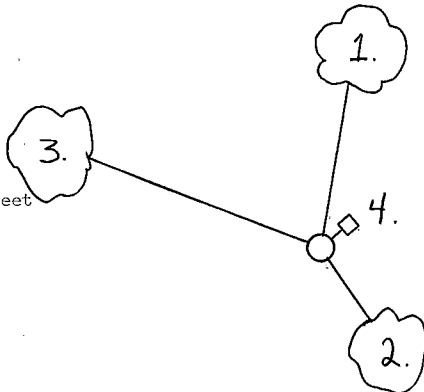

REGISTER'S OFFICE }  
Forest County, Wis.

Received for record this 1st day  
of April A.D., 1985  
at 4:05 o'clock P.M. and  
recorded in Vol. CORNER RESTORATIONS  
on page 3-16  
John Aschenbrenner  
REGISTER

- (e) Describe any material discrepancy between the location of the corner as restored or reestablished and the location of that corner as previously restored or reestablished by distance and direction. Show the discrepancy on the plan view drawing under (d), above. Show the distances between the corner as previously restored or reestablished and (1) the corner as restored or reestablished, and (2) to at least 2 of the witness monuments shown on the drawing in (d), above.

No.

- (f) Was the corner restored through acceptance of (1) an obliterated evidence location, or, (2) a found perpetuated location?

(2) a found perpetuated location.

- (g&h) Was the corner reestablished through lost corner proportionate methods? If so, show the method, including the directions and distances to other public land survey corners used as evidence or used for proportioning in determining the corner location?

No.

- (1) I, Milo E. Stefan  
(type or print name) certify that the corner location shown on this record was determined by me or under my direction and control and that this U.S. Public Land Survey Monument Record is correct and complete to the best of my knowledge and belief.

Milo E. Stefan  
Signature

2/14/85  
Date



## U. S. PUBLIC LAND SURVEY MONUMENT RECORD


## INSTRUCTIONS:

This record shall show the location of the corner and shall include all of the following nine elements (a through i).

- (a) Identify the corner by reference to the U.S. public land survey system.

O = Corner monument restored.

Section corner to Sections 3, 4, 33, and 34, T.35-36N., R.16E., Fourth Principal Meridian, Forest County, Wisconsin.

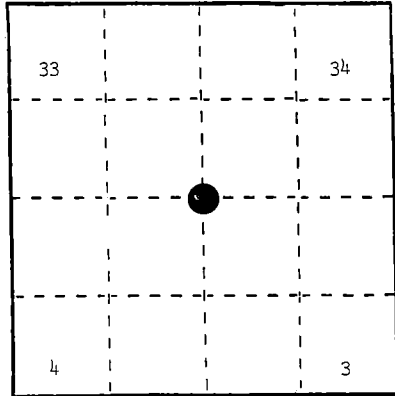

- (b) Describe any record evidence, monument evidence, occupational evidence, testimonial evidence or any other material evidence you considered, and whether the monument was found or placed.

1857, Artemas Curtis set post at 80.00 chains with the following BTs: Sugar, 14", N.59°W., 20 links; Sugar, 12", N.74°E., 19 links; Elm, 18", S.22°E., 32 links; Sugar, 16", S.74°W., 29 links.


1926, Goodman Lumber Company set 1½" flue pipe, 2 feet above ground from the following original BTs: Sugar Maple, 16", N.56°W., 20 links; Sugar Maple, 16", N.74°E., 19 links; Elm windfall, S.22°E., 32 links; Sugar Maple, 18", S.74°W., 29 links.

May, 1984, Milo Stefan found the 1½" flue pipe and replaced it with a 2" x 36" aluminum monument.

- (c) In the plan view drawing below, provide reference ties to at least 4 witness monuments, or, if the location is within a municipality, to at least 2 witness monuments. (Witness monuments shall be made of concrete, natural stone, iron or other equally durable material.) Describe witness monuments.

- (d) Show a plan view drawing depicting the relevant monuments and reference ties which is sufficient in detail to enable accurate relocation of the corner monument if the corner monument is disturbed. Indicate north.

1. Sugar Maple, 7", N.82°E., 8.22 feet
2. Yellow Birch, 8", S.20°E., 27.93 feet
3. Black Cherry, 14", S.37°W., 23.75 feet
4. Sugar Maple, 8", N.29°W., 23.90 feet
5. Steel Sign Post, 7', Northwest, 1.5 feet

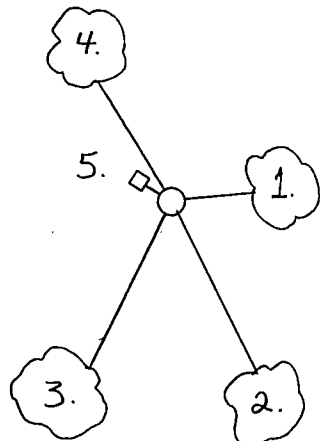

REGISTER'S OFFICE  
Forest County, Wis.

Received for record this 1st day  
of April 1985 at  
2:05 o'clock P. M. and  
recorded in Vol. CORNER RESTORATIONS  
on page 3-13.  
Paul Aschenbrenner  
REGISTER

43616330000

- (e) Describe any material discrepancy between the location of the corner as restored or reestablished and the location of that corner as previously restored or reestablished by distance and direction. Show the discrepancy on the plan view drawing under (d), above. Show the distances between the corner as previously restored or reestablished and (1) the corner as restored or reestablished, and (2) to at least 2 of the witness monuments shown on the drawing in (d), above.

None.

- (f) Was the corner restored through acceptance of (1) an obliterated evidence location, or, (2) a found perpetuated location?

(2) a found perpetuated location.

- (g&h) Was the corner reestablished through lost corner proportionate methods? If so, show the method, including the directions and distances to other public land survey corners used as evidence or used for proportioning in determining the corner location?

No.

Affix Land Surveyor Seal



(1) I, Milo E. Stefan

(Type or print name) certify that the corner location shown on this record was determined by me or under my direction and control and that this U.S. Public Land Survey Monument Record is correct and complete to the best of my knowledge and belief.

Milo E. Stefan  
Signature

2/14/85  
Date

## U. S. PUBLIC LAND SURVEY MONUMENT RECORD


## INSTRUCTIONS:

This record shall show the location of the corner and shall include all of the following nine elements (a through i).

- (a) Identify the corner by reference to the U.S. public land survey system.

○ = Corner monument restored.

Quarter corner to Sections 3 and 34, T.35-36N., R.16E., Fourth Principal Meridian, Forest County, Wisconsin.

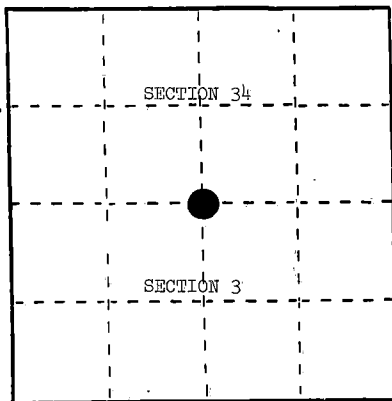

- (b) Describe any record evidence, monument evidence, occupational evidence, testimonial evidence or any other material evidence you considered, and whether the monument was found or placed.

1857, Artemas Curtis set quarter post at 40.00 chains with the following BTs: Fir, 8", S.51°E., 15 links, 9.90 feet; Hemlock, 7", N.74°W., 17 links, 11.22 feet.


May, 1927, Goodman Lumber Company restored this corner by lost methods and set a 3½" Balsam post and a 2" x 18" flue pipe.

June, 1984, Milo Stefan found the 2" x 18" flue pipe to be 7.00 feet, N.38°49'15"W., out of single proportionate position and set a 2" x 36" aluminum monument at the proper location.

- (c) In the plan view drawing below, provide reference ties to at least 4 witness monuments, or, if the location is within a municipality, to at least 2 witness monuments. (Witness monuments shall be made of concrete, natural stone, iron or other equally durable material.) Describe witness monuments.

- (d) Show a plan view drawing depicting the relevant monuments and reference ties which is sufficient in detail to enable accurate relocation of the corner monument if the corner monument is disturbed. Indicate north.

1. Sugar Maple, 5", N.19°E., 22.79 feet
2. Sugar Maple, 10", S.06°W., 78.53 feet
3. Basswood, 9", N.51°W., 47.47 feet
4. 2" x 18" flue pipe, N.38°49'15"W., 7.00 feet
5. Steel Sign Post, 7', Northeast, 1.3 feet

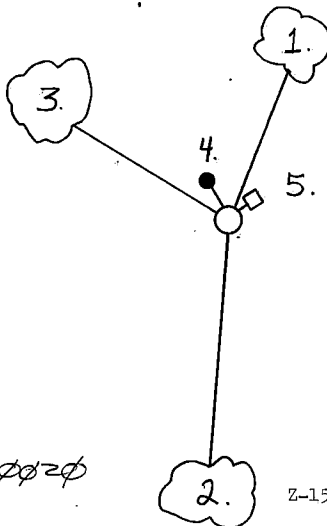

REGISTER'S OFFICE }

Forest County, Wis. }

Received for record this.....day

of, April.....A.D., 1985

at 2:05.....o'clock.....P.....M. and

recorded in Vol. CORNER RESTORATIONS

on page 7-15

*Paul A. Schenckner*  
REGISTER

4361634 0020

- (e) Describe any material discrepancy between the location of the corner as restored or reestablished and the location of that corner as previously restored or reestablished by distance and direction. Show the discrepancy on the plan view drawing under (d), above. Show the distances between the corner as previously restored or reestablished and (1) the corner as restored or reestablished, and (2) to at least 2 of the witness monuments shown on the drawing in (d), above.


Goodman's flue pipe was to be set at single proportion position--it was found to be N.38°49'15"W., 7.00 feet out of its proper position.

- (f) Was the corner restored through acceptance of (1) an obliterated evidence location, or, (2) a found perpetuated location?

Neither.

- (g&h) Was the corner reestablished through lost corner proportionate methods? If so, show the method, including the directions and distances to other public land survey corners used as evidence or used for proportioning in determining the corner location?

Single proportionate measure.

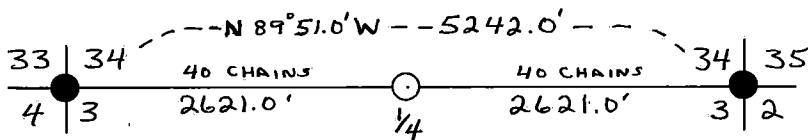

Affix Land Surveyor Seal



- (1) I, Milo E. Stefan (type or print name) certify that the corner location shown on this record was determined by me or under my direction and control and that this U.S. Public Land Survey Monument Record is correct and complete to the best of my knowledge and belief.

Milo E. Stefan  
Signature

2/14/85  
Date

## U. S. PUBLIC LAND SURVEY MONUMENT RECORD


## INSTRUCTIONS:

This record shall show the location of the corner and shall include all of the following nine elements (a through i).

- (a) Identify the corner by reference to the U.S. public land survey system.

○ = Corner monument restored.

Section corner to Sections 2, 3, 34, and 35,  
T.35-36N., R.16E., Fourth Principal Meridian,  
Forest County, Wisconsin.

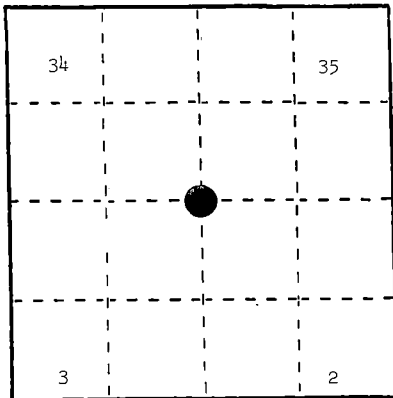

- (b) Describe any record evidence, monument evidence, occupational evidence, testimonial evidence or any other material evidence you considered, and whether the monument was found or placed.

1857, Artemas Curtis set post at 80.00 chains with the following BTs: Hemlock, 8", S.60°E., 10 links, 6.60 feet; Sugar, 12", S.18°W., 60 links, 39.60 feet; Fir, 8", N.57°W., 47 links, 31.02 feet.


May 16, 1927, Goodman Lumber Company restored corner by lost methods--set an Elm post and a 2" flue pipe 18" high.

June, 1984, Milo Stefan found 2" flue pipe to be out of single proportionate position 9.51 feet, N.8°05'31"E. He did not accept this position and restored the corner by lost methods. He placed a 2" x 36" aluminum monument.

- (c) In the plan view drawing below, provide reference ties to at least 4 witness monuments, or, if the location is within a municipality, to at least 2 witness monuments. (Witness monuments shall be made of concrete, natural stone, iron or other equally durable material.)  
Describe witness monuments.

- (d) Show a plan view drawing depicting the relevant monuments and reference ties which is sufficient in detail to enable accurate relocation of the corner monument if the corner monument is disturbed. Indicate north.

1. Basswood, 7", N.43°E., 45.55 feet
2. Sugar Maple, 5", S.76°E., 123.53 feet
3. White Oak, 7", S.09°W., 63.55 feet
4. Sugar Maple, 4", N.59°W., 46.07 feet
5. Flue Pipe, 2", N.8°05'31"E., 9.51 feet
6. Steel Sign Post, 7', East, 1.4 feet

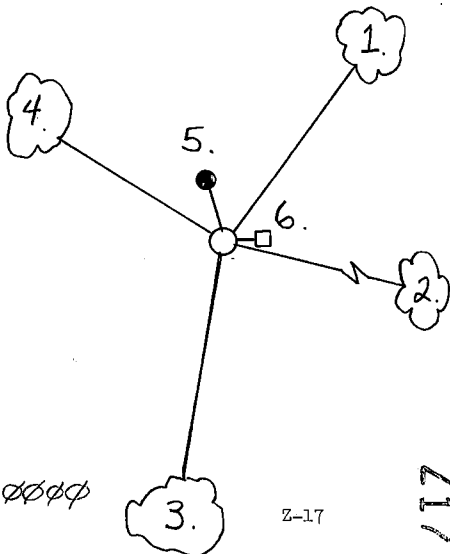

REGISTER'S OFFICE }  
Forest County, Wis.

Received for record this 1st day

of April A.D., 1984

at 2:05 o'clock P. M. and

recorded in Vol. CORNER RESTORATIONS

on page 2-17 Aschauer  
REGISTER

43616340000

- (e) Describe any material discrepancy between the location of the corner as restored or reestablished and the location of that corner as previously restored or reestablished by distance and direction. Show the discrepancy on the plan view drawing under (d), above. Show the distances between the corner as previously restored or reestablished and (1) the corner as restored or reestablished, and (2) to at least 2 of the witness monuments shown on the drawing in (d), above.


2" flue pipe set by Goodman Lumber Company was to be at single proportion position, but it is N.8°05'31"E., 9.51 feet from its proper position.

- (f) Was the corner restored through acceptance of (1) an obliterated evidence location, or, (2) a found perpetuated location?

Neither.

- (g&h) Was the corner reestablished through lost corner proportionate methods? If so, show the method, including the directions and distances to other public land survey corners used as evidence or used for proportioning in determining the corner location?


Single proportionate measure.

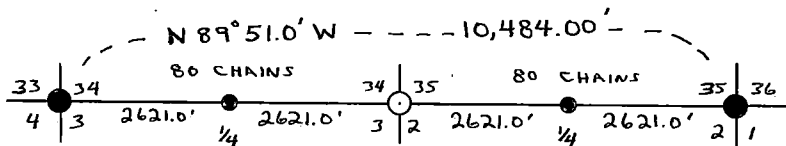

- (1) I, Milo E. Stefan  
(Type or print name) certify that the corner location shown on this record was determined by me or under my direction and control and that this U.S. Public Land Survey Monument Record is correct and complete to the best of my knowledge and belief.

Milo E. Stefan  
Signature

2/14/85  
Date

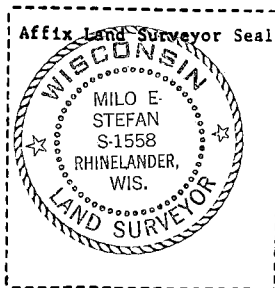

## U. S. PUBLIC LAND SURVEY MONUMENT RECORD


## INSTRUCTIONS:

This record shall show the location of the corner and shall include all of the following nine elements (a through i).

- (a) Identify the corner by reference to the U.S. public land survey system.

○ = Corner monument restored.

Quarter corner to Sections 2 and 35, T.35-36N., R.16E., Fourth Principal Meridian, Forest County, Wisconsin.

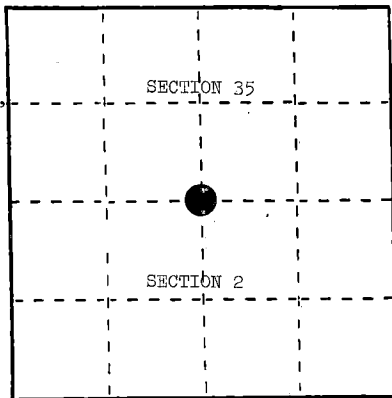

- (b) Describe any record evidence, monument evidence, occupational evidence, testimonial evidence or any other material evidence you considered, and whether the monument was found or placed.

1857, Artemas Curtis set post at 40.00 chains with the following BTs: Sugar, 7", S.5°E., 28 links; Basswood, 18", N.4°W., 18 links.


May 16, 1927, Goodman Lumber Company restored this corner by lost methods and set a 3" Popple post and a flue pipe in a mound of stone.

June, 1984, Milo Stefan found Goodman's flue pipe to be out of position by 11.44 feet, N.12°51'10"E., and set a 2" x 36" aluminum monument at the proper proportionate position.

- (c) In the plan view drawing below, provide reference ties to at least 4 witness monuments, or, if the location is within a municipality, to at least 2 witness monuments. (Witness monuments shall be made of concrete, natural stone, iron or other equally durable material.) Describe witness monuments.

- (d) Show a plan view drawing depicting the relevant monuments and reference ties which is sufficient in detail to enable accurate relocation of the corner monument if the corner monument is disturbed. Indicate north.

1. Sugar Maple, 10", N.77°E., 63.80 feet
2. Sugar Maple, 6", S.28°E., 47.30 feet
3. Sugar Maple, 6", N.68°W., 21.80 feet
4. Goodman's flue pipe, N.12°51'10"E., 11.44 feet
5. Steel Sign Post, 7', West, 1.5 feet

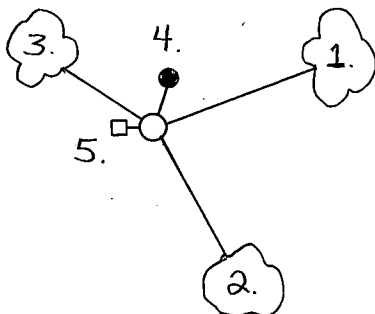

REGISTER'S OFFICE }  
Forest County, Wis. }

Received for record this... 1st day  
of April... A.D., 1985 at  
2:05 P.M. and

recorded in Vol. CORNER RESTORATIONS

on page 2-19. Paul A. Schanderman  
REGISTER

43616 35pp 20

- (e) Describe any material discrepancy between the location of the corner as restored or reestablished and the location of that corner as previously restored or reestablished by distance and direction. Show the discrepancy on the plan view drawing under (d), above. Show the distances between the corner as previously restored or reestablished and (1) the corner as restored or reestablished, and (2) to at least 2 of the witness monuments shown on the drawing in (d), above.


Goodman's flue pipe was to be set at single proportion position. It was found to be N.12°51'10"E., 11.44 feet from its proper position.

- (f) Was the corner restored through acceptance of (1) an obliterated evidence location, or, (2) a found perpetuated location?

Neither.

- (g&h) Was the corner reestablished through lost corner proportionate methods? If so, show the method, including the directions and distances to other public land survey corners used as evidence or used for proportioning in determining the corner location?


Single proportionate measure.

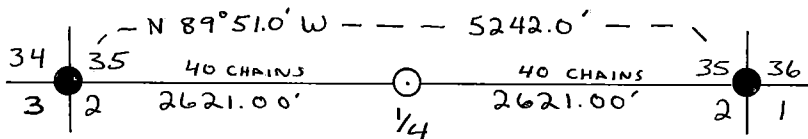

- (i) I, Milo E. Stefan (type or print name) certify that the corner location shown on this record was determined by me or under my direction and control and that this U.S. Public Land Survey Monument Record is correct and complete to the best of my knowledge and belief.

Milo E. Stefan  
Signature

2/14/85  
Date

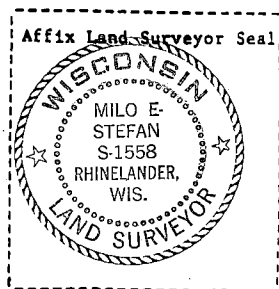

## U. S. PUBLIC LAND SURVEY MONUMENT RECORD


## INSTRUCTIONS:

This record shall show the location of the corner and shall include all of the following nine elements (a through i).

- (a) Identify the corner by reference to the U.S. public land survey system.

○ = Corner monument restored.

Quarter corner to Sections 1 and 36, T.35-36N., R.16E., Fourth Principal Meridian, Forest County, Wisconsin.

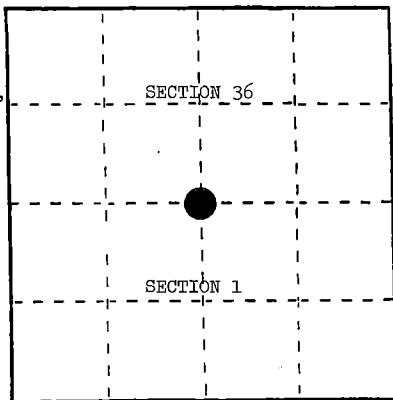

- (b) Describe any record evidence, monument evidence, occupational evidence, testimonial evidence or any other material evidence you considered, and whether the monument was found or placed.

1857, Artemas Curtis set post at 40.00 chains with the following BTs: Hemlock, 14", N.2°W., 38 links; Lynn, 10", S.48°W., 15 links.


1926, Goodman Lumber Company found 15" Hemlock windfall partially burnt, N.2°W., 32 links; Lynn, 20", S.48°W., 15 links. They set a 3" Hemlock post and a 3 1/8" flue pipe.

1984, Milo Stefan found 3 1/8" flue pipe with Hemlock roots, N.2°W., 25.08 feet; Lynn stump, S.48°W., 9.90 feet. He replaced the 3 1/8" flue pipe with a 2" x 36" aluminum monument in a mound of stone.

- (c) In the plan view drawing below, provide reference ties to at least 4 witness monuments, or, if the location is within a municipality, to at least 2 witness monuments. (Witness monuments shall be made of concrete, natural stone, iron or other equally durable materials.) Describe witness monuments.

- (d) Show a plan view drawing depicting the relevant monuments and reference ties which is sufficient in detail to enable accurate relocation of the corner monument if the corner monument is disturbed. Indicate north.

1. Sugar Maple, 8", N.48°E., 30.26 feet
2. Sugar Maple, 5", S.7°E., 6.82 feet
3. Basswood, 8", S.76°W., 20.79 feet
4. Steel Sign Post, 7', Northwest, 1.4 feet

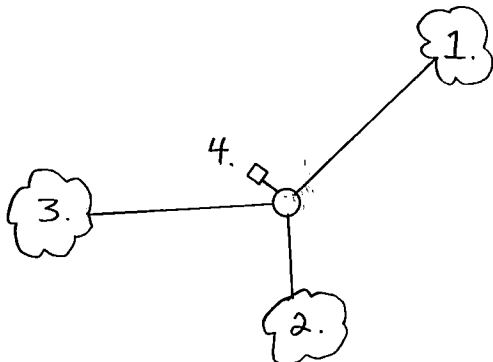

REGISTER'S OFFICE }  
Forest County, Wis. }

Received for record this 1st day

of April A.D., 1985 at

2:05 o'clock P. M. and

in Vol. CORNER RESTORATIONS

by Paul A. Schenck  
REGISTER

43616360020

- (e) Describe any material discrepancy between the location of the corner as restored or reestablished and the location of that corner as previously restored or reestablished by distance and direction. Show the discrepancy on the plan view drawing under (d), above. Show the distances between the corner as previously restored or reestablished and (1) the corner as restored or reestablished, and (2) to at least 2 of the witness monuments shown on the drawing in (d), above.

No.

- (f) Was the corner restored through acceptance of (1) an obliterated evidence location, or, (2) a found perpetuated location?

(2) a found perpetuated location.

- (g&h) Was the corner reestablished through lost corner proportionate methods? If so, show the method, including the directions and distances to other public land survey corners used as evidence or used for proportioning in determining the corner location?

No.

Affix Land Surveyor Seal



- (i) I, Milo E. Stefan  
(type or print name) certify that the corner location shown on this record was determined by me or under my direction and control and that this U.S. Public Land Survey Monument Record is correct and complete to the best of my knowledge and belief.

Milo E. Stefan  
Signature

2/14/85  
Date