State of Wisconsin  County of Forest  1	CERT	TIFIED LAND CORNER RESTORATION
I Jean F. Resyick do hereby certify that on the 15th day of May 19 74 I found evidence of the Morth quarter corner of Section 6 Township Do noxth Range 12 sast Nourth Principal Meridian, as described hereon; and that from this evidence I established a new monument and accessories as described hereon to per petuate the original location of this corner:  Description of original monument and accessories and subsequent restorations:  Original survey 1857 Dependent resurvey in 1941, by Guy R. Veal Proportionste distance set iron post, 3 feet long 2 inch diameter 1/4, 36, 1941 Maple 7, bears \$23°15E, 39 1ks. Maple 16, bears \$78° 15'W, 84 1ks. Standard corner of section 31 and 32 bears N89° 37'E, 8.42 chains  Description of corner evidence found:  Monument found marked as described. Monument was either set or has been turned approximately 180°.  Maple 11, bears 323° 15'E, 39 1ks. tree has been girdled Maple 20, bears \$78° 15'W, 84 1ks. Standard corner easterly 8.42 chains  Description of monument and accessories I established to perpetuate the location of this corner:  Blazed and scribed the following new bearing tree Maple 7, S63E, 128 feet  Set steel sign post 0.5 foot SW of monument  Signatur Jean F. Resylok Title Land Surveyor.  County Surveyors Registered Land Surveyor or other sluly subhorized effician)  Surveyors Registered Land Surveyor, or other sluly subhorized effician  Surveyors Registered Land Surveyor, or other sluly subhorized effician  Office of Register of Deeds County Number 105819  Office of Register of Deeds County Records.  Only of Porest Interest 10 feeds County Records.		•
I found evidence of the Morth quarter corner of		
Original survey 1877 Dependent resurvey in 1941, by Guy R. Veal Proportionate distance set iron post, 3 feet long 2 inch diameter with brass cap marked 1/4, 86, 1941 Maple 7, bears \$230 15.8, 39 lks. Maple 16, bears \$780 15.9 kg. 4 lks. Standard corner of section 31 and 32 bears N890 37.8, 8.42 chains  Description of corner evidence found:  Monument found marked as described. Monument was either set or has been turned approximately 1800.  Maple 11, bears \$230 15.8, 39 lks. tree has been girdled Maple 20, bears \$780 15.1 kg. 44 lks. Standard corner easterly 8.42 chains  Description of measurement and accessories I established to perpetuate the location of this corner:  Elazed and scribed the following new bearing tree Maple 7, \$632, 128 feet Set steel sign post 0.5 foot SW of monument  Resident witnesses.  Dated at Rhinelander Wisconsin, this 32 day of July 19.  Wisconsin, this 40 day of July 19.  Wisconsin, this 40 d	I found evidence of the North Township 40 north hereon; and that from this evidence	n quartercorner of6  Range12 east, Fourth Principal Meridian, as described et established a new monument and accessories as described hereon to per-
Dependent resurvey in 1941, by Guy R. Veal Proportionate distance set iron post, 3 feet long 2 inch diameter with brass cap marked Maple 7, bears \$23°15E, 39 lks. Maple 16, bears \$78° 15'W, 84 lks. Standard corner of section 31 and 32 bears N89° 37'E, 8.42 chains  Description of corner evidence found:  Monument found marked as described. Monument was either set or has been turned approximately 180°. Maple 11, bears \$32° 15'E, 39 lks. tree has been girdled Maple 20, bears \$78° 15'W, 84 lks. Standard corner easterly 8.42 chains  Description of manument and accessories I established to perpetuate the location of this corner:  Elazed and scribed the following new bearing tree Maple 7, \$65E, 128 feet Set steel sign post 0.5 foot SW of monument  Resident witnesses.  Dated at Rhinelander Wisconsin, this 32 day 6000000000000000000000000000000000000	Description of original monument an	nd accessories and subsequent restorations:
Monument found marked as described. Monument was either set or has been turned approximately 180°.  Maple 21, bears \$323° 15'E, 39 lks. tree has been girdled Maple 20, bears \$78° 15'W, 84 lks. Standard corner easterly 8.42 chains  Description of measurement and accessories I established to perpetuate the location of this corner:  Blazed and scribed the following new bearing tree Maple 7, \$63E, 198 feet Set steel sign post 0.5 foot SW of monument  Resident witnesses.  Dated at Rhinelander Wisconsin, this 30 day 0900000000000000000000000000000000000	Dependent resurvey in 1941, be Proportionate distance set in with brass cap marked Maple 7, bears \$23°15E, 39 1k Maple 16, bears \$78° 15'W, 84	on post, 3 feet long 2 inch diameter 1/4, S6, 1941 ss. 4 lks.
Apple 20, bears \$73° 15'E, 39 lks. tree has been girdled Maple 20, bears \$78° 15'W, 84 lks.  Standard corner easterly 8.42 chains  Description of measurement and accessories I established to perpetuate the location of this corner:  Blazed and scribed the following new bearing tree Maple 7, \$63E, 128 feet Set steel sign post 0.5 foot SW of monument  Resident witnesses.  Dated at Rhinelander. Wisconsin, this. \$20 day of Manufacture of County Surveyor, Registered Land Surveyor, or other duly authorized official)  Surveyors Registration No. \$-802 County of Forest I hereby certify that the within instrument was filed in this office for record of the day of August 19.74, and was filed in Bool No. BestionationPage No. \$4.3 of County Records.	Description of corner evidence found	d:
Blazed and scribed the following new bearing tree  Maple 7, S63E, 198 feet  Set steel sign post 0.5 foot SW of monument  Resident witnesses  Dated at Rhinelander Wisconsin, this 32 day of 2000 County Surveyor, Registered Land Surveyor, or other duly authorized official)  Surveyors Registered Land Surveyor, or other duly authorized official)  Surveyors Registered Land Surveyor, or other duly authorized official)  Surveyors Registered Land Surveyor, or other duly authorized official)  Surveyors Registered Land Surveyor, or other duly authorized official)  Surveyors Registered Land Surveyor, or other duly authorized official)  Surveyors Registered Land Surveyor, or other duly authorized official)  Surveyors Registered Land Surveyor, or other duly authorized official)  Surveyors Registered Land Surveyor, or other duly authorized official)  Surveyors Registered Land Surveyor, or other duly authorized official)  Surveyors Registration No. S-802  DCGUMENT NUMBER 105819  Office of Register of Deeds County of Forest  I hereby certify that the within instrument was filed in this office for record on the 8th day of August 19 74, and was filed in Bool No. RestorationPage No. A-3 of County Records.	approximately 180°. Maple 11, bears S23° 15'E, 39 Maple 20, bears S78° 15'W, 84	lks. tree has been girdled
Blazed and scribed the following new bearing tree  Maple 7, S63E, 198 feet  Set steel sign post 0.5 foot SW of monument  Resident witnesses  Dated at Rhinelander Wisconsin, this 32 day of 2000 County Surveyor, Registered Land Surveyor, or other duly authorized official)  Surveyors Registered Land Surveyor, or other duly authorized official)  Surveyors Registered Land Surveyor, or other duly authorized official)  Surveyors Registered Land Surveyor, or other duly authorized official)  Surveyors Registered Land Surveyor, or other duly authorized official)  Surveyors Registered Land Surveyor, or other duly authorized official)  Surveyors Registered Land Surveyor, or other duly authorized official)  Surveyors Registered Land Surveyor, or other duly authorized official)  Surveyors Registered Land Surveyor, or other duly authorized official)  Surveyors Registered Land Surveyor, or other duly authorized official)  Surveyors Registration No. S-802  DCGUMENT NUMBER 105819  Office of Register of Deeds County of Forest  I hereby certify that the within instrument was filed in this office for record on the 8th day of August 19 74, and was filed in Bool No. RestorationPage No. A-3 of County Records.	Description of manner 1	into I and What a second of the Control
Resident witnesses  Dated at Rhinelander Wisconsin, this 30 day of		• •
Resident witnesses  Dated at Rhinelander Wisconsin, this 30 day of 0.74.  Signatur Jean F. Resvick Title Lend Surveyor (County Surveyor, Registered Land Surveyor, or other duly authorized official)  Surveyors Registration No. S-802  DCGUMENT NUMBER Office of Register of Deeds County of Forest I hereby certify that the within instrument was filed in this office for record on the 8th day of August 19.74, and was filed in Bool No. RestorationPage No. A-3 of County Records.	Maple 7, S63E, 198 feet	i
Office of Register of Deeds County of Forest  I hereby certify that the within instrument was filed in this office for record on the 8th day of August 19 74, and was filed in Bool No. RestorationPage No. A=3 of County Records.	Sec. 6 s	desident witnesses
on the 8th day of August 19 74, and was filed in Bool No. RestorationPage No. 4-3 of County Records.		Office of Register of Deeds County of Forest
	<ul><li>Corner monument restored</li><li>D</li></ul>	on the 8th day of August 19 74, and was filed in Book No. RestorationPage No. A-3 of County Records.
Township 40 north , Range 12 east V, Section 6 V, Index No. A-3 , Page No.		() // 7

44/123/0020

W

HELLEN COMPANY TO STOCK NO. 26273


DOCUMENT NUMBER

O = Corner monument restored.

(e) Describe any material discrepancy between the location of the corner as restored or reestablished and the location of that corner as previously restored or reestablished by distance and direction. Show the discrepancy on the plan view drawing under (d), above. Show the distances between the corner as previously restored or reestablished and (1) the corner as restored or reestablished, and (2) to at least 2 of the witness monuments shown on the drawing in (d), above.
N/A.

- (f) was the corner restored through acceptance of (1) an obliterated evidence location, or, (2) a found perpetuated location?
  Found perpetuated location.
- (gkh) Was the corner reestablished through lost corner proportionate methods? If so, show the method, including the directions and distances to other public land survey corners used as evidence or used for proportioning in determining the corner location?

  No.

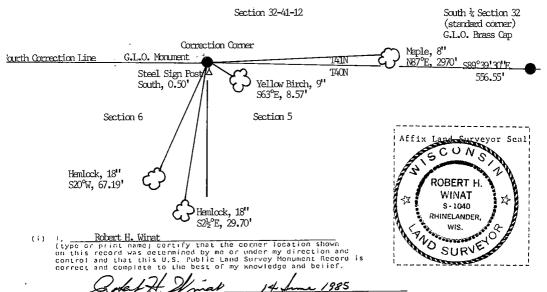

Signature

CE	RTIFIED LAND CORNER RESTORATION
State of Wisconsin  County of Forest ss	
I found evidence of the North w Township 40 north	est section corner of Section 5  Range 12 east Fourth Principal Meridian, as described ce I established a new monument and accessories as described hereon to personner:
Description of original monument	and accessories and subsequent restorations:
	concrete monument 2 feet long, 6 inches in diameter, with , S32, S6, S5, T40N, R12E, CC 1941
Description of corner evidence for	ind:
Monument found as described Hemlock 11, snag bears S571 Hemlock 19, bears S21W, 102	30E, 68.5 lks.
Description of acceptance and acceptance and scribe the follow Yellow Birch 8, S62E, 8.68 Set steel sign post 0.8 fee	feet.
	JEAN F. RESVICK RHINELANDER, WIS.
	Resident witnesses.
Sec. 5	Dated at Rhinelander Wisconsin, this 30 days of starting 1974.  Signature Jean F. Resvick Title Land Surveyor
	(County Surveyor, Registered Land Surveyor, or other duly authorized official)
	Surveyors Registration No. S-802 DOUMENT NUMBER 105820 Office of Register of Deeds County of Forest
	I hereby certify that the within instrument was filed in this office for record
<ul><li>Corner monument restored</li></ul>	on the 8th day of August 1974, and was filed in Book Nonestoretions Page No. A-5 of County Records.  Signature Light Plattant Title
Township 40 north , Range	

		corner of	Fourth Principal Me and that from this ev monument and acce to perpetuate the o
		Mike Stevens	***************************************
5273	<b>⊘</b>	Mike Lukasko	
Stock No. 26273	128453		
	NUMBER	1	1 1
	DOCUMENT NUMBER	<del> </del>	
	Д	1	


U.S. PUBLIC LAND SURVEY MONUMENT RECORD Index No. A - 7 State of Wisconsin History of original corner establishment: SS. County of Forest Dependent resurvey in 1941 by Guy R. Veal, set a 6"x24" concrete monument with a G.L.O. brass cap. Robert H. Winat 22nd certify that on the .. BT's: Maple 34 1ks. January 19 85 I found 51½ 1ks. Ash Range eridian. Description of corner evidence found: vidence essories Found G.L.O. monument and brass cap. original BT's: Maple 22.50 feet (dead) 33.90 feet S64°W Ash ......... Description of monument and accessories I established to perpetuate the original location of this corner. Blazed and scribed new BT's: S88½°E Sugar Maple 82.26 feet N38¾°E 69.04 feet all to nail in tree Sugar Maple Sugar Maple N45°W 15.19 feet Steel Sign Post 0.40 feet South (over) Rhinelander Dated at... Title K.L.S. Registration No. 1040 Forest Office of Register of Deeds, County of .... July certify that the within instrument was filed in this office for record on the 24th at 1:10 o'clock P. (Register of Deeds) O = Corner monument restored.

e) Describe any material discrepancy between the location of the corner as restored or reestablished and the location of that corner as previously restored or reestablished by distance and direction. Show the discrepancy on the plan view drawing under (d), above. Show the distances between the corner as previously restored or reestablished and (1) the corner as restored or reestablished, and (2) to at least 2 of the vitness monuments shown on the drawing in (d), above.

N/A.

- (f) was the corner restored through acceptance of (1) an obliterated evidence location, or, (2) a found perpetuated location?
  Found perpetuated location.
- (gkh) Was the corner reestablished through lost corner proportionate methods? If so, show the method, including the directions and distances to other public land survey corners used as evidence or used for proportioning in determining the corner location?

  No.

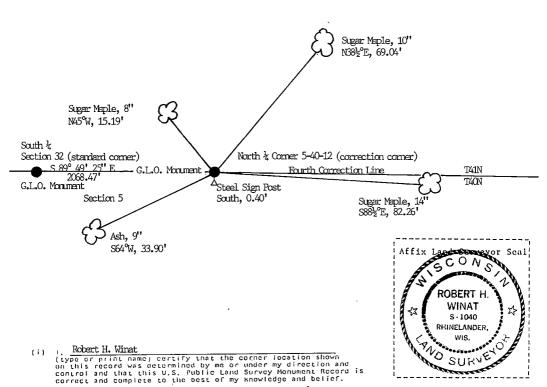

del H. Wm

State of Wisconsin
County of Forest ss.
I Robert H., Winat, do hereby certify that on the
Resident witnesses:
Mike Stevens
Mike Lukasko
Kentuck.


						mack none	
History of original corner es Dependent resurvey ir monument with a G.L.C	n 1941 by	y Guy R. Vea	al, set	a 6"x24" co	ncrete		
BT: Elm	7''	S18½°E	6 1ks				
	r						
Description of corner evider	ice found:						
Found 1" iron pipe up pipe in bank eroded b water, no base. Found BT's:	2". Fo y water.	ound 6"x6" 1 Found 6":	oroken c x6"x12" (	oncrete N64 concrete pi	°E 6' from ece in		
White Birch	8"	S42°W	9.10'	(set nail	in tree)		
Sugar Maple	13 <sup>11</sup>	S20°E	4.15'	(set nail	in tree)		
Description of monument a Set a 2"x36" aluminum identify corner. Bla Sugar Maple Steel Sign Pos	n monumer azed and 7" st	nt with 3" a scribed the S50°W : East	aluminum e follow 16.72' 1 2.00'	tablet star ing BT's: to nail in tre	mped to		:
Reference to S				哥	141N, K12	E, marked by	
a G.L.O. Brass	Cap; St	39°55'50'W,	380.22	• -			
(over)							
Dated at Rhinelander		, Wis., this	14	day of	June	1985	, 19
Office of Register of Deeds, instrument was filed in this	County of office for r	Title tered Land Surve Forest	R.L.S. yor, xxxxxx t 24th	XKXXXKKXKK dav	মসেন্ত্রপ্র) July of July	Registration No	the with
at 1:10 o'clock P.	M.			•			
Paul A	Schen	Grenne	v				
(R	egister of De						

\*

(e) Describe any material discrepancy between the location of the corner as restored or reestablished and the location of that corner as previously restored or reestablished by distance and direction. Show the discrepancy on the plan view drawing under (d), above. Show the distances between the corner as previously restored or reestablished and (1) the corner as restored or reestablished, and (2) to at least 2 of the vitness monuments shown on the drawing in (d), above.
N/A.

- (f) Was the corner restored through acceptance of (1) an obliterated evidence location, or, (2) a found perpetuated location?
  Found perpetuated location.
- (gkh) Was the corner reestablished through lost corner proportionate methods? If so, show the method, including the directions and distances to other public land survey corners used as evidence or used for proportioning in determining the corner location?

  No.

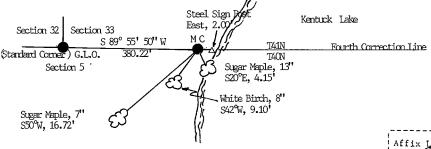

MC is set 2'X36'' aluminum morument w/3'' aluminum tablet, stamped to identify corner.

(i) I, Robert H. Winat
(type or print name) certify that the corner location shown
on this record was determined by me or under my direction and
control and that this U.S. Public Land Survey Monument Record is
correct and complete to the best of my knowledge and belief.

Signature 14 June 1985

ROBERT H.

WINAT
S-1040
RHINELANDER,
WIS.

SURNE

.....

21-04


k No. 26273	128461
Stock	NUMBER
	DOCUMENT

FORM NO. 985-A

U.S. P	UBLIC LAN	D SURVEY	MONUME	NT RECORD	Index	No. A 11-12
State of Wisconsin  County of Forest ss.	Dependent :	ginal corner estab resurvey by Gu onument with a	ıy R. Veal	in 1941. Set ass cap.	a 6"x24"	
I Robert H. Winat , do hereby certify that on the 6th day of February 19.85, I found evidence of the meander		lock	8" 14"	N403/4°E S23½°E	77 lks. 31 lks.	
Township	Rotted Hem Dead Hem	lock f corner evidence f ). monument.	14 <sup>**</sup> found:	N60½°E N18°W	12 lks. 44 lks.	
Resident witnesses:	Hem	lock Stump ren lock lock	nains with 21" 12"	cedar intertw S25°E N44°E	ined. (original) 20.30 feet (1941) 50.90 feet (1941)	
Mike Stevens	Set	nail in BT's.				-
Mike Lukasko						• '
	Description of Blazed and	f monument and a scribed BT's:	accessories I e	stablished to perp	etuate the original location of this corr	ner.
33 34 T446	L Stee	lock el Sign Post	9"	S21°W Southwest	35.74 feet to nail in tree. 1.00 feet	: 
	(over)					
4	Signature Office of Regi	County Surveyors ster of Deeds, Cor as filed in this office P	r, Registered La unty of ce for record of	Title R.L.S	day of June 1985.  Registration of the day authorized official)  th day of July	on No. 1040
O = Corner monument restored.	Ву			Del	outy	

(e) Describe any material discrepancy between the location of the corner as restored or reestablished and the location of that corner as previously restored or reestablished by distance and direction. Show the discrepancy on the plan view drawing under (d), above. Show the distances between the corner as previously restored or recstablished and (1) the corner as restored or reestablished, and (2) to at least 2 of the witness monuments shown on the drawing in (d), above.
N/A.

(f) was the corner restored through acceptance of (1) an obliterated evidence location, or, (2) a found perpetuated location?
Found perpetuated location.

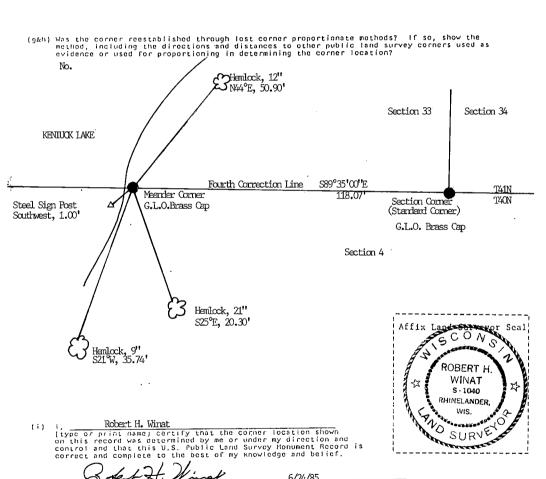

Signature


	26273	
-		
1	Stock No.	

DOCUMENT NUMBER

	U.S. PL	JBLIC	LAND	SURVEY	MONUME	NT REC	CORD	Index No.	A 11-12
State of Wisconsin County of Forest ss.		Depend	lent res	ul corner estal survey by G ment with	olishment: Guy R. Veal a G.L.O. b	in 1941. rass cap.	Set a 6"x24"		
I Robert H. Winat, do he certify that on the	day ound	BT's:	Hemloc Hemloc		11'' 6''	S42°W N32°W	38 1ks 56 1ks		
corner of	ange	Found: Rotted		(Hemlock) hole		N43°W N10°E	16 lks 22 lks		
as described hereon; and that from this evid I established a new monument and access as described hereon to perpetuate the origination of this corner.	lence ories		G.L.O.	rner evidence monument.	found:				
Resident witnesses:			Stump Stump Hemloc	(cut)	14''	N46°W S42°W N32°W	25 fee	et (original) et feet-set nail in tree	_
Mike Stevens Mike Lukasko								·	• •
				onument and cribed new		established to	o perpetuate the o	original location of this corner.	
KENTUK LAKE	74/1 740/		Sugar	Birch Maple Sign Post	12 <b>''</b> 5''	S27°E S25°W S2°E		feet to nail in tree feet to nail in tree feet	- -
		(over)	<b>.</b>						
4		Dated a		hinelander		is., this 24tl	day day	of June 1985	, 19
		Signatu	Register ent was fi	of Deeds, Colled in this off	Wind	Title R.I	L.S. or other duly authori 4th	Registration N  Thereby certify the lay of July	10.1040
O = Corner monument restored.		Ву					Deputy		

(e) Describe any material discrepancy between the location of the corner as restored or reestablished and the location of that corner as previously restored or reestablished by distance and direction. Show the discrepancy on the plan view drawing under (d), above. Show the distances between the corner as previously restored or reestablished and (1) the corner as restored or reestablished, and (2) to at least 2 of the vitness monuments shown on the drawing in (d), above.
N/A.

- (f) was the corner restored through acceptance of (1) an obliterated evidence location, or, (2) a found perpetuated location.
  Found perpetuated location.
- (gkh) Was the corner reestablished through lost corner proportionate methods? If so, show the method, including the directions and distances to other public land survey corners used as evidence or used for proportioning in determining the corner location?

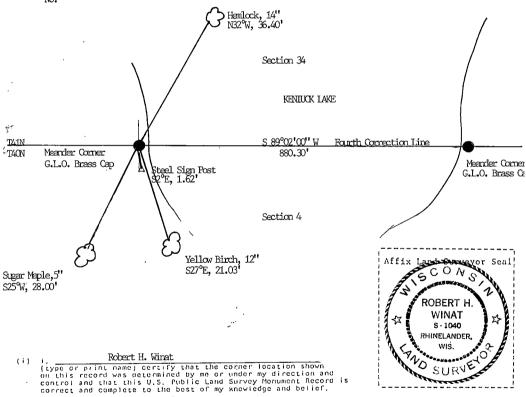

Robert H. Wind 6/24/85

Index No. A 12-13

-,,	concrete monument with a G.L.	). brass cap	o <b>.</b>		
IRobert H. Winat ,, do hereby certify that on the5thday ofFebruary, 1985, I found	BT's: no new BT's marked.	•			
corner of 40	Veal found fallen Hemlock Stump hole	20" Non N84	cth 27 lks. 4°E 11 lks.		
as described hereon; and that from this evidence I established a new monument and accessories as described hereon to perpetuate the original location of this corper.	Description of corner evidence found: Found G.L.O. monument. Found BT's:				
Resident witnesses:	Stump mound Stump hole	Noi N84	cth 18 feet (or 4°E 8 feet± (o		
Mike Stevens					
Mike Lükasko					- <del>-</del>
	Description of monument and accessor Blazed and scribed new BT's:	ies I establishe	d to perpetuate the origi	nal location of this co	orner.
TAN TAON	Sugar Maple - Hemlock Yellow Birch White Cedar Steel Sign Post	5" N30 6" N68 7" S62 9" S50 N13	3°E 29.22 feet 2°E 30.65 feet 0°W 25.65 feet	to nail in tree to nail in tree to nail in tree to nail in tree	17
	(over)				
4	Dated at Rhinelander	, Wis., this	24th day of	June 1	.985 , 19
	Signature (County Surveyor, Regist	Title	R.L.S. or, or other-duly authorized c	Registra	tion No. 1040
1 1 1 1	Office of Register of Deeds, County of instrument was filed in this office for reat1:100'clock	Fore	24th day	, I hereby certi of July	ify that the within
	Jaul Ascher (Register of Dee	Grenna ds)	v		
O = Corner monument restored.	Ву		Deputy		

♥ U.S. PUBLIC LAND SURVEY MONUMENT RECORD

History of original corner establishment: Dependent resurvey by Guy R. Veal in 1941. Set a 6"x24"

State of Wisconsin

County of Forest


28463

DOCUMENT NUMBER

SS.

Describe any material discrepancy between the location of the corner as restored or reestablished and the location of that corner as previously restored or reestablished by distance and direction. Show the discrepancy on the plan view drawing under (d), above. Show the distances between the corner as previously restored or reestablished and (1) the corner as restored or reestablished, and (2) to at least 2 of the vitness monuments shown on the drawing in (d), above. N∕A.

- was the corner restored through acceptance of (1) an obliterated evidence location, or, (2) a found perpetuated location?
  Found perpetuated location.
- (gkh) Was the corner reestablished through lost corner proportionate methods? If so, show the method, including the directions and distances to other public land survey corners used as evidence or used for proportioning in determining the corner location? No.

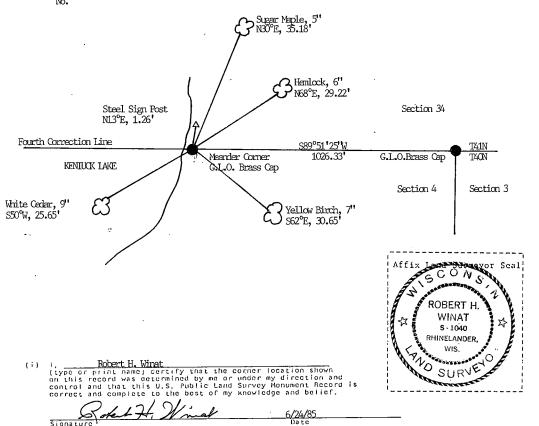

....


Signature

FORM NO. 985-A

0.3. 1	PUBLIC LAIND SURVEY MUNUMENT RECORD	Index No. A - 13
State of Wisconsin State of Wisconsin State of Wisconsin State of Wisconsin State of Misconsin State of Wisconsin State of Wisc	History of original corner establishment: Dependent resurvey by Guy R. Veal in 1941. Set a 6"x24" concrete monument with a G.L.O. brass cap.	
certify that on the 5th day	BT's: Maple 12" S31°E 22 lks. Maple 5" S27½°W 24 lks.	
cvidence of the closing corner corner of 4-3  Township 40 , North, Range 12 East , Fourth Principal Meridian, as described hereon; and that from this evidence I established a new monument and accessories as described hereon to perpetuate the original location of this corner.	Jean F. Resvick visited in 1969. He found G.L.O. monument. BT's: Maple 20" S31°E 14.50 feet (stump Maple 11" S27½ W 15.00 feet Set BT:Maple 12" S61½°E 12.47 feet Description of corner evidence found: Found G.L.O. monument. Found BT's:	)
Resident witnesses:	Sugar Maple 15" S63°E 12.60 feet Sugar Maple 14" S26°W 14.89 feet	*
Mike Stevens Mike Lukasko	(set nails in BT's)  Description of monument and accessories I established to perpetuate the original In Blazed and scribed new BT's:	~
34 91N	Sugar Maple 11" N75°W 17.08 feet to nai Sugar Maple 7" N50°E 31.50 feet to nai	
904	Steel Sign Post Southwest 1.00 feet	_
	(over)	
4	Dated at Rhinelander , Wis., this 24th day of	June 1985 , 19
	Signature Title R.L.S. (County Surveyor, Registered Land Surveyor, or other duly authorized official	Registration No. 1040
	Office of Register of Deeds, County of Forest instrument was filed in this office for record on the 24th day of at 1:10 o'clock. P	July 19.85
O = Corner monument restored.	Register of Deeds)  Deputy	

(e) Describe any material discrepancy between the location of the corner as restored or reestablished and the location of that corner as previously restored or reestablished by distance and direction. Show the discrepancy on the plan view drawing under (d), above. Show the distances between the corner as previously restored or reestablished and (1) the corner as restored or reestablished, and (2) to at least 2 of the vitness menuments shown on the drawing in (d), above. N/A.

- (f) Was the corner restored through acceptance of (1) an obliterated evidence location, or, (2) a found perpetuated location?
  Found perpetuated location.
- (gkh) Was the corner reestablished through lost corner proportionate methods? If so, show the method, including the directions and distances to other public fand survey corners used as evidence or used for proportioning in determining the corner location?

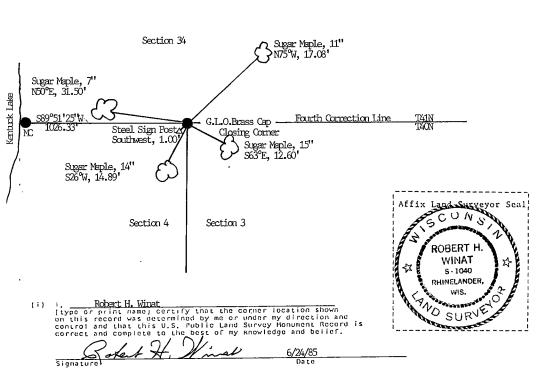

CERTIFIED LAND CORNER RESTORATION
State of Wisconsin
County of Forest. ss.
I Jean F. Resvick do hereby certify that on the 13th day of February 19.69, I found evidence of the Northwest Section corner of Section 3.  Township 40 North Range 12 East Fourth Principal Meridian, as described hereon; and that from this evidence I established at new and an accessories as described hereon to perpetuate the axiginal location of this corner:
Description of resignal kmonument and accessories and subsequent restorations:  Surveyed in 1859 by Wm. E. Daugherty. Dependent resurvey in 1941 by  Guy R. Veal. Intersect the 4th standard parallel North, at the point  for the closing corner of secs. 3 and 4, as determined by proportionate  measurement, set a concrete monument 2 ft. long, 6 ins. diam., 18 ins.  in the ground for the closing corner of secs. 3 and 4 with an iron  post 22 ins. long, 1 in. diam., encased therein, with a brass cap mkd:  THON R12E  C C  A maple, 12 ins., bears S 31°E, 22 LKs.  A maple, 5 ins., bears S 27°30°W, 24 LKs.
Description of corner evidence found:  Monument as described above in place.  Maple, 20 ins. stump, S 31°E, 14.5 ft. (Tree was recently cut by logging crew.)  Maple, 11 ins., S 27°30'W, 15.0 ft.
Description of xwarenesext and xaccessories I established to perpetuate the original location of this corner: Blazed and scribed the following new bearing tree: A maple, 12 ins., bears S 61°30'E, 12.47 feet or 18.89 LKs.
JEAN F. RESVICK RHINELANDER, WIS.
Resident witnesses  Dated at Rhinelander Wisconsin, this 27th day of February  19.69  Signature Jean F. Resvick Title Cadastral Surveyor  (County Surveyor, Registered Land Surveyor, or other duly authorized official)  Surveyors Registration No. S=802  Office of Register of Deeds County of Forest
I hereby certify that the within instrument was filed in this office for record on the 26th day of August 19 69, and was filed in Book No. I Page No. of County Records.  Signature Signature Title Register of Deeds  Township 40 North , Range 12 East , Section 3 , Index No. A=13 , Page No.

CE	RTIFIED LAND	ÇORNER	RESTORATION		•
State of Wisconsin  County of Forest s	s.	,	DOCUMENT NUMBI	er 9	9452
I Jean F. Resvick I found evidence of the North Township 40 North hereon; and that from this evidence the original location of the	Quarter , Range 12 F nce I established a	last	corner ofSec	rion Principa	l Meridian, as described
Description of original monument	and accessories an	ıd subseque	nt restorations:		
Surveyed in 1859 by Wm. E. the 4th Standard Parallel N the original plat. Set a c in the ground, for the k set 83, 1941. From which the f Maple, 18", bears S37E Maple, 12", bears S12W. The standard corner of bears N89°57'E, 8.07 c. Description of corner evidence for	orth, and at proncrete monumer of ollowing bear: 1, 106 lks. 1, 123 lks. 2, Sections 34 and hains.	roportion nt, 2 fee f Section	ate distance bat long, 6 inche 3, only with a	nsed on es in o n bras:	n the record of diameter, 18 inches s cap stamped: ½,
Maple The ot Section N89°57		eter, (bla ee was not on the 4th	t recovered. To standard para	he sta llel N	
1941					
Description of monument and acc	essories I establishe	ed to perpe	tuate the original	location	of this corner:
Blazed and scribed the foll Maple, 7", bears S77W, Maple, 7", bears S52E, Set a steel sign post North	6.37 feet 28.97 feet				
	,	1	TA TA	JEAN RESVICE	F. XI MARINE
	Resident witnesse	s	The same of the sa	301	A Control of the Cont
	19.70 Kan	- f. Kes	ouk.		day of Nov.
Sec. 3	(County Surve Surveyors Registr	yor, Register	ed Land Surveyor, or	other di	dastral Surveyor ly authorized official)
				nty of	Forest
	I hereby certify t	hat the wit	hin instrument wa	s filed	in this office for record , and was filed in Book
= Corner monument restored	No	Page No.	) A-15 of €	County 1	Records.
Township 40 North , Range	- //		// //		
44/1:	234 RX20	,	,		

CE	RTIFIED LAND CORNER RESTORA	ATION
State of Wisconsin		
County of Forest ss	•	
I found evidence of the North Township 40 North	, do hereby certify that on the	f Section 3 ourth Principal Meridian, as described
Description of original monument	and accessories and subsequent restorati	ions:
North township line surveyed Dependent resurvey by Guy R From remains of an original cap marked T40N, R12E, S2, From which the following be Hemlock, 6", S12E, 83 lks. Maple, 9", S72W, 108 lks.	• Veal in 1941 bearing tree, set 6" diameter c 53, 1941	oncrete monument with brass
.  Description of corner evidence for	nnd:	
Monument as described and i		
Hemlock, 16", S12E, 83 lks. Maple stump, S72W, 108 lks.	n prace	
Description of monument and acc Blazed and scribed the foll Maple, 22", S26E, 49.72 ft. Maple, 13", S15W, 36.17 ft. Hemlock, 15", N77W, 57.50 f Steel sign post, Southeast,	t <b>.</b>	WILLIAM B. COCHRANE S-1107
	DOCUMENT NO.	HILES, WISCONSIN
	124411	TO SURVE LINE
•	Resident witnesses	<i>j</i>
	Dated at Hiles William B. Co	isconsin, this day of fuly
Section 3	Signature William B. Cochrane	
·	(County Surveyor, Registered Land Sur	veyor, or other duly authorized official)
ş <sup>e</sup> f	Surveyors Registration No. S-110	
	Office of Register of Deeds	
Corner monument restored	I hereby certify that the within instrum on the 7th day of October No. Page No.	1983 and was filed in Boo
<u> </u>	Signature Ligen States	
Township 40 North Rang	· // //	ndex No. A-17 Page No.
	14112:340000	_

U.S. P	UBLIC LA	ND SURV	EY MON	JMENT RE	CORD	·•
Note: This form is inter Public Land Surv conform with said (a) Corner location:	ey Monument Reco d requirements	o fulfill all requirem rd (3) (a) (b) (c) (d) ( O North	ents of Wisconsin (e) (f) (g) (h) (i). An	Administrative Code additional sheet may	a, Chapter A-E 5. y be added if nece	02, U.S
	Range I2	_East/West				
Town/City/Village	Hiles					
	Forest		•			
			<del></del>		SectionI	
the corner.	nial, occupation if nothing was ough lost corne o establish. meter brass	al, plats, records found, state ever proportionate capped round t was re-est	s, other monum vidence used methods, ind	ents) used as a bas a basis for esta	pasis for accep ablishing locat ents, distance	oting. I tion. I es and
BT's recover	ed from the ch Stump Birch Stub	•	20.71fe	et bing visible.		
Other BT's f	ound: 7" Y. 8" S.		29 <sup>0</sup> E 10 70 <sup>0</sup> W 30	Received of	County, Wis. of the record this of the record the record the record that the record the record that the r	_ at
(c) (d) (e) Plan view o established corne disputed corner.	f corner with ties r, show the dist	to at least 4 witi ances between	ness monumer the two corne	its. If in disagreer	Register of Deeds nent with previ cate the ties t	ously to the
ciopalica domini.	•			ි <i>ගු</i> 6" s	• Maple	
,	441	1235pp	<b>P</b> P	/ N 21° / 17.7		
			Brass capp	La costeer s		
	•,	s 70°			5" 	Spruc
	8" S. Maple		* 4 .	े ज		
·Scale 1" =	10 feet	Note:	. Measuremer	7" Y. Bir Its are to nai		
	.6	, 1,000	rootcrown	of tree.	بر پېر	
(i) I, Stephen J. F. (type or print name was determined by this U.S. Public L complete to the beautiful to t	e) certify that they me or under my and Survey Morest of my knowled favorities.  Survey: Gamele Survey:	y direction and comment Record edge and belief.  April  Jamil	on this record ontrol and that is correct and 9, 1988 ate,//7/88	STEPHE FAVOR S-161 ST. GERN WI	N J. *	Index No. #- 21
	District	kanger, Da	ite , ,	<***********************************	Tère.	40-1

## 136573

<del></del>		<del></del>			
U.S. P	<b>UBLIC LANI</b>	D SURVI	EY MONU	MENT RE	CORD
Note: This form is inten Public Land Surve	ey Monument Record (3	fill all requireme ) (a) (b) (c) (d) (e	ents of Wisconsin A e) (f) (g) (h) (i). An a	Administrative Code	, Chapter A-E 5.02, U.S be added if necessary t
conform with said (a) Corner location:	Township 40	_North	REGISTER'S OF	FFICE	
•••	10	ı <u>st</u> /West	Forest County  Received for the following	ord this	
Town/City/Village	Hiles	·	In Vol. CORNER	M. and recorded RESTORATIONS	
County	Forest		Regisk	er of Deeds	
	•		η, -	•	SectionI
not accepted or	nial, occupational, p if nothing was fou ough lost corner p	olats, records, nd, state evi	, other monume idence used as	ents) used as a b s basis for esta	asis for accepting. I blishing location. I
lying on the	meter brass cap ground. The m Office Depende	onument wa	as re-establ	identifying ished from th	the corner ne 1941
BT's recover 18" Y. 26" Hem	ed from the 194 Birch Stump S lock S	11 Resurvey 38° E 29 50° W 1	0.04 feet	e S	
was evidentl	s we were able y removed and r his area that m	eset monum	ment off BT'	s. There has	monument s been some
				•	
(c) (d) (e) Plan view of established corner disputed corner.	corner with ties to a r, show the distanc	es between Note: Mea	the two corner	s and also indic re to nail s	ate the ties to the
	441123	86.000ZØ		BT made: 16" S. Mapl	Le.
	BT ma			90	
1		Maple		/N 37° E 28.17'	•
	, , , , ,	N 33 <sup>0</sup> W		20.17	ı
		\17.80°			post NE, 1.0° 4" Hemlock I made.
   Scale 1" = 1	O feet 1041 cr	0. 200-00	N 710 E		
,	capped irom	O Brass	S 50° W,	1.32'	
	26	" Hemlock		anninining.	1999.
(i) I, Stephen J.	Favorite e) certify that the co	RLS#S-1	.616	HILLIAN STATE	Index Index
was determined by	y me or under my di	rection and co	ontrol and that	STEPHE	NJ.
	and Survey Monumest of my knowledg		s correct and	STEPHE FAVOR S-161 ST. GERI	6 7
Staphen (	). Favorto		. 1988	WI	A SALAN DE LA COLONIA DE LA CO
Signature Survey requested b	y; Jamel of	Da Da	te 11/11/88	SUR	Minimum C
	District Rar	iger, Dat	te.		. 40

### DOCUMENT NUMBER

### 136571

# U.S. PUBLIC LAND SURVEY MONUMENT RECORD

Note: This form is intended and design Public Land Survey Monument conform with said requirements	Record (3) (a) (b) (c) (d) (e) (f) (a) (i	isconsin Administrativ h) (i). An additional she	e Code, Chapter A-E 5.02, U.S. et may be added if necessary to
(a) Corner location: Township			_ Lillin M
<b>D</b>	2	•	
Hange	2 <u>East/</u> West		<b>→</b>
Town/City/Village Hiles		<del>-</del> .	
County Fores	st		
		• •	Section1
(b) (f) (g) (h) Description of more (material, testimonial, occupa- not accepted or if nothing values through lost of directions used to establish.	itional, plats, records, other r was found, state evidence	nonuments) used used used as	as a basis for accepting. If restablishing location. If
Found 2" diameter bras The monument was re-es Dependent Resurvey.	ss capped iron pipe st stablished from the 19	amped identify 941 General Lar	ing the corner.
BT's recovered from th	ne 1941 Resurvey:		
17" S. Maple (dyi	ing) S 77.1/2° E	7.26 feet	REGISTER'S OFFICE Forest County, WI
7" Maple Stump	N 81 1/2° W	14.52 feet	Received for record thisde
			of HELMULL AD, 1970
			recorded in Vol CORNEX REST
		_	and Aschention
,	· ·		REGISTER
(c) (d) (e) Plan view of corner with established corner, show the disputed corner. Made 4 new	distances between the two	numents. If in disa corners and also 6" S. Maple	indicate the ties to the
,	1941 GLO bras	l bodden	
<b>/</b>	iron pipe.	ss capped	
	8" S. Ma	s 88° w 839 ple 64. 90.54 /s 18° / 22.29	W
		් ර	
Scale 1" = 30 feet		. 12" S. Mapl	e
	Note: meas root	urements are t crown of tree.	o nail set in
(i) ! Stephen J. Favorite	RLS#S-	1616	
(type or print name) certify that was determined by me or under this U.S. Public Land Survey complete to the best of my kn	t the corner location on this i er my direction and control ar Monument Record is correc	record surrent	CONSTITUTE AND CONSTI

Signature Survey requested by;

40-12

8, 1988 ST. GERMAIN / WI

1/10/88

Date


Jamele Gard District Ranger

FORM NO, 985-A	K.C. Miller Company Profiler	Stock No. 26273	

State of Wisconsin  County of Forest ss.  Robert H. Winat do hereby	History of original corner Dependent resurvey monument with a G.	in 1941 b	y Guy R. Ve	eal, set a 6":	:24" concrete		
certify that on the 23rd day of January 19.85, I found evidence of the quarter corner of 5-6  Township 40, North, Range 12 East Fourth Principal Meridian,	BT's: Ash Maple	9 <b>''</b> 10 <b>''</b>	S38°E S48°W	83 1ks. 56 1ks.			
as described hereon; and that from this evidence I established a new monument and accessories as described hereon to perpetuate the original location of this corner.	Description of corner evi- Found G.L.O. monume No BT's found.						Ø
Resident witnesses:							3
Mike Stevens							86
Mike Lukasko							N
	Description of monument Blazed and scribed		ries I establish	ed to perpetuate	the original location	of this corner.	44012662000
	Spruce Ash Ash Maple Steel Sign Pos	15" 10" 14" 16"	S21°E S7눌°E S41°W N4°E East	105.52 feet 64.44 feet 63.89 feet 45.69 feet 2.00 feet	all to nail in th	œ	1
1 1 1	(over)						
5	Dated at Rhinelande	er	, Wis., this.	14	day of June	1985	19
1 1 1	Signature Sold 2	SuxxxxXX Regis	Title	R.L.S.	KXXXXXXXXXXX	Registration N	Io. 1040
	Office of Register of Deec instrument was filed in the at. 1:10	ds, County of his office for r	ecord on the	orest	I her	reby certify the	at the within
		(Register of De		•••••			
O = Corner monument restored.	Ву			Deputy			

(e) Describe any material discrepancy between the location of the corner as restored or reestablished and the location of that corner as previously restored or reestablished by distance and direction. Show the discrepancy on the plan view drawing under (d), above. Show the distances between the corner as previously restored or reestablished and (1) the corner as restored or reestablished, and (2) to at least 2 of the vitness monuments shown on the drawing in (d), above.
N/A.

- (f) was the corner restored through acceptance of (1) an obliterated evidence location, or, (2) a found perpetuated location?
  Found perpetuated location.
- (g&h) Was the corner reestablished through lost corner proportionate methods? If so, show the method, including the directions and distances to other public land survey corners used as evidence or used for proportioning in determining the corner location?

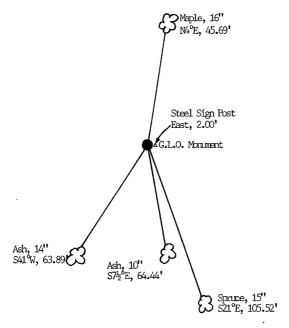

(i) 1. Robert H. Winat
(type or print name) certify that the corner location shown
on this record was determined by me or under my direction and
control and that this U.S. Public Land Survey Monument Record is
correct and complete to the best of my knowledge and belief.

Gotal H. Wimal 14 frame 1985



128466

DOCUMENT NUMBER

State of Wisconsin		
County of Forest ss.	History of original corner establishment: Dependent resurvey by Guy R. Veal in 1941. Set a 2"x36" iron pipe with a G.L.O. brass cap.	
I Robert H. Winat , do hereby	BT's: Maple 7" S55°E 44 lks.	
certify that on the 4th day	Maple 9" S72°15'W 29 lks.	
of February, 19.85, I found evidence of thequarter	Jean F. Resvick visited corner in 1969. He found the G.L.O. brass cap and BT's:	
corner of 3-4		
Township	Maple stump S55°E 29.00 feet rotted 19.30 feet Set BT:Maple 6" S20°E 23.60 feet Description of corner evidence found:	
I established a new monument and accessories as described hereon to perpetuate the original	Found G.L.O. monument. Found BT's:	$\mathscr{C}_{k}$
location of this corner.	Maple 20" N57°W 9.80 feet	200
Resident witnesses:	Maple 10" S17°E 23.65 feet	18
	Maple 18" S75°W 19.35 feet	
Mike Stevens	Wood Sign Post S78°W 1.30 feet	20
Mike Lukasko		012,0
	Description of monument and accessories I established to perpetuate the original location of this corner.	_
	Blazed and scribed new BT:	- 4
	Maple 8" N57°E 21.53 feet to nail in tree	4
	(over)	
4	Dated at Rhinelander , Wis., this. 24th day of June 1985	19
	Signature Gounty Surveyor, Registered Land Surveyor, or other duly authorized official) Registration No. 14	040
		a within
	Office of Register of Deeds, County of Forest I hereby certify that the instrument was filed in this office for record on the 24th day of July	1985
	at 1:10 o'clock P. M.	
	Paul Aschenbrenner	
i į	(Register of Deeds)	
	· (Register of Deeds)	
O = Corner monument restored.	ByDeputy	

(e) Describe any material discrepancy between the location of the corner as restored or reestablished and the location of that corner as previously restored or reestablished by distance and direction. Show the discrepancy on the plant view drawing under (d), above. Show the distances between the corner as previously restored or reestablished and (1) the corner as restored or reestablished, and (2) to at least 2 of the witness manufacts shown on the drawing in (d), above.


N/A.

(f) was the corner restored through acceptance of (1) an obliterated evidence location, or, (2) a found perpetuated location?

Found perpetuated location.

(9kh) Was the corner reestablished through lost corner proportionate methods? If so, show the method, including the directions and distances to other public land survey corners used as evidence or used for proportioning in determining the corner location?

No.

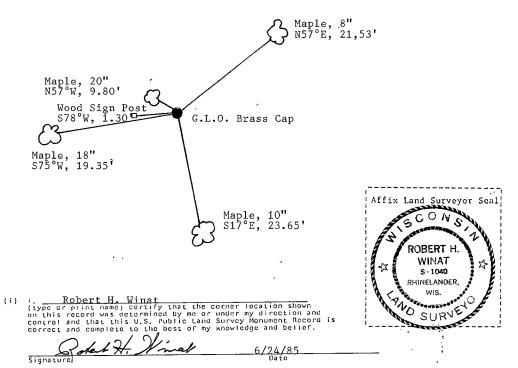

.....

CE	RTIFIED LAND CORNER	RESTORATION		
State of Wisconsin  County of Forest ss				
I Jean F. Resvick  I found evidence of the West of Township 40 North hereon; and that from this eviden petuate the noticinal location of thi	uarter , Range <u>12 East</u> ce I established <b>x new mon</b>	corner of Secti	.on 3 ncipal Meridian, as	
Description of original monument	and accessories and subseque	ent restorations:		
Surveyed in 1859 by Wm. E. Dependent Resurvey in 1911 At proportionate distance s cap marked 1/4, Sh, S3, 194 Maple 7, bears S55E, 144 Maple 9, bears S72015'W	by Guy R. Veal et an iron post, 3 ft. 1. 1ks.	long, 2 inches i	n diameter with	ı brass
Description of corner evidence fou Iron post with brass camp s Maple stump, Rotted bea Maple 16, healed over b	tamped as described abors 555E, 29 feet			
Description of AMERICAN CRACK Blazed and scribed a New be Maple 6, bears S20E, 23	aring tree	etuate the original lo	cation of this corn	er:
4.	491ZØA <i>ZØ</i> ØØ		JEAN RESVI	ICK A
	Resident witnesses  Dated at Rhinelander  19.70	-	30 A D	Part A
Sec. 3	Signature Jean F. Resvic (County Surveyor, Registe Surveyors Registration No.	red Land Surveyor, or o		
	Office of Register of D I hereby certify that the wi	eeds Count	y of Forest filed in this office	for record
<ul><li>Corner monument restored</li><li>=</li></ul>	on the 22nd day of No. Page No.	0-13 of Co		

, Section...

, Index No. C-13 , Page No.

Sep.

Township 40 North , Range 12 East

	CERTIFIED LAND CORNER RESTORATION
State of Wisconsin County of Forest	ss.
I found evidence of the West Township 40 North	day of October , 19 69 , center one sixteenth
Section subdivision surv	ent and accessories and subsequent restorations:  by Ripco established location of corner. Corner marked by 1  on pipe with a 2 inch square brass plate welded on top which is  er.
Description of corner evidence	found:
iron pipe with 2 inch so	.4 ft. from the west 1/4 corner of section 3 found 1 inch diamet hare brass plate stamped C-W1/16, Ripco. From which a blazed and meter, bears N11E, 9.50 feet. ars N88°21'E, 1324.5 feet.
Description of monument and	accessories I established to perpetuate the original location of this corner:
Blazed and scribed the f Balsam 7, double, bea Balsam 7, bears S56°w	ollowing new bearing trees s \$400E, 53.34 ft. 25.48 ft.
	JEAN F. RESVICK RHINELANDER, WIS.  Resident witnesses.
	Dated at Rhinelander Wisconsin, this Jethday of January
Section 3	Signature dean F. Resvick  Signature dean F. Resvick  County Surveyor, Registered Land Surveyor, or other duly authorized official)  Surveyors Registration No. S-802  Office of Register of Deeds  County of Forest
Corner manuscrat	I hereby certify that the within instrument was filed in this office for record on the 22nd day of May 19.70., and was filed in Bool
<ul><li>Corner monument restor</li><li>=</li></ul>	No. Page No. G-14 of County Records.  Signatur Gugen States my Title Register of Deeds

40 North , Range

Township.

3 Index No.

CI	ERTIFIED LAND CORNER RESTORATION
State of Wisconsin  County of Forest	ss.
I found evidence of the Center Township 40 North	, do hereby certify that on the 23rd day of October , 19.69 , quarter, Corner of Section 3
Description of original monument	t and accessories and subsequent restorations:
Section subdivision survey marked by a 2 inch outsid top and stamped to identi	y by Ripco establish the location of center quarter corner. Corner e diameter iron pipe with a 3 inch square brass plate welded on fy corner.
,	
2780.6 ft. from the north with 3 inch square brass white spruce 7 inch di	nund:  2 ft. from the south quarter corner of section 3 and S1°07'W, quarter corner of section 3 found 2 inch diameter iron pipe plate stamped C1/4, S3, Ripco. From which a ameter, bears N83W, 19.55 ft. amter, bears S23E, 19.05 ft.
I did not add any new acc	cessories I established to perpetuate the original location of this corner: essories. zed south to the south quarter corner and west to the west - center
·	44012 Ø3 ZØZØ  JEAN F. RESVICK RHINELANDER, WIS.
Section 3	Resident witnesses.  Dated at Rhinelander Wisconsin, this will have been sent to be a second of the
	Surveyors Registration No. S-802 DOCUMENT Number 98064
	Office of Register of Deeds County of Forest  I hereby certify that the within instrument was filed in this office for record
© - Corner monument restored	on the 22nd day of May 19 70, and was filed in Book No. Page No. C-15 of County Records.

40 North Range

12 East

ហ

, Index No. C-15 , Page No.

	. R9-7150-11 (9/1/66) H. C. MILLER CO., MILWAUKET 450024
CE	RTIFIED LAND CORNER RESTORATION
State of Wisconsin  County of Forest ss	s.
I found evidence of the East Qua Township 40 North	Range 12 East Fourth Principal Meridian, as described are I established a new MAGNAMENE AND Accessories as described hereon to per-
Surveyed in 1859 by Wm. E. Dependent Resurvey in 1941 At proportionate distance s	
Description of corner evidence for Monument found as described Maple 7, bears N46E, 46.9 f Maple blow down, S59W, 121	above.
Description of meanument and cace Blazed and scribed the foll Spruce 10, S73E, 37.99 Spruce 6, S24W, 15.31 f	ft.
	44012032000 JEAN F. RESVICK BHINELANDER.
Section 3	Resident witnesses  Dated at Rhinelander Wisconsin, this Resident witnesses  19.70  Signature Sean F. Resvick TitleCadastral Surveyor (County Surveyor, Registered Land Surveyor, or other duly authorized official)
	Surveyors Registration No. S-802 DOCUMENT No. 98063.  Office of Register of Deeds County of Forest.  I hereby certify that the within instrument was filed in this office for record on the 22nd day of May 19.70, and was filed in Book No. Page No. C-17 of County Records.

Township 40 North

Signatur Jug

, Section...

12 East

., Range

., Index No.

	R9-7150-11 (9/1/66) H, C. MILLER CO., MILWARKEE 458024
CE	ERTIFIED LAND CORNER RESTORATION
State of Wisconsin  County of Forest state	is.
	do hereby certify that on the 21st day of October 19.69
Township 40 North	One sixteenth
Description of original monument	t and accessories and subsequent restorations:
	$2\frac{1}{4}$ lks.
	ter pipe with 2 inch square brass plate stamped to identify llowing scribed bearing trees bear. White pine 14, Sh5E, 47.7 ft
	ressories I established to perpetuate the original location of this corner:  ved and was nearly out of the ground. I drove monument down and making it stable.
-	44012041000  JEAN F. RESVICK RHINELANDER, WIS.
Section 3	Dated at Rhinelander Wisconsin, this 23 day treatmary  19.70
	(County Surveyor, Registered Land Surveyor, or other duly authorized official)
<b>•</b>	Surveyors Registration No. 5-002 DOCUMENT NUMBER 98062 Office of Register of Deeds County of Forest
= Corner monument restored	I hereby certify that the within instrument was filed in this office for record on the 22nd day of May. 19.79, and was filed in Book
- Instanting restored	NoPage Noof County Records.

VIndex No. D-13

40 North , Range

State of Wisconsin  County of Forest ss.
I Jean F. Resvick , do hereby certify that on the 13th day of October , 19.69 , I found evidence of the Southwest 1/16
Description of original monument and accessories and subsequent restorations:
Section subdivision survey by Ripco established location of corner.  Corner marked by a railroad spike in the west edge of road.  Bearing trees by Ripco.  White pine 14, S68W, 25½ lks.  White pine 8, S65E, 57½ lks.  Iron pipe, 1 inch diameter with 2 inch square brass plate weldedon top.  Stamped 25 lks. East, 16.50 ft.
Description of corner evidence found:
Witness monument was brass plate stamped as recorded. Railroad spike in west edge of road, 16.50 ft. east of witness corner. White pine 14, S68W, 16.38 ft. (Later removed by road construction.) White pine 11, S65E, 38.00 ft. To protect this location from possible loss from road building I set hub NO 21'E on 1/16 line 75.00 ft. for witness corner. I put nails with bottle caps in bearing tree at the distance recorded above. I put nail and bottle cap in white pine, NW of corner a distanc of 52.66 feet. I also blazed and scribed two new bearing trees as shown below. Description of monument and accessories I established to perpetuate the location of this corner:
On June 1, 1973 before road was surfaced I replaced hub set at NO <sup>o</sup> 21'E, 75.00 ft. from corner with a 2 inch inside diameter galvanized iron pipe, 3 feet long, filled with concrete to weigh 5 pounds per foot with brass cap stamped witness corner we to identify corner.
From this and other witness established I set a 1 inch square iron bar, 18 inches long, 6 inches below surface of road. Top of bar punched to identify point measured too, from this point the following bearing trees bear:  White pine 12, S72°05′E, 84.42 ft.  White pine 11, S65°E, 38.00 ft.  White pine 12, N80°42′W, 92.64 ft.  White pine 18, northwest, 52.66 ft. (Not blazed or scribed.)
Resident witnesses:  Dated at Rhinelander Wisconsin, This RESUCK  Dated at Rhinelander Wisconsin, This RESUCK  1973  Signature Jean F. Resulck Title fand Surpression  (County Surveyor, Registered Land Surveyor, or other duly featogised Official)  Surveyors Registration No. S-802  Office of Register of Deeds County of Forest  I hereby certify that the within instrument was filed in this office for record on the 13th day of November 1973., and was filed in Book  Corner Restorations  Aday of November 1973., and was filed in Book  Corner Restorations
Signature Cufinitation Title Register of Deeds  Township 40 North Page 12 Fast Section 3 Inde No. D. 14 Page No.

	CERTIFIED LAND CORNER RESTORATION
State of Wisconsin	
County of Forest	ss.
I found evidence of the South Township 40 North	, do hereby certify that on the 23rd day of October , 19.69 , h Center one sixteenth corner of Section 3 , Range 12 East , Fourth Principal Meridian, as described lence I established a new and an experimental meridian as described hereon to perthis corner:
ection subdivision survey orner and the center quar	nt and accessories and subsequent restorations:  by Ripco established this corner on line between the south quart ter corner of section 3. Corner marked by a 1 inch outside diam- ch square brass plat welded on top stamped to identify corner.
,	
•	
Description of corner evidence f	
rom which the following be	pipe with brass plate welded on top stamped to identify corner. earing trees bear:
Maple 8, bears N88W,	33.80 ft.
Hemlock 14, stump, bea	ars N54E, 41.00 It.
•	
Description of monument and ac	encouries I established to normativate the original location of this government
lazed and scribed the foll	ccessories I established to perpetuate the original location of this corner: lowing new bearing tree: sam 11, bears N18E, 11.13 ft.
lazed and scribed the foll	lowing new bearing tree:
lazed and scribed the foll	lowing new bearing tree: sam 11, bears N18E, 11.13 ft.  JEAN F. RESVICK RHINELANDER, WIS.
lazed and scribed the foll	lowing new bearing tree: sam 11, bears N18E, 11.13 ft.  JEAN F.  RESVICK
lazed and scribed the foll	lowing new bearing tree: sam 11, bears N18E, 11.13 ft.  JEAN F. RESVICK RHINGLANDER, WIS.
lazed and scribed the foll	Resident witnesses  Dated at Rhinelander Wisconsin, this 23 day of January
lazed and scribed the foll	Resident witnesses.
lazed and scribed the following	Resident witnesses  Dated at Rhinelander Wisconsin, this 23 day of January  19.70  Signature Jean F. Resvick Title Cadastral Surveyor  (County Surveyor, Registered Land Surveyor, or other duly authorized official)
lazed and scribed the following	Resident witnesses  Dated at Rhivelander Wisconsin, this 23 day of January  19.79  Signature Jean F. Resvick Title Cadastral Surveyor  (County Surveyor, Registered Land Surveyor, or other duly authorized official)  Surveyors Registration No. S-802  DOCUMENT NUMBER 9806
lazed and scribed the following	Resident witnesses.  Dated at Rhinelander Wisconsin, this 23 day of January 19.70  Signature Jean F. Resvick Title Cadastral Surveyor (County Surveyor, Registered Land Surveyor, or other duly authorized official)  Surveyors Registration No. S-802  Office of Register of Deeds County of Forest I hereby certify that the within instrument was filed in this office for record
lazed and scribed the following	Resident witnesses.  Dated at Rhinelander Wisconsin, this 23 day of January 19.79  Signature Jean F. Resvick Title Cadastral Surveyor (County Surveyor, Registered Land Surveyor, or other duly authorized official)  Surveyors Register of Deeds County of Forest I hereby certify that the within instrument was filed in this office for record on the 22nd day of May 19.70, and was filed in Book
Section 3	Resident witnesses.  Dated at Rinnelander.  Signature Jean F. Resvick  (County Surveyor, Registered Land Surveyor, or other duly authorized official)  Surveyors Register of Deeds  County of Forest  I hereby certify that the within instrument was filed in this office for record on the 22nd day of May.  19.70, and was filed in Book

J

44012,060000

FORM NO. 985-A


a Forest	n )
County of Forest	} ss.
I Robert H. Winat certify that on the formulary evidence of the section corner of 5-6-7-8. Township 40. 12 East Fourth I as described hereon; and that I established a new monumer as described hereon to perpolocation of this corner.	., 1985, I found, North, Range Principal Meridian, from this evidence ent and accessories
Resident witnesses:	
like Stevens	
like Lukasko	
1 [	1 /
1	i
	1 1 1 1 
5	

Origin	of original corner e al corner set : 1 by Guy R. Ve	in 1859 bv	Wm. E. Dau	gherty. Dependent pipe with a G.L.O.	resurvey brass cap.		
BT's:	Maple Ironwood Maple Maple	16" 4" 7" 7"	N83½°E S42½°E S81°W N82°W	63 lks. 13 lks. 66 lks. 80½ lks.			
•	tion of corner evide G.L.O. monumen		cap.				
round	Maple Ironwood Maple Maple	20" 7" 16" 16"	N84°E S43°E S81°E N81°W	40.75' 8.88' 43.86' 52.98'			Š
All ha	we visible bla	zes.Set nai	l in all BT's.				7
•			es I established	to perpetuate the origina	al location of the	s corner.	
							7
(ove	r)						
Dated a	t Rhinelander		, Wis., this	14day of	June	1985 , 19	9,
Signatu	e G/417/	Windle	Title	R.L.S.	Regis	tration No. 10	×40
instrum	Register of Deeds,	County of office for rec	For	<b>24th</b> day of	I hereby o	ertify that the	within
	(R	Register of Deed					
Rv				Denuty			

(e) Describe any material discrepancy between the location of the corner as restored or reestablished and the location of that corner as previously restored or reestablished by distance and direction. Show the discrepancy on the plan view drawing under (d), above. Show the distances between the corner as previously restored or reestablished and (1) the corner as restored or reestablished, and (2) to at least 2 of the vitness monuments shown on the drawing in (d), above.

- (f) Was the corner restored through acceptance of (1) an obliterated evidence location, or, (2) a found perpetuated location?
  Found perpetuated location.
- (gkh) Was the corner reestablished through lost corner proportionate methods? If so, show the method, including the directions and distances to other public land survey corners used as evidence or used for proportioning in determining the corner location?

  No.

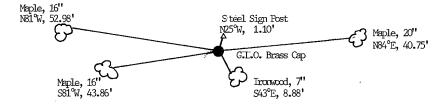

(i) Robert H. Winat

[type or print name] certify that the corner location shown
on this record was determined by me or under my direction and
control and that this U.S. Public Land Survey Monument Record is
correct and complete to the best of my knowledge and belief.

Signature 1 Stat H. Winab 14 for 19

ROBERT H.

WINAT
S-1040
RHINELANDER,
WIS.

SURVE

128468	
NUMBER	
DOCUMENT	

State of Wisconsin }ss.		LAND SURVE of original corner es			RECORD	Index No	<u></u>
County of Forest	Depend		n <b>1</b> 941 '	by Guy R. Ve	eal, set a 6"x24" concrete	ž	
I Robert H. Winat , do hereby			-11		ccl		
of January 19	BT's:	Poplar	5'' 5''	N32½°E S20½°E	66½ 1ks. 46 1ks.		
evidence of the quarter		Poplar	5	520% E	40 IKS.		
corner of 5-8							
Township 40 , North, Range							
12 East Fourth Principal Meridian,							
as described hereon; and that from this evidence	Descript	ion of corner evider	ice found	:			
I established a new monument and accessories		G.L.O. monumen	t and b	rass cap.			-0
as described hereon to perpetuate the original location of this corner.	Found	BT's:					$\mathcal{O}$
location of this corner.		D 7	10!!	MAG OF	// 20 F		02.8g
Resident witnesses:		Poplar Sugar Maple	10''	N33°E S45°E	44.20 feet 46.68 feet (origin unk	201.22	<i>Q</i> ,
		Sugar Maple	6"	S44½°W	28.24 feet (origin unk		
Mike Stevens		Wood sign pos	-	S2°E	1.20 feet	101117	, S
Må lag Tarlagalag		0.					
Mike Lukasko		Set nail in all	BT's.				ī
	Descript	ion of monument a	nd access	ories I establish	ned to perpetuate the original loc	ation of this corner.	; 4812
	-	l and scribed n					4
	biazec	i and scribed in	ew DI.				77
		Spruce	11"	N64°W	87.35 feet to mail in th	æ	- 4
		•					-
1 1 1	-						
<del>-</del>							



O = Corner monument restored.

> Rhinelander ..., Wis., this 14 day of June Title R.L.S. Registration No. 1940. (828889938899696, Registration No. 1940. Office of Register of Deeds, County of Forest , I hereby certify that the within instrument was filed in this office for record on the 24th day of July , 19 85


at 1:10 o'clock P. M. Pul Aschenbrenner

(Register of Deeds)

(over)

(e) Describe any material discrepancy between the location of the corner as restored or reestablished and the location of that corner as previously restored or reestablished by distance and direction. Show the discrepancy on the plan view drawing under (d), above. Show the distances between the corner as previously restored or reestablished and (1) the corner as restored or reestablished, and (2) to at least 2 of the vitness monuments shown on the drawing in (d), above.
N/A.


- (f) was the corner restored through acceptance of (1) an obliterated evidence location, or, (2) a found perpetuated location?
  Found perpetuated location.
- (gkh) Was the corner reestablished through lost corner proportionate methods? If so, show the method, including the directions and distances to other public land survey corners used as evidence or used for proportioning in determining the corner location?

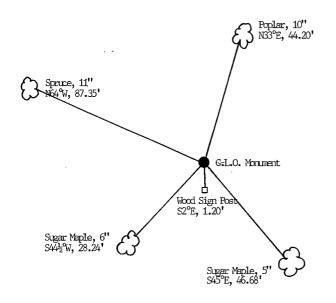

(i) i. Robert H. Winat

(type or print name) certify that the corner location shown on this record was determined by me or under my direction and control and that this U.S. Public Land Survey Monument Record is correct and complete to the best of my knowledge and belief.

Robert 7. Winds 14 fine 1985

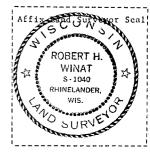

	R9-5680-5 (7/15/64) H. C. WILLER CO., HILWAYEEE 448643
<del></del>	CERTIFIED LAND CORNER RESTORATION
State of Wisconsin County of Forest	ss.
I found evidence of the Township	vick , do hereby certify that on the 7th day of August , 19 6h.,  North quarter corner of Section 8.  , Range 12 E , Fourth Principal Meridian, as described his evidence I established across a described hereon to person of this corner:
Description of original m	onument and accessories and subsequent restorations:
D S	urveyed in 1859 by Wm. E. Daugherty. ependent resurvey in 1941 by G. R. Veal. Proportionate distance. et a concrete monument 24 ins. long, 6 ins. dia., with brass cap arked:
1941 f	rom which the following trees bear:  Poplar, 5", N32° 30'E, 66½ 1ks., 43.89 ft.  Poplar, 5", S20° 30'E, 46 1ks., 30.36 ft.
Pescription of monument	oplar, 10 ins., N32° 30'E, 14.0 ft. oplar, dead and fallen (scribed) S22° 30'E, 30.10 ft.  xxxxx accessories I established to perpetuate the xxxxx location of this corner: lazed and scribed the following new bearing trees:
	Maple, 3 in., Sh6° 30'E, h6.7 ft. or 70.757 lks. Maple, 3 in., S33° 30'E, 28.1 ft. or h2.575 lks. Set h"x4"x7' cedar post along side of monument
(1	AADIZOSOOZO JEAN F. RESVICK RHINELANDER, WIS.
Sec. 8	Dated at Rhinelander Wisconsin, this
	Office of Register of Deeds County of Forest  I hereby certify that the within instrument was filed in this office for record on the 11th day of May 19 68, and was filed in Book
	No. I Page No. E-7 of County Records. at 10:00 AM  Signature Lugene State ny Title Register of Deeds
Township 40 N	, Range 12 E , Section 8 , Index No. E-7 , Page No.

FORM NO. 985-A . P. P. R. KELMIN COMPANY

Stock No. 26273


,		U.S.	PUBLIC	LAND	SURVEY	MONUMENT	RECORD
tate of Wisconsin	1		***				

		~		$\sim$
In day	AI-	_	-	ч
Index	INO.	<b>—</b>		

0							
State of Wisconsin } ss.	History	of original corner e	stablishn	ient:			
County of Forest	Depend		n 1941	by Guy R. Ve	al, set a 6"x2	4" concrete	
I Robert H. Winat , do hereby	morrane		Or Dias	o sap.			
certify that on the 25th day	BT's:	Maple	8"	N32½°E	133 lks.		
of January, 1985, I found		Maple	7"	S40°E	50 lks.		
evidence of the <u>Section</u>		Hemlock	12"	S14½°W	59 1ks.	•	
corner of 4-5-8-9		Maple	6"	N41°W	73½ 1ks.		
Township 40 , North, Range							
12 East Fourth Principal Meridian, as described hereon; and that from this evidence	Doggeine	ion of corner evide	noo foun	4.	_		
I established a new monument and accessories		G.L.O. monumen					
as described hereon to perpetuate the original	round (	3.L.O. MONUMEN	it alid t	mass cap.			×
location of this corner.	BT's:	Sugar Maple	12"	N28½°E	81.62 feet		$\mathcal{P}_{\mathcal{L}}$
	DI 0.	Sugar Maple	12"	S45°E	33.10 feet		ď,
Resident witnesses:		Hemlock Stump		S10°W	36.44 feet	(scribing visible)	<i>'Q'</i>
		Sugar Maple "	14"	N46°W	48.79 feet	,	ĺΩ.
Mike Stevens		Wood sign pos	t	South	4.70 feet		$\mathcal{O}$
Mike Lukasko		Set nail in all	BT's.				44012/50000
		_					$\wedge$
	•			sories I establish	ied to perpetuate t	he original location of this corner.	$\frac{4}{2}$
	Blazed	and scribed n	ew BT:				4
		White Birch	14"	S60°₩	76.57 feet	to mail in tree	1
		(over)					
		Rhinelander			1/	. Imo 1005	
<del> </del> <del> </del> +	Dated at	. Nilleleikel	/	, Wis., this	d	ay of June 1985	, 19
	Signature	alet H	Him	Title	R.L.S.	Registration l	Vo 1040
	-	((C0000000050		gistered Land Surve	- ) O · I WYWYNYNYN MANN I · O · O · O	korizedenficiolix	10
	Office of	Register of Deeds	. County	of For	est	I hereby certify th	at the within
<del> </del> <del> </del>	instrume	nt was filed in this	office fo	r record on the	24th	I hereby certify th July	, 1985
	at 1:10	o'clock P.	М,				
		Taul	do	heatrenner	c.		
	************		Register of		<u> </u>		
		\-		<b>-</b>			
O = Corner monument restored.	Ву				Deputy		

(e) Describe any material discrepancy between the location of the corner as restored or reestablished and the location of that corner as previously restored or reestablished by distance and direction. Show the discrepancy on the plan view drawing under (d), above. Show the distances between the corner as previously restored or reestablished and (1) the corner as restored or reestablished, and (2) to at least 2 of the vitness monuments shown on the drawing in (d), above.
N/A.

- (f) was the corner restored through acceptance of (1) an obliterated evidence location, or, (2) a found perpetuated location?
  Found perpetuated location.
- (gkh) Was the corner reestablished through lost corner proportionate methods? If so, show the method, including the directions and distances to other public land survey corners used as evidence or used for proportioning in determining the corner location?

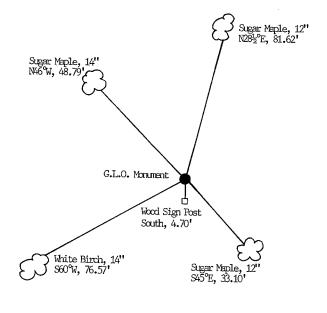

(i) Robert H. Winat

[type or print name; certify that the corner location shown on this record was determined by me or under my direction and control and that this U.S. Public Land Survey Monument Record is correct and complete to the best of my knowledge and belief.

Signature Jelet H. Winds -14 free 1985



X
1
ĺΛ
$\mathcal{O}$
10.
4
JA.
Ø
10
10
~
0
12
1

i			
ı			
,			
;			

and the same of th		
State of Wisconsin ss.	History of original corner establishment: Wm. E. Daugherty est. in 1859.	
County of Forest	G.L.O. set a brass capped iron pipe in 1941 with the following Bt's:	
I Robert H, Winat , do hereby	Maple 7" S70°E 52Lks. Yellow Birch 12" N21°30'E 59 Lks.	
certify that on the 10 day	Jean F. Resvick made an additional Bt in 1968:	
of February 19.85 , I found evidence of the Quarter	Maple 4" N23°E 28.35'.	
corner of Sections 4 & 9		
Township 40 , North, Range		
12 EaST Fourth Principal Meridian, as described hereon; and that from this evidence	Description of corner evidence found: Found the G.L.O.brass capped I.P. and the following	
I established a new monument and accessories	Yellow Birch Swag N20°E 39.41'	V
as described hereon to perpetuate the original	Maple 8" N21°E 28.42'	9
location of this corner.	Maple 14" S70°E 34.50'	4
Resident witnesses:	Wood sign post South 0.80'	7
Mike_Stevens		ý
Mike Lukasko		l
	Description of monument and accessories I established to perpetuate the original location of this corner.	7
	Made new BT's:	7
	Maple 9" N76°E 10.17' Maple 10" S22°E 18.30'	4
	Maple 10" S22°E _ 18.30'	
[		
	•	
<u> </u>	(over) Dated at Rhindands , Wis., this 4 day of June , 19.8	? <b>5</b>
	Signature County Surveyor, Registered Land Surveyor, or other duty authorized official)  Registration No. 1954	٥
i i i	Office of Register of Deeds, County of Forest I hereby certify that the wi	ithin
	Office of Register of Deeds, County of Forest I hereby certify that the wishstrument was filed in this office for record on the 24th day of July 198 at 1:10 o'clock P. M.	15
	Quel Aschenbrenner	
	(Register of Deeds)	
= Corner monument restored.	ByDeputy	


Describe any material discrepancy between the location of the corner as restored or reestablished and the location of that corner as previously restored or reestablished by distance and direction. Show the discrepancy on the plan view drawing under (d), above. Show the distances between the corner as previously restored or reestablished and (1) the corner as restored or reestablished, and (2) to at least 2 of the witness monuments shown on the drawing in (d), above.

See drawing below.

Was the corner restored through acceptance of (1) an obliterated evidence location, or, (2) a found perpetuated location?

Found perpetuated location.

(gkh) Was the corner reestablished through lost corner proportionate methods? If so, show the method, including the directions and distances to other public land survey corners used as evidence or used for proportioning in determining the corner location?

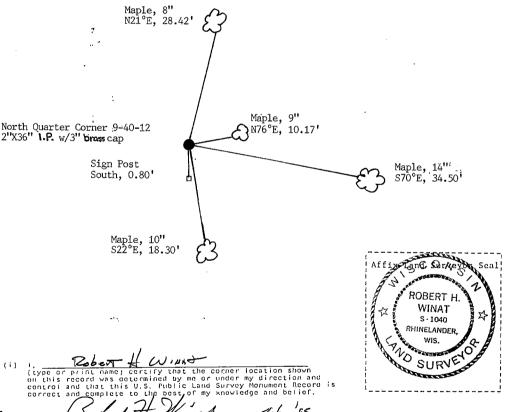

Description of original monument and accessories and subsequent restorations:

Surveyed in 1859 by Wm. E. Daugherty. Dependent resurvey in 1941 by G. R. Veal. Proportionate distance. Set a concrete monument 21 long, 6 ins. dia., 18 ins. in the ground, with brass cap marked: Set a concrete monument 24 ins.

from which the following trees bear: A maple, 7", S70°E, 52 lks.
A birch, 12", N21° 30'E, 59 lks.

Description of corner evidence found:

petuate the zeighnak location of this corner:

Monument as described above and in place. A maple, 12", S70°E, 34.50 ft. A birch snag, 14", N21° 30'E, 39.00 ft.

Description of movement accessories I established to perpetuate the location of this corner:

Blazed and scribed the following new bearing tree: A maple, 4", N230E, 28.35 ft. or 42.954 1ks. Set 4" x 4" x 7' long cedar post next to the monument.

44012BABBZG



Sec.	9	••••
	:	

Signature

Dated at. 19 68

Resident witnesses.

Cadastral Surveyor ...Title...

(County Surveyor, Registered Land Surveyor, or other duly authorized official) DOCUMENT # 94557 S-802 Surveyors Registration No.....

Office of Register of Deeds \_\_\_\_County of Forest I hereby certify that the within instrument was filed in this office for record on the luth day of May 19 68, and was filed in Book

\_\_\_\_of County Records. at 10:00 AM ategny Title Register of Deeds

E-11 , Page No. Township

### U.S. PUBLIC LAND SURVEY MONUMENT RECORD

* C T G C T	
	N W B


Stock No. 26273 FORM NO. 985-A

	Index No	
State of Wisconsin  County of Forest ss.	History of original corner establishment: Wm. E. Daugherty est. in 1859. G.L.O. set a brass capped iron pipe in 1941 with the following BT's:	
1 Robert H. Winat , do hereby certify that on the 10 day of February , 19.85., I found cyldence of the Section	Birch 6" N68°30'E 9.50 Lks.  Poplar 10" S64°E 33.00Lks.  White Birch 5" S41°W 53.50 Lks.  White Birch 7" N35°W 53.50 Lks.	
corner of 3,4,9,10.  Township 40.  North, Range 11:EAST., Fourth Principal Meridian, as described hereon; and that from this evidence I established a new monument and accessories	Jean F. Resvick in 1969 found these BT's: White Birch 9" N70°30'E 6.30' White Birch 9" N37°W 35.50' White Birch 9" S43°W 35.10' Description of corner evidence found: Resvick set BT: W. Birch 8" S21°E 15.86'	
as described hereon to perpetuate the original location of this corner.  Resident witnesses:	White Birch 10" S20°E 16.00" in poor condition White Birch 10" S37°30'W 34.83' in good condition White Birch 11" N64°E 6.31' tree has some punky areas, some limbs are dieing White Birch 10" N35°30'W 35.35' scribing visible.	;. ×
Mike Stevens	_	Ø.
Mike Lukasko		2,
, , , , , , , , , , , , , , , , , , , ,	Description of monument and accessories I established to perpetuate the original location of this corner. Made new BT's:	4401264,0000
	Sugar Maple       8" N60°W       28.29'         Sugar Maple       6" S47°30'E       37.75'         Sign Post       S30°W       1.00'	440
	(over) at 2hid ale , Wis, this 4 iday of	10 85
	Signature County Surveyor, Registered Land Surveyor, on other duly authorized official)	1040
	Office of Register of Deeds, County of Forest I hereby certify that instrument was filed in this office for record on the 24th day of July at 1:10 o'clock P. M.  Ascharlhenner (Register of Deeds)	the within, 19. <b>85</b>
= Corner monument restored.	ByDeputy	

(e) Describe any material discrepancy between the location of the corner as restored or reestablished and the location of that corner as previously restored or reestablished by distance and direction. Show the discrepancy on the plan view drawing under (d), agove. Show the distances between the corner as previously restored or reestablished and (1) the genner as restored or reestablished, and (2) to at least 2 of the witness menuments shown on the drawing in (d), above. See drawing below.

Was the corner restored through acceptance of (1) an obliterated evidence location, or, (2) a found perpetuated location? Found perpetuated location.

(gkh) Was the corner reestablished through lost corner proportionate methods? If so, show the method, including the directions and distances to other public land survey corners used as evidence or used for proportioning in determining the corner location?

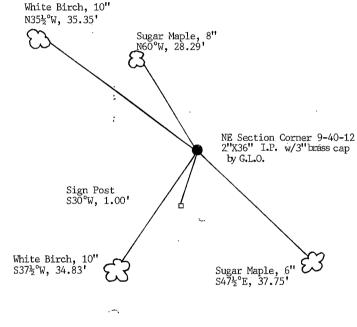

i. Robert H. W. wat (type or print name) certify that the corner location shown on this record was determined by me or under my direction and control and that this U.S. Public Land Survey Monument Record is correct and complete to the best of my knowledge and belief. obert H Winds

June Date

Seal ROBERT H: WINAT S · 1040 RHINELANDER WIS. SURV

#### CERTIFIED LAND CORNER RESTORATION

State of Wisconsin	
County of Forest	SS.
I found evidence of the Sour Township 40 North	, do hereby certify that on the
Thon R12E At proj 6 ins. 9 and therein A birch A popl 1941 A White	t and accessories and subsequent restorations: Surveyed in 1859 by Daugherty. Dependent resurvey in 1941 by Guy. R. Veal. cortionate distance set a concrete monument, 2 ft. long, diam., 18 ins. in the ground, for corner of secs. 3, 4, 10, with an iron post, 22 ins. long, 1 in. diam., encased in, with brass cap mkd.: From which: h, 6 ins., bears N.68°30'E., 9.50 LKs. ar, 10 ins., bears S.64°E., 33 LKs. as birch, 5 ins., bears S.64°E., 35°W, 53.50 LKs. as birch, 7 ins., bears N.35°W, 53.50 LKs.
Description of corner evidence fo	
Monument as described above A white birch, 9 ins., N 7 A white birch, 9 ins., S 4 A white birch, 9 ins., N 3	0°30'È., 6.3 feet. 3°W., 35.1 feet.
Blazed and scribed the fol	cessories I established to perpetuate the <u>swigined</u> location of this corner: lowing new bearing trees: rs S 21°E, 15.86 feet or 24.03 LKs.
	JEAN F. RESVICK RHINELANDER, WIS.
	440120400000 Replaced SURVE SU
. Sec. 3	Resident witnesses.  Dated at Rhinelander
S = Corner monument restored	Office of REgister of Deeds County of Forest, I hereby certify that the within instrument was filed in this office for record on the 26th day of August 19 69, and was filed in Book No. I Page No. of County Records. 8:30 AM.  Signature State State of Deeds
m 1 lo North Dans	e 12 East , Section 3 , Index No. E-13 , Page No.

4401203000

			0.5.					
State	of Wisc	onsin	} ss.					
County of Forest								
I Robert H. Winat, do hereby certify that on the 8th day of November								
Resident wi	tnesses:							
, Michael	57 C C4-0							
PILCHAE	ar n. o. ote	vens						
		••••						
	1	    - 	 					
	[    -	 						
  -	SEC	10	ļ 					
·	! 	<b>!</b> ]	1					
	 	] [	1					
<u> </u>	: 	; 	<u>-</u>					
		1	!					
]	! !	 	i l					
	-							
- Corner	monument	d						

History of original corner establishment:

1859 survey by Wm. Daugherty

1941 Dependent resurvey by Guy Veal of G.L.O. set 2"iron pipe mont. at proportional location BT's 8"Hemlock N21°E, 26 lks - 7"Hemlock S460W, 272 lks.

1966 recovery by Jean Resvick of 1941 mont. & Bt's.

Description of corner evidence found:

\* 13. \*K

1941 G.L.O. mont. & Bt's.

Description of monument and accessories I established to perpetuate the original location of this corner.

1941

new

BT's: 10"Hemlock S460W, 18.08' 19"Hemlock N21°E, 17.21' 24"Maple S 810 E, 23.91 24"Maple N 8320W, 39.49"

to mail in side of tree

Steel sign post bears S 800W, 1.0'

(orer)					
Dated at Phinelands	, Wis., this	4	day of	June	19.85
Signature Chet H. Wish (County Surveyor, Registered	Title	المساع	wy	Regi	stration No. 1040
Office of Register of Deeds, County of	Forest			I hereby	certify that the within
nstrument was filed in this office for reco	rd on the	24th	day of	July	19 <b>8.5</b>
Paul Aschen	brenae	v			
(Register of Deeds)			·		

(e) Describe any material discrepancy between the location of the corner as restored or reestablished and the location of that corner as previously restored or reestablished by distance and direction. Show the discrepancy on the plan view drawing under (d), above. Show the distances between the corner as previously restored or reestablished and (1) the corner as restored or reestablished, and (2) to at least 2 of the witness monuments shown on the drawing in (d), above.


N/A

(f) Was the corner restored through acceptance of (1) an obliterated evidence location, or, (2) a found perpetuated location?

2

(gkh) Was the corner reestablished through lost corner proportionate methods? If so, show the method, including the directions and distances to other public land survey corners used as evidence or used for proportioning in determining the corner location?

1941 resurvey set this by proportional location.

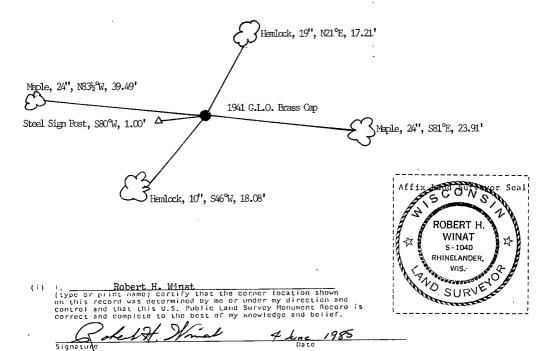

State of Wisconsin SS. County of FOREST Robert H.Winat ...., do hereby certify that on the seventh day of November 19.84 I found cyclence of the NE section corner of Section 10 Township.........., North, Range 12 East Fourth Principal Meridian, as described hereon; and that from this evidence as described hereon to perpetuate the original

Corner monument restored.

History of original corner establishment:

1941 Dependent resurvey by Guy R. Veal of G.L.O. 20"Hemlock S45°W 71k (stump & log)orig 7"Hemlock N3440E 96 lks - 11"Y.Birch S5340E 83 lks - 8"Y.Birch S 10W 121 lks and 8"Y.Birch N 510W 79 lks new

Set mon't.

Description of corner evidence found:

G.L.O. mont. & Hemlock rampike N20°E 62.56' (1941) Nemlock Stump S 45°W 4.60' (orig.)

Description of professional location of this corner.

10"Spruce S:60°E, 56.52" 12"Balsam S20°W, 28.80 N7520W.37.30

11"Spruce N10°W, 55.18'

metal sign post bears N 83°E, 1.29° from G.L.O. mont.

(OVAR)

Dated at Rhinelander

Wis., this 4 day of June 1985

to mail in side of tree

(County Surveyor, Registered Land Surveyor, or other day authorized official)

., I hereby certify that the within July at 1:10 o'clock P. M.

> Aschenbrewser (Register of Deeds)

Describe any material discrepancy between the location of the corner as restored or reestablished and the location of that corner as previously restored or reestablished by distance and direction. Show the discrepancy on the plan view drawing under (d), above. Show the distances between the corner as previously restored or reestablished and (1) the corner as restored or reestablished, and (2) to at least 2 of the witness monuments shown on the drawing in (d), above.


N/A

Was the corner restored through acceptance of (1) an obliterated evidence location, or, (2) a found perpetuated location?

: 2

(gkh) Was the corner reestablished through lost corner proportionate methods? If so, show the method, including the directions and distances to other public land survey corners used as evidence or used for proportioning in determining the corner location?

no

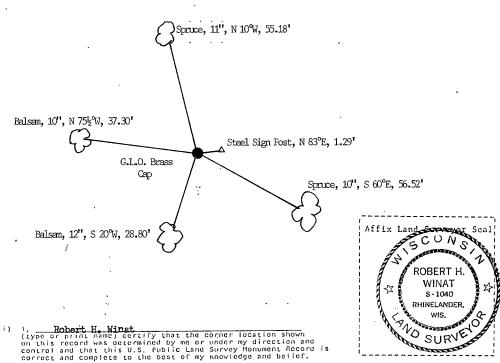

June 1985

# CERTIFIED LAND CORNER RESTORATION

CE	RTIFIED LAND CORNER RESTORATION
State of Wisconsin	
County of Forest	i.
I found evidence of the Sout Township 40 North	, do hereby certify that on the 25th day of May , 19.82 , heast Section
Description of original monument	and accessories and subsequent restorations:
Original subdivision in 185 Dependent resurvey in 1941	9 by Wm. E. Daugherty by Guy R. Veal L bearing tree, set 6" diameter concrete monument with brass 53, SlO, Sll, 1941 ar: 3 lks. lks.
Found monument as described Original Hemlock stump, S45 Hemlock snag, 7", N34E, 96 Yellow Birch stump, N53E, 8 Yellow Birch stump, S1W, 12 Yellow Birch stump, N5W, 79	W, 7 lks. lks. 3 lks. 1 lks.
Description of monument and acc	essories I established to perpetuate the location of this corner:
Blazed and scribed the foll Spruce, 10", S45½E, 56.50 f Balsam, 11", S33W, 28.81 ft Balsam, 10", N65W, 37.22 ft Spruce, 11", N3W, 55.16 ft. Steel sign post, East, 1.0	ft. WILLIAM B. COCHRANE S-1107
	DOCUMENT NO. HILES, WISCONSIN OF
1.5%	124412 FILL SURVERSE
	Resident witnesses
Section 3	Dated at Hiles Wisconsin, this Widay of July 19.82 William B. Cochrane Signature William B. Cochrane Title Land Surveyor (County Surveyor, Registered Land Surveyor, or other duly authorized official)
	Surveyors Registration No. S-1107
	Office of Register of Deeds County of Forest I hereby certify that the within instrument was filed in this office for record
- Corner monument restored	on the 7th day of October 1983, and was filed in Book
· -	Signature Title Register of Deeds
Township 40 North, Rang	
	4401ZØ3ØØØØ

ŧ	f
	ď
Č	d
3	š
Ì	1
6	7
۹	ď
	ρ
	~
	Σ
	ZIME
	2
	F
	Ż
	ť
	Ξ
	⊆
	c

U.S.	PUBLIC LAND SURVEY MONUMENT RECORD Index No.E-19
State of Wisconsin	History of original corner establishment:
County of Forest .	1941 Dependent resurvey by Guy R. Veal and found no evidence of the original post or
I Gary L. Pisoni , do hereby certify that on the 26th day of November , 19 86, I found cyidence of the North quarter corner of Section 11	original bearing trees. Corner restored by proportionate methods. Guy R. Veal set a 2" diameter by 36" long iron pipe with a brass cap stamped: U.S. General Land Office Survey, 1/4, S2, S11, 1941 from which the following bear:  Yellow Birch 30" S.29 W. 73 links  White Pine 4" N.50 W. 102 links
Township	Description of corner evidence found:  Monument as described and in place, from which the following bear:
location of this corner.	All bearing trees dead.
Resident witnesses:	14
Marile Callan	N <sup>N</sup>
Mark Selmo	
Bill Erickson	
	Description of monument and accessories I established to perpetuate the original location of this corner.  Blazed and scribed the following new bearing trees:  Sugar Maple 7" S.68 E. 9.66 feet  Balsam 3" S.66 W. 18.68 feet  Sugar Maple 8" N.26 W. 12.26 feet  Set a steel sign post: South, 0.9 feet
SECTION II	Dated at Iron River, MI Wis, this 2nd day of November 19 87  Signature Fund Surveyor Title Land Surveyor Registration No. S-1634 (Wounty Surveyor, Registered Land Surveyor, or other duly authorized official)  Office of Register of Deeds, County of Forest instrument was filed in this office for record on the 5th day of at 12:450 clock P. M.  Toul fishers (Register of Deeds)
O = Corner monument restored.	ByDeputy

 $\mu$ 


Describe any material discrepancy between the location of the corner as restored or reestablished and the location of that corner as previously restored or reestablished by distance and direction. Show the discrepancy on the plan view drawing under (d), above. Show the distances between the corner as previously restored or reestablished and (1) the corner as restored or recstablished, and some corner as of the witness monuments shown on the drawing in (d), above. (e)

See drawing below.

was the corner restored through acceptance of (1) an obliterated evidence location, or, (2) a found perpetuated location?

Restored through acceptance of a found perpetuated location.

(gkh) Was the corner reestablished through lost corner proportionate methods? If so, show the method, including the directions and distances to other public land survey corners used as evidence or used for proportioning in determining the corner location?

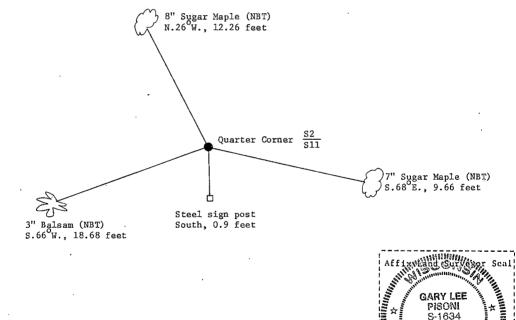

Gary L. Pisoni

(i)

(type or print name) certify that the corner location shown on this record was determined by me or under my direction and control and that this U.S. Public Land Survey Monument Record is correct and complete to the best of my knowledge and belief.

J. Loom 11-2-87 Signature

Survey requested 1√2/1·

IRON RIVER, MI

CERT	IFIED LAND CORNER RESTORATION
State of Wisconsin  County of Forest ss.	
I found evidence of the Southwest Township 40 North	o hereby certify that on the 10th day of April , 19.68, Section corner of Section 1.  Range 12 East Fourth Principal Meridian, as described I established in new MAGNAGEMENT accessories as described hereon to performer:
Description of the light of monument and	d accessories and subsequent restorations:
Veal. Set a concrete monumen long, 1 ins. diameter, encase S12, 1941	lliam E. Daugherty. Dependent resurvey in 1941 by Guy R. t, 2 ft. long, 6 ins. diameter, with an iron post, 22 ins. d therein, with brass cap marked: T40N, R12E, S2, S1, S11,
from which the following bear	Double maple, 6 ins., N 5° 30' E., 66 Lks. Yellow birch, 11 ins., S. 59° E., 40 Lks. Maple, 14 ins., S.11° 15' W., 14 Lks. Maple, 8 ins., N.71° 45' W., 80 Lks.
Description of corner evidence found  Thon R12E  S2 S1  S11 S12  1941	Monument found as described above.  Double maple, 10 ins., N. 5° E., 43.73 ft.  Yellow birch, 17 ins., S. 60° E., 26.0 ft.  Maple, 24 ins., S. 11° W., 9.5 ft.  Maple, 20 ins., N. 72° W., 53.0 ft.
Description of KNOWNEKK KKK accesse	ories I established to perpetuate the WANGHAN location of this corner:
Blazed and scribed the follow	ing new bearing tree:
Maple, 11 ins., S. 2° E., 41.	18 ft. or 62.39 Lks.
p.	18 ft. or 62.39 Lks.  A461262666  SURvive Wisconsin, this 19th day of December.
	ated at Rhinelander Wisconsin, this 19th day of December.
Sec. 1 Si	gnature Jean F. Resvick Title Cadastral Surveyor (County Surveyor, Registered Land Surveyor, or other duly authorized official)  arveyors Registration No. S-802 DOCUMENT Number 95391
0	ffice of Register of Deeds County of Forest.
- Corner monument restored	the <u>31st day of January</u> 19 <u>69</u> , and was filed in Book
N	o. I Page No. E-21 of County Records.  gnature Ligene States ny Title Register of Deeds
Township 40 North , Range	

# U.S. PUBLIC LAND SURVEY MONUMENT RECORD


Public Land Si	tended and designed to fulfill all requirements urvey Monument Record (3) (a) (b) (c) (d) (e) (f said requirements.	of Wisconsin Administrati ) (g) (h) (i). An additional sh	ve Code, Chapter A-E 5.02, U.S leet may be added if necessary to
(a) Corner location	n: Township 40 North		
	Range 12 East/West	· · · · · · · · · · · · · · · · · · ·	
Town/City/Village	Hiles	<del></del>	
County	Forest		
•			Section

(b) (f) (g) (h) Description of monument found at this corner and if it was accepted, state all evidence (material, testimonial, occupational, plats, records, other monuments) used as a basis for accepting. If not accepted or if nothing was found, state evidence used as basis for establishing location. If reestablished through lost corner proportionate methods, indicate all monuments, distances and directions used to establish.

Found 2" diameter brass capped iron pipe stamped identifying the corner. The monument was re-established from the 1941 General Land Office Dependent Resurvey.

BT's recovered from the 1941 Resurvey: 16" S. Maple S 32<sup>9</sup>3/4<sup>0</sup> E 52.14' 16" S. Maple N 64 3/4<sup>0</sup> E 50.49'

(c) (d) (e) Plan view of corner with ties to at least 4 witness monuments. If in disagreement with previously established corner, show the distances between the two corners and also indicate the ties to the disputed corner.

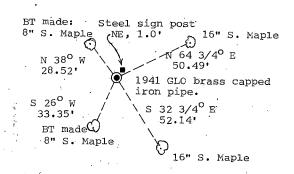

Scale 1" = 40 feet

44012010020 Note: measurements are to hail set in rootcrown of tree.

(i) I, Stephen J. Favorite RLS#S1616

(type or print name) certify that the corner location on this record was determined by me or under my direction and control and that this U.S. Public Land Survey Monument Record is correct and complete to the best of my knowledge and belief.

Stephen Savouto April 8, 1988

onature
prevey requested by;

District Ranger

Date




Index No. E - 20

Document No. 107239

# PLAT OF SURVEY U.S. GOVERNMENT LAND

Being NI/2 NEI/4 and SWI/4 NEI/4 in NEI/4 Section 9
Township 40 North, Range I2 East, Fourth Principal Meridian
FOREST COUNTY, WISCONSIN

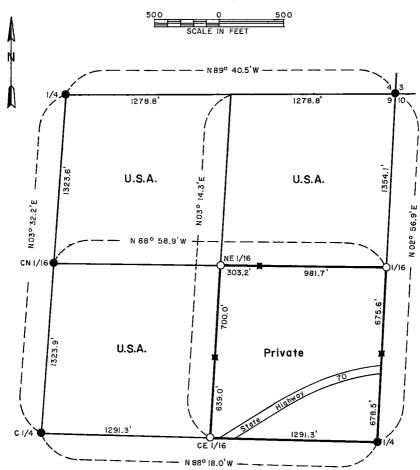

#### **LEGEND**

- Bureau of Land Management monument
- O Corner position marked by a 2 inch inside diameter by 3 foot long concrete filled galvanized iron pipe capped with a 3 inch diameter brass tablet stamped to identify corner.
- Boundary line marked to standards
- Boundary line post

U.S.A. U.S. Government land

49012092027

7

#### SURVEY NOTES

This survey was made by the U.S. Department of Agriculture, Forest Service, to subdivide the northeast quarter of section 9, township 40 north, range 12 east, fourth principal meridian, Forest County, Wisconsin.

The original Government survey of this township was made in 1859. Subsequent General Land Office (Bureau of Land Management) dependent resurveys and subdivision surveys monumented those corners shown by legend on the plat map.

The U.S. Government acquired title to the  $SW_2^1 NE_3^1$  in 1931 and the  $N_2^2 NE_2^1$  in 1942. Thus one purpose of this survey was to locate and mark the boundary of U.S. Government lands within said northeast quarter and on the perimeter of said northeast quarter.

The corner positions recovered and established by this survey are monumented by the monument described in the map legend.

The bearings between corner positions are true bearings. The relative accuracy of the traverse control for corner establishment was one part in 3,000.

The field survey notes and a copy of this plat of survey are on file in the Forest Supervisor's office at Rhinelander, Wisconsin.

#### Corners Recovered

#### 1. Section Corner to Sections 3-4-9-10.

Corner position restored by 1941 dependent resurvey. Corner recovered in 1969 and documented as corner certificate No. 96936 in Forest County records.

#### 2. Quarter Corner to Sections 4-9.

Corner position restored by 1941 dependent resurvey. Corner recovered in 1968 and documented as corner certificate No. 94557 in Forest County records. Corner references:

Maple 4" N. 23°E. 28.4 feet Sign post set at edge of monument.

#### 3. Quarter Corner to Sections 9-10.

Corner position restored by 1941 dependent resurvey and recovered in 1968 as described.

Corner reference:

Sign post Southwest 0.8 foot

#### 4. Center Quarter Corner.

Corner position established by 1955 Bureau of Land Management subdivision survey of section 9.

Corner reference:

Sign post set at edge of monument.

₹

# 5. Center North Sixteenth Corner.

Corner position established by 1955 Bureau of Land Management subdivision survey of section 9. Corner reference:

Sign post set at edge of monument.

#### Corners Established

#### 1. North Sixteenth Corner to Sections 9-10.

Corner position established at midpoint and on line between east quarter corner and northeast corner of section 9. Corner references:

Maple 7"	s. 37°W.	6.5	feet
Maple 9"	N. 36°W.	8.1	feet
Iron pipe	S. 13° 43'E.	99.2	feet
Sign post	Northeast	0.5	foot

#### 2. Center East Sixteenth Corner.

Corner position established at midpoint and on line between east quarter corner and center quarter corner. Corner references:

Maple 7" N. 89°E. 21.7 feet

Maple 6" N. 72°W. 12.5 feet Sign post Northwest 0.5 foot

# 3. Northeast Sixteenth Corner.

Corner position established at the intersection of the straight lines between opposing sixteenth corner positions on the perimeter of the northeast quarter of section 9. Corner references:

> White birch 11" N. 52°E. 1.8 feet Sign post Northwest 0.5 foot

#### SURVEYOR'S AFFIDAVIT

State of Wisconsin)<sub>ss</sub> County of Forest )

I Jean F. Resvick, land surveyor, U.S. Forest Service, and a registered land surveyor in the State of Wisconsin, hereby certify that I have surveyed and subdivided the northeast quarter of section 9, township 40 north, range 12 east, fourth principal meridian, Forest County, Wisconsin.

The plat map and survey notes herewith are a correct representation of the land surveyed, marked, and subdivided. I have surveyed and subdivided said northeast quarter section in accordance with the rules for the survey of the public lands and the statutes of the State of Wisconsin.

Date of Survey: . 1974

Land Surveyor, U.S. Forest Service

R.L.S. State of Wisconsin

SCONS ificate S-802

JEAN F.

RESVICK
RHINELANDER
WIS.

DOCUMENT NO. 107239

MIS.

RESVICK
FOREST COUNTY, WIS.

FOREST COUNTY, WIS.

RESVICK
FOREST COUNTY, WIS.

44612082000

<b>5.5.</b>	. ODEIO EMILO OC		0.102.11. 11.200	in	dex No.
State of Wisconsin County of Forest		ey in 1941		in 1859 by Wm. E. Daugherty. Teal set a brass capped concr	ete
IRobert H. Winat, do hereby certify that on the7thday of	Poplar Poplar	8"' 12"'	S47°15'E N44°15'W	41 1ks. 14 1ks.	
evidence of the quarter	Jean F. Resvick	found monu	ment in 1968 and t	the following:	
corner of 8. & 9.  Township 40 , North, Range 12. East , Fourth Principal Meridian, as described hereon; and that from this evidence I established a new monument and accessories	Poplar Stum Stump Hole DXXXXXXXXXXXXXXXXXXXXXXXXXXXXXXXXXXXX			9.30 ft. 27.00 ft.	
as described hereon to perpetuate the original location of this corner.	Maple Maple	4" 5"	S13°E N56°W	19.07 ft. 20.22 ft.	
Resident witnesses:	Cedar wood Description of c	orner evid	lence found:		
Mike Stevens	Found 2" G. Red Maple Sugar Maple Wood Sign F	L.O. brass	capped concrete m 513 E N54 W	nonument and BT's: 19.13 ft. old blazes v 20.22 ft. & ov 1.30 ft. in good shap	isible ergrown
Mike Lukasko	wood Sign F	ost	west	1.30 ft. in good snap	e
	Description of monun Established the			perpetuate the original location of this	corner.
	Sugar Maple Red Maple	5 <b>''</b> 7 <b>''</b>	S77°E S78°W	16.37 ft. 26.81 ft.	7
	(over) Dated at Rhind	.de-	, Wis., this	day of June	, 19. <b>25</b>
	Signature (Com	4 H. M <del>ny Surveyo</del> r, R	Title egistered Land Surveyor, or	Regist	
	Office of Register of I instrument was filed in at 1:10 o'clock	М.	y of Forest or record on the		ertify that the within 19.85
	Ja	(Register of	heabrennes Deeds)		•
Corner monument restored	By			Deputy	


(e) Describe any material discrepancy between the location of the corner as restored or reestablished and the location of that corner as previously restored or reestablished by distance and direction. Show the discrepancy on the plan view drawing under (d), above. Show the distances between the corner as previously restored or reestablished and (1) the corner as restored or reestablished, and (2) to at least 2 of the vitness monuments shown on the drawing in (d), above.

See drawing below.

Was the corner restored through acceptance of (1) an obliterated evidence location, or, (2) a found perpetuated location?

Found perpetuated location.

(g&h) Was the corner reestablished through lost corner proportionate methods? If so, show the method, including the directions and distances to other public land survey corners used as evidence or used for proportioning in determining the corner location?

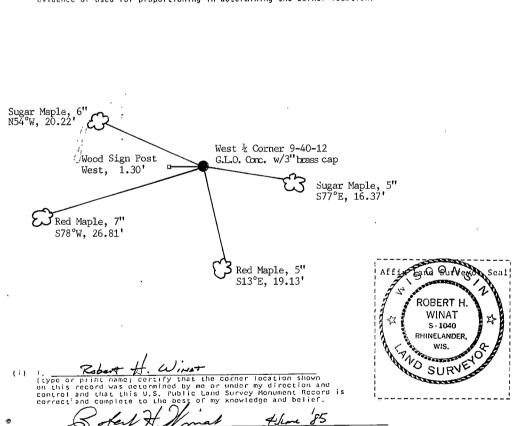

Date

		,		
		R9-5680-5 (7/15/64) H. C. MILLER CO	., WILWAUKEE 440043	
	CERT	TIFIED LAND CORNER	RESTORATION	
State of Wiscons				
County of Forest	t ss.			
I found evidence of Township40	the North om this evidence	West quarter, Range 12 East	corner of Sec	ofAugust, 19_67., tion 9 ncipal Meridian, as described as as described hereon to per-
Description of origin	nal monument an	nd accessories and subsequen	t restorations:	
1/4	G.R. Veal.	859 by Wm. E. Daughert Proportionate distance diameter, with brass c	e. Set a conc	esurvey in 1941 by rete monument 24 ins.
s8 s9	from which th	ne following trees bear	· <b>:</b>	_
1941		<b>.</b>	A poplar, 8",	Sh7° 15'E, hl lks. , Nhh° 15'W, lh lks.
Description of corne	er evidence found	I:		
	Monument as of A poplar stum A stump hole	described above and in mp, 15", Nh4° 15'W, 9.3, S47° 15'E, 27.00 ft.	place Oft.	ć
Description of MADE	инихіхний access	ories I established to perpet	nate the <b>xxiviral</b> lo	cation of this corner:
•		cribed the following ne		
	•	A mar	ole, 5". N56°W,	19.07 ft. or 28.894 lks 20.22 ft. or 30.636 lks dar post next to monume
		1Z <i>\$8Z##</i>		JEAN F. RESVICK RHINELANDER, WIS.
	1	esident witnesses Dated at Rhinelander		OPP SUR
		9 68		his // the day of April
Sec. 9	Si	ignature Jean F. Res (County Surveyor, Registered	vićk Titl	
	S	urveyors Registration No		росимент но. 94558
	0	Office of Register of Dec	ds County	of <b>Forest</b> filed in this office for record
② = Corner mont	Umant restared 01	n the 14th day of day	Мау1	968 and was filed in Book unty Records. at 10:00 AM
=		ignature Lugene S		
Township 40 N	N Range	12 E / Section	9 / , Index No	G-9 , Page No

FORM NO. 985-A

es es
NUMBER
DOCUMENT

	ilidex No. CaI	
State of Wisconsin ss.	History of original corner establishment:	
County of POREST Section 1	Wm. Daugherty 1859	
Robert H. Winat , do hereby	10/1 Postporter by C.T.O. and inch mine & main Differ Full 1, 1, 00007 1571, and 7	
certify that on the 9th day November 1984, I found	1941 Reservey by G.L.O. set iron pipe & made BT's- 5"Hemlock S30°E,451ks- 9"Maple, S51°W, 66 lks.	
evidence of the W # corner of Section 10	1968 Resvick recovers G.L.O. mont.& Bt's	
l'ownship40 , North, Range		
12 East Fourth Principal Meridian, as described hereon; and that from this evidence	Description of corner evidence found:	
established a new monument and accessories	Description of corner evidence round.	
s described hereon to perpetuate the original ocation of this corner.	44/4	
	1968 info OK	Š.
Resident witnesses:		e E
Michael G. Stevens		ري. ا
	•	7
	Description of monument and accessories I established to perpetuate the original location of this corner.	2
	9"Maple S20 <sup>0</sup> W, 18.60' 8"Maple N84 <sup>0</sup> W, 6.15' to nail in side 5"Maple N34 <sup>0</sup> W, 41.45' 14"Maple S51 <sup>0</sup> W,,43.44', snag wood signpost bears S510W, 0.8'	77
SEC   10	(ore) Dated at Phine and Wis, this day of June 198	·5
	Signature County Surveyor, Registered Land Surveyor, or other duly authorized official)  Registration No. /044	2
1 1 1	Office of Register of Deeds, County of Forest I hereby certify that the winstrument was filed in this office for record on the 24th day of July 198	ithin 15
	at 1:10 o'clock P. M.  Gegister of Deeds)	
= Corner monument restored.	Ву	


(e) Describe any material discrepancy between the location of the corner as restored or reestablished and the location of that corner as previously restored or reestablished by distance and direction. Show the discrepancy on the plan view drawing under (d), above. Show the distances between the corner as previously restored or reestablished and (1) the corner as restored or reestablished, and (2) to at least 2 of the vitness monuments shown on the drawing in (d), above.

N/A

(f) Was the corner restored through acceptance of (1) an obliterated evidence location, or, (2) a found perpetuated location?
2

(gkh) Was the corner reestablished through lost corner proportionate methods? If so, show the method, including the directions and distances to other public land survey corners used as evidence or used for proportioning in determining the corner location?

#### see 1941 resurvey

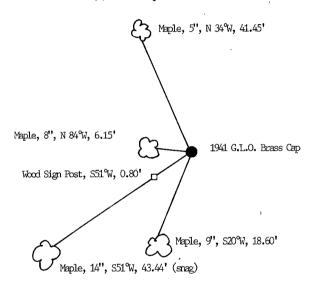

(i) I, Robert H. Winat
(type or print name) certify that the corner location shown
on this record was determined by me or under my direction and
control and that this U.S. Public Land Survey Monument Record is
correct and complete to the best of my knowledge and belief.

Signature Signature & June 1985

ROBERT H.
WINAT
S-1040
RHINELANDER,
WIS.
OSURVE

NUMBER

DOCUMENT

County of	FOREST		} 55.			
County of						
Resident wi	tnesses:					
Mich	ael G. St	evens				
Mich	ael T. Lu	kasko				
r	ı,					
	 	  - 	 			
<ul> <li>= Corner monument restored.</li> </ul>						

State of Wisconsin

History of original corner establishment: 1941 Dependent resurvey by Guy R. Veal of G. L. O. established proportioned corner. 7"Maple N  $6\frac{10}{4}$ E, 44 lks 8"Hemlock  $517\frac{10}{2}$ W, 68 lks BT's made. 2' iron pipe mont. set. 1965 Jean Resvick recovers:1966 15"Hemlock, N5920E, 110.95"- 17"Sugar, N6420E, 46.85"- Description of corner evidence found: BT's14"Hemlock, S520E, 118.85" -16"Sugar, S6220E, 90.90" Recover Resvick's BT's with nails found in the Hemlocks; remonument in 20'road fill by using temperature corrected distances from the nails found. Description of monument and accessories I established to perpetuate the original location of this corner. 20"Hemlock N5957 50"E, 110.89 18"Hemlock S52006'55"E, 118.79" to mail in side of tree 16"Sugar Maple S62030'W, 91.15' 22"Sugar Maple N64005"E, 47.11" metal sign post bears S 86°E, 2.5' (east shoulder Forest Rd.#2176-Divide Rd.) Monument is 2"x 36"aluminum pipe with 3"tablet stamped to identify corner buried in the shoulder of the road. (over) (County Surveyor, Registered Land Surveyor, or other duly authorized official) Office of Register of Deeds, County of Forest ..., I hereby certify that the within 24th instrument was filed in this office for record on the...... at 1:10 o'clock P. (Register of Deeds)

(e) Describe any material discrepancy between the location of the corner as restored or reestablished and the location of that corner as previously restored or reestablished by distance and direction. Show the discrepancy on the plan view drawing under (d), above. Show the distances between the corner as previously restored or reestablished and (1) the corner as restored or reestablished, and (2) to at least 2 of the vitness monuments shown on the drawing in (d), above.


N/A

(f) Was the corner restored through acceptance of (1) an obliterated evidence location, or, (2) a found perpetuated location?

1

(g&h) Was the corner reestablished through lost corner proportionate methods? If so, show the method, including the directions and distances to other public land survey corners used as evidence or used for proportioning in determining the corner location?

in 1941 resurvey

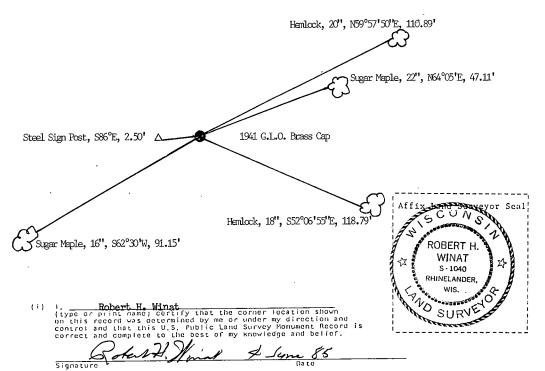

(1

CERTIFIED LAND CORNER RESTORATION State of Wisconsin Forest County of ..... ek \_\_\_\_\_, do hereby certify that on the \_\_\_\_\_19th
East quarter \_\_\_\_\_\_ corner
\_\_\_\_\_\_, Range \_\_\_12 East \_\_\_\_\_\_\_, I Jean F. Resvick corner of Section I found evidence of the... .., Fourth Principal Meridian, as described hereon; and attaccionnochiscoxidence destablished an asyconomy ment and assessories as despribed become to corre petratectize oxiginal document of this connect Description of original monument and accessories and subsequent restorations: Dependent resurvey in 1941 by Guy R. Veal. Set iron post, 3 ft. long, 2 ins. in diam. with brass cap marked: from which: 1/4 A Maple, 7 ins. diam. bears N6015'E, 44 lks. dist. A Hemlock, 8 ins. diam. bears S17°30'W, 68 lks. dist. S10 S11 1941 Description of corner evidence found: Monument found as described above from which: A Maple, 15 ins. diam, bears N60 15'E, 29.0 ft. A Hemlock, 16 ins. diam, bears S17030'W, 44.9 ft. Description of monomentational accessories I established to perpetuate the original location of this corner: Place bearing tree signs on bearing trees. RHINELANDER 44012102000 Resident witnesses. Dated at Rhinelander Wisconsin, this 28 Hd. day of May 1965... Sec. 10 Cadastral Surveyor (Couply Surveyor, Registered Land Surveyor, or other duly authorized official) Surveyors Registration No. S-802 .....County of..... Office of... I hereby certify that the within instrument was filed in this office for record .....19....., and was filed in Book on the day of = Corner monument restored ....Page No.....of County Records. ...Title... Signature.....

12 East Section 10 , Index No. G-17 , Page No.

40 North

, Range

Township.

DOCUMENT NUMBER

	PUBLIC LAND SURVEY MONUMENT RECORD Index No. G-21
State of Wisconsin  County of Forest  I Gary L. Pisoni , do hereby certify that on the 26th day of November , 19 86., I found evidence of the East guarter corner of Section 11  Township 40 , North, Range 12E , Fourth Principal Meridian,	History of original corner establishment: 1941 Dependent resurvey by Guy R. Veal and found no evidence of the original post or original bearing trees. Corner restored by proportionate methods. Guy R. Veal set a 2" diameter by 36" long iron pipe with a brass cap stamped: U.S. General Land Office Survey, 1/4, S11, S12, 1941 from which the following bear:  Maple 10" N.78°E. 52.14 feet Maple 7" S.68°W. 19.47 feet
as described hereon; and that from this evidence I established a new monument and accessories	Description of corner evidence found:
as described hereon to perpetuate the original	Monument as described and in place, from which the following bear:
location of this corner.	Sugar Maple 18" N.78°E. 52.14 feet
Resident witnesses:	
Mark Selmo	
Bill Erickson	
	Description of monument and accessories I established to perpetuate the original location of this corner.
	Blazed and scribed the following new bearing trees:  Sugar Maple 7" S.11 W. 9.81 feet  Sugar Maple 8" S.86 30'W. 21.79 feet  Steel sign post North 0.60 feet
SECTION II	Dated atIron River, MI , WMs., this2ndday ofNovember, 19 87
	Signature Day Surveyor, Registered Land Surveyor, or other duly authorized official)  (Coupty Surveyor, Registered Land Surveyor, or other duly authorized official)
	Office of Register of Deeds, County of Forest I hereby certify that the within instrument was filed in this office for record on the 5th day of February 1988 a 12:450 clock P. M.
O = Corner monument restored.	ByDeputy


Describe any material discrepancy between the location of the corner as restored or reestablished and the location of that corner as previously restored or reestablished by distance and direction. Show the discrepancy on the plan view drawing under (d), above. Show the distances between the corner as previously restored or reestablished and (1) the corner as restored or reestablished, and (2) to at least 2 of the witness monuments shown on the drawing in (d), above. re t

See drawing below

the corner restored through acceptance of (1) an obliterated evidence location, or, found perpetuated location?

Restored through acceptance of a found perpetuated location.

(gkh) Was the corner reestablished through lost corner proportionate methods? If so, show the method, including the directions and distances to other public land survey corners used as evidence or used for proportioning in determining the corner location?

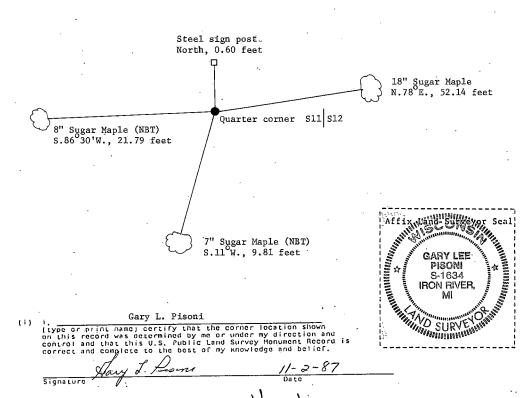

Gary L. Pisoni

(type or print name) certify that the corner location shown on this record was determined by me or under my direction and control and that this U.S. Public land Survey Monument Record is correct and complete to the best of my knowledge and belief.

Signature

Survey requested by: District Range

CE	RTIFIED LAND CORNER RESTORATION
State of Wisconsin	
County of Forest ss.	
I found evidence of the south Township 40 north	, do hereby certify that on the 2nd day of October , 19.73, quarter, Corner of Section 8, Range 12 east, Fourth Principal Meridian, as described ce I established a new monument and accessories as described hereon to personner:
Description of original monument	and accessories and subsequent restorations:
Original survey in 1859 by Dependent Resurvey in 1941 Set iron pipe 36 inches lon Aspen 4, bears S23E, 16 1/2 Aspen 5, bears N17W, 26 1/2	by Guy R. Veal g, 2 inch diameter with brass cap marked S8, 1/4, S17, 1941 lks.
Description of corner evidence fou	nd:
Monument as described above Aspen stump bears S23E, 17. Aspen stump bears N17W, 10.	
Blazed and scribed the follo	essories I established to perpetuate the location of this corner:
White pine 5, bears N74E, 2 White pine 6, bears S56E, 1 Steel sign post set 1.0 foo	.50 feet 3.45 feet
	JEAN F. RESVICK RHINELANDER. WIS.
	Resident witnesses
	Dated at Rhinelander Wisconsin, this 30 day 0055000
Sec 8	19The. Jean J. Resvice
Sec. 8	Signature Jean F. Resvick Title Land Surveyor (County Surveyor, Registered Land Surveyor, or other duly authorized official)
	Surveyors Registration No. S-802 DOCUMENT NUMBER 105821
	Office of Register of Deeds County of Forest
Corner monument restored	I hereby certify that the within instrument was filed in this office for record on the oth day of August 19.74, and was filed in Book No Corner Page No. J-7 of County Records.
ing in	Signature Ligene State not Title
Township 40 north Range	e (1 (1 (1 (1 (1 (1 (1 (1 (1 (1 (1 (1 (1

FORM NO. 985-A

128477

DOCUMENT NUMBER

State of Wisconsin		
County of Forest ss.		
Robert H. Winat , do hereby certify that on the 4th day of April ;19.85, I found evidence of the Section corner of 8-9-16-17  Township 40 , North, Range 12 East , Fourth Principal Meridian, as described hereon; and that from this evidence I established a new monument and accessories as described hereon to perpetuate the original location of this corner.		
Resident witnesses:		
Mike Stevens		
Mike Lukasko		
<del> </del> <b>-9</b> <del> </del>		
7		
<ul><li>Corner monument restored.</li></ul>		

History of original corner establishment: Established in 185 Dependent resurvey in 1941 by G.R. Veal set a 6" of He established the following BT's:	9 by Wm. E. Daugherty. concrete with brass cap.
Poplar 7" N59°W 63 lks. Poplar 5" Poplar 7" S60°E 79 lks. Poplar 5"	' S49°W 49 lks. ' N67°W 31½ lks.
Jean F. Resvick in 1963 found concrete and cap and	d BT's: '
Poplar snag 7" N59°E 41.6 ft. Poplar fal Poplar snag 8" S60°E 52.1 ft. Poplar sna	
XXXXXXXXXXXXXXXXXXXXXXXXXXXXXXXXXXXXXX	
White Pine 4" S82°W 12.60 ft. White Pi White Pine 4" N14°E 17.10 ft.	ne 4" S75°E 9.70 ft.
Description of corner evidence found:	
Found 1941 G.L.O. monument and the following: White Pine 4" N14°E 17.38 fttree dead, Poplar 12" N72°E 11.90 ftovergrown White Pine 4" S77°E 9.95 fttree dead,	scribe visible
White Pine 8" S81°W 23.05 fto.k. White Pine 4" S82°W 12.60 ftcut down,	,
Description of morument and accessories I established to perposition and scribed the following BT's:	etuate the original location of this corner.
White Pine 9" S19°W 11.17 ft. White Pine 6" N6°W 33.80 ft. White Pine 8" S81°W 23.05 ft. Poplar 12" N72°E 11.90 ft. Sign Post N47°W 1.15 ft.	
(over) Dated at Rhindards Wis., this 4	day of
	Street Registration No. 1040
Office of Register of Deeds, County of Forest instrument was filed in this office for record on the 24th at 1:10 o'clock P M.	, I hereby certify that the within day of July 1985
Paul Aschenbrenner (Register of Deeds)	-
ByDeput	у


Describe any material discrepancy between the location of the corner as restored or reestablished and the location of that corner as previously restored or reestablished by distance and direction. Show the discrepancy on the plan view drawing under (d), above. Show the distances between the corner as previously restored or reestablished and (1) the corner as restored or reestablished, and (2) to at least 2 of the vitness monuments shown on the drawing in (d), above.

See drawing below.

Was the corner restored through acceptance of (1) an obliterated evidence location, or, (2) a found perpetuated location?

Found perpetuated location.

(g&h) Was the corner reestablished through lost corner proportionate methods? If so, show the method, including the directions and distances to other public land survey corners used as evidence or used for proportioning in determining the corner location?

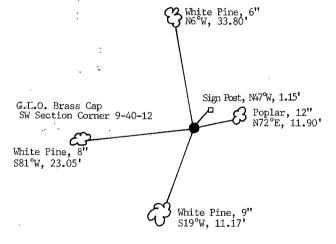

Tobert H W, MA

I type or print name; certify that the corner location shown on this record was determined by me or under my direction and control and that this U.S. Public Land Survey Monument Record is correct and complete to the best of my knowledge and belief.

Control and that this U.S. Public Land Survey Monument Record is correct and complete to the best of my knowledge and belief.

SCONS
ROBERT H. ROBERT H. WINAT ₽ S - 1040 RHINELANDER 10 Sp. WIS. NOSURVE SURVE SURV

O = Corner monument restored.

Jean F. Resvick do hereby

State of Wisconsin

County of Forest

SS.

Index No

History of original corner establishment:

Surveyed in 1859 by Wm. E. Daugherty. Dependent Resurvey in 1941 by Guy R. Veal. At proportionate distance set concrete monument, 2 ft. long, 6 in. diam., with iron post, 22 in. long, 1 in. diam., encased therein with brass cap marked:

> THON RIZE **S8 S**9 s17 s16 1911

From which: Poplar 7", bears, N59°E, 63 lks. Poplar 7", bears, S60°E, 79 1ks. Poplar 5", bears, Sh9°W, 49 1ks. Poplar 5", bears, N67°W,  $31\frac{1}{2}$  lks.

Description of corner evidence found:

Monument as described: Poplar, snag 7", N59°E, 41.6 ft. Poplar, snag 8", S60°E, 52.1 ft. Poplar, fallen 5", S49°W, 32.3 ft.

Description of monument and accessories I established to perpetuate the original location of this corner.

Blazed and scribed the following new bearing trees: W. pine 4", \$82°W, 12.60 ft. (19.09 lks.) W. pine 4", N14°E, 17.10 ft. (25.91 1ks.) W. pine ht. S75°E, 9.70 ft. (14.70 lks.)

, Wis, this 16 th day of August Rhinelander F. Olewick Title Cadastral Surveyor Registration No. S-802 Signature.. (County Surveyor, Registered Land Surveyor, or other duly authorized official) Office of Register of Deeds, County of Jonest Lhereby certify that the within instrument was filed in this office for record on the.... November at 900 o'clock A

(Register of Deeds)

87830

"No trees available for marking, as corner falls in open swamp."

N55°E

Established in 1859 by Wm. E. Daugherty. Dependent resurvey in 1941

History of original corner establishment:

A fallen Spruce

NUMBER

DOCUMENT

IRobert H. Winat, do hereby certify that on the
Resident witnesses:
Mike-Stevens
Mike Lukasko
<del></del>
<del> </del> <del> </del>
<del>-</del>
<ul><li>Corner monument restored.</li></ul>

State of Wisconsin

County of Forest

· ss.

Description of corner evidence found: Found G.L.O. corner and possible original BT remains that match bearing and distance of Veal's.

by G.L.O., G.R. Veal, set a brass capped 2" iron pipe with the following BT's:

10 lks. (remains of original BT)

Description of monument and accessories I established to perpetuate the original location of this corner. Did not set any accessories as corner falls in open swamp. Witnessed by section corners east and west.

(over) Registration No. 1040 (County Surveyor, Registered Land Surveyor, or other duly author Forest Office of Register of Deeds, County of ..... I hereby certify that the within 24th day of July instrument was filed in this office for record on the. at 1:10 o'clock P. M.

(Register of Deeds)

(e) Describe any material discrepancy between the location of the corner as restored or reestablished and the location of that corner as previously restored or reestablished by distance and direction. Show the discrepancy on the plan view drawing under (d), above. Show the distances between the corner as previously restored or reestablished and (1) the corner as restored or reestablished, and (2) to at least 2 of the vitness monuments shown on the drawing in (d), above.

See drawing below.

(f) Was the corner restored through acceptance of (1) an obliterated evidence location, or, (2) a found perpetuated location?

Found perpetuated location.

(gkh) Was the corner reestablished through lost corner proportionate methods? If so, show the method, including the directions and distances to other public land survey corners used as evidence or used for proportioning in determining the corner location?

G.L.O. Brass Cap South ½ Corner 9-40-12

2509.38'

S89°15'40"E

Section Corner

Section Corner 8,9,17,16, 40-12

2"X36" I.P. w/3"Brass cap by G.L.O.

Section Corner 8,9,16,15, 40-12

2"X36" I.P. w/3"brass cap by G.L.O..

IgnO syrgenor Scal

(i) Robert H W, mit

(type or print name; certify that the corner location shown on this record was determined by me or under my direction and control and that this U.S. Public Land Survey Monument Record is correct and complete to the best of my knowledge and belief.

acure Robert HW mot 4)

WINAT S-1040 RHINELANDER, WIS.

SURVEY

ROBERT H.

Date

State of Wisconsin	0.0.
County of Forest ss.	
I	day ound dange dian, dence sories
Resident witnesses:	
Mike Stevens Mike Lukasko	
<del>        </del>	
1 1 1	
Corner monument restored.	


1100	
History of original corner establishment: Wm. Daugherty established in 1859 and set a wood post.	
G.L.O. resurvey by Guy Veal in 1941 set a concrete w/brass cap and these BT's: Maple 10", N59½°E, 44 Lks.  Maple 7", S63½°E, 52 Lks.  Maple 7", S33°W, 52 Lks.  Y. Birch 5", N44½°W, 30½ Lks.	
In 1967 Jean Resvick recovered the G.L.O. monument and BT's.	
Description of corner evidence found: In 1985 found the G.L.O. Brass cap and the following BT's:  Maple 10" S33°W 34.41' Maple 19" N60°E 15.40' Maple 15" S63½°E 33.94'	
Sign Post N71°E 1.40'	
	=_
Description of monument and accessories I established to perpetuate the original location of this constant $\mathcal{L}$	orner.
Set the following new BT: Maple 10" N46°W 22.55'	
Dated at Rhinelander , Wis., this 12 day of June	19. <b>85</b>
Signature Gold Winds Title Land Surveyor Registrat	
Office of Register of Deeds, County of Forest , I hereby certification instrument was filed in this office for record on the 24th day of July at $1:10.0$ clock P. M.	fy that the within 19 <b>85</b>
Paul Aschenbrenner (Register of Deeds)	
D. D	

(e) Describe any material discrepancy between the location of the corner as restored or reestablished and the location of that corner as previously restored or reestablished by distance and direction. Show the discrepancy on the plan view drawing under (d), above. Show the distances between the corner as previously restored or reestablished and (1) the corner as restored or reestablished, and (2) to at least 2 of the vitness menuments shown on the drawing in (d), above.
N/A

(f) Was the corner restored through acceptance of (1) an obliterated evidence location, or, (2) a found perpetuated location?

Found perpetuated location.

(gkh) Was the corner reestablished through lost corner proportionate methods? If so, show the method, including the directions and distances to other public land survey corners used as evidence or used for proportioning in determining the corner location?

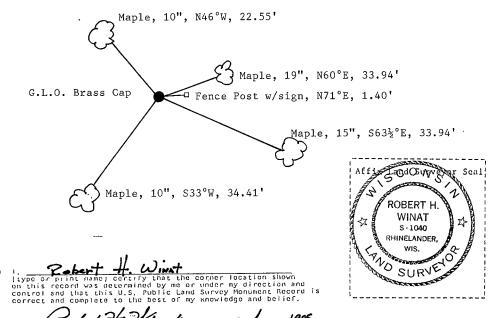

	R9-5680-5 (7/15/64) N. C. MILLER CO., MILWAUKEE 448643
C	ERTIFIED LAND CORNER RESTORATION
State of Wisconsin	
County of Forest.	ss.
found evidence of the	, do hereby certify that on the <u>8th</u> day of <u>March</u> , 1967, Northeast section corner of <u>Section 16</u> , Range 12 East , Fourth Principal Meridian, as described ence I established a new monument and accessories as described hereon to perhis corner:
Description of original monumen Original surv Set concrete an iron post, marked:	t and accessories and subsequent restorations: ey in 1859. Dependent resurvey in 1941 by Guy R. Veal. monument, 2 ft. long, 6 ins. diam., 18 ins. in ground with 22 ins. long, 1 in. diam. encased therein with brass cap
/	Maple 10", N59° 30'E, 44 lks. Maple 7", S63° 15'E, 52 lks. Maple 7", S33°W, 52 lks. Yellow birch 5", N44° 30'W, 30½ lks.
Monument as described ab	ove: .3 ft. or 23 lks. (distance recorded as 44 lks.) .3 ft. t. "W, 20.13 ft.
No new accessories added U. S. Forest Service bea	cessories I established to perpetuate the original location of this corner:  . ring tree shields were placed on each bearing tree. h maple to find scribing to prove distance was
	JEAN F. RESVICK RHINELANDER, WIS.
•	Resident witnesses.
	Dated at Rhinelander, Wisconsin, this 21 st day of March.  19 67.
Sec. 16	Signature Jean F. Resvick Title Cadastral Surveyor (County Surveyor, Registered Land Surveyor, or other duly authorized official)
	Surveyors Registration No. S-802 DC. No. 94215
	Office of Register of Deeds County of Forest  I hereby certify that the within instrument was filed in this office for record
© = Corner monument restored	on the 27th day of February 19.68, and was filed in Book No. I Page No. of County Records.
<u>-</u> - `	Signature Lugent Stategray Title Register Of Deeds
Township, Ran	ge 12 East , Section 16 , Index No. J-13 , Page No.

	R9-5980-5 (7/15/64) H. C. MILLER CO., MILWADEEE 448643-
· C	ERTIFIED LAND CORNER RESTORATION
State of Wisconsin	ss.
County of Forest	
I found evidence of the Angl Township 40 North	m, do hereby certify that on the 3rd day of May , 19 65, e Point 8 restor of Section 15.  Range 12 East. Fourth Principal Meridian, as described once I established a new restoration accessories as described hereon to per-
Surveyed in 1943 by Hal D. inches in the ground, for diam., encas marked: R12E S15 from whic	t and accessories and subsequent restorations:  Craig. Set concrete monument, 2 ft. long, 1 inches diam., 20 angle point 8, Sec. 15, with an iron post, 22 inches long, 1 inced therein, with brass cap  h: A Maple, 6 inches diam., bears \$760301W, 89 lks. dist.
1943	A Maple, 12 inches diam., bears N34 <sup>0</sup> 30 W, 25 1ks. dist.
Description of corner evidence fo	
Monument found as describe Maple 14 ins. diam., bears Maple 17 ins. diam., bears	d above. \$76°30'W, 58.74 ft. N34°30'W, 16.50 ft.
•	
=	cessories I established to perpetuate the original location of this corner:
A maple, 6 ins. diam., bear	lowing new bearing tree: rs S17°30' E, 24.0 ft. or 36.4 lks. dist.
	90407
44¢12 153728	AUG 1 1 1965  AUG 1 1 1 1 1 1 1 1 1 1 1 1 1 1 1 1 1 1 1
	Resident witnesses.
AP 8	Dated at Rhinelander Wisconsin, this 9th day of Aug.
Sec. 15	Signature flan f Resveck Title Cadastral Surveyor (County Surveyor, Registered Land Surveyor, or other duly authorized official)
	Surveyors Registration No
	Office ofCounty ofI hereby certify that the within instrument was filed in this office for record
Corner monument restored	on the day of 19, and was filed in Book
=	1,01
1.0 x	Signature11tle
Township 40 North , Rang	ge_ 12 East, Section_ 15, Index No, Page No

6.33

State				
	of Wise	consin	ss.	
County of	Forest		} SS.	
certify that of Novem evidence of corner of Township	t on the sheer c the So Sect LO the Fild hereon; ared & new % d hereon to	8th 19 uth 1/4 ion 10 ourth Prin ion that from 10 ion	, North, Range cipal Meridian, n this evidence at the original te the original	
location of	this corner.			
Resident w	itnesses:			
Me al	ם מובבי			
MICI	izei G. S	tevens		
1	1.	1		
	1	1	1	
	1 1 1	1	1 1 1	
	1	1	1 1	
	1 1 1 1	1        -	1 1 1 1 1 1 1 1 1 1 1 1 1 1 1 1 1 1 1 1	
	 	1    -  -  -	1 1 1 1 - <del>1</del>	
		 	   1   1       1	
		    - 	1 1 1 1 1 1	
	I I I I I I I I I I I I I I I I I I I	    - 	1 1 1 1 1 1 1	
	SEC	 		
	SEC	10		
		10		
		101111111111111111111111111111111111111		
		10		
	SEC	110		
	SEC	1 10 1 10 1 1 1 1 1 1 1 1 1 1 1 1 1 1 1		

History of original corner establishment:

Wm. Daugherty 1859 survey.

1941 Dependent resurvey by Guy Veal of G.L.O. set 2"iron pipe & Bt's-12"HemlockS42\frac{1}{2}OW. 48 lks-6"Maple N29°W.46 lks.

1965 Jean Resvick recovered momt. & BT's of 1941 (new)8"Y. Birch N54°E,54.0"

Description of corner evidence found:

steel sign post bears

G.L.O. mont. And Resvick's Bt's.

Description of monument and accessories I established to perpetuate the priginal location of this corner.

BT's; 11" Y. Birch N 5420E, 54.13' 15" Maple N 4320W, 29,41 ' 16" Hemlock S 840W, 40.40 ' to mail in side of tree 10" Hemlock S 27 ow, 32.43

over

N 70 W

(County Surveyor, Registered Land Surveyor, or other duly authorized official) Office of Register of Deeds, County of Forest ., I hereby certify that the within July 1985

24th

instrument was filed in this office for record on the at 1:10 o'clock P. M.

(Register of Deeds)

401210000


(e) Describe any material discrepancy between the location of the corner as restored or reestablished and the location of that corner as previously restored or reestablished by distance and direction. Show the discrepancy on the plan view drawing under (d), above. Show the distances between the corner as previously restored or reestablished and (1) the corner as restored or reestablished, and (2) to at least 2 of the witness monuments shown on the drawing in (d), above.
N/A

(f) Was the corner restored through acceptance of (1) an obliterated evidence location, or, (2) a found perpetuated location?

(gkh) Was the corner reestablished through lost corner proportionate methods? If so, show the method, including the directions and distances to other public land survey corners used as evidence or used for proportioning in determining the corner location?

1941 survey proportioned this corner.

2

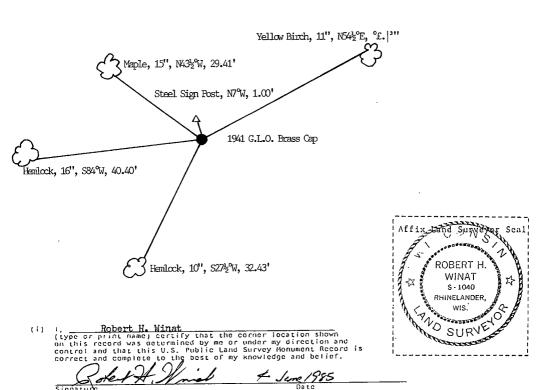

·	: : R9-5580-5 (7/15/64) N. C. WILLER CO., MILWAUKER 448849	_
C	ERTIFIED LAND CORNER RESTORATION	
State of Wisconsin  County of Forest	ss.	
I found evidence of the North Township 40 North	, do hereby certify that on the 3rd day of May 19.69 a quarter corner of Section 15	ed
Description of original monument Original survey by Wallia At proportionate distance for 1/4 sec. of marked:	at and accessories and subsequent restorations: Im E. Daugherty in 1859. Dependent Resurvey by Guy R. Veal, in set an iron post, 3 ft. long, 2 ins. diam., 27 ins. in the gro corner, with brass cap	n 1941 ound,
1 S 10 4 S 15 1941	which: A Hemlock, 12 ins. diam., bears S43°30'W, 48 lks, dismkd 1/4 S15BT.  A Maple, 6 ins. diam., bears N29°W., 46 lks. dist., ml 1/4 S10 BT.	•
when scribed.  A Maple, 12 ins. diam., bea	ound: ed above, from which, ears S29°W, 32.3 ft. dist. Hemlock was about 6 ins. diam. ears N山 <sup>O</sup> W., 29.85 ft. dist. Maple was 6 ins. diam. when scrib eg trees were recorded for opposite trees.	oed.•
Blazed and scribed the following		
•	90408 GISTER'S OFFICE DREST COUNTY, WIS.	•
44.012/00020 11	AUG 1 1 1965  AUG 1 1 1965  AUG 1 1 1965	2,5
Sec., 15	Resident witnesses  Dated at Rhinelander  19 65.  Signature Lander  Title Cadastral Surveyor	
	(Conty Surveyor, Registered Land Surveyor, or other duly authorized official)  Surveyors Registration No	ord
Corner monument restored	on theday of19, and was filed in Bo NoPage Noof County Records.	
	SignatureTitle	····

Township 40 North , Range 12 East , Section 15 , Index No. J-15 , Page No.

FORM NO, 985-и местине Балия В Stock No. 26273


Obel of Miner of	ilidex No.
State of Wisconsin  County of FOREST ss.	History of original corner establishment:
certify that on the Seventh day of November 19.84. I found evidence of the Southeast corner of Section 10.  Township 40 North North Range 12. East Fourth Principal Meridian, as described hereon; and that from this evidence I established X new XOCHIMENTAGE accessories as described hereon to perpetuate the original location of this corper.	1941 Dependent resurvey by Guy R. Veal of G.L.O. 18"Maple N40°E,901ks-22"Y.BirchS428W,511 Set conc. mont. & made BT's; 12"Hemlock N26½°E,90 lks-7"Hemlock S59°45'E,601ks - 1965 5"Hemlock, S 50W, 39 lks-9"Hemlock N39½°W, 17 lks.  Jean Resvick recovers 1941 corner makes new BT's- 22"Y.Birch S42°W,3.3'-Hemlock snay N26°15'E,59.4'- Hemlock snag S59°45'E, 45.5'-12"HemlockS5°W,25.7'-14"HemlockN39½°W, new - 3" Maple S 68°E, 10.7'  Description of corner evidence found:  G.L.O. conc.mont. 36" Y.Birch,S30°W, 3.8'- 1941 S5°W Hemlock- 1965 3"Maple Wood sign post
Resident witnesses:	
Michael G. Stevens	
Michael T. Lukasko	
	Description of provided accessories I established to perpetuate the original location of this corner.
	BT's; 36"Y. Birch S30°W, 3.85' 16"Hemlock S 5°W, 26.66' 4" Maple S 70°E, 10.68 to nail in side of tree 8" Maple N12°E, 34.16' 20"Hemlock N47°W, 10.53' Wood sign post S44°E, 2.1'
SEC 10 1	Dated at. Rhindonke , Wis, this day of
<ul><li>Corner monument restored.</li></ul>	ByDeputy

(e) Describe any material discrepancy between the location of the corner as restored or reestablished and the location of that corner as previously restored or reestablished by distance and direction. Show the discrepancy on the plan view drawing under (d), above. Show the distances between the corner as previously restored or reestablished and (1) the corner as restored or reestablished, and (2) to at least 2 of the vitness monuments shown on the drawing in (d), above.
N/A

(f) Was the corner restored through acceptance of (1) an obliterated evidence location, or, (2) a found perpetuated location?

(gkh) Was the corner reestablished through lost corner proportionate methods? If so, show the method, including the directions and distances to other public land survey corners used as evidence or used for proportioning in determining the corner location?

 $n_0$ 

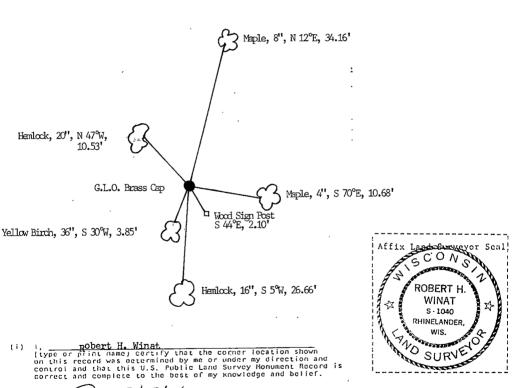

Signature Namel

4 June 1985

	RO-5680-5 (7/15/64) H. C. MILLER CO., MILWAUEEE 448643
. CE	ERTIFIED LAND CORNER RESTORATION
State of Wisconsin	-
County of Forest	SS.
found evidence of the Souther Fownship 40 north	ast section
$ \begin{pmatrix} \underline{\text{S10}}   \underline{\text{S11}} \\ \underline{\text{S15}}   \underline{\text{S14}} \end{pmatrix} $ A M	e, from which:  A Hemlock, 5 ins., 55°W, 39 lks.  A Hemlock, 9 ins., N39°30'W, 17 lks.  A Hemlock, 9 ins., N39°30'W, 17 lks.  A Hemlock, 9 ins., N39°30'W, 17 lks.
Blazed and scribed the foll	
14012 18000	S S68°E, 10.7 ft. or 16.21 lks.  90413  FEGISIER'S OFFICE FOREST COUNTY, WIS.  AUG 1 1965  Aug 1 1965
Section 10	Resident witnesses  Dated at Rhinelander Wisconsin, this Ish day of 1965  Signature from f Resurk Title Cadastral Surveyor (County Surveyor, Registered Land Surveyor, or other duly authorized official)
Corner monument restored	Surveyors Registration No. S-802  Office of
	SignatureTitle
Township 40 North Rang	ge 12 East , Section 10 , Index No. J-17 , Page No

. FORM NO. 985-A

DOCUMENT NUMBER 134616

O = Corner monument restored.

. 0.5.	TOBLIC EARD SORVET MICHOMENT RECORD	Index No. JT19
State of Wisconsin	History of original corner establishment:	
County of Forest	1941 Dependent resurvey by Guy R. Veal and found no evidence of the	original post or
•	original bearing trees. Corner restored by proportionate methods.	Guy R. Veal set
I Gary L. Pisoni , do hereby	a 2" diameter by 36" long iron pipe with a brass cap stamped: U.S.	General Land
certify that on the 12th day	Office Survey, 1/4, S11, S14, 1941 from which the following bear:	
of November 19 86 I found	White Pine 5" N.76 <sup>0</sup> 25'W. 65 links Maple 5" S.41 <sup>0</sup> 25'W 119 links	
evidence of the South quarter corner of Section 11	Maple 5" S.41 <sup>0</sup> 25'W. 119 links	
Township40 , North, Range		
12E Fourth Principal Meridian,		
as described hereon; and that from this evidence	Description of corner evidence found:	•
I established a new monument and accessories		
as described hereon to perpetuate the original	Monument as described and in place, from which the following bear:	
location of this corner.	All bearing trees dead.	
5.11	in searing crees dead.	
Resident witnesses:		Ø
Rich Sloat		Ŋ
		$\mathscr{Q}_{\iota}$
		$\mathcal{G}$
	Description of monument and accessories I established to perpetuate the original location of	of this corner. N
	Blazed and scribed the following new bearing trees:	2
	Red Maple 10" N.09°E. 7.61 feet	\$
	Red Maple 10" N.09°E. 7.61 feet Sugar Maple 3" S.19°W. 12.41 feet	7
	Balsam 7" S.69 <sup>°</sup> W. 10.31 feet	1
1 1 .	Steel sign post S.74°E. 1.0 feet	
<del></del>		
1 1 1		
SECTION II	Dated at Iron River, MI WWK, this 2nd day of November	per 10.87
<del> </del>		
1 1 1	Signature Land Surveyor Title Land Surveyor [County Surveyor, Registered Land Surveyor, or other duly authorized official)	Registration No. S-16
	(County Surveyor, Registered Land Surveyor, or other duly authorized official)	
	Office of Register of Deeds, County of Forest I here instrument was filed in this office for record on the 5th day of February	by certify that the with
<del> </del>	instrument was filed in this office for record on the OLD day of Febru	ary 19 8
<b> </b>	at 12:45 clock P. M.	
	Harles Lange	
	(Register of Deeds)	
L		

...Deputy


Describe any material discrepancy between the location of the corner as restored or reestablished and the location of that corner as previously restored or reestablished by distance and direction. Show the discrepancy on the plan view drawing under (d), above. Show the distances between the corner as previously restored or reestablished and (1) the corner as restored or recstablished, and (2) to at least 2 of the witness monuments shown on the drawing in (d), above.

See drawing below.

Was the corner restored through acceptance of (1) an obliterated evidence location, or, (2) a found perpetuated location?

Restored through acceptance of a found perpetuated location.

(gkh) Was the corner reestablished through lost corner proportionate methods? If so, show the method, including the directions and distances to other public land survey corners used as evidence or used for proportioning in determining the corner location?

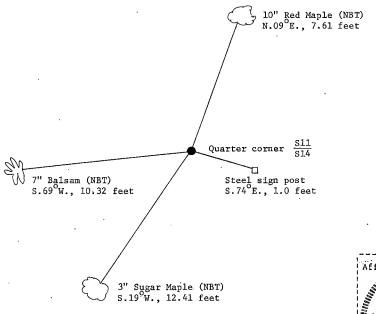

Gary L. Pisoni

type or print name) certify that the corner location shown on this record was determined by me or under my direction and control and that this U.S. Public Land Survey Monument Record is correct and complete to the best of my knowledge and belief.

Survey requested District Ranger GARY LEE
PISONI
S-1634
IRON RIVER,
MI
SURVE

12" Sugar Maple

10" Sugar Maple

N32°W

S24°E

evidence of the corner post or BT's. Set an iron post 2"x36",

27" in the ground for corner of Sections 11,12,13 and 14 with a

9.14 ft.

6.09 ft.

0.50 ft.

County Surveyor, Registered Land Surveyor, or other duly authorized official)

Registration No. 1060

9 lks. (5.94 ft.)

18 lks. (11.88 ft.)

6" Sugar Maple

7" Sugar Maple

Metal Sign Post

brass cap stamped to identify corner.

N27"E

 $N O^{O}E$ 

Aschenbrenner

(Register of Deeds)

s41°30'W

..... I hereby certify that the within

461211 BBBB

= Corner monument restored.

State of Wisconsin

County of Forest

location of this corner.

Resident witnesses:

History of original corner establishment: SS. Original corner set by Wm. Daugherty, Deputy Surveyor in 1859. Set Post. I Robert H. Winat ...... do hereby BT'S certify that on the 14th day of September 19.84., I found evidence of the Section corner of \_\_\_\_Sections 11, 12, 13, 14 Township.......40......, North, Range 12 East Fourth Principal Meridian, Description of corner evidence found: as described hereon; and that from this evidence I established a new monument and accessories 1941-G.L.O. resurvey-Proportionate distance; there is/no remaining as described hereon to perpetuate the original Continued on back side ... (aver) Dated at EAGLE RIVER Wis., this. G day of MOVEMBER , 19.84 Office of Register of Deeds, County of Forest instrument was filed in this office for record on the 24th day of July 1985 at 1:10 o'clock P. M.

(e) Describe any material discrepancy between the location of the corner as restored or reestablished and the location of that corner as previously restored or reestablished by distance and direction. Show the discrepancy on the place view drawing under (d), above. Show the distances between the corner as previously restored or reestablished and (1) the corner as restored or reestablished, and (2) to at least 2 of the vitness monuments shown on the drawing in (d), above.

Continued from front page:

N/A

Description of monument and accessories I established to perpetuate the original location of this corner.

Put new sign on post monument, sign missing. Brought all trees to std. Painted red band around trees, blazed and painted same. Nail in side of tree at root crown. Made new BT's as follows:


12" Oak N61°W 31.14 ft. 4" Sugar Maple S30°E 9.84 ft.

(f) Was the corner restored through acceptance of (1) an obliterated evidence location, or, (2) a found perpetuated location?

N/A

(gkh) Was the corner reestablished through lost corner proportionate methods? If so, show the method, including the directions and distances to other public land survey corners used as evidence or used for proportioning in determining the corner location?

N/A

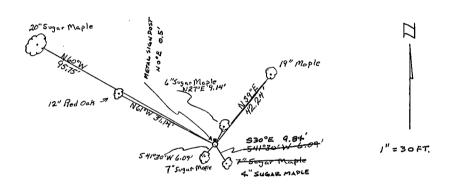

ROBERT H.

WINAT

S. 1040

RelineLander,

wis.

OSURVE

Monument Record is edge and belief.

Affix Land-Surveyor Scal

(i) 1. Robert H. Winat R.L.S. 1040 (type or print name) certify that the conner location shown on this record was determined by me or under my direction and control and that this U.S. Public Land Survey Monument Record is correct and complete to the best of my knowledge and belief.

Robert H. Winat 6 NOV. 1984

DOCUMENT, NUMBER

Corner monument restored


scribing visible

(e) Describe any material discrepancy between the location of the corner as restored or reestablished and the location of that corner as previously restored or reestablished by distance and direction. Show the discrepancy on the plan view drawing under (d), above. Show the distances between the corner as previously restored or reestablished and (1) the corner as restored or reestablished, and (2) to at least 2 of the vitness monuments shown on the drawing in (d), above.

N/A

Was the corner restored through acceptance of (1) an obliterated evidence location, or, (2) a found perpetuated location?  $_{\rm M}/_{\rm A}$ N/A

(gkh) Was the corner reestablished through lost corner proportionate methods? If so, show the method, including the directions and distances to other public land survey corners used as evidence or used for proportioning in determining the corner location? N/A

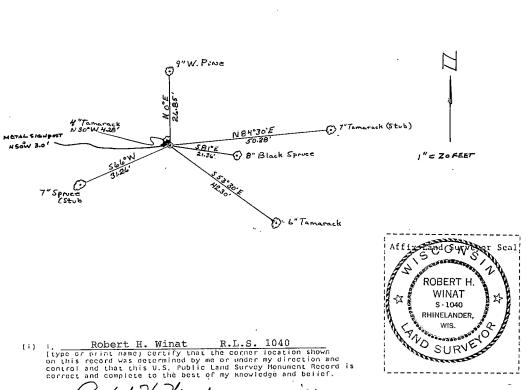

det H. Winat Date Signature

6 NOV. 84

#### CERTIFIED LAND CORNER RESTORATION

State	of	Wisconsin	1	
County	of	Forest	} :	SS

ck do hereby certify that on the 1 day of August 1978,
North Quarter corner of Section 13
Range 12 East Fourth Principal Meridian, as described I Jean F. Resvick I found evidence of the .... Township 40 North hereon; and that from this evidence I established a new monument and accessories as described hereon to perpetuate the original location of this corner:

Description of original monument and accessories and subsequent restorations: Surveyed in 1859 by William E. Daugherty 39.982 chains west corrected between Sections 12 and 13, set post Tamarack 6, N28W, 20 Tamarack 5, S44E, 9

Dependent resurvey in 1941 by Guy R. Veal

At proportionate distance, set iron post, 3 ft. long, 2 in. diameter, 27 ins. in the ground, with brass cap marked S12, 1/4, S13, 1941

Tamarack 10, N84E, 75 1ks.

Spruce 6, S66 1/4W, 47 1/2 1ks.

Tamarack post, 4 ins. square, 6 ft. long, north and alongside of monument. Description of corner evidence found:

Monument as described Tamarack post rotted off on north side of monument.

Tamarack stump 10, N83E, 50.1 ft. Spruce snag 6, S65W, 31.2 ft.

Description of monument and accessories I established to perpetuate the location of this corner:

Blazed and scribed the following new bearing trees: White pine 7, N1E, 26.80 ft.

Tamarack 5, S54E, 42.26 ft.

Set steel sign post NW of monument about 1/2 foot.

# 4401212pgzd



Dated at Rhinelander Wisconsin, this 29 day of August 19...78.

RESVICK

RHINELANDER,

SUF

Signature Jean F. Resvick Title Land Surveyor (County Surveyor, Registered Land Surveyor, or other duly authorized official)

DOCUMENT NUMBER Surveyors Registration No. S-802 Office of Register of Deeds ......County of.....

I hereby certify that the within instrument was filed in this office for record on the 27th day of November 19 78, and was filed in Book Page No... .....of County Records.

Title Register of Deeds Signature

..... Section. Index No. J-23 , Page No. Township 40 North , Range 12 East

NUMBER

DOCUMENT

	AP8
,	
	  -section-15-+
	<u> </u>
	i i i l

Forest

November

40

Section 15

Mark Selmo

County of

certify that on the...

evidence of the.....

location of this corner.

Resident witnesses:

corner of......

Township...

O = Corner monument restored.

November 1987 Iron River, MI Dated at ....

Signature Stary 1. Frome Title Land Surveyor Registration No. S-1634 (County Surveyor, Registered Land Surveyor, or other duly authorized official)

Forest Office of Register of Deeds, County of .... ., I hereby certify that the within instrument was filed in this office for record on the 5th day of February 1988 at 12:45 o'clock P. M.

(Register of Deeds)

.Deputy


(e) Describe any material discrepancy between the location of the corner as restored or reestablished and the location of that corner as previously restored or reestablished by distance and direction. Show the discrepancy on the plan view drawing under (d), above. Show the distances between the corner as previously restored or reestablished and (T) the corner as restored or reestablished, and (2) to at least 2 of the vitness monuments shown on the drawing in (d), above.

See drawing below.

(f) Was the corner restored through acceptance of (1) an obliterated evidence location, or, (2) a found perpetuated location?

Restored through acceptance of a found perpetuated location.

(gkh) Was the corner reestablished through lost corner proportionate methods? If so, show the method, including the directions and distances to other public land survey corners used as evidence or used for proportioning in determining the corner location?

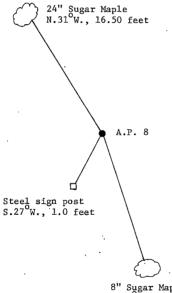

8" Sugar Maple S.17<sup>0</sup>30'E., 23.94 feet

(i) I. Gary L. Pisoni

(type or print name) certify that the corner location shown on this record was determined by me or under my direction and control and that this U.S. Public Land Survey Monument Record is correct and complete to the best of my knowledge and belief.

Signature Pary L. fismi Mon. 3rd 1987

Survey requested by:

Affix Land Syrveyor Scal

FORM NO. 985-A.

County of.	Fore	st	} ss.
ı	Gary L	. Pisoni	do her
certify that	t on the	26	
		er, 19	
evidence of	theA	ngle Poir n 15	ıtNo7.
Township	40		North. Ra
	12E, F	ourth Princ	ipal Merid
		nd that fron	
		nonument a o perpetua:	
location of			
Resident w	itnaccac		
Resident w			
******	Mark S	elmo	
	Willia	m Erickso	n
		••••••	
		` .	
		· .	v
		` .	v
		· .	
	1 1 1 1 1 1 1 1 1 1 1 1 1 1 1 1 1 1 1 1	· .	
	1 1 1 1	· .	
		A.P. 7	 
	SECTION	· .	 
	SECTIO	A.P. 7	 
	SECTION	A.P. 7	 
	SECTIO	A.P. 7	 
	SECTIO	A.P. 7	 
	SECTION	A.P. 7	 
	SECTIO	A.P. 7	 

U.S. PI

UBL	IC LAND	SURVEY	MONUME	NT RECO	RD	Inde	x No. J,K - 15,
ŀ	listory of origina	al corner estab	lishment:		. *		
	1943 Depender	nt resurvey	·				
1	Artu a T Incl	n diameter	iron post a	and brass ca	nches long, 4 in ap encased in co	ncrete stampe	d as follows:
	Maple Maple		6" N. 12" S.	24 <sup>0</sup> 45'E. 47 <sup>0</sup> 15'E.	10 links 60 links		
Γ	escription of co	rner evidence	found:				
ľ	fonument as o	described a	nd in place	, from which	ch the following	bear:	
		r Maple r Maple	28" S. 12" N.	48°E. 78°30'W.	39.60 feet 23.57 feet		,
,							;· .
D	escription of mo	onument and a	accessories I es	tablished to pe	rpetuate the origina	l location of this c	orner.
S	eț a steel s	sign post:	s.05°w., 0	.80 feet		-	- 2
	-						*-
	**						
	•						
		. /1			day of		
Si	gnature Aa	County Surveyo	r, Registered Lan	Title Lan d Surveyor, or ot	d Surveyor her duly authorized offic	Registra	tion No.S-1634
0	ffice of Register	of Deeds, Cou	inty of	Forest	- 	I hereby cert	ify that the within
in at	strument was hi	P	Л.		h day of	rebruary	, 1988
•••	Ja	(Regist	er of Deeds)	nner	·····		

..Deputy

e) Describe any material discrepancy between the location of the corner as restored or reestablished and the location of that corner as previously restored or reestablished by distance and direction. Show the discrepancy on the plan view drawing under (d), above. Show the distances between the corner as previously restored or reestablished and (1) the corner as restored or reestablished, and (2) to at least 2 of the vitness monuments shown on the drawing in (d), above.

See drawing below.

(f) was the corner restored through acceptance of (1) an obliterated evidence location, or, (2) a found perpetuated location?

Restored through acceptance of a found perpetuated location.

(gkh) Was the corner reestablished through lost corner proportionate methods? If so, show the method, including the directions and distances to other public land survey corners used as evidence or used for proportioning in determining the corner location?

12" Sugar Maple N.78°30'W:, 23.57 feet

Steel sign post S.05°W., 0.80 feet

€...

28" Sugar Maple S.48°E., 39.60 feet

Nov. 31d 1987

(i) i. Cary I. Pisoni
(type or print name) certify that the corner location shown
on this record was determined by me or under my direction and
control and that this U.S. Public Land Survey Monument Record is
correct and complete to the best of my knowledge and belief.

Signature Hay L. Fisine

Survey requested by:

District Ranger

GARY LEE
PISONE
S-1634
IRON RIVER,
MI

SURVENIE

1/1/33 Page

Sheet 1 of 2

## CERTIFIED BOUNDARY LINE AND CORNER ESTABLISHMENT

BEING THE NORTH 1,732.49 FEET OF THE WEST LINE
OF SECTION 18, AND THE PROPERTY CORNER AND
NORTH ONE SIXTEENTH ON SAID LINE, TOWNSHIP 40 NORTH,
RANGE 13 EAST, FOURTH PRINCIPAL MERIDIAN,
COUNTY OF FOREST, STATE OF WISCONSIN

#### LEGEND

- 2 inch diameter aluminum pipe, 3 feet long, with aluminum cap stamped to identify corner.
- O Corners monumented by B.L.M. in 1941

Scale: 1'' = 600 feet

#### SURVEY NOTES

This survey of the North half of the West line of Section 18, Township 40 North, Range 13 East, Fourth Principal Meridian was made by the U.S. Department of Agriculture, Forest Service.

The purpose of this survey was to establish the north one sixteenth and property corner on the section line and mark the boundary of U.S. Government land.

The U.S. Government acquired title to the NWNW Section 18 in 1934 and a parcel in the SWNW in 1937.

Bearing of line is as recorded by the B.L.M. Survey in 1941.

#### CORNERS RECOVERED

- Section corner to Sections 12 and 13, T40N, R12E, and Sections 7 and 18, T40N, R13E. Recovered as monument in 1941 by B.L.M.
- Quarter corner between Sections 13, T40N, R12E, and Section 18, T40N, R13E. Recovered as monument in 1941 by B.L.M.

#### CORNERS ESTABLISHED

1. North One Sixteenth Corner Between Sections 13 and 18, T40N, Range 12 and 13  $\overline{\text{East.}}$ 

Established north sixteenth at midpoint and on line between the section corner and quarter corner.

Corner References:

N 1/16

Prop

Maple 17, bears N22E, 10.12 feet Hemlock 20, bears S63E, 24.67 feet

DOCUMENT NO. 118063

4401213 ZODO

REGISTER'S OFFICE Forest County, Wis. 

Received for record this 9th day of June

A. D., 19 80 at 10:00 o'clock M. and recorded in Vol. of RESTORATION page K-1

Register of Deeds

Sharon Mueller, Dugar

MAL PIDE

K-1

Sheet 2 of 2

 Southwest Corner of Parcel in the SWNW of Section 17, T40N, R13E or Property Corner.

Established property corner 418 feet south on line from north sixteenth corner according to deed.

Corner References: Ash 6, bears N 8E, 17.95 feet Maple 27, bears N47E, 27.29 feet

#### SURVEYOR'S AFFIDAVIT

State of Wisconsin) County of Forest ) ss

I, Jean F. Resvick, Land Survey, U.S. Forest Service, and a registered Land Surveyor in the State of Wisconsin, hereby certify that I have surveyed the North half of the West line of Section 17, Township 40 North, Range 13 East, Fourth Principal Meridian, State of Wisconsin.

The plat map and the survey notes are a correct representation of the corners recovered, corners located, and section line location.

JEAN F.
RESVICK
RHINELANDER,
WIS:

Date of Survey: 1979

Land Surveyor

U.S. Forest Service R.L.S. State of Wisconsin

Certificate S-802

State of Wisconsin

#### . CERTIFIED LAND CORNER RESTORATION

County of
I William B. Cochrane , do hereby certify that on the 26th day of May , 1982  I found evidence of the Property corner of Between Sections 13 and 18  Township 40 North , Range 12 and 13 East , Fourth Principal Meridian, as described hereon; and that from this evidence I established a new monument and accessories as described hereon to perpetuate the original location of this corner:
Description of original monument and accessories and subsequent restorations:
Corner established by Jean Resvick in 1979 According to deed, set an aluminum monument, 3° long, with an aluminum cap stamped Property Corner, 1979, S-802 From which the following bear: Ash, 6", NSE, 17.85 ft. Maple, 27", N47E, 27.29 ft.
Description of corner evidence found:
Monument as described and in place Elm (dead), 6", NBE, 17.85 ft. Maple, 27", N47E, 27.29 ft.

Description of monument and accessories I established to perpetuate the location of this corner:

Blazed and scribed the following new bearing tree: Maple, 26", S70E, 10.13 ft. Steel sign post, East, .50 ft.

DOCUMENT NO.

44011132000



	Resident witnesses
Section 18	1982 William B. Cochrane  Signature William B. Gochrane Title Land Surveyor (County Surveyor, Registered Land Surveyor, or other duly authorized official)
	Surveyors Registration No. S-1107
	Office of Register of Deeds County of Forest
	I hereby certify that the within instrument was filed in this office for record on the 7th day of October 19 83, and was filed in Book
<ul> <li>Corner monument restored</li> </ul>	on the 1th day of October 19.82, and was filed in Book
	No

Township 40 North Range 12 East , Section 18 , Index No. K-L-1 , Page No.

\_0

NUMBER

DOCUMENT

44&12 1529Ø8


Describe any material discrepancy between the location of the corner as restored or reestablished and the location of that corner as previously restored or reestablished by distance and direction. Show the discrepancy on the plan view drawing under (d), above. Show the distances between the corner as previously restored or reestablished and (1) the corner as restored or recstablished, and (2) to at least 2 of the witness monuments shown on the drawing in (d), above.

See drawing below.

Was the corner restored through acceptance of (1) an obliterated evidence location, or, (2) a found perpetuated location?

Restored through acceptance of a found perpetuated location.

(g&h) Was the corner reestablished through lost corner proportionate methods? If so, show the method, including the directions and distances to other public land survey corners used as evidence or used for proportioning in determining the corner location?

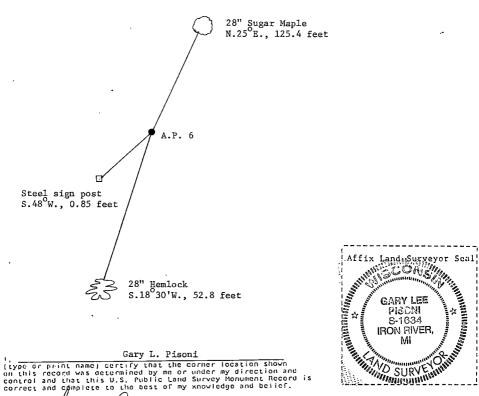

Gary L. Pisoni Lype or print name) certify that the corner location shown on this record was actermined by me or under my direction and control and that this U.S. Public land Survey Monument Record is correct and opmplete to the best of my knowledge and belief.

New. 31d 1987 Signatur

Survey requested by District Ranger

Stock No. 26273	128447
	NUMBER
,	DOCUMENT

0.3.
State of Wisconsin ss.
County of Forest
I Robert H. Winat , do hereby certify that on the day of day of Sersease , 19.84, I found evidence of the West Quarter corner of Section 13.  Township 40 , North, Range 12. East , Fourth Principal Meridian, as described hereon; and that from this evidence I established e new monument and accessories as described hereon to perpetuate the original location of this corner.
Resident witnesses:
.Robert H. Winat
.MichaelGStevens
.T40NR12E
S 13
= Corner monument restored.

History of original corner establishment: 1859-Wm. Daugherty, U.S. Government Deputy Surveyor, set wood post. BT's 7" Tamarack s45°W 46 lks. (30.36 ft.) S29°E 6" Tamarack 21 lks. (13.86 ft.) 1941-Guy R. Veal, Dependent Resurvey, 2"x36" iron post, proportionate distance. No remaining evidence of original post or BT's. New BT's 5" Tamarack S72°15'E 197 lks. N48°W 290 lks. Description of corner evidence found: 74" Spruce 1984-North Country Surveyors-R-A, M.G. Stevens, found a 2" iron pipe and sign post in marsh area. Corner is in good shape. Spruce BT to NW is dead but still standing. BT's found 5" Black Spruce N46°30'W 191.5 ft. (dead) 6" Tamarack S73°E 130.62 ft. Description of monument and accessories I established to perpetuate the original location of this corner. Placed nail in root crown of BT's to bring to std. Blazed, scribed and painted blazes, also painted red ring around trees. New Corner References: 5" Black Spruce S84°W 36.48 ft. 6" Black Spruce N26°30'E 56.49 ft. 4" Tamarack S86°E 26.50 ft. 2.78 3" Tamarack s37°E 11.68 ft. Sign post is West .4 ft. Corner is in a wet marsh area with scattered trees (OVER) L.S. Registration No. 1060 (County Surveyor, Registered Land Surveyor, or other-duly authorized official) Office of Register of Deeds, County of Forest I hereby certify that the within 24th July 1985 instrument was filed in this office for record on the.. at 1:10 o'clock P. (Register of Deeds)

(e) Describe any material discrepancy between the location of the corner as restored or reestablished and the location of that corner as previously restored or reestablished by distance and direction. Show the discrepancy on the plan view drawing under (d), above. Show the distances between the corner as previously restored or reestablished and (1) the corner as restored or reestablished, and (2) to at least 2 of the witness monuments shown on the drawing in (d), above.

N/A

(f) Was the corner restored through acceptance of (1) an obliterated evidence location, or, (2) a found perpetuated location? (2)

(gkh) Was the corner reestablished through lost corner proportionate methods? If so, show the method, including the directions and distances to other public land survey corners used as evidence or used for proportioning in determining the corner location?

Stakek Spruce (dead)

N/A

Sign Post West 0.40

31.48

32.50

34.48

Affix Sand Guyyanar Scal

(i) Robert H. Winat R.L.S. 1040
(type or print name; certify that the corner location shown on this record was determined by me or under my direction and control and that this U.S. Public Land Survey Monument Record is correct and complete to the best of my knowledge and belief.

Signatur

C NOV. 84

- (A. 17)

ROBERT H. WINAT

S - 1040 RHINELANDER, WIS.

NO SURVE

☆

70

0.3.	г
State of Wisconsin } ss.	
County of Forest	
I	
Resident witnesses:	
Robert H. Winat	
MichaelGStevens	
•	
T40N R12E	
1 5000	
i i i	
Howert	
<u>s</u> -13	
LAKE	
<del>-</del>	
1 1 2	
Corner monument restored.	

History of original corner establishment: 1858-Alfred Millard, U.S. Government Deputy Surveyor. Set wood post between R12 & 13 E. 9" Sugar Maple BT's N18°E 18 lks. (11.88 ft.) 11" Sugar Maple s30°W 14 lks. (9.24 ft.) 1941-G.L.O. dependent resurvey, found remains of O.B.T. Scribe visible, post not found. 5" Maple S22°30'E 19 lks. (12.54 ft.) 12" Hemlock N51°W 59 lks. (38.94 ft.) 1982-Gary Pisoni (recovered) 13" Maple Description of corner evidence found: S22°30'E (12.78 ft.) 17" Hemlock N51°45'W (38.94 ft.) 1984-North Country Surveyors-R-A found G.L.O. monument set in 1941 resurvey. 6" round concrete monument & 1941 BT's. 12" Sugar Maple S30°E 12.83 ft. 15" Hemlock N55°30'W 38.91 ft. Also believe I have found remains (decayed) S30°W 11.22 ft. Description of monument and accessories I established to perpetuate the original location of this corner. Old BT's brought up to standard. Nail in root crown. New BT signs. Where needed, red band painted on trees. 15 10" Sugar Maple S69°W 15.23 ft. 4" Sugar Maple N27°E 7.92 ft. Sign Post S80°E 1.1 ft. (over) (County Surveyor, Registered Land Surveyor, or other duly authorized official) Office of Register of Deeds, County of Forest .. I hereby certify that the within instrument was filed in this office for record on the 24th at 1:10 o'clock P. (Register of Deeds)

44012132000


1/2-1/2

(e) Describe any material discrepancy between the location of the corner as restored or reestablished and the location of that corner as previously restored or reestablished by distance and direction. Show the discrepancy on the plan view drawing under (d), above. Show the distances between the corner as previously restored or reestablished and (1) the corner as restored or reestablished, and (2) to at least 2 of the witness monuments shown on the drawing in (d), above.

N/A

(f) Was the corner restored through acceptance of (1) an obliterated evidence location, or, (2) a found perpetuated location? N/A

(9kh) Was the corner reestablished through lost corner proportionate methods? If so, show the method, including the directions and distances to other public land survey corners used as evidence or used for proportioning in determining the corner location? N/A

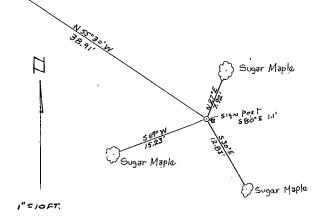

(i) Robert H. Winat RLS 1040
[type or print name; certify that the corner location shown on this record was determined by me or under my direction and control and that this U.S. Public Land Survey Monument Record is correct and complete to the best of my knowledge and belief.

Signatural GNOV. 1984

ROBERT H.
WINAT
S.1040
RHINELANDER,
WIS.
SURNE

= Corner monument restored

on the \_\_\_\_day of \_\_\_\_\_\_19 \_\_\_\_, and was filed in Book,

Township 40 North Range 12 East Section 15 Index No. Page No.

12 East Section 15 Index No. Page No.

40 North

Township.

### CERTIFIED LAND CORNER RESTORATION

State of Wisconsin	
County of Forest ss	is.
I found evidence of the East qu Township 40 North	arter corner of Section 18 , Range 12 East , Fourth Principal Meridian, as described are I established a new monument and accessories as described hereon to persist corner:
Description of original monument	and accessories and subsequent restorations:
Original survey in 1859 Dependent resurvey in 1941 Proportionate position set marked 1/4, S18, S17, 1941 Poplar 6, bears N63E, 23 1/ Poplar 6, bears N82W, 12 1k County trunk "A" south 10.7	iron post, 3 feet long, 2 inch diameter, with brass cap 2 lks. s.
Description of corner evidence for	and:
Monument as described above Aspen stump, scribed bears Aspen stump, scribed bears State Highway 70, south 10.	N63E, 23 1/2 lks. N82W, 12 lks.
Description of menuments arkace Blazed and scribed the foll	essories I established to perpetuate the location of this corner:
Maple 5, bears N75E, 8.66 f Maple 6, bears SlE, 18.06 f Seet steel sign post 0.5 fe	eet
	Resident witnesses
Sec. 18	Dated at Rhinelander Wisconsin, this 10 day of ferre  1974.  Signature Jean F. Resvick Title Land Surveyor
	(County Surveyor, Registered Land Surveyor, or other duly authorized official)
	Surveyors Registration No. S-802 DOCUMENT NUMBER 105822
Corner monument restored	Office of Register of Deeds: County of Forest  I hereby certify that the within instrument was filed in this office for record on the 8th day of August 1974, and was filed in Book No. Corner Page No. 1-5 of County Records.
	Signature Lugene Fitzle my Title
Township 40 North , Rang	e 12 East , Section 18 , Index No. L-5 , Page No.

4401218ZØØØ

— Corner monument restored.

History of original corner establishment:

Surveyed in 1859 by Wm. E. Daugherty. Dependent Resurvey in 1941 by Guy R. Veal. Set Iron post. 3 ft. long. 2 in. diam., 27 in. in the ground, with brass cap marked:

S17 S16

1941

From which: poplar 6" bears  $S27^{\circ}E$ ,  $93\frac{1}{2}$  lks. poplar 7" bears  $S84^{\circ}W$ ,  $90\frac{1}{2}$  lks.

Description of corner evidence found:

Monument marked as described:

Poplar 9", S84°W, 59.45 ft. Poplar stump scribed B.T., S27°E, 61.71 ft.

Description of monument and accessories I established to perpetuate the original location of this corner.

Blazed and scribed the following new bearing trees:

W. pine 6", Sll°E, 62.55 ft. (94.77 lks.) W. pine 7", N55°W, 30.20 ft. (45.76 lks.)

Dated at Rhinelander	Wis., this	16 th	day of	August	, 19 <i>6 3</i> .
Signature fear f Chevid  (County Surveyor, Registered	Title Cada	stral Su	veyor	Registra	tion No. <b>S-802</b>
(County Surveyor, Registered	l Land Surveyor,	or other duly a	authorized offic	cial)	ifer that the within
Office of Register of Deeds, County of instrument was filed in this office for reco	rd on the	4	day of.	november	19 that the within
at 9:00 o'clock A M.  Unna Leterson				87832	
(Register of Deeds)					

#### ...

CERT	FIED LAND CORNER RESTORATION
State of Wisconsin	Ŧ
County of Forest ss.	
I found evidence of the Township 40 North	o hereby certify that on the 8th day of March, 19.67, ast quarter corner of Section 16.  Range 12 East Fourth Principal Meridian, as described I established a new monument and accessories as described hereon to performer:
Description of original monument and Original survey in Set concrete monume	accessories and subsequent restorations: 1859. Dependent resurvey in 1941 by Guy R. Veal. ent, 2 ft. long, 6 ins. diameter, with iron post 22 ins. long, used therein, with brass cap marked:
	Maple 6 ins., N35°W, 47 lks.
Description of corner evidence found:	
Monument found as of Maple 7 ins., bears other bearing tree	described above. 3 N35°W, 31.02 feet. would fall in power line clearing.
Blazed and scribed White birch Power pole, Set lxlı ceda	ries I established to perpetuate the original location of this corner:  the following new bearing trees: 6 ins., bears S80°E, 53.6 ft. or 81.2 lks. number 4012-16E19, bears N29°E, 28.4 ft. or 43 lks. ar post one foot east of monument.  JEAN F. RESVICK RHINELANDER. WIS.  SURMAN
Sec. 16  Su  Of  I1  On  No  Signature  Sign	And the steel of Peeds County of Forest County Surveyor Deeds County of Forest County of February 19.68., and was filed in Book County Of County Records.  Title Cadastral Surveyor County of Forest County County Records County Records.  The Page No. Of County Records Co
Township 40 NOT 611 , Range	W

RG-5880-5 (7/15/54) N. C. WILLER CO., MINNAUEEE 448843	
CERTIFIED LAND CORNER RESTORATION	
State of Wisconsin County of Forest ss.	
I Jean F. Resvick, do hereby certify that on the 8th day of March 19. found evidence of the North meander corner of between Sections 15. & 19. North Principal Meridian, as descreteon; and that from this evidence I established a new monument and accessories as described hereon to be tuate the original location of this corner:	6 ribed
Description of original monument and accessories and subsequent restorations:  Original survey in 1959. Dependent resurvey in 1941 by Guy R. Veal.  Set concrete monument, 2 ft. long, 6 ins., diameter with brass cap marked:	
from which: White birch 9 ins., bears N58°30'E, 24 lks. Norway pine 10 ins., bears Sh6°45'E, 41 lks. Norway pine 6 ins., bears N9°W, 85 lks.	
Description of corner evidence found:  Monument found as described above.  Morway pine 13 ins., bears N9030tW, 56.1 ft.  Mite birch 9 ins., bears N58030!E, 15.8 ft.  Morway pine 15 ins., bears S46045tE, 27.0 ft.	

JEAN F RESVICK RHINELANDER,

Description of monumentum accessories I established to perpetuate the original location of this corner:

Place U. S. Forest Service bearing tree shields on bearing trees.

Set 4x4 cedar post 1 ft. east of monument.

Township...

# 44¢1216180¢

	A CONTRACT OF THE PROPERTY OF
Section 16	
	Resident witnesses
	Dated at Rhinelander, Wisconsin, this 7th day of March
	19 67 Signature Jean F. Resvick Title Cadastral Surveyor
M.C	Signature Jean F. Resvick Title Cadastral Surveyor (County Surveyor, Registered Land Surveyor, or other duly authorized official)
	Surveyors Registration No. S-802 DOC.NO. 94217
Franklin Lake	Office of Register of Deeds County of Forest ,
\	I hereby certify that the within instrument was filed in this office for record
Corner monument restored	on the 27th day of February 19 68, and was filed in Book
	NoI Page No
	Signature Stategraf Title Register Of Deeds
lo North	e 12 East , Section 16 , Index No. L.M-13 , Page No.
Cownship 40 Moroti , Range	e 12 100 , Section 10 , Index No. 1, 11 , Page No.

R9-7150-11 (9/1/86) H. C. MILLER CO., MILWAUKEE 458824
CERTIFIED LAND CORNER RESTORATION
State of Wisconsin
County of Forest ss.
I Jean F. Resvick do hereby certify that on the 4th day of April , 19.73 I found evidence of the East quarter corner of Section 15.  Township 40 North , Range 12 East , Fourth Principal Meridian, as described hereon; and that from this evidence I established a new monument and accessories as described hereon to perpetuate the original location of this corner:
Description of original monument and accessories and subsequent restorations:
Dependent resurvey by Guy R. Veal in 1941  The point for the 1/4 section corner as determined from an original bearing tree.  At the point for the 1/4 corner set an iron post, 3 feet long 2 inch diameter 27 inches in the ground, with brass cap marked, 1/4, S15, S14, 1941  Hemlock 10 inch diameter N77°45E 184 1ks.  Hemlock 7 inch diameter S0°45'W 188 1ks.
Description of corner evidence found:
Monument found as described above.
From which a Hemlock 16" N78E 122.44 feet Hemlock snag 8" S1 <sup>O</sup> W 124.08 feet scribing visible
Description of monument and accessories I established to perpetuate the original location of this corner:  Blazed and scribed the following new bearing tree Maple 8" N70V 41.9 Iks. Set steel sign post and sign Painted bearing trees
JEAN F. RESVICK RHINELANDER, WIS.  Resident witnesses.  SURVENTED  Resident witnesses.
Dated at Rhinelander Wisconsin, this 31 st day of July
19.73. Jan & Rewick
Sec. 15 Signature Jean F. Resvick Title Land Surveyor (County Surveyor, Registered Land Surveyor, or other duly authorized official) DOCUMENT NUMBER 104451
Office of Register of Deeds County of Forest  I hereby certify that the within instrument was filed in this office for record
on the 13th day of November 19 73, and was filed in Book Corner Restorations No. 1-17 of County Records.
Signature Cufunt Title Register of Deeds  Township 40 North , Range 12 East Section 15 , Index No. L-17, Page No.

Document No. 108567

REGISTER'S OFFICE } Forest County, Wig. Received for record this 14 th day of Jentines

N-1 10-3 11-4 P-3 02 6-3 R-/ R-3

A. D., 19 76 at 10:15 o'clock A M. and

recorded in Vol.

Sheet 1 of 5


OF SURVEY

GOVERNMENT LAND

Refisite of Deeds

Being SE 1/4, NI/2 NE 1/4, E1/2 NW 1/4, W1/2 SW 1/4, SE 1/4 SW 1/4 and SE 1/4 NE 1/4 Section 19, Township 40 North, Range 12 East, Fourth Principal Meridian FOREST COUNTY, WISCONSIN



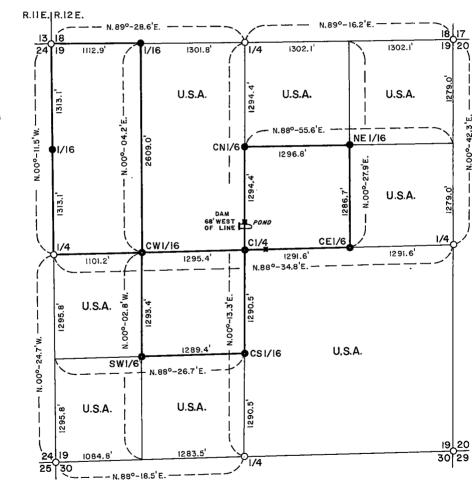

LEGEND

- 0 Bureau of Land Management monument.
- Corner position marked by a 2 inch inside diameter by 3 foot long concrete filled galvanized iron pipe capped with a 3 inch diameter brass tablet stamped to identify corner.
- Boundary line post.
- U.S.A. U.S. Government land.

Marked boundary of U.S. Government land. 446/2/90020

## SURVEY NOTES

This survey was made by the U. S. Department of Agriculture, Forest Service.

The original Government subdivision survey of township 40 north, range 12 east, fourth principal meridian was made in 1859. In 1926 the Bureau of Land Management made a dependent resurvey of the west range line. In 1941 the Bureau of Land Management made a dependent resurvey of the township. The corners recovered from these surveys were used as the control for this subdivision survey of section 19.

The U. S. Government acquired title to the plat identified Government lands within section 19 during the period of 1931-41.

The corner positions recovered and established by this survey are monumented by the monument described in the map legend.

The bearings between corner positions are true bearings as determined by reference to a Polaris observation. The relative accuracy of the traverse control for corner establishment and for building and construction sites was one part in 3,000.

The field survey notes and a copy of the plat of survey are on file in the Forest Supervisor's Office at Rhinelander, Wisconsin.

## Corners Recovered

1. Section Corner to Sections 19-24-25-30 T. 40 N., Rs. 11-12 E.

Corner position, now in beaver pond, restored by 1926 dependent resurvey. Corner references:

Spruce 6" S. 35° 45' W. 26 links Spruce 6" S. 88° 00' W. 57 links Tamarack 6" N. 80° 00' W. 96 links Sign Post at monument

2. Quarter Corner to Sections 19-24 T. 40 N., Rs. 11-12 E.

Corner position restored by 1926 dependent resurvey.

Corner references:

N. 5° W. Hemlock 22" 13.7 feet Sign Post West-0.5 foot 10.0 feet Hemlock 22" s. 17° E.

3. Section Corner to Sections 13-18-19-24 T. 20 N. Rs. 11-12 E.

Corner position restored by 1926 dependent resurvey.

Corner references:

S. 78° 45' E. Hemlock 16" 60.7 feet N. 24° W. Hemlock 13" 52.8 feet

## 4. Quarter Corner to Sections 18-19

Corner position restored by 1941 dependent resurvey.

0	r	n	е	ŗ		r	е	Ι	е	r	е	n	с	е	s	:	
				m	_	•	_	_			7	11					

Balsam 7"	N. 28° W.	10.3 feet
Spruce 6"	S. 77° E.	13.2 feet
Sign Post	S. W	1.0 feet

# 5. Section Corner to Sections 17-18-19-20

Corner position restored by 1941 dependent resurvey.

Corner references:

Black Spruce	6" N.	10° W.	24.5	feet
White Spruce	12" S.	75° E.	23.8	feet
White Spruce	15" S.	8° - E.	4.3	feet
White Spruce	10" N.	33° W.	37.4	feet

# 6. Quarter Corner to Sections 19-20

Corner position restored by 1941 dependent resurvey. Corner references: Sign Post N. E. 1.0 feet

7. Section Corner to Sections 19-20-29-30

Corner position restored by 1941 dependent resurvey.

# 8. Quarter Corner to Sections 19-30

Maple 10" S. 34° 15' W. 5.6 feet N. 34° W. Maple 9" 24.6 feet

## Corners Established

## 1. Center Quarter Corner

Corner position established at the intersection of straight lines between opposing quarter corners on the perimeter of section 19. Corner references:

Maple 9"	N. 6° E.	35.9 feet
Maple 11"	N. 88° W.	21.8 feet
Sign Post	N. W.	0.5 foot
Line Post	N. 00° 13.3' E.	323.1 feet
Center dam	N. 12° 08' W.	316.0 feet
Line Post	N. 88° 34.8' E.	260.9 feet
Well	N. 87°39'E.	226.4 feet
S. W. Corner Cabin (20.4' X 36.3')	N. 86° 49' E.	212.7 feet
Stream	s. 88° 34.8' W.	424.5 feet

## 2. West Sixteenth Corner to Sections 18-19

Corner position established at proportionate measurement and on line between the northwest corner and the north quarter corner of section 19.

Corner references:

Maple 7" N. 55° W. 20.4 feet
Maple 7" S. 43° E. 72.1 feet
Sign Post N. E. 0.5 foot

# 3. North Sixteenth Corner to Sections 19-24 Rs. 11-12 E.

Corner position established at midpoint and on line between the northwest corner and the west quarter of section 19.

Corner references:

Maple 8" N. 70° E. 16.1 feet
Maple 6" S. 84° W. 15.8 feet
Sign Post S. W. 1.0 feet

## 4. Center North Sixteenth Corner

Corner position established at midpoint and on line between the north quarter corner and the center quarter corner.

Corner references:

 Spruce 9"
 N. 14° W.
 34.0 feet

 Spruce 7"
 S. 3° W.
 31.3 feet

 Sign Post
 N. W.
 0.5 foot

## 5. Center East Sixteenth Corner

Corner position established at midpoint and on line between the east quarter corner and the center quarter corner.

Corner references: Yellow birch 5"

Yellow birch 5" S. 39° E. 14.8 feet White birch 7" S. 40° W. 15.1 feet Sign Post S. E. 0.5 foot

# 6. Center South Sixteenth Corner

Corner position established at midpoint and on line between the south quarter corner and the center quarter corner.

Corner references:

 Balsam 8"
 S. 75° E.
 29.4 feet

 Balsam 9"
 N. 54° W.
 19.9 feet

 Sign Post
 S. E.
 0.5 foot

## 7. Center West Sixteenth Corner

Corner position established at proportionate measurement and on line between the west quarter corner and the center quarter corner. Corner references:

er references:		
Maple 12"	N. 32° E.	30.0 feet
Maple 6"	S. 9° E.	17.2 feet
Maple 5"	N. 56° W.	31.1 feet
Sign Post	s.w.	0.5 foot

## 8. Northeast Sixteenth Corner

Corner position established at the intersection of straight lines between opposing sixteenth corners on the perimeter of the northeast quarter of section 19.

Corner references:

Spruce 11"	N. 37° W.	11.5 feet
Spruce 10"	S. 72° W.	19.5 feet
Sign post	N. E.	0.5 foot

## 9. Southwest Sixteenth Corner

Corner position established at the intersection of straight lines between opposing sixteenth corners on the perimeter of the southwest quarter of section 19.

Corner references:

Cedar 14"	S. 42° E.	19.0 feet
Maple 20"	N. 31° W.	16.0 feet
Sign Post	S. W	0.5 foot
Stream	N. 88° 26.7' E.	393.5 feet

# SURVEYOR'S AFFIDAVIT

State of Wisconsin)ss County of Forest )

I, Jean F. Resvick, land surveyor, U. S. Forest Service, and a registered land surveyor in the State of Wisconsin, hereby certify that I have surveyed and subdivided section 19, township 40 north, range 12 east, fourth principal meridian, Forest County, Wisconsin.

The plat map and survey notes herewith are a correct representation of the land surveyed and subdivided and of the building and construction sites. I have surveyed and subdivided said section 19 in accordance with the rules for the survey of the public lands and the statutes of the State of Wisconsin. JEAN F.
RESVICK
RHINELANDER
WIS.

Land Surveyor, U. S. Forest Service L. S. State of Wisconsin Certificate S-802

Date of Survey:

# CERTIFIED LAND CORNER RESTORATION

State of Wisconsin ss.
County of Forest
I Jean F. Resvick , do hereby certify that on the 1st day of June , 19 73 , I found evidence of the North quarter corner of Section 19.  Township 40 North , Range 12 East , Fourth Principal Meridian, as described hereon; and that from this evidence I established a new Engagement accessories as described hereon to perpetuate the principal Meridian of this corner:
Description of original monument and accessories and subsequent restorations:
Surveyed in 1859 by William E. Daugherty Dependent Resurvey in 1941 by Guy R. Veal At proportionate distance set an iron post, 3 feet long, 2 inches in diameter, with brass cap marked 1/4, S18, S19, 1941 Poplar 6, bears S62W, 32 1ks. Yellow Birch 22, bears N26W, 86 1ks.
Description of corner evidence found:
Monument as described above Yellow Birch stump bears N26W, 86 1ks.
Description of INCHMENNAME accessories I established to perpetuate the location of this corner:  Blazed and scribed the following new bearing trees: Balsam 7, N28W, 10.32 feet Spruce 6, S77E, 13.23 feet Set galvanized sign post 1 foot southwest of monument
Supplied to State of the State
Resident witnesses  Dated at Rhinelander Wisconsta, this 200 County Resolution  Sec. 19  Signature Jean I. Resvick Title and Surveyor, or other ditability of County Surveyor, Registered Land Surveyor, or other ditability of County Surveyors Registration No. S-802  Office of Register of Deeds  County of Forest  I hereby certify that the within instrument was filed in this office for record on the 13th day of November 19.72, and was filed in Book No.
44012180020

# CERTIFIED LAND CORNER RESTORATION

day of November Section 20

DOCUMENT NUMBER

\_\_\_\_\_19\_72\_\_, and was filed in Book

.....County of Forest

N-5 of County Records.

(County Surveyor, Registered Land Surveyor, or other duly authorized official)

I hereby certify that the within instrument was filed in this office for record

Section 20 , Index No. N-5

State of Wisconsin County of Forest

I Jean F. Resvick

Jean F. Resvick do hereby certify that on the 3rd November 19
I found evidence of the Northwest Section corner of Section 20
Township. 40 North , Range 12 East , Fourth Principal Meridian, as described
hereon; and that from this evidence I established a new monument and accessories as described hereon to per
petuate the original location of this corner:
Description of original monument and accessories and subsequent restorations:  Dependent Resurvey by Guy R. Veal in 1941. Proportionate location.
Set concrete monument, 2 feet long, 6 inches in diameter, with iron post
1 inch in diameter, 22 inches long encased therein, with brass cap stamper
T40N, R12E, S18, S17, S19, S20 1941
Poplar 8, N41E, 31 lks.
Poplar 6, S32E, 24 lks.
Poplar 5, S42 <sup>O</sup> 30'W, 35 lks.
Poplar 7, N66 <sup>o</sup> 30'W, 14 lks.
<del>-</del>
Description of corner evidence found:
6 inch diameter concrete monument with brass cap stamped as above.
Aspen stump 8, N41E, 20.5 feet
Aspen stump 6, S32E, 15.8 feet
Aspen stump 6, S42W, 23.1 feet
Aspen stump 7, N66W, 9.2 feet
Description of manuscription and accessories I established to perpetuate the exiginal location of this corner:
Blazed and scribed the following new bearing trees.
Black Spruce 6, N10W, 24.48 feet
White Spruce 12, S75E, 23.79 feet
White Spruce 15, S 8E, 4.33 feet
White Spruce 10, N33W, 37.43 feet
18 M
Set steel sign post near monument.
という RESVICK に対象
RHINELANDER PL
4401Z1800000 ********************************
4-19 (2 (0 9099
SUR again
Resident witnesses
Dated at Rhinelander Wisconsin, this 22 and day of Nov.
19.71
Jean F. Resvick Till. Land Surveyor
Sec. 20 Signature Jean F. Resvick Title Land Surveyor

Surveyors Registration No. S-802

on the 20th day of January

Office of....

Signature....

Range

12 East

= Corner monument restored

40 North

Township.

Register of Deeds

O = Corner monument restored.

4401217084

History of original corner establishment:

Surveyed in 1859 by Wm. E. Daugherty. Dependent Resurvey in 1911 by Guy R. Veal. Set concrete monument, 2 ft. long, 6 in. diam., with iron post, 22 in. long, 1 in. diam .. encased therein with brass cap marked:

> TLON:R12E S17 S16 S20 S21 1941

From which: W. birch 7", bears, N62°E, 33½ 1ks. W. birch 6", bears, \$68030 E, 512 1ks.

W. birch 8", bears, \$500W. 30 lks. W. birch 6", bears, N56°W, 36 lks.

Description of corner evidence found:

Monument as described:

W. birch stump, cut by Power Co., scribe showing, N69030 E, 21.90 ft. W. birch stump, cut by Power Co., scribe showing, \$69030 E, 35,50 ft.

W. birch, 12", S50°W, 20.25 ft.

W. birch, 8", N56°W, 23.35 ft.

Description of monument and accessories I established to perpetuate the original location of this corner. Blazed and scribed the following new bearing trees:

Balsam 5", S57°E, 54.40 ft. (82.42 lks.) Spruce 5", S7W, 30.30 ft. (45.91 1ks.) Spruce 9", N72030 W, 24.20 ft. (36.67 lks.) W. birch 7", N28°E, 40.75 ft. (61.74 lks.) Power pole number 4012-16-11, S50°E, 28.85 ft. (43.71 lks.)

Dated at Rhinelander			
Signature fran f. Resorich (County Surveyor, Registered	Title Cadastral	Surveyor	Registration No. S-802
(County Surveyor, Registered	d Land Surveyor, or other	duly authorized official	)
Office of Register of Deeds, County of instrument was filed in this office for reco at	-Forest	,	, I hereby certify that the within
instrument was filed in this office for reco	rd on the4	day of	Movember , 1963
at 9:00 o'clock A. M.			<b>'</b>
anna Ceterso.	n	87	829
(Register of Deeds)			

State of Wisconsin

## CERTIFIED LAND CORNER RESTORATION

Index No. N - 13

History of original corner establishment:

Survey 1859 by Wm. E. Daugherty. Dependent Resurvey in 1941 by Guy R. Veal From remains of original bearing trees set concrete monument, 2 ft. long, 6 in. diam. with iron post, 22 in. long 1 in. diam., encased therein with brass cap marked:

Thon R12E

S16 S15

S21 S22

19h1

From which:
Hemlock 10", bears, N3045'E, 108 lks.
Hemlock 10", bears, S19015'E, 21 lks.
Hemlock 15", bears, S25015'W, 83 lks.
Maple 10", bears, N240W, 27½ lks.

Description of corner evidence found:

Monument found as described:

Hemlock 18" snag, N3°L5'E, 71.6 ft.

Hemlock 11" snag, S19°E, 11.2 ft.

Hemlock 21", S25°15'W, 55.00 ft.

Maple 17", N24°W, 18.00 ft.

Description of monument and accessories I established to perpetuate the original location of this corner.

Blazed and scribed the following new bearing trees:

Maple 8", S75°E, 17.50 ft. (26.52)

Dated at Rhinelander	_, Wis., this	day of	August	, 19 <u>63</u> .
Signature flam F Resource (County Surveyor, Register	Title Cadastra,	L Surveyor duly authorized o	Registration I	No. <b>S-802</b>
Office of Register of Deeds, County of instrument was filed in this office for rec	Forest	4 day (	, I hereby certify the	at the within 10 63
at 9:00 o'clock A M.	ord on the	day C	87831	
(Register of Deed	s)			
_	-			


Describe any material discrepancy between the location of the corner as restored or reestablished and the location of that corner as previously restored or reestablished by distance and direction. Show the discrepancy on the plan view drawing under (d), above. Show the distances between the corner as previously restored or reestablished and (1) the corner as restored or reestablished, and (2) to at least 2 of the witness monuments shown on the drawing in (d), above. (e)

See drawing below.

was the corner restored through acceptance of (1) an obliterated evidence location, or, (2) a found perpetuated location?

Restored through acceptance of a found perpetuated location.

(gkh) Was the corner reestablished through lost corner proportionate methods? If so, show the method, including the directions and distances to other public land survey corners used as evidence or used for proportioning in determining the corner location?

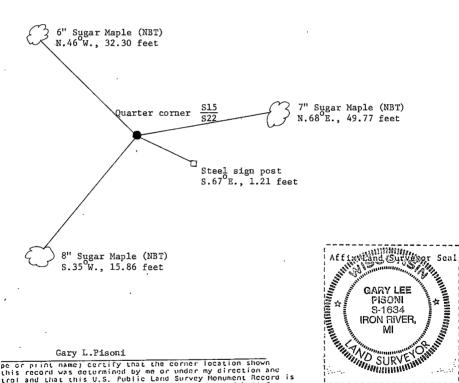

Gary L.Pisoni

Itype or print name) certify that the corner location shown on this record was determined by me or under my direction and control and that this U.S. Public Land Survey Monument Record is correct and complete to the best of my knowledge and belief.

11-2-87

Signature

District Rang

# CERTIFIED LAND CORNER RESTORATION

	•	
State of Wisconsin ss		
County of Forest .	•	
I found evidence of the Sou Township 40 North	, do hereby certify that on the <u>4th</u> <u>day of February theast Section</u> <u>corner of Section 15</u> , Range <u>12 East</u> , Fourth Principal Meridian, a ce I established a new monument and accessories as described here s corner:	s described
Description of original monument	and accessories and subsequent restorations:	
24 ins. long. 18 ins. in th	al evidence, set a concrete monument, 6 ins. diameter, ne ground with a brass cap stamped:  S23, 1941 From which the following bear:  30'E, 37.5 lks.  15'E, 43.5 lks.  33.0 lks.	
Description of corner evidence for	ınd:	
Monument as described above Yellow Birch, 12 ins., N76 Yellow Birch, 6 ins., S450 W. Pine, 8 ins., S660W, 33 Yellow Birch, 8 ins., N840	PE, 37.5 lks. E, 43.5 lks. lks.	
Description of monument and acc	essories I established to perpetuate the location of this corner:	
Blazed and scribed the fol Hemlock, 8 ins., N88°W, 24 Set a steel sign post, nor	ANGUE PAREN	O PARTITURE OF THE PART
	Resident witnesses	
Sec. 15	Dated at Three Lakes Wisconsin, this Ltd day of G. 19.76.  Signature William B. Cochrane Title Survey Techn (County Surveyor, Registered Land Surveyor, or other duly authorized	ician official)
	Surveyors Registration No. S-11:07 DOCUMENT NUM	0961
	Office of Register of Deeds County of Forest  I hereby certify that the within instrument was filed in this office	e for record
Corner monument restored	on the 2nd day of July 19.70, and was fi	led in Book
	Signature Linguist States of Register of	Deeds
Township 40 North , Range	e 12 East , Section 15 , Index No. N-17 , Page N	0
4	4012150000	

40 12 14BBB

= Corner monument restored.

State of Wisconsin

I Robert H. Winat do hereby

certify that on the \_\_\_\_\_day

County of Forest

History of original corner establishment: 1859-Wm. Daugherty, Deputy Surveyor, set wood post. 8" Tamarack S35°W 13 1ks. (8.58 ft.) 9" Tamarack N10°E 12 1ks. (7.92 ft.) 1941-G.L.O., corner set at proportionate distance. No remaining evidence of post or BT's. New BT's as follows: 10" Spruce N76°15'E 41 lks. (27.06 ft.) 12" Cedar 70 lks. (46.20 ft.) s87°E \$68°15'W 84 lks. (55.44 ft.) 6" Cedar . Description of corner evidence found:

Set a 2"x36" brass capped iron pipe 27" in the ground, stamped to identify corner. 1984-North Country Surveyors found 2" brass capped iron pipe. Stamped to identify corner. 5" Cedar (in very poor condition) S63°30'W 55.58 ft. S10°E 56.73 ft. 16" Cedar 18" Spruce s73°W 53.18 ft. Description of monument and accessories I established to perpetuate the original location of this corner. New bearing trees 6" Balsam Fir N53°30'W 16.51 ft. N19°E 33.25 ft. 12" Ash 1.7 ft. Sign Post Steel Easterly All BT's were brought up to standard by placing a nail in side, placing new BT signs on side facing corner and away-painted red ring on trees. (OVER) Wis this 6 day of NOVEMBER 1984 Title L.S. Registration No. 1060 (County Surveyor, Registrated Land Surveyor, or other duly authorized official) Office of Register of Deeds, County of Forest , I hereby certify that the within instrument was filed in this office for record on the 24th , lay of July , 19.85 instrument was filed in this office for record on the... at 1:10 o'clock P. M.


(Register of Deeds)

Stock-Mo.

(e) Describe any material discrepancy between the location of the corner as restored or reestablished and the location of that corner as previously restored or reestablished by distance and direction. Show the discrepancy on the plan view drawing under (d), above. Show the distances between the corner as previously restored or reestablished and (1) the corner as restored or reestablished, and (2) to at least 2 of the vitness monuments shown on the drawing in (d), above.

Was the corner restored through acceptance of (1) an obliterated evidence location, or, (2) a found perpetuated location? 2

(gkh) Was the corner reestablished through lost corner proportionate methods? If so, show the method, including the directions and distances to other public land survey corners used as evidence or used for proportioning in determining the corner location?

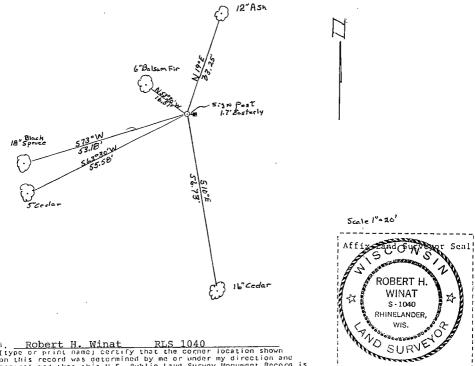

٠,,...

i, Robert H. Winat RIS 1040 (type or print name) certify that the corner location shown on this record was determined by me or under my direction and control and that this U.S. Public Land Survey Monument Record is correct and complete to the best of my knowledge and belief.

84 Date Signatur

U.S., I
State of Wisconsin } ss.
County of Forest
IRobert H. Winat, do hereby certify that on the
Resident witnesses:
Robert H. Winat
Michael G. Stevens
•
T40N R12E
= Corner monument restored.

History of original corner establishment: 1859-Wm. Daugherty, Deputy Surveyor, set wood post. 10" Birch 14 lks. (9.24 ft.) BT's S33°E S18°W 9 1ks. (5.94 ft.) 7" Fir 1941-Guy R. Veal Dependent Resurvey 2"x36" iron post 27" in ground, proportionate distance. There is no remaining evidence of post or trees. 5" W. Birch S16°30'W 6 1ks. (3.96 ft.) New BT's 6" W. Birch N67°W 42 lks. (27.72 ft.) Description of corner evidence found: 1984-R. H. Winat (North Country Surveyors) found 2" iron pipe with brass cap stamped to identify corner. 8" W. Birch S17°W 3.80 ft. 9" Balsam (over grown) S51°E 12.28 ft.(origin unknown). No evidence of 6" White Birch N67°W.27.72'. Description of monument and accessories I established to perpetuate the original location of this corner. Placed nail in BT's at root crown to bring to std. Blazed, painted and scribed painted red ring around trees. New Corner references 37.55 ft. 8" Maple N27°W 8" W. Birch N19°E 24.69 ft. Steel Sign Post East 2.00 ft. (SENO) (County Surveyor, Registered Land Surveyor, or other duly authorized official) Signature.. Office of Register of Deeds, County of Forest ... I hereby certify that the within instrument was filed in this office for record on the 24th ... day of July ... 19.85 at 1:10 o'clock P. (Register of Deeds)


(e) Describe any material discrepancy between the location of the corner as restored or reestablished and the location of that corner as previously restored or reestablished by distance and direction. Show the discrepancy on the plan view drawing under (d), above. Show the distances between the corner as previously restored or reestablished and (1) the corner as restored or reestablished, and (2) to at least 2 of the vitness monuments shown on the drawing in (d), above.

N/A

(f) Was the corner restored through acceptance of (1) an obliterated evidence location, or, (2) a found perpetuated location? (2)

(gkh) Was the corner reestablished through lost corner proportionate methods? If so, show the method, including the directions and distances to other public land survey corners used as evidence or used for proportioning in determining the corner location?

8'Maple N/A

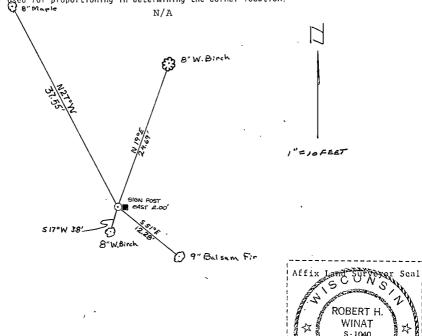

RHINELANDER, WIS.

(i) 1. Robert H. Winat R.L.S 1040 (type or print name; certify that the corner location shown on this record was determined by me or under my direction and control and that this U.S. Public Land Survey Monument Record is correct and complete to the best of my knowledge and belief.

Signature Bate A. Winds GNOV. 84

40 North

Township.

.....Title.....

Section 13 Index No. N-23 , Page No.

# PUBLIC LAND SURVEY MONUMENT RECORD

			0.5.
State	of Wisc	onsin	ss.
County of	Forest		. } 55.
I Robert certify that of S.E.P. evidence of to corner of Township 12 East as described I established as described location of the second seco	on the	, 19 <b>8</b> . East Sect 13, Nurth Principal that from tonument and	day , I found, I found
Resident wit	nesses:		
70 al march ##	*******		
Robert H.	winat		······
Michael G	Steven	3	
	E4037	D1 0m	
	<u>T40N</u> _	i RIZE	~ 7
		1 1	
i i		1 1	
		<b>-</b> -	
i		I I	
1 '		1	
	0	[    13 1	,
	5	¦ <del>1</del> 3— — †	
i 'i		!!!	
+			
		:÷	·
1		i – – f I – I	
1 1		i	
1		i f 	

= Corner monument restored.

History of original corner establishment:  1857-Original Survey on town line (R12 & 13), Alfred Millard, U.S. Government Deputy Surveyor. Set wood post.  BT's 11" Fir N50°E 4 lks. (2.64 ft.)  12" Sugar Maple N30°W 14 lks. (9.24 ft.)  12" Maple 518°W 40 lks. (26.40 ft.)  18" Sugar Maple S30°W 27 lks. (17.82 ft.)  1941-G.L.O. Dependant Resurvey-Post not found. Found O.B.T. blaze by base and old stump hole.  BT's 12" Hemlock N30°E 44 lks. (29.04 ft.)  DEMARKANGE MARKET HEMLOCK N30°E 44 lks. (29.04 ft.)  DEMARKANGE MARKET HEMLOCK N67°30'W 34 lks. (33.66 ft.)  16" Hemlock S49°W 75 lks. (49.50 ft.)  16" Hemlock N67°30'W 34 lks. (22.44 ft.)  1965-Jean F. Resvick-Corner form on file-Doc. No. 90029  1962-Pisoni- Hemlock (dead) N30°E 29.52 ft.  8" Maple S73°E 2.15 ft.  11" Maple S24°W 31.65 ft.  Hemlock (dead) S49°W 49.50 ft.  Wood post SE 1.0 ft.  New BT's by Pisoni: 14" Hemlock N62°E 48.43 ft.  8" Maple S73°E 2.9 ft.  10.95 ft.  DEMARKANGE MARKET HEMLOCK N62°E 48.43 ft.  8" Maple 10.95 ft.  NO "WOOD FOR THE POST OF THE
14 Heilitock No.3-E 48.29 It.
11" Sugar Maple S23°30'W 31.38 ft. 16" Hemlock(rampike) S51°30'W 49.98 ft. scribing visible
8" Sugar Maple N71°W 10.94 ft.
13" Hemlock N69W 17.58 ft. No painted on tree
4" x 4" wood post S50°E 1.1 ft.
2" iron pipe with brass cap stamped to identify corner (OVER)
Continued on back side  Dated at EASLE ZUEE, Wis., this day of November, 1984
Signature County Surveyor, Registered Land Surveyor, exother duly authorized official)
Office of Register of Deeds, County of Forest , I hereby certify that the within instrument was filed in this office for record on the 24th day of July , 1985
instrument was filed in this office for record on the 24th day of July 185
at. 1:10.0'clock
Paul Aschenbrenner
(Register of Deeds)
ByDeputy

128461

DOCUMENT NUMBER

(e) Describe any material discrepancy between the location of the corner as restored or reestablished and the location of that corner as previously restored or reestablished by distance and direction. Show the discrepancy on the plan view drawing under (d), above. Show the distances between the corner as previously restored or reestablished and (1) the corner as restored or reestablished, and (2) to at least 2 of the vitness monuments shown on the drawing in (d), above.

N/A

Continued from front page:


Description of monument and accessories I established to perpetuate the original location of this corner.

7" Sugar Maple S26°E 8.38 ft. New BT's N40°E 8" Sugar Maple 4.42 ft. (1941 BT tag partially 4" wood sign post S50°E 1.10 ft. consumed by tree)

Was the corner restored through acceptance of (1) an obligerated evidence location, or, (2) a found perpetuated location?

(2)

(gkh) Was the corner reestablished through lost corner proportionate methods? If so, show the method, including the directions and distances to other public land survey corners used as evidence or used for proportioning in determining the corner location? N/A

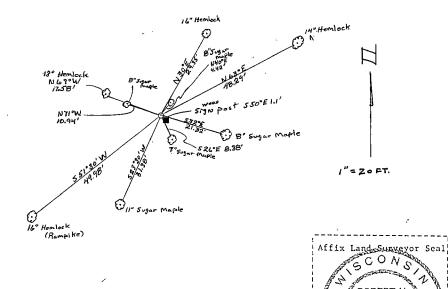

t. Robert H. Winat R.L.S. 1040
(type or print name) certify that the corner location shown on this record was determined by me or under my direction and control and that this U.S. Public Land Survey Monument Record is correct and complete to the best of my knowledge and belief. R.L.S. 1040

> 6 NOV. 1984 Date:

Sent H. Wa Signature

ROBERT H. WINAT

S-1040 RHINELANDER, WIS.

SURVE

BANCO SO!

公员

於

70

	R9-5680-5 (7/15/64) H. C. WILLER CO., WILMAUREE A46843
CE	RTIFIED LAND CORNER RESTORATION
State of Wisconsin  County of Forest	s
I found evidence of the Northe Township 40 North	day of June 19 64  ast Section corner of Section 24  Range 12 East Fourth Principal Meridian, as described a new monument and accessories as described hereon to per is corner:
Surveyed in 1858 Dependent resurvey in 1943 Set iron post, 3 ft. long, Sections 13, 18, 19 and 24 S19, 1941, from which A maple stump, 20 ins A hemlock, 12 ins. di A hemlock, 16 ins. di	and accessories and subsequent restorations:  1. by Guy R. Veal.  2. ins. diameter, 27 ins. in the ground, for corner of 4 with brass cap mkd. ThON, Rl2E, Rl3E, Sl3, Sl8, S24,  3. diam., bears S 53°E, 27 lks. dist.  1. lam., bears N 30°E, hh lks. dist.  1. lam., bears S 64° 15' E, 51 lks. dist.  1. lam., bears S 19° W, 75 lks. dist.  1. lam., bears N 67° 30' W, 3h lks. dist.  1. lam., bears N 67° 30' W, 3h lks. dist.  1. lam.
A hemlock, 17 ins. di A hemlock, fallen, be	Lam., dead, scribing readable, bears S 64° 15' E, 33.18 ft.
Blazed and scribed the fol A sugar, 5 ins. diam.	essories I established to perpetuate the original location of this corner:  Llowing new bearing trees  , bears S 73° 15' E, 21.15 ft or 32.0 lks. dist.  , bears S 24° W, 31.65 ft. or 48.0 lks. dist.
4481Z13888B	REGISTER'S OFFICE Forest County, Wis. Support of the second of the secon
Section 214  Section 214	Signature Jean F. Resvick Title Cadastral Surveyor (County Surveyor, Registered Land Surveyor, or other duly authorized official)  Surveyors Registration No. S-802  Office of County of Lereby certify that the within instrument was filed in this office for record on the day of 19 and was filed in Bool No. Page No. of County Records.

Signature.....

Township 40 North , Range 12 East , Section 24 , Index No. N-25 , Page No.


...Title...

CERTIFIED LAND CORNER RESTORATION
State of Wisconsin  County of Forest ss.
I Jean F. Resvick , do hereby certify that on the 30th day of September , 19 74, I found evidence of the west quarter
Description of original monument and accessories and subsequent restorations:
Survey in 1857 by Alfred Millard Dependent Resurvey in 1926 by Guy R. Veal Set iron post 3 feet long, 2 inches diameter with brass cap marked: \( \frac{1}{4}\), S24, S19, 1926 Hemlock 16, S16°45'E, 15 lks Hemlock 18, N40°00'W, 31 lks
Description of corner evidence found:  Monument as described above Hemlock 22, S17°E, 10.5 feet Hemlock stump 20, N40W, 20.5 feet
Description of manumentanck accessories I established to perpetuate the location of this corner:  Blazed and scribed new bearing tree  Hemlock 22, N5W, 13.73 feet  Set steel sign post 0.5 feet west of monument  JEAN F.  RESVICK RHINGA DER. WIS.
Resident witnesses  Dated at Rhinelander Wisconsin, this day of Merch  1975.  Signature Jean F. Resvick Title Land Surveyor (County Surveyor, Registered Land Surveyor, or other duly authorized official)  Surveyors Registration No. S-802 Document Number 10687  Office of Register of Deeds County of Forest I hereby certify that the within instrument was filed in this office for record on the 31st day of Merch 1975, and was filed in Book No-restorations Page No. P-1 of County Records.  Signature Landsurveyor  Register of Deeds  Signature Register of Deeds  Signature Register of Deeds  Register of Deeds
Township 40 North, Range 12 East, Section 19, Index No. P-1, Page No.

# PLAT OF SURVEY U. S. Government Land

Being lots 1, 3, 4, 5, and 9; SEI/4NEI/4; and parts of lots 6 and 7 all in Section 21.

Township 40 North, Range 12 East, Fourth Principal Meridian COUNTY OF FOREST, STATE OF WISCONSIN

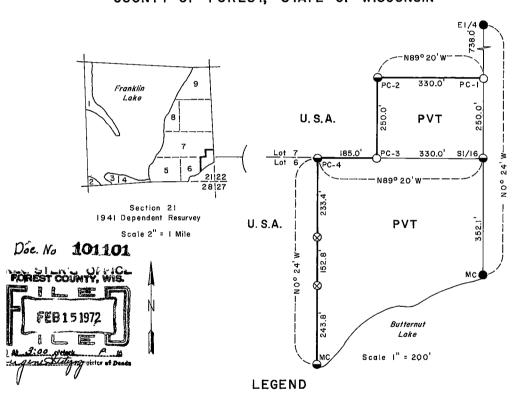

- 1941 General Land Office Dependent Resurvey Monument
- Corner position marked by a 2 inch inside diameter by 5 foot long concrete filled galvanized iron pipe capped with a 3 inch diameter brass tablet stamped to identify corner.
- O Corner position in road marked by a 6 inch diameter by 30 inch long concrete post with top inserted brass tablet stamped to identify corner. Top of post below road surface.
- ⊗ Boundary line sign post.
- --- Boundary U.S. Government Land

MC Meander Corner

440/2212000

# PLAT OF SURVEY

# U.S. Government Land

Being lots 1, 3, 4, 5, and 9; SE1/4NE1/4; and parts of lots 6 and 7 all in Section 21. Township 40 North, Range 12 East, Fourth Principal Meridian COUNTY OF FOREST. STATE OF WISCONSIN

## SURVEY NOTES

This survey was made by the U.S. Department of Agriculture, Forest Service, for the purpose of marking the corners and boundary lines of U.S. Government land within Government Lots 6 and 7 of section 21, township 40 north, range 12 east, fourth principal meridian, Forest County, Wisconsin as shown on the plat map herewith. The property line boundary surveyed is in accordance with U.S. Government Disclaimer description dated September 17, 1941 as recorded in the Forest County deed records.

A dependent resurvey of this township was made by the General Land Office in 1941.

The corner positions are monumented as shown on the map legend. The boundary line posts are at the locations shown on the plat map.

# Property Corners Established

1. South Sixteenth Corner to Section 21.

Corner established at midpoint and on line between southeast corner and east quarter corner of section 21. Corner references:

Yellow birch 12"	N.22 E.	29.5 feet
Yellow birch 9"	N.48 W.	27.0 feet

Property Corner No. 1.

Corner established on section line and 250 feet north of southeast corner of Lot 7 (South sixteenth corner).

Corner references:

Hemlock 12,"	N.17 W.	36.2 feet
Maple 12"	N.34 E.	51.7 feet
W.C. monument	N.O 24'W.	10.99 feet
Property corner (Section 22)	N.O 24'W.	30.9 feet

Property Corner No. 2.

Corner established 330 feet west of section line and 250 feet north of south line of Lot 7.

Corner references:

Hemlock 11"	N.19 E.	32.5 feet
Hemlock 9"	N.46 W.	36.0 feet
Steel sign post	N.W.	1 foot

# PLAT OF SURVEY

# U.S. Government Land

Being lots 1, 3, 4, 5, and 9; SEI/4NEI/4; and parts of lots 6 and 7 all in Section 21. Township 40 North, Range 12 East, Fourth Principal Meridian.

# COUNTY OF FOREST, STATE OF WISCONSIN

Property Corner No. 3.

Corner reestablished on south line of Lot 7 and 330 feet west of section line. Corner references:

Hemlock 13"	N.37°W.	44.3 feet
Maple 7"	N.81°W.	48.3 <b>feet</b>
Line post	West	36.9 feet
Line post	North	81.0 feet

Property Corner No. 4.

Corner established on north line of Lot 6 and 515 feet west of section line. Corner references.

N.23°E. Maple 10" 22.5 feet N.72°W. Hemlock 9" 26.9 feet Steel sign post N.W. 1 foot

Property Line Corner.

Corner established as meander corner on north shore of Butternut Lake and being on a line south from property corner no. 4 and parallel with the east line of section 21. Corner references:

S.36°W. Maple 7" 5.8 feet N.80°W. Tamarack 8" 18.4 feet

The field notes of this survey and a copy of this plat of survey are on file in the Forest Supervisor's Office at Rhinelander, Wisconsin.

#### SURVEYOR'S AFFIDAVIT

State of Wisconsin) ss County of Forest

I, Jean F. Resvick, land surveyor, U.S. Forest Service, and a registered land surveyor in the State of Wisconsin hereby certify that I have surveyed and marked the property line boundary for those parts of Government Lots 6 and 7 in section 21, township 40north, range 12 east, fourth principal meridian, State of Wisconsin as shown on the plat map herewith.

The plat map and notes herewith are a correct representation of the corners and lines established. I have surveyed the location of Government Lots 6 and 7 in accordance with the rules for the survey of the public lands and with the statutes of the State of Wisconsin.

JEAN F.

Land Surveyor, U.S. Forest Service


JEAN F. RESVICK RHINELANDER,

Land Surveyor, U.S. Forest Service R.L.S. State of Wisconsin Certificate S-802

Sheet 1 of 4

# PLAT OF SURVEY U.S. GOVERNMENT LAND

Being North 40 acres Government Lot 3 & Government Lot 7 - Section 22
Township 40 North, Range 12 East, Fourth Principal Meridian
FOREST COUNTY, WISCONSIN

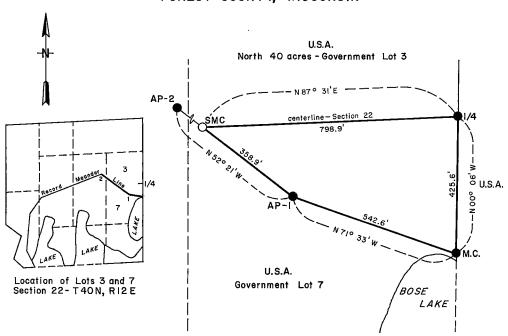

## LEGEND

- BLM monument.
- O Corner position marked by 2 inch inside diameter by 3 foot long concrete filled galvanized iron pipe capped with a 3 inch diameter brass tablet stamped to identify corner.
- Boundary line U.S. Government land.

U.S.A. U.S. Government land,

Document No. 108566

REGISTER'S OFFICE }
Forest County, Vis. }

Peresignal for moord this III day of January

A. D., 1676 at 1015 of the A. II at ...

Course in von Restorations

Eugene State of Diego

446/2222000

## SURVEY NOTES

The original Government survey of section 22 was made in 1859. In 1941 the Bureau of Land Management made a dependent resurvey of township 40 north, range 12 east as a retracement and reestablishment of the lines of the original Government survey. Due to gross errors in the original government survey all public lands were not included within the original survey. By an extension survey in 1943 the original record meander lines within section 22 were established as fixed boundaries and additional Government lotting was established within these fixed boundaries. A fixed boundary was established between Government Lot 3 from the original Government survey and Government Lot 7 established by the 1941 and 1943 dependent and extension surveys.

In 1935 the U.S. Government acquired title to the north 40 acres of Government Lot 3 bounded on the south by the east-west centerline of section 22 and by the record meander line established as a fixed boundary by the Bureau of Land Management dependent and extension surveys of 1941 and 1943 under authority for the resurvey contained in the BLM letter 1858603E dated March 21, 1941. Adjoining Government Lot 7 within the fixed boundary of the record meander line is reserved public domain by Proclamation No. 2035, dated 1933.

The purpose of this survey was to recover those corners of the 1941 and 1943 BLM surveys that identify the boundaries of Government Lots 3 and 7 and to establish the south line of the north 40 acres of Government Lot 3.

The corner positions are marked by the monument described in the map legend. The special meander corner position was established to within an accuracy of one part in 3000. The bearings between corner positions are referenced to the bearings of the BLM surveys.

The field notes of this survey and a copy of this plat of survey are on file in the Forest Supervisor's Office at Rhinelander, Wisconsin.

# Corners Recovered

# 1. Quarter Corner to Sections 22-23.

Corner found marked by brass cap concrete monument from 1941 BLM dependent resurvey.

Corner references:

 Maple 23"
 N. 21°E.
 6.0 feet

 Hemlock 15"
 S. 2°E.
 14.5 feet

 Yellow Birch 13"
 N. 22°W.
 33.7 feet

 Sign post
 NE
 0.9 foot

Sheet 3 of 4

# 2. Meander Corner to Sections 22-23.

Corner on north side of Bose Lake found marked by brass cap iron pipe movement from 1941 BLM dependent resurvey. Corner references:  $\cdot$ 

Norway Pine 20"	N. 75°E.	7.9 feet
White Pine stump	N. 33°E.	3.3 feet
Norway Pine 16"	S. 70°E.	51.5 feet
White Birch 6"	s. 73°W.	2.0 feet
Sign post	SE	1.0 foot
Lake	South	24 feet

# 3. Angle Point No. 1.

Angle point of record meander line found marked by brass cap concrete monument from 1943 BLM extension survey. Corner references:

Maple 21"	S. 13°30'E.	45.5 feet
Yellow birch 17"	N. 16°W.	31.0 feet
Sign post	s. 65°W.	0.8 foot

## 4. Angle Point No. 2.

Monument recovered in place from 1943 BLM extension survey.

## Corner Established

## 1. Special Meander Corner.

Corner established at point of intersection of east-west centerline of section 22 and the record meander line between angle points 1 and 2 as monumented by the 1943 BLM extension survey. Corner references:

Yellow Birch 14"	N. 25°E.	36.3 feet
Hemlock 13"	s. 30°W.	24.5 feet

*;* •

## SURVEYOR'S AFFIDAVIT

State of Wisconsin) ss County of Forest

I, Jean F. Resvick, Land Surveyor, U.S. Forest Service, and a registered land surveyor in the State of Wisconsin hereby certify that I have retraced and recovered the corners on the record meander line from the meander corner on the east line of section 22 to angle point 2 and have established the point of intersection of the east-west centerline of section 22 with the line between angle points 1 and 2 all in section 22, township 40 north, range 12 east, fourth principal meridian, State of Wisconsin.

The plat map and survey notes are a correct representation of the corners recovered and established. This survey was made in accordance with the rules

JEAN F.
RESVICK
RHINKELANDER,
WIS.

RELOS State of Wisconsin

Land Surveyor, U.S. Forest Service
R.L.S. State of Wisconsin

Gertificate S-802

Date of Survey:

Certificate S-802

## CERTIFIED LAND CORNER RESTORATION

State of Wisconsin	
State of Wisconsin  County of Forest	S.
I William B. Cochrane	, do hereby certify that on the 17th day of January 19.75
I found evidence of the East Ou	arter corner of Section 23
Township 40 North	Range 12 East Fourth Principal Meridian, as described
	nce I established a new monument and accessories as described hereon to per-

Description of original monument and accessories and subsequent restorations:

Dependent resurvey of 1941 by Guy R. Veal At proportionate distance set an iron post 3 feet long, 2 ins. diameter, 27 ins. in the ground with a brass cap marked: 1/4, S23, S24, 1941 From which: Poplar, 6" bears N68° 15'E, 14 lks., Poplar 6" bears N26°/30'W, 41 lks.

Description of corner evidence found:

petuate the original location of this corner:

Monument as described above and in place. Aspen snag,  $N68^{\rm OE}$ ,  $14~{\rm lks}$ . No evidence of the other aspen bearing tree.

Description of monument and accessories I established to perpetuate the location of this corner:

I blazed and scribed the following new bearing trees:

W. Spruce, 13", bears  $N66^{O}E$ , 23.14 feet W. Spruce, 5", bears  $N45^{O}W$ , 55.44 feet Set a steel sign post west of the monument, 0.50 feet

	Resident witnesses
	Dated at Three Lakes Wisconsin, this 20 day of January
Sec. 23	Signature William B. Cochrane  Title Land Surveyor  (County Surveyor Britished Land Surveyor on other duly authorized official)
	(County Surveyor, Registered Land Surveyor, or other duly authorized official) Surveyors Registration No. S-1107 Document Number 106876
	Office of Register of Deeds County of Forest
Corner monument restored	I hereby certify that the within instrument was filed in this office for record on the 31ste day of March 19.75, and was filed in Book Corner No. RestorationsPage No. P-21 of County Records.
say	No Restorations Page No. 1221 of County Records. Signature Lugent Statut Milital Register of Deeds
Township 40 North Rang	re 12 East Section 23 Index No. P-21 Page No

P. 18.14


#### CERTIFIED LAND CORNER RESTORATION

Township 40 North, Range 12 East, 4th P.M. Wisconsin Government Lot 6, Section 22

State of Wisconsin)

SS
County of Forest

I, Jean F. Resvick, do hereby certify that on the 30th day of November 1964, I found

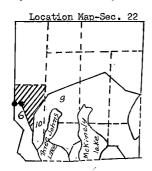

evidence of the property corners in Government lot 6,
ThON, R12E as established and described for Fred Rueping
by Genisot Engineer Company of Rhinelander, Wisconsin in
October 1963. The plat hereon is a correct representation
of the corners found and the monuments and accessories
used to perpetuate the original location of these property
corners.

Corners monumented and corner accessories established are:

Property corners Three (PC-3) Corner position < 706.58 ft. south of west  $\frac{1}{4}$  corner on west section line.

Corner accessories established are: Hemlock 12", N69°W, 11.03 ft. Maple 12", N67°E, 31.80 ft.

Property corner Four (PC-4) Corner position established 225 feet east of PC-3.

Corner accessories are:
 Hemlock 6", N49°30'E, 26.85 ft.
 Maple 12", S35°W, 7.18 ft.
 Maple 10", N21°W, 20.08 ft.

44012211500

- O G. L. O. Monuments 1945 Resurvey
- Iron pipe found replaced with 2"x5' long iron pipe capped with brass tablet.

U.S.A. Property in Government Lot 6

JEAN F.
RESVICK
RRINGLANDER
WIS

Cadastral Surveyor-U.S. Forest Service R. L. S. State of Wisconsin Certificate No. S-802

Dated at Rhinelander, Wisconsin, the 89768 and day of March ,196

REGISTER'S OFFICE Forest County, Wis. }

Received for record this 9 day of Musch h.c., 1965 9 9 0'clock A M. and the county of the second state of the second st

Register of Deeds

I Jean F. Resvick do hereby certify that on the 22nd day of September 1970, I found evidence of the Angle Point #1 corner of Section 22

Township 40 North , Range 12 East , Fourth Principal Meridian, as described hereon; and that from this evidence I established a new monument and accessories as described hereon to per-

DOCUMENT NUMBER

State of Wisconsin

petuate the original location of this corner:

County of Forest

SS.

Description of original monument	and accessories and subsequent restor	ations:
diameter, 20 inches in the	Craig. Set a concrete monument ground, for angle point 1, Sec API, 1943. From which the follows 30'E, 69 1ks.	tion 22, with a brass cap
		•
Description of corner evidence for	und:	•
Monu	ment as described above.	
T40N R12E S22	Maple, 21", bears S13 <sup>o</sup> 30'E, 4 Y. Birch 17", bears N16W, (re 31.0 feet. Scribing is visab	cord bearing is N1 <sup>0</sup> 30'W)
Description of monument and acc	cessories I established to perpetuate the	original location of this corner:
Set a steel sign post S65W,	, 0.80 feet from the monument.	
	4401Z ZZ 1803  Resident witnesses	JEAN F. RESVICK RHINELANDER WIS.  OSUR
Sec. 22  API  — Corner monument restored  — =	(County Surveyor, Registered Land S Surveyors Registration No S=802 Office of Register of Deeds I hereby certify that the within instron the Li6th day of March No 1 Page No AP- Signature Signature State	TitleCadastral Surveyor urveyor, or other duly authorized official)  County of Forest ument was filed in this office for record 19 71, and was filed in Book of County Records.
Township 40 North , Rang	ge 12 East V, Section 22 V	Index No.AP1 Page No

# CERTIFIED LAND CORNER RESTORATION

State of Wisconsin

Township....

County of	Forest	SS.	DOCUMENT NUMBER	99451
Township. hereon; an	40 North	evidence I established a new n	, Fourth	ay of September 1970 , ection 22 and 23 Principal Meridian, as described ries as described hereon to per-
Surve by Gu 2 fee corne diame No Wh No Description	eyed in 1859  Ty R. Veal.  The transfer of Section  The transfer encased  The pine 18  The transfer exists  The pine 10  The pine 10	nches in diameter, 18 as 21 and 22 with an d therein, with brass 3, bears N75E, 12 lks ab 28, bears N33W, 5 a, 78 lks. (in SE quanche found:	rty. Dependent inal evidence, inches in the iron post 22 in cap stamped to lks.	set a concrete monument ground for meander nches long, 1 inch in didentify corner.
with No Wh No	brass cap storway 20, N7! Lite pine storway pine 16	amped to identify co	rner (recorded	r, 27 inches in ground as concrete monument)
Blaze Wh	d and scribe ite Birch 6,	nd accessories I established to ped the following new S73W, 2.0 feet with signs bears SE,	bearing tree	location of this corner:
		44ø12221	S COO	A Daniel Bar
		Resident witnesses		SUR
S	Sec. 22	Country Stimmon Do	Kesvick Resvick T gistered Land Surveyor, o	n, this Land day of Mr
<b>⊗</b> = 0	Corner monument res	Office of Register I hereby certify that the on the 16ht day of	of Deeds Cou	as filed in this office for record

26273	NUMBER	89
ģ	Ţ	S
Stock	DOCUMENT	₩ ₩

FORM NO. 985-A

U.S. PUBLIC LAND S	SURVEY MO	ONUMENT R	ECORD
--------------------	-----------	-----------	-------

Index No	K-/
----------	-----


State of Wisconsin  County of Forest  I Gary L. Pison i , do hereby certify that on the 16th day of August 19.89, I found evidence of the 1/4 corner of Sections 20 and 29.  Township 40 , North, Range 12E , Fourth Principal Meridian, as described hereon; and that from this evidence I established a new monument and accessories as described hereon to perpetuate the original leaster of this corner.	History of original corner establishment:  Corner position established from the 1941 General Land Office dependent resurvey of this township. They set a 2" diameter iron pipe monument with a brass cap stamped to identify the corner. Corner references established in 1941: Oak 20" N 39 E 30.67 feet; Hemlock S 59 E 25.15 feet  Corner references recovered in 1980 by U.S.F.S.:  Oak 20" N 39 E 30.67 feet  Hemlock Stump S 59 E 25.15 feet  New corner reference set by U.S.F.S. in 1980:  White Birch 13" S 17 E. 14.47 feet  Description of corner evidence found:  Monument as described and in place.
location of this corner.  Resident witnesses:	Corner references recovered:  Oak. 24" N 39°E 30.67 feet  Wood sign post S 30°W 1.4 feet
	Description of monument and accessories I established to perpetuate the original location of this corner.  Blazed and scribed the following new bearing trees:  Sugar Maple 8" \$ 73°E 35.08 feet  Sugar Maple 5" N 59°W 21.15 feet
SECTION 29	Dated at Iron River, MI, Wise, this 26th day of August 1989.  Signature Land Surveyor Registered Land Surveyor, or other duly authorized official)  Office of Register of Deeds, County of Forest 1, I hereby certify that the withinstrument was filed in this office for record on the 8th day of March 1990 at 1:00 c'clock P. M.  Register of Deeds)
= Corner monument restored.	ByDeputy

See drawing below

(r) Was the corner restored through acceptance of (1) an obliterated evidence location, or, (2) a found perpetuated location?

Restored through acceptance of a found perpetuated location.

(gkh) Was the corner reestablished through lost corner proportionate methods? If so, show the method, including the directions and distances to other public land survey corners used as evidence or used for proportioning in determining the corner location?

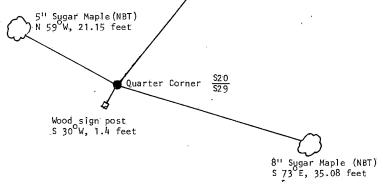

24" Oak N 39°E, 30.67 feet



Gary L. Pisoni

Signature

(type or print name) certify that the corner location shown on this record was determined by me or under my direction and control and that this U.S. Public Land Survey Monument Record is correct and complete to the best of my knowledge and belief.. (4)

Promi 8-26-89

Survey requested by:

1/5/90

District Ranger

100184

DOCUMENT NO.

Title Register of Deeds

Surveyors Registration No. S-802

Office of Register of Deeds County of Forest

I hereby certify that the within instrument was filed in this office for record on the 5th day of August 19.71, and was filed in Book

Page No. \_\_\_\_\_of County Records.

12 East Section 28 Index No. R-11 Page No.

State of Wisconsin

County of Forest

I found evidence of the \_\_\_\_\_

R. Veal in 1941.

Sec. 28

Township

= Corner monument restored

. Range

Jean F. Resvick

#### CERTIFIED LAND CORNER RESTORATION

State of Wisconsin	} ss.	
--------------------	-------	--

I Jean F. Resvick , do hereby certify that on the 21st day of April ,19.71., I found evidence of the East Meander corner of Section 21 & Section 28

Township. 40 North , Range 12 East , Fourth Principal Meridian, as described hereon; and that from this evidence I established a new monument and accessories as described hereon to perpetuate the original location of this corner:

#### Description of original monument and accessories and subsequent restorations:

Surveyed in 1859 by William E. Daugherty. East between Section 21 & 28, 62.36 chains, set M.G. post.

Fir 8, N60W, 6 1ks.

Fir 6, S50W, 27 1ks.

Dependent resurvey in 1941 by Guy R. Veal. S89°31'E, 22.85 chains from quarter between Section 21 & 28 to old shoreline of lake. Set iron post, 3 feet long, 2 inches in diameter, 27 inches in the ground, for meander corner of Section 21 & 28 with brass cap marked, T40N, S21, MC, S28, R12E, 1941 from which, A yellow birch, 14" diam., bears S39W, 23½ lks. Yellow birch, 5" diam., bears N2°45'W, 18 lks. A local meander post, which is a cedar post Description of corner evidence found:

4" square, 4' long, set 1' in the ground, marked MC, bears S89°31'E, 98 lks. distance over low wet land to present lake shore.

Monument found as described.
Yellow Birch 18, bears S39W, 15.27 feet
Yellow Birch 8, dead, bears N27°45'W, 11.90 feet.

## Description of monument and accessories I established to perpetuate the original location of this corner:

Blazed and scribed the following new bearing tree. Black Ash 14, bears N84E, 13.88 feet Set steel sign post 1 foot north of monument.



	Resident witnesses
	Dated at Rhinelander Wisconsin, this A. day of April
Sec. 21	1971 fear f. Rescie Title Land Surveyor  Signature Jean F. Resvick Title Land Surveyor  (County Surveyor, Registered Land Surveyor, or other duly authorized official)
	Surveyors Registration No. S-802 DOCUMENT NUMBER 99718
MC	Office of Register of Deeds County of Forest.  I hereby certify that the within instrument was filed in this office for record
= Corner monument restored	on the 25th day of May 19 71, and was filed in Book No. 1 Page No. R-12 of County Records.
	Signature Title Register of Deeds
Township 40 North , Rang	e 12 East , Section 21 , Index Nor-12, 13., Page No.

# CERTIFIED LAND CORNER RESTORATION.

7	
State of Wisconsin	
County of Forest ss	
I found evidence of the North Q Township 40 North	day of October, 19.73
Description of original monument	and accessories and subsequent restorations:
Original survey in 1859 by Dependent resurvey in 1941 At proportionate distance scap marked S22, 1/4, S27, 1981 White Birch 7, S60E, 38 1ks Yellow Birch 5, N46 30 W, 8 Meander Corner N85 12 E, 1.	by Guy R. Veal et iron post, 3 feet. long, 2 inch diameter with brass 941 et iron post, 3 feet. long, 2 inch diameter with brass 941 et iron post, 3 feet. long, 2 inch diameter with brass 941 et iron post, 3 feet. long, 2 inch diameter with brass 941 et iron post, 3 feet. long, 2 inch diameter with brass 941 et iron post, 3 feet. long, 2 inch diameter with brass 941 et iron post, 3 feet. long, 2 inch diameter with brass 941 et iron post, 3 feet. long, 2 inch diameter with brass 941 et iron post, 3 feet. long, 2 inch diameter with brass 941 et iron post, 3 feet. long, 2 inch diameter with brass 941 et iron post, 3 feet. long, 2 inch diameter with brass 941 et iron post, 3 feet. long, 2 inch diameter with brass 941 et iron post, 3 feet. long, 2 inch diameter with brass 941 et iron post, 3 feet. long, 4 fe
Description of corner evidence for	ınd:
S60°E, 38 lks. and a Yellow These 2 trees had been blaze	feet, scribed feet, scribed. 28 feet from monument as found, a White Birch bears Birch bears N47 <sup>O</sup> W, 8 lks.
Description of monument and acco	essories I established to perpetuate the location of this corner:
1941 survey. The monument were made at the new location	rent that the quarter corner position was adjusted in the was moved and bearing tree cut out. New bearing trees on but not recorded. The distance between meander corners. I accept the monument as found. Set steel sign post near
	JEAN F. RESVICK RHINELANDER. WIS.
	Resident witnesses
Sec. 27	Dated at Rhinelander Wisconsin, this day of July  19. 74  Signature Jean F. Resvick Title Land Surveyor  (County Surveyor, Registered Land Surveyor, or other duly authorized official)
	Surveyors Registration No. S-802  DOCUMENT NUMBER 105823
Corner monument restored	Office of Register of Deeds County of Forest  I hereby certify that the within instrument was filed in this office for record on the 8th day of August 19 74, and was filed in Book No. Corner Page No. R-15 of County Records.
m	Signature Ligene State of Title

44Ø1ZZZØGZØ,

CE	RTIFIED LAND CORNER RI	ESTORATION	•
State of Wisconsin  County of Forest ss			
I Jean F. Resvick I found evidence of the Norther Township 38 North hereon; and that from this eviden petuate the original location of thi	, Range 13 East ce I established a new monumer	corner of Section 26 Fourth Principal Me	ridian, as described
Description of original monument	and accessories and subsequent	restorations:	
North between sections 25 at Set post for section corner Birch 10, N67°W, 10 lks. Cedar 14 N22E, 34 lks.	nd 26, 80 chains		
Description of corner evidence fou	nd:		
Cedar stump, lower blaze wi Yellow Birch snag 16 ft. ta 24 inch diameter. Set point for corner S22°W, Birch snag bears N47W, 10 11	<ul><li>11, old cat face about 10</li><li>34 lks. from Gedar stump.</li></ul>	inch diameter, tree a	
Description of monument and acce	essories I established to perpetu	ate the location of this cor	ner:
Set 2 inch diameter galvani brass cap stamped, T38N, Rl from which the following bl Hemlock 18, N24E, 25.24 Ft.	3E, S23, S24, S26, S25, 19 azed and scribed new beari	972, S-802	e with
White Spruce 10, S3E, 20.59 Hemlock 13, S44W, 41.09 Ft. Cedar 14, N35W, 25.79 Ft. Set steel sign post 1.4 ft.		RE	AN F. SVICK ELANDER, WIS.
	Resident witnesses	\$ 500,000 \$ 500,000	URVERSON
Sec. 26	Dated at Rhinelander  19.74.  Signature Jean F. Resvick	Wisconsin, this 18	•
	(County Surveyor, Registered I Surveyors Registration No	Land Surveyor, or other duly a 5–802 1 DOCUMENT NUMBER	uthorized official) 05814
Corner monument restored	Office of Register of Deeds I hereby certify that the within on the 8th day of Augu No. Restorations Page No.	instrument was filed in t	nd was filed in Book
Township 38 North , Range	Signature Lugens	attany Title	***************************************

44012,23,0000

CERTIFIED LAND CORNER RESTORATION	
State of Wisconsin  County of Forest ss.	٠
I William B. Cochrane , do hereby certify that on the 17th day of January , 19 75., I found evidence of the Southeast Section corner of Section 24.  Township 40 North , Range 12 East , Fourth Principal Meridian, as described hereon; and that from this evidence I established a new monument and accessories as described hereon to perpetuate the original location of this corner:	
Description of original monument and accessories and subsequent restorations:	
Dependent resurvey of 1941 by Guy R. Veal From the remains of original evidence, set an iron post, 3 feet long, 2 ins. diameter 27 ins. in the ground with a brass cap marked: T40N, R12E, R13E, S19, S24, S25, S30, 1941. From which: Maple, 12", bears N600 45'E, 86 lks. Maple, 8", bears S580 45'E, 38 lks. Maple, 20", bears S670 30'W, 33 lks. Original bearing tree. Basswood, 10", bears N580 45'W, 9 lks.	
Description of corner evidence found:	
Monument as described above and in place.  Maple, stump, N61°E, 86 lks.  Maple, stump remains, S59°E, 38 lks.  Maple, 26" stump, S67°W, 33 lks.  Basswood, 17", N59°W, 9 lks.	
Description of monument and accessories I established to perpetuate the location of this corner:  I blazed and scribed the following new bearing trees: Maple, 9", bears N81°E, 11.58 ft. Maple, 9", bears S2°E, 8.93 ft. Maple, 6", bears S83°W, 13.95 ft. Set a steel sign post NE of the monument, 0.50 ft.	
Set a steel sign post NE of the monument, 0.50 ft.	
Resident witnesses	
Dated at Three Lakes Wisconsin, this 20th day of January  19.75.  Sec. 24  Signature William B. Cochrane Title Land Surveyor  (County Surveyor, Registered Land Surveyor, or other duly authorized official)  Surveyors Registration No. S-1107  Document Mumber 1068	79
Office of Register of Deeds County of Forest 12	
I hereby certify that the within instrument was filed in this office for record on the 31st. day of 19.75, and was filed in Book No Restorations Page No. R-25 of County Records.	;
Township 40 North , Range 12 East , Section 24 , Index No. R-25 , Page No.	J

	S. PUBLIC LAND SURVEY MONUMENT RECORD	Index No. S-9
State of Wisconsin } ss.	History of original corner establishment:	
County of Forest Sary L. Pisoni do hereb	Corner was set in 1980 by the U.S.F.S. under the di a Registered Land Surveyor during the sub-division	
certify that on the 16th day of August 19.89 I foun evidence of the North 1/16 corner of Sections 28 and 29.  Township 40 North Rang 12E Fourth Principal Meridia as described hereon; and that from this evident I established a new monument and accessorie	U.S.F.S. set a 2½ inch diameter aluminum pipe monum stamped to identify the corner. Corner references  Sugar Maple 18" N. 28°W. 25. Steel sign post N. 50°W. 0. Maple 11" S. 58°W. 31.  Description of corner evidence found:	
as described hereon to perpetuate the original location of this corner.	Monument as described and in place.  Corner references recovered:	
Resident witnesses:	Sugar Maple 18" N 28°W 25.	54 feet 5 feet
	·	
	· 	
	Description of monument and accessories I established to perpetua	
		10
	Blazed and scribed the following new bearing tree:  Ironwood ( 5" \$ 55 E 12.	37 feet , <u>N</u>
1 1 1		· · · · · ·
	k:	₩ <b>4</b> -
	:	
SECTION 29	Dated at Iron River, MI , WKs., this 26th	day of August 19.89
	Signature Say J. Som Title Land Survey  (County Surveyor, Registered Land Surveyor, or other duly	YOR Registration No.S-1634
	Office of Register of Deeds, County of Forest	
t   t   t   t	instrument was filed in this office for record on the 8th at 1:00 o'clock P. M.  Aud Hochen Stenses (Register of Deeds)	day of <b>March</b> 19 <b>.90</b>
= Corner monument restored.	ByDeputy	

See drawing below.

(f) was the corner restored through acceptance of (1) an obliterated evidence location, or, (2) a found perpetuated location?

Restored through acceptance of a found perpetuated location.

(g&h) Was the corner reestablished through lost corner proportionate methods? If so, show the method, including the directions and distances to other public land survey corners used as evidence or used for proportioning in determining the corner location?

18" Sugar Maple N 28<sup>0</sup>W, 25.54 feet Steel sign post N 50°W, 0.5 feet North 1/16 Corner S29 S28 5" Ironwood (NBT) S 55°E, 12.37 feet

Gary L. Pisoni (type or print name) certify that the corner location shown on this record was determined by me or under my direction and control and that this U.S. Public Land Survey Monument Record is correct and complete to the best of my knowledge and belief.

Signature

8-26-89

190 Survey requested by:

District Ranger

Wiffix Manual State Stat

. 4-6-35

IRON HI.
MI
SURVEYORM

FORM NO. 985-A NEARING COMPANY STOCK NO. 26273	. FI AT	à i
------------------------------------------------	---------	-----


	PUBLIC LAND SURVEY MONUMENT RECORD	Index No. S-9, 10
State of Wisconsin  County of Forest ss.  1 Gary L. Pisoni do hereby	History of original corner establishment: Corner was set in 1980 by the U.S.F.S. under the direction of Will a Registered Land Surveyor during the sub-division of Section 28.	iam B. Cochrane,
certify that on the 16th day of August , 19 89. I found evidence of the W.C. of the NW 1/16 corner of Section 28  Township 40 North, Range 12E Fourth Principal Meridian, as described hereon; and that from this evidence I established a new monument and accessories as described hereon to perpetuate the original	U.S.F.S. monumented the witness corner on West shore of Gertrude La Government Lots 2 and 3 and set a $2\frac{1}{2}$ inch diameter aluminum pipe m with an aluminum cap, stamped to identify the corner. Corner refersore 7'' N 33 W. 4.14 feet Balsam 9'' S 81 E. 3.63 feet Steel sign post North 0.5 feet NW Sixteenth corner position is in Lake bearing N 87 47.9'E, 286 Monument as described and in place.	onument 60 <sup>m</sup> long rences established:
location of this corner.		
Resident witnesses:	Corner references recovered: Black Spruce 8" N 33 <sup>0</sup> W 4.14 feet Steel sign post North 0.5 feet	
		٠
	<b>3</b>	
	Description of monument and accessories I established to perpetuate the original location	n of this corner.
	Blazed and scribed the following new bearing tree:	
	Hemlock 7" \$ 10 W. 27.63 feet	
		. 47
		,
SECTION 28	Dated at Iron River, MI , W.K., this 26th day of Augus	
1 1 1	Signature Hary L. Room Title Land Surveyor  (County Surveyor, Registered Land Surveyor, or other duly authorized official)	
	Office of Register of Deeds, County of Forest I h instrument was filed in this office for record on the 8th day of Mar	ereby certify that the withi
	at 1:00 o'clock P. M.  Joul Halentrenner  (Register of Deeds)	
= Corner monument restored.	ByDeputy	

See drawing below.

(r) Was the corner restored through acceptance of (1) an obliterated evidence location, or, (2) a found perpetuated location?

Restored through acceptance of a found perpetuated location.

(gkh) Was the corner reestablished through lost corner proportionate methods? If so, show the method, including the directions and distances to other public land survey corners used as evidence or used for proportioning in determining the corner location?

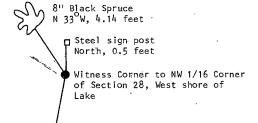

7" Hemlock (NBT) \$ 10°W, 27.63 ft.



Gary L. Pisoni type or print name; certify that the corner location shown on this record was determined by me or under my direction and control and that this U.S. Public Land Survey Monument Record is correct and complete to the best of my knowledge and belief.

8-26-89 Signature

Survey requested by:

District Ranger


U.S.	PUBLIC LAND SURVEY MONUMENT RECORD	Index No. T-8
State of Wisconsin  County of Forest ss.	History of original corner establishment: Corner was set in 1980 by the U.S.F.S. under the direction a Registered Land Surveyor during the sub-division of Sect	
I. Gary L. Pisoni , do hereby certify that on the 16th .day of August , 19.89 I found evidence of the Center-East 1/16 corner of Section 29  Township. 40 , North, Range 12E , Fourth Principal Meridian, as described hereon; and that from this evidence	U.S.F.S. set a $2\frac{1}{2}$ inch diameter aluminum pipe monument 30" stamped to identify the corner. Bearing trees established White Birch 12" N 52°E 33.36 feet White Birch 10" N 82°W 20.10 feet Steel sign post Northwest 0.5 feet	
I established a new monument and accessories as described hereon to perpetuate the original	Monument as described and in place.	
location of this corner.  Resident witnesses:	Bearing trees recovered:  White Birch 14" N 52°E. 33.36 feet Steel sign post N 65°W 0.5 feet	
	Description of monument and accessories I established to perpetuate the original Blazed and scribed the following new bearing tree:  Sugar Maple 8" N 65 <sup>O</sup> W 16.98 feet	nal location of this corner.
SECTION 29	Dated at Iron River, MI , Wis., this 26th day of Signature for County Surveyor, Registered Land Surveyor, or other duly authorized of Gregister of Deeds, County of FOLEST instrument was filed in this office for record on the 8th day at 1:00 o'clock P. M. (Register of Deeds)	Registration No.S-1634  Conficial)  Registration No.S-1634
O = Corner monument restored.	ByDeputy	

See drawing below.

(F) Was the corner restored through acceptance of (1) an obliterated evidence location, or, (2) a found perpetuated location?

Restored through acceptance of a found perpetuated location.

(gkh) Was the corner reestablished through lost corner proportionate methods? If so, show the method, including the directions and distances to other public land survey corners used as evidence or used for proportioning in determining the corner location?

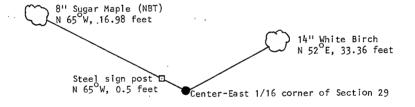

Gary L. Pisoni (type or print name) certify that the corner location shown on this record was determined by me or under my direction and control and that this U.S. Public Land Survey Monument Record is correct and complete to the best of my knowledge and belief.

8-26-89

District Ranger

GARY LEE PISONI S-1634 IRON RIVER MI

Survey requested by:

# CERTIFIED LAND CORNER RESTORATION

State	of	Wisconsin	ì	
County	of	Forest	} ss.	

I, Jean F. Resvick do hereby certify that on the 24th day of April 19.68. I found evidence of the East Quarter corner of Section 29

Township 10 North Range 12 East Fourth Principal Meridian, as described hereon; and that from this evidence I established a new recomment and accessories as described hereon to perpetuate the original location of this corner:

Description of description and accessories and subsequent restorations:



Original survey by William E. Daugherty in 1859. Dependent resurvey by Guy R. Veal, in 1941. At proportionate distance set a concrete monument, 2 feet long, 6 inches in diameter, with an iron post, 22 inches long, 1 inch diameter, encased therein, with brass cap marked:

 
from which the following bear: Maple, 4 ins., S. 21° W., 12 Lks. Yellow Birch, 8 ins., S. 33° E., 29 Lks. Birch, 15 ins., S. 11° 30' E., 8 Lks. Fallen Maple, 8 ins., N. 29° 45' W., 21 Lks.

Description of corner evidence found:

Monument found as described above.
White birch, 16 ins., S. 11° 30' E., 4.90 ft.
White birch, 9 ins., S. 33° E., 18.75 ft. This bearing tree was called in error as a Yellow birch.
Maple, 5 ins., S. 21° W., 7.85 ft.

Description of management and accessories I established to perpetuate the minimal location of this corner:

Set a 4" x 4" cedar post NW of the monument.





	Resident witnesses.
	Dated at Rhinelander Wisconsin, this 19th day of December
	19.68.
Sec. 29	Signaturo Jean F. Resvick Title Cadastral Surveyor
1   T	(County Surveyor, Registered Land Surveyor, or other duly authorized official)
	Surveyors Registration No. S-802 DOCUMENT NUMBER 95892
	Office of Register of Deeds County of Forest
	I hereby certify that the within instrument was filed in this office for record
	on the 31st day of January 19 69, and was filed in Book
Corner monument restored	No. I Page No. T-9 of County Records.
_ =	Signature Legent State Title Register of Deeds
- 1'	$\mathcal{L} = \mathcal{L} = $
Township 40 North Rang	e 12 East , Section 29 , Index No. T=9 , Page No.

		τ.
	;	Q Q
•		


	PUBLIC LAND SU	IRVEY MONUMEN	T RECORD	l	Index	No. <u>V-3</u>
State of Wisconsin  County of Forest ss.	Resurvey in 1941	ner establishment: Origi by Guy R. Veal; 39.0 n brass tablet stamp	08 chains se	in 1859 by Wil t iron post 3'	liam E. Daughe: long, 2ins. D	rty. Depende iameter, 27 i
I John H. Fisher , do hereby certify that on the 9 day of May , 1984 , I found	1/4 <u>\$ 30</u>	From which the fol	llowing bear	Remains of Stump Hole Stump Hole	the original bo S81°E N77°W	earing trees: 8 lks. 7 lks.
corner of Section 30 and 31 Township 40, North, Range	1941	Local Bearing Tree Hemlock Hemlock	14" 12"	S57-1/4°E N30°W	36 lks. 32 lks.	
.12 East, Fourth Principal Meridian, as described hereon; and that from this evidence I established a new monument and accessories	Description of corner	New Bearing Tree: evidence found:	ek 16"	N47°E	29 1ks.	
as described hereon to perpetuate the original location of this corner.	B.L.M. Monument	as described and in	place; and	the following	bearing tree	
Resident witnesses:	(	Hemlock	18"	N27°W	21.3 feet	ì
None						i 7 7
• ( • )	Description of monum	nent and accessories I esta	blished to perpe	etuate the original	location of this cor	ner.
	Corner in good	condition;				1
	Blazed and scri	bed the following ne	ew bearing to	rees:	-	7
1 1		Hemlock	10"	N37°E	14.71 feet	- `
		Sugar Maple Hemlock	9" 12"	S71°E S62°W	13.33 feet 21.12 feet	
		Set Steel Sign	n Post	S80°W	0.5 feet	
7, 1	Dated at Minocoua	, Wis.,	this 22nd	day of J	nuari	1985
	Signature Toles	Z. Lile T hty Surveyor, Registered Land	itle Register	ed Land Survey	or Registrati	
	Office of Register of I instrument was filed in at 1:00 o'clock	Deeds, County of For n this office for record on	est the 24th	day of	, I hereby certif	y that the within
(   1   1   1   1   1   1   1   1   1		Aschenbre (Register of Deeds)	nner	*****		
. 1 1 1 1						

See drawing below


(f) Was the corner restored through acceptance of (1) an obliterated evidence location, or, (2) a found perpetuated location?

## Found perpetuated location

(g&h) Was the corner reestablished through lost corner proportionate methods? If so, show the method, including the directions and distances to other public land survey corners used as evidence or used for proportioning in determining the corner location?

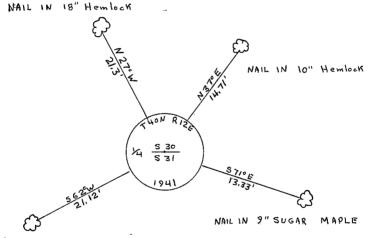

NAIL IN 12" Hemlock

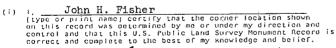

John H. Feiker 1/29/83




Number

See drawing below

(f) Was the corner restored through acceptance of (1) an obliterated evidence location, or, (2) a found perpetuated location?

Found perpetuated location

(gkh) Was the corner reestablished through lost corner proportionate methods? If so, show the method, including the directions and distances to other public land survey corners used as evidence or used for proportioning in determining the corner location?

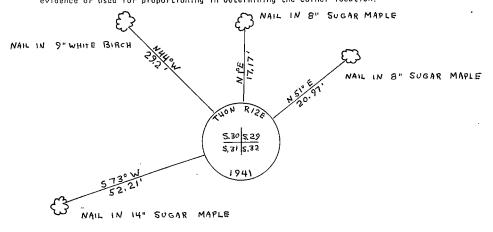

(i) i. John H. Fisher

(type or print name) certify that the corner location shown on this record was determined by me or under my direction and control and that this U.S. Public Land Survey Monument Record is correct and complete to the best of my knowledge and belief.

John H. Lisler 1/22/8

Affix LandatSunyeyor Scal

# CERTIFIED LAND CORNER RESTORATION

State of Wisconsin  County of Forest ss						
I William B. Cochrane I found evidence of the Nort Township 40 North hereon; and that from this eviden petuate the original location of thi	theast Section Range 12 ace I established a	East	er of , Fourth	Section. Principal	32 Meridian, as	described
Description of original monument	and accessories an	d subsequent resto	orations:			
Original survey in 1859 by W Dependent resurvey in 1941 bof a graded road, and origin Set a concrete monument, 2' post 22" long, 1" in diamete \$29, \$32, \$33 Yellow Birch, 14", N57E, 49 Hemlock, 8", \$64E, 121 lks.	by Guy R. Veal; nal blazes on the long, 6" in dia er, encased the	corner set fro ne line between ameter, 6" belo	Section Section the raise cap	ons 32 ar road suri marked 1	nd 33 face, with F4ON, RIZE,	an iron
Description of corner evidence for	ınd:					
Monument below road surface, Yellow Birch, 19", N57E, 32. Hemlock, 18", S64E, 79.86 ft Yellow Birch, 9", S49W, 36.7 Hemlock, 16", M25W, 76.35 ft Previously recorded on Plat	,34 ft. ;. 75 ft.		n, rlee			
Description of monument and acco	essories I establish	ed to perpetuate t	he locati	on of this	corner:	
Removed concrete monument an 6th below the road surface, w S33, 1982, S-1107	with an aluminu	ameter aluminum cap stamped ?  CUMENT NO.  124421	140n, R	12E, S28	SCONS WILLIAM B. COCHRANE S-1107 HILES, WISCONSIN	PROPERTION
. '		*		**************************************	SURVE	•
Section 32	Resident witnesse  Dated at Hil  19.82  Signature Will		<i>loc</i> hr	sin, this	Th	luly
	(County Surve	yor, Registered Land	Surveyor,	or other du		
	_	ration No. S-110			<b>.</b>	
- Corner monument restored Township40 North, Rang	I hereby certify to the 10th No.	ter of Deeds hat the within inst day of Octob Page No.	trument oer	was filed 19.83 f County l Title Reg	in this office , and was file Records. ister of	ed in Book Deeds
Township40 North Rang	e	, эеспоп <i>Эн</i> У.	, inger l	тлоу.	, гиде 140	•

State of Wisconsin
County of Forest
IJohn H. Fisher , do hereby certify that on the 16 day of May. 19.84, I found evidence of the One quarter corner of Sections 31 and 36.  Township 40 , North, Range 11 and 12 EastFourth Principal Meridian, as described hereon; and that from this evidence I established a new monument and accessories as described hereon to perpetuate the original location of this corner.
Resident witnesses: None
7-2
·
1 1 1
<b>a</b> <del>-</del> <del>-</del> <del>-</del> - <del>-</del> <del>-</del> <del>-</del> <del>-</del> <del>-</del>
T i i i l
O = Corner monument restored.


DEIC LAIN	D JOINTE	MONONEN	INECOND		In	dex No
Resurvey in Diameter, U with brass	1939 by Ha pper 24 ins tablet stan		39. 80 chair monument, A	ns set an ¦ ins. Dia	iron post 3 ft	. long, 1 in.
1/4		om which the fo	_			_
_		ginal White Pi		24"	S64-1/2ºE	28 lks.
S 36 S	31 Ori Nev	lginal White Pi		26"	N16-3/4°W	25 lks.
1939	****	te Birch	-	5"	N88-1/2°E	24 lks.
Description of	Whi	te Birch		811	N27°W	27 lks.
		as described and	d in place; a	and the fo	llowing bearin	g trees:
		ite Birch		10"		17.3 feet
		te Spruce		811	N28°W S44°E	14.9 feet
	Red Oa	ed the following	g new bearing	trees:	N81°W	31.39 feet 33.21 feet
		-				
	Set St	teel Sign Post			N40°W	1.1 feet
Dated at	(County Surv ter of Deeds, (s filed in this o	4	ele Registered Surveyor, or other d est he 24th	l Land Sur uly authorized	veyor Regist	tration No. S-836
	Taul #	Schenbre gister of Deeds)	rner	<b></b>		
R.,			Denu	***		

See drawing below

(f) Was the corner restored through acceptance of (1) an obliterated evidence location, or, (2) a found perpetuated location?

## Found perpetuated location

(g&h) Was the corner reestablished through lost corner proportionate methods? If so, show the method, including the directions and distances to other public land survey corners used as evidence or used for proportioning in determining the corner location?

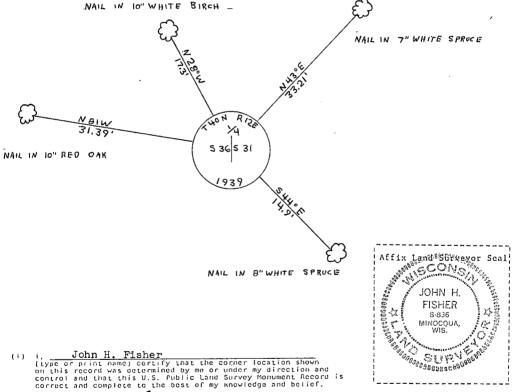

John H. Lisher 1/22/85

(Register of Deeds)

U.S. PUBLIC LAND SURVEY MONUMENT RECORD

State of Wisconsin

O = Corner monument restored.

27882

Document Number

SS.


Index No. X-5

See drawing below

(f) Was the corner restored through acceptance of (1) an obliterated evidence location, or, (2) a found perpetuated location?

Found perpetuated location

(gkh) Was the corner reestablished through lost corner proportionate methods? If so, show the method, including the directions and distances to other public land survey corners used as evidence or used for proportioning in determining the corner location?

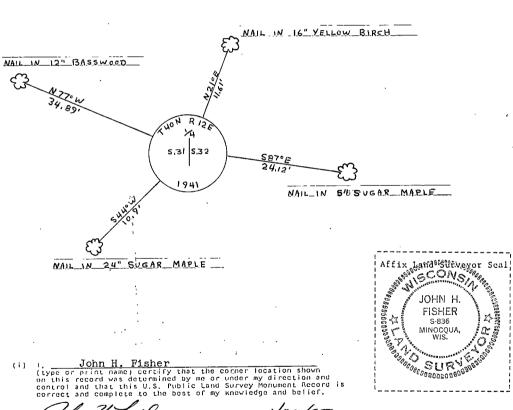

John H. Fisher 1/22/85

State of Wisconsin

# CERTIFIED LAND CORNER RESTORATION

County of Forest		
I found evidence of the Township 40 North	, do hereby certify that on the13th Quartercorner of , Range12 East, Fo ce I established a new monument and as s corner:	Sections 32 and 33 urth Principal Meridian, as described
Description of original monument	and accessories and subsequent restoration	ons:
Original survey in 1859 by Dependent resurvey in 1941 At proportionate distance, 2º long, 6" in diameter, 6" diameter embedded therein, Maple, 8", N36° E, 57.09 ft Maple, 10", N52° 3/4W, 50.5%		ad, set a concrete monument iron post 22" long, 1" in 333, 1941
Description of corner evidence for	nd:	
Concrete monument, set from Flush with road surface, br Maple, 16" N36 E, 57.09 ft Maple, 21", N52 3/4W, 50.5	ass can gone	•
Description of monument and acco	essories I established to perpetuate the le	ocation of this corner:
Replaced concrete monument	with a 2½" aluminum pipe monument	3, 30" long, 6" below the
road surface, with an alumi	num cap stamped T40N, R12E, 4, S	32, S33, 1982, S-1107
4401232200	document no. 124422	WILLIAM B. COCHRANE S-1107 HILES, WISCONSIN
	Resident witnesses	
Section 32	Dated at Hiles Wi 19.82 William B. Cochrane (County Surveyor, Registered Land Surveyor)	wave Title Land Surveyor
	Surveyors Registration No. S-1107	
	Office of Register of Deeds	County of Forest
Corner monument restored	I hereby certify that the within instrum on the 10th day of October No. Page No.	19_83, and was filed in Bool
<u></u> -	Signature Lugent Statepen	Title Register of Deeds
Township 40 North , Rang		dex No. X=9 , Page No

1-130

CE	RTIFIED LAND CORNER	RESTORATION		
State of Wisconsin County of Forest	<b>.</b>			
I William B. Cochrane I found evidence of the Souths Township 40 North hereon; and that from this eviden petuate the original location of th	ast section Range 12 East ace I established a new mon	corner of Se	ction 26 Principal Meridi	an, as described
Description of original monument	and accessories and subsequ	ent restorations:		
Dependent resurvey of 1941 At proportionate distance, 20 inches in the ground, for T40N, R12E, S25, S26, S35, Hemlock, 5", N34°E, 43 lks. Maple, 7", S72°E, 128 lks. Maple, 24", S6°45'W, 149 lkmaple, 6", N70°45'W, 117 lkmaple, 6", N70°45'W, N70	set a concrete monumen or corner of Sections 2 S36, 1941. From which	5, 26, 35 and 3	6 with a bras	imeter; ss cap marked
Description of corner evidence for	ınd:			4
Found the monument as desci No evidence of the hemlock. Maple, 13" stump, S68°E, 12 Maple, 30" stump snag, S7°W Maple, 12" tipout, N71°W, 1	28 lks. overgrowth.			
		•		
Description of monument and acceptable and scribed the followaple, 8", N34°W, 23.11 ft. Maple, 9", N66°E, 31.00 ft. Maple, 8", S38°E, 18.61 ft. Maple, 9", S56°W, 23.70 ft. Set a steel line post, sour	lowing new bearing tree		WILLIAM B. COCHRANE S-1107 HILES, WISCONSIN	No. of the contract of the con
44012	ZLØØØØ.	20 <sub>8</sub>	SURVE	BOHE
Sec. 26	Resident witnesses	B. Cochrace ochrane T red Land Surveyor, or S-1107	itle Survey Te	chnician rized official) 107238
Corner monument restored	I hereby certify that the wind the 16th day of No. Page No Signature	thin instrument was June of Category T	as filed in this  19.75 , and v  County Records  itle Register	office for record vas filed in Book
Township 40 North , Rang	e 12 East , Section	, Index No	J, Pa	ge 140

 $e^{jt}$ 

O = Corner monument restored.

History of original corner establishment:

See Vol. 2 of Plats Pages 23-A-B for details of survey

Description of corner evidence found:

See Vol. 2 of Plats Pages 23-A-B for details of survey

See Document # 89297

Description of monument and accessories I established to perpetuate the original location of this corner.

See Vol. 2 of Plats Pages 23-A-B for details of survey

West center 1/16 corner Corner to GL #7-8-11-12 Center quarter corner PC-8 Center South 1/16 corner P.O.C. # 1 (point on curve) Center East 1/16 corner P.O.C. #6 South 1/16 corner P.O.C. # 14 East 1/16 corner Center Curve # 9. Southeast 1/16 corner Corner tô GL # 1-2-9 Center West 1/16 Corner Corner to GL # 2-3-9-10 A.P. # 3

Signature /s// Jean F Resvick Title Cadastral Surveyor USEC Registration No. S\_802.

(County Surveyor, Registered Land Surveyor, or other duly authorized official)

Office of Register of Deeds, County of Forest , I hereby certify that the within at 11: - o'clock A. M. in Vol. 2 of Plats Pages 23-A-B

/s/ Anna Peterson

(Register of Deeds)

SMC # 2

O = Corner monument restored.

127883

Number

Document

State of Wisconsin

ss.

U.S.	PUBLIC	LAND	SURVEY	MONUMENT	RECORD

BLIC LAI	ND SURVEY M	CHOMEN	RECORD	Index No	
lesurvey in	1939 by Hal D. eter, 18 ins. in	Craig; at 39	0.68 chains set	857 by Alfred Millard: Depe a concrete monumnet, 24 in t, 3-1/2 ins. Diameter, 3 i	s. long,
and scamped	From which the	e following	hoor.		
0		11"	NL-3/4°E	41 lks.	
<u> 531</u>		16"	S62°E	12 lks.	
S 6					
1939					
Description of	of corner evidence fou	nd:			
PIM mo	nument as descri	had and in r			
Denéme mo	nument as descrit	bed and in p	Diage:		
Description	of monument and accept	pecorias I autabl	iched to perpetuate	the original location of this corner	
-			ished to perpetuate	the original location of this corner.	
Corner	in good condition	n:			
Corner Blazed	in good condition and scribed the	n:			
Corner	in good condition and scribed the s	n:			
Corner Blazed	in good condition and scribed the	n: following ne	ew bearing tree N62°E N35°E	es:	
Corner Blazed	in good condition and scribed the : l in: Sugar Maple	n: following ne	ew bearing tree N62°E N35°E N28°W	19.53 feet	
Corner Blazed	in good conditio and scribed the l in: Sugar Maple Red Maple	n: following ne 7" 6"	ew bearing tree N62°E N35°E	19.53 feet 10.08 feet	
Corner Blazed	in good conditio and scribed the l in: Sugar Maple Red Maple Sugar Maple	n: following ne 7" 6" 11" 8"	ew bearing tree N62°E N35°E N28°W	19.53 feet 10.08 feet 26.20 feet	
Corner Blazed	in good conditio and scribed the l in: Sugar Maple Red Maple Sugar Maple Red Maple	n: following ne 7" 6" 11" 8" n post	w bearing tree N62°E N35°E N28°W S88°W N14°W	19.53 feet 10.08 feet 26.20 feet 19.61 feet	
Corner Blazed Set nai	in good conditio and scribed the l in: Sugar Maple Red Maple Sugar Maple Red Maple	n: following ne 7" 6" 11" 8" n post	w bearing tree N62°E N35°E N28°W S88°W N14°W	19.53 feet 10.08 feet 26.20 feet 19.61 feet	, 19. <i>85</i>
Corner Blazed Set nai	in good condition and scribed the standard transfer of the sugar Maple Red Maple Red Maple Set steel sig	n: following ne 7" 6" 11" 8" n post	w bearing tree N62°E N35°E N28°W S88°W N14°W	19.53 feet 10.08 feet 26.20 feet 19.61 feet 1.5 feet	
Corner Blazed Set nai	in good condition and scribed the sin: Sugar Maple Red Maple Sugar Maple Red Maple Set steel sig	n: following ne 7" 6" 11" 8" n post	w bearing tree N62°E N35°E N28°W S88°W N14°W	19.53 feet 10.08 feet 26.20 feet 19.61 feet 1.5 feet  day of Surveyor Registration N	
Corner Blazed Set nai	in good condition and scribed the state of the sugar Maple Red Maple Red Maple Red Maple Red Maple Set steel siguinocqua	n: following ne 7" 6" 11" 8" n post, Wis., th	N62°E N35°E N35°E N28°W S88°W N14°W Als. 22 - J Registered Lar	19.53 feet 10.08 feet 26.20 feet 19.61 feet 1.5 feet  day of Surveyor Registration N	o. <b>S-</b> 836

.Deputy


L Aschenbrennes (Register of Deeds)

See drawing below

Was the corner restored through acceptance of (1) an obliterated evidence location, or, (2) a found perpetuated location?

#### Found perpetuated location

(gkh) Was the corner reestablished through lost corner proportionate methods? If so, show the method, including the directions and distances to other public land survey corners used as evidence or used for proportioning in determining the corner location?

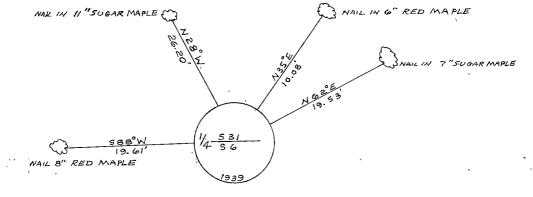

type or print name; certify that the corner location shown on this record was determined by me or under my direction and control and that this U.S. Public tand Survey Monument Record is correct and complete to the best of my knowledge and belief.

122

Affix Land Surveyor So MINIOCOUA, WIS.

Affix Land Surveyor Scal

in

O = Corner monument restored.

State of Wisconsin

County of Forest

SS.

PUBLIC LAN	D SURVEY	MONUMENT	RECORD			Index No. 2	<b>-</b> 5	
1939, by Hal	D. Craig, at he ground wit From whic Original	A splinte	set concrete 3-1/2" diam g bear: Sugar pturned pile red Hemlock	monument, eter, 3 in Maple earth Stump	24ins.; stem en 20"	long, 6 ins. onbedded in top S70°E S48°W .N69°W	diamet p and 45 10 25	lks. lks.
1939	New Beari	ng Trees:	Mapl Mapl Heml Mapl	e ock	8" 10" 18" 8"	N52-1/2°E S60-3/4°E S19-1/2°W S64-1/4°W	41 75	lks. lks. lks.
B.L.M. Monus	ment as descr	ribed and in pl	ace; and the	following	bearing	trees.		
Sugar Maple Sugar Maple Sugar Maple	16"	N50°E	1	27.37 ' 46.83 ' 48.35 '			<u>.</u> -	310,000
Description of	monument and a	accessories I establi	shed to perpetua	ite the origina	l location	of this corner.		2
	ood <b>conditi</b> on s <b>cr</b> ibed new b							72104
Set mail in	Hemlock	9" N19°	E 52.63	feet			<u>.</u>	<u>A</u> Ø
Set Steel S	ign Post	\$30°	E 1.2	feet			- <del>; -</del>	7

Dated at Minocqua	, Wis., this 22-2	day of Janus	end 1985
Signature Joke H. Hills (County Surveyor, Regis	Title Registered	Land Surveyor	Registration No. S-836
Office of Register of Deeds, County of			
instrument was filed in this office for r			

at 1:00 o'clock P. M. (Register of Deeds)


See Drawing Below

Was the corner restored through acceptance of (1) an obliterated evidence location, or, (2) a found perpetuated location?

## Found perpetuated location

(9kh) Was the corner reestablished through lost corner proportionate methods? If so, show the method, including the directions and distances to other public land survey corners used as evidence or used for proportioning in determining the corner location?

WAIL IN 9" HEMLOCK

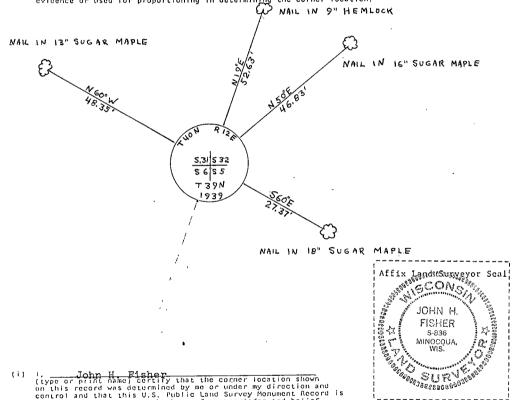

(type or print name) certify that the corner location shown on this record was determined by me or under my direction and control and that this U.S. Public Land Survey Monument Record is correct and complete to the best of my knowledge and belief.

Signatur