

State of Wisconsin
County of FOREST

ss. ESTABLISHMENT OF QUARTER - QUARTER SECTION CORNER BETWEEN ORIGINAL GOVERNMENT SURVEY CORNERS.

I NEAL SPERHAKE, do hereby certify that on the TWENTY-THIRD day of OCTOBER, 19 63, I established the EAST ONE SIXTEENTH CORNER BETWEEN SECTIONS 1 AND 12, TOWNSHIP 34 NORTH, RANGE 13 EAST, Fourth Principal Meridian, as described hereon.

History: There is no record of this corner having ever been previously established.

Description of monument and accessories I established to perpetuate the location of this corner:


At the point determined for the location of the corner I emplaced a:

GALVANIZED IRON PIPE, THREE FEET LONG, ONE INCH IN DIAMETER, WITH AN ALUMINUM CAP DENOTED AS, "KIMBERLY CLARK CORP. T34N E 1/16 BTWN. 1 & 12 R13E SPERHAKE RLS 463 10/23/63."

The pipe is witnessed by:

- Maple 6 N 68°E 28 links. (SCRIBED S 1 BT).
- Maple 14 South 31 links. (SCRIBED S12 BT).

Description as to how corner was located: The section corner $\frac{1}{4}$ mile east and the quarter corner $\frac{1}{4}$ mile west have been previously established with a distance of 39.35 chains between them. Thus, set the east one sixteenth corner $19.67\frac{1}{2}$ chains from either corner and on a straight line between them.

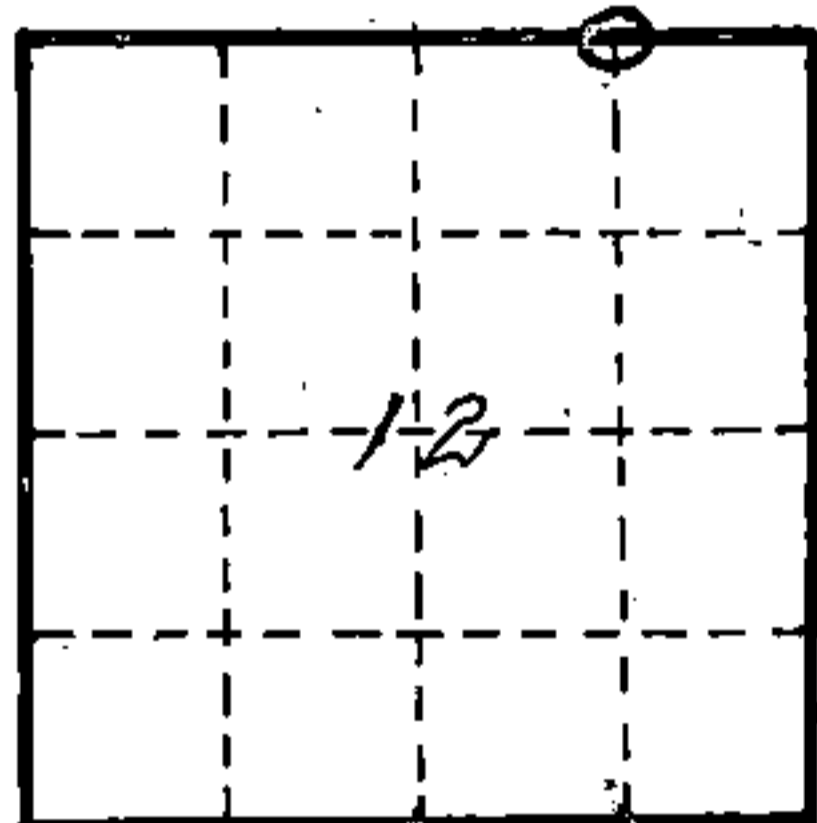

O = Corner monument restored

Subscribed & sworn to before me this 25
Day of Aug 1964

Anna Peterson
Notary Public, Forest Co., Wis
Com. expires 10/31/65

88942

Resident witnesses _____

Dated at Crandon, Wisconsin, this 25
day of Aug, 19 64.

Signature Neal Sperhake

Title Registered Land Surveyor Registration No. 463

Office of Register of Deeds County of Forest

I hereby certify that the within instrument was filed in this office for record on the 25 day of Aug, 19 64, and was filed in Book No. _____ Page No. _____ of County Records.

Surveyor's Seal

Signature Anna Peterson Title Reg. of Deeds

43913010010

Index No. E-24