

State of Wisconsin

County of FOREST

ss. RESTORATION OF LOST ORIGINAL GOVERNMENT SURVEY CORNER.

I NEAL SPERHAKE, do hereby certify that on the TWENTY-THIRD day of OCTOBER, 1963, I established the NORTH QUARTER SECTION CORNER OF SECTION 12, TOWNSHIP 34 NORTH, RANGE 13 EAST, Fourth Principal Meridian, as described hereon.

History: This corner was established during the original survey of this township, as noted in the original field notes for the original survey of T34N-R13E, 4th. p.m.

Description of monument and accessories I established to perpetuate the location of this corner:


At the point determined for the location of the corner I emplaced a:

GALVANIZED IRON PIPE, THREE FEET LONG, ONE INCH IN DIAMETER, WITH ALUMINUM CAP DENOTED AS, "KIMBERLY-CLARK CORP. T34N 1/4 BTWN. 1 & 12 R13E SPERHAKE RLS 463 10/23/63."

The pipe is witnessed by:

Maple 9 North 15 1/2 links. (SCRIBED 1/4 S 1 NBT).
W. Birch 8 S 48°W 14 links. (SCRIBED 1/4 S12 NBT).

Description as to how corner was located: No evidence of original corner present. Thus, set by proportionate measurement. The section corners 1/2 mile east and west have been previously established with a distance of 78.70 chains between them. Thus, set the quarter corner 39.35 chains from either corner and on a straight line between them.

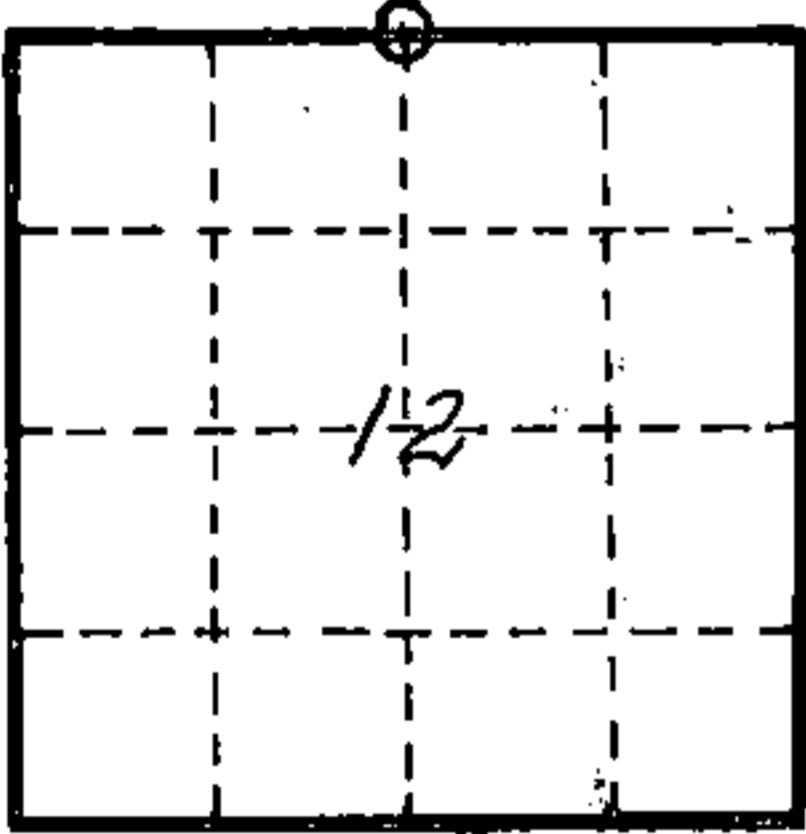

0 = Corner monument restored

Subscribed & sworn to before me this 25 day of Aug. 1964

Anna Peterson
Notary Public, Forest Co. Wis.
Com. expires 10/31/65

88911

Resident witnesses _____

Dated at Grandon, Wisconsin, this 25 day of Aug., 1964.

Signature Neal Sperhake

Title Registered Land Surveyor Registration No. 463

Office of Reg. of Deeds County of Forest

I hereby certify that the within instrument was filed in this office for record on the 25 day of August 1964, and was filed in Book No. _____ Page No. _____ of County Records.

Surveyor's Seal

Signature Anna Peterson Title Register of Deeds

43413010020

Index No.

E-208
E-23