

State of Wisconsin

County of FOREST

ss. ESTABLISHMENT OF QUARTER - QUARTER SECTION CORNER BETWEEN ORIGINAL GOVERNMENT SURVEY CORNERS.

I NEAL SPERHAKE, do hereby certify that on the THIRTIETH day of OCTOBER, 1963, I established the NORTH ONE SIXTEENTH CORNER BETWEEN SECTIONS 1 AND 2, TOWNSHIP 34 NORTH, RANGE 13 EAST, Fourth Principal Meridian, as described hereon.

History: There is no record of this corner having ever been previously established.


Description of monument and accessories I established to perpetuate the location of this corner: At the point determined for the location of the corner I emplaced a:

GALVANIZED IRON PIPE, THREE FEET LONG, ONE INCH IN DIAMETER, WITH AN ALUMINUM CAP DENOTED AS, "KIMBERLY-CLARK CORP. T34N N 1/16 BTWN. 1 & 2 R13E SPERHAKE RLS 463 10/30/63."

The pipe is witnessed by:

Balsam 4 S 18°W 16 1/2 links. (SCRIBED S 2 BT).  
Maple 12 S 55°E 37 1/2 links. (SCRIBED S 1 BT).

Description as to how corner was located: The section corner 1/4 mile north and the quarter corner 1/4 mile south have been previously established with a distance of 37.53 chains between them. The record length of this line was 37.55 chains. The record length of the line between the quarter section corner and the north one sixteenth corner between 1 and 2 was 20.00 chains. Thus, set the north one sixteenth corner 19.99 chains north of the quarter corner between sections 1 and 2 and 17.54 chains south of the section corner between sections 1 and 2 on the town line and on a straight line between them.

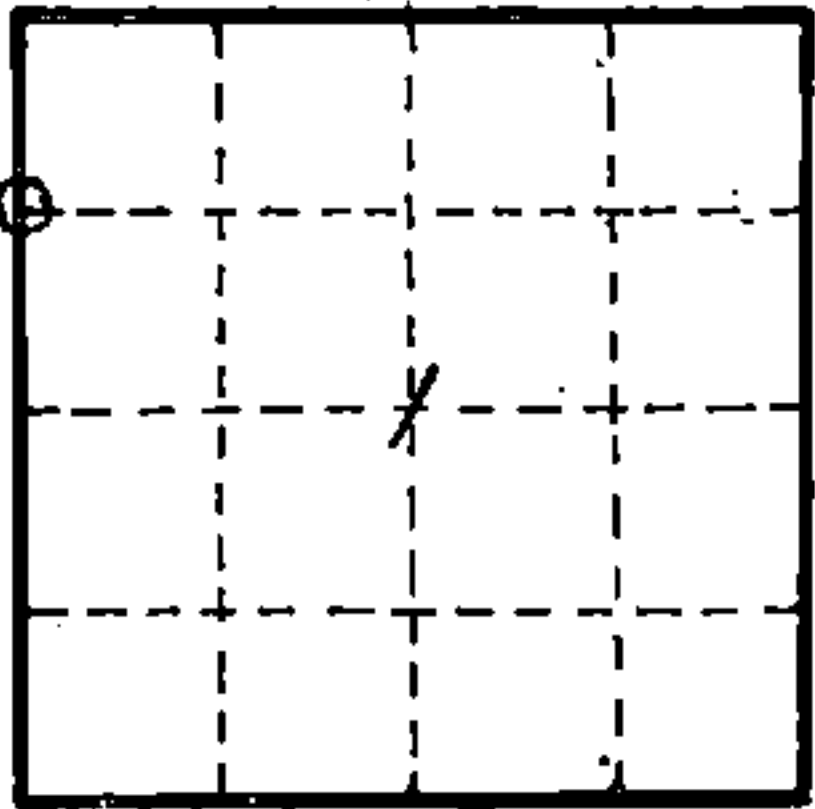

O = Corner monument restored

Subscribed & sworn to before me this 25 day of Aug 1964

Anna Peterson  
Notary Public, Forest Co., Wis  
Com. expires 10/31/65

Resident witnesses \_\_\_\_\_

Dated at Crandon, Wisconsin, this 25 day of Aug, 19 64.

Signature Neal Sperhake

Title Registered Land Surveyor Registration No. 463

Office of Register of Deeds County of Forest  
I hereby certify that the within instrument was filed in this office for record on the 25 day of August 19 64, and was filed in Book No. \_\_\_\_\_ Page No. \_\_\_\_\_ of County Records.

Surveyor's Seal

Signature Anna Peterson Title Reg. of Deeds

43413023000

88939

Index No.

B-21  
B-21  
21