

State of Wisconsin

County of FOREST

ss. RESTORATION OF LOST ORIGINAL GOVERNMENT SURVEY CORNER.

I NEAL SPERHAKE, do hereby certify that on the TWENTY-EIGHTH day of OCTOBER, 1963, I established the NORTHWEST SECTION CORNER OF SECTION 11, TOWNSHIP 34 NORTH, RANGE 13 EAST, Fourth Principal Meridian, as described hereon.

History: This corner was established during the original survey of this township, as noted in the original field notes for the original survey of T34N-R13E, 4th. p.m.

Description of monument and accessories I established to perpetuate the location of this corner:


At the point determined for the location of the corner I emplaced a:

GALVANIZED IRON PIPE, THREE FEET LONG, ONE INCH IN DIAMETER, WITH ALUMINUM CAP DENOTED AS, "KIMBERLY-CLARK CORP. T34N 2, 3, 10, 11 R13E SPERHAKE RLS 463 10/28/63."

The pipe is witnessed by:

- Aspen 5 N 70°E 60½ links. (SCRIBED S 2 NBT).
- Oak 6 N 12°W 73 links. (SCRIBED S 3 NBT).
- Maple 28 S 38°E 320 links. (SCRIBED S11 NBT).

Description as to how corner was located: The section corner one mile east has been previously set. A post approximately 3 miles west has apparently been accepted by others as the section corner for 5, 6, 7, 8. The distance between these points is 318.26 chains. The record distance for this four miles was 320.70 chains. The record distance of the line between 2 and 11 was 80.10 chains. Proportionately, therefore, the corner of 2, 3, 10, 11, should be 79.49 chains west of the corner of 1, 2, 11, 12. Previous survey work in this town has convinced me that although the original survey was generally very erratic, the actual lengths of the top tier of sections is approximately that of the record distances. As an example, an original bearing tree was located at the corner of 1, 2, 11, 12. The town line corner of 1 and 2 was also irrefutably located. The record length of the line between 1 and 2 was 77.55 chains. The actual length is 77.50 chains. Therefore, I tentatively established the north-south position of 2, 3, 10 and 11, as being the record distance, or 77.40 chains south of the town line corner of 2 and 3.

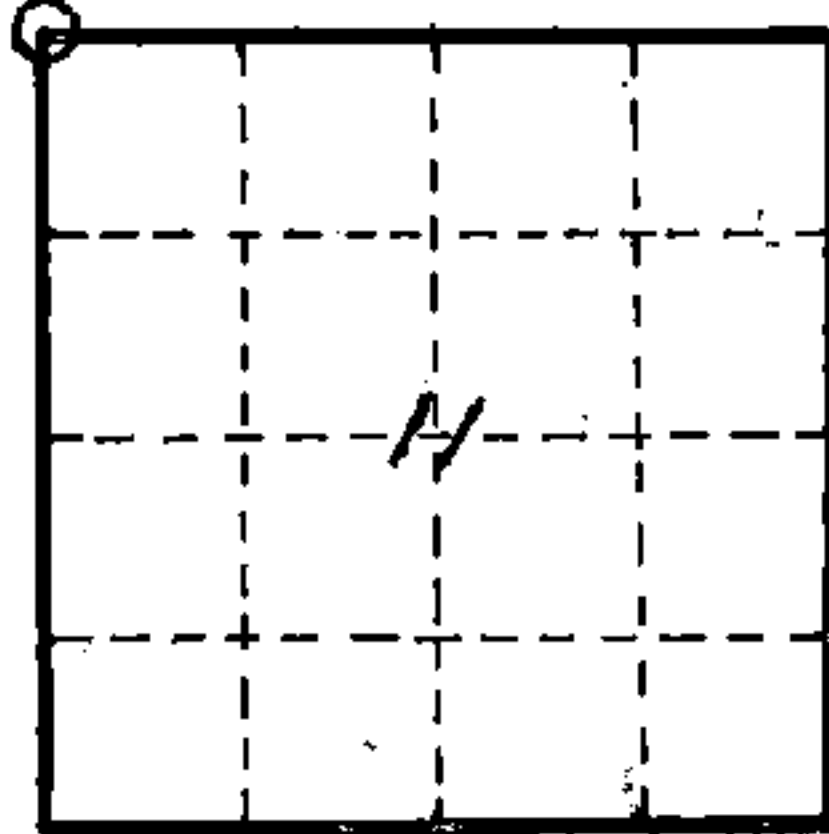

O = Corner monument restored

The above reasoning thus placed the corner tentatively in an open bog. The original field notes state that the bearing trees were a W. Pine 15 N 4°W 60 links, and a W. Birch 12 N 20°E 53 links. It is quite apparent that no trees have ever grown in the swamp, and that the bearing trees at the very least would have to grow right on the edge, rather than farther up into the high ground. A pine stump that could be interpreted as the above noted pine bearing tree was located right on the edge of the swamp. Though badly burned, a scar at its base could be interpreted as once being the bearing face for the B. T. mark. Others have chopped into this face (Continued on back)

Resident witnesses _____

Dated at Crandon, Wisconsin, this 25 day of Aug, 19 64.

Signature Neal Sperhake

Title Registered Land Surveyor Registration No. 463

Office of Register of Deeds County of Forest

I hereby certify that the within instrument was filed in this office for record on the 25 day of Aug, 19 64, and was filed in Book No. _____ Page No. _____ of County Records.

Signature Anna Peterson Title Reg. of Deeds

43413030000

Subscribed & sworn to before me
 this 25 day of Aug. 1964
Anna Peterson
 Notary Public, Forest Co., Wis
 Com. expires 10/31/65

Surveyor's Seal

88914

Index No.

E-17
13

many years ago, apparently feeling then too that this stump was the original bearing tree. Measuring south three degrees east for sixty links I arrived at a point only 12 links south and 17 links west of the point that had been tentatively determined by proration as being the site of the corner of 2, 3, 10, 11. I have, therefore, accepted the above noted pine stump as being the original bearing tree, and have so replaced the corner 77.52 chains south of the town line corner of 2 and 3, and 79.66 chains west of the corner of 1, 2, 11, 12.