


CERTIFIED LAND CORNER RESTORATION

Index No. G-99


State of Wisconsin }
County of Forest } ss.

I, Daniel K. Plegger, do hereby certify that on the 13 day of July, 1981, I found evidence of the Quarter corner of Sections 8 & 9 Township 34, North, Range 13 east, Fourth Principal Meridian, as described hereon; and that from this evidence I established a new monument and accessories as described hereon to perpetuate the original location of this corner.

Resident witnesses:

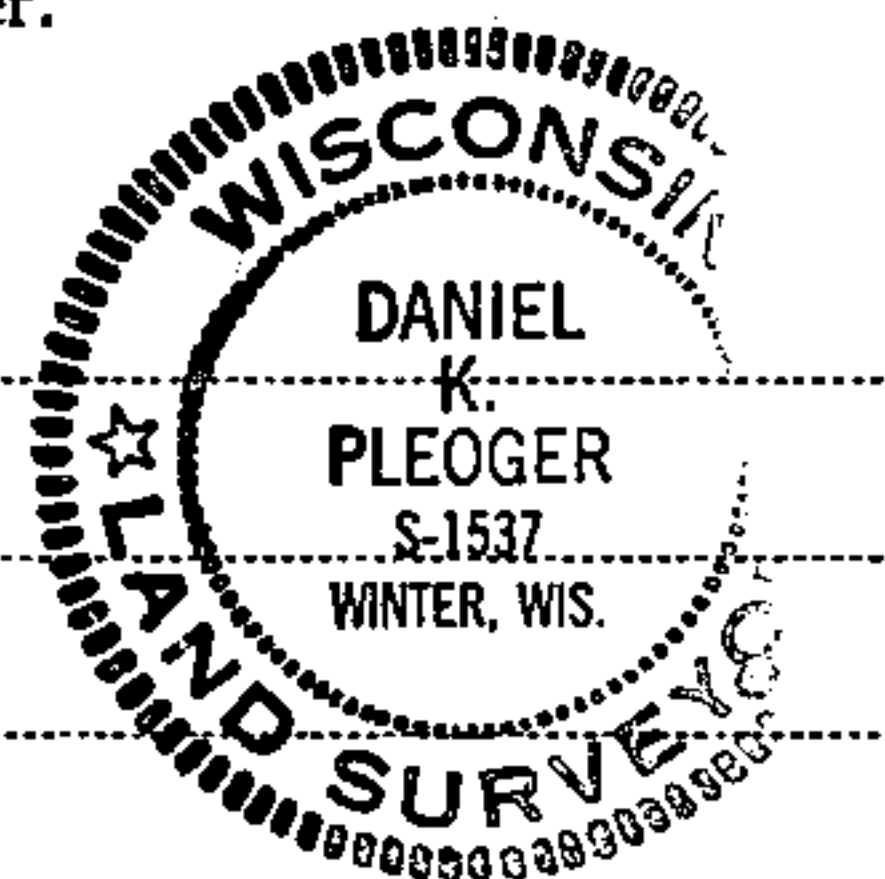

FORM 985 H. C. MILLER CO., MILWAUKEE

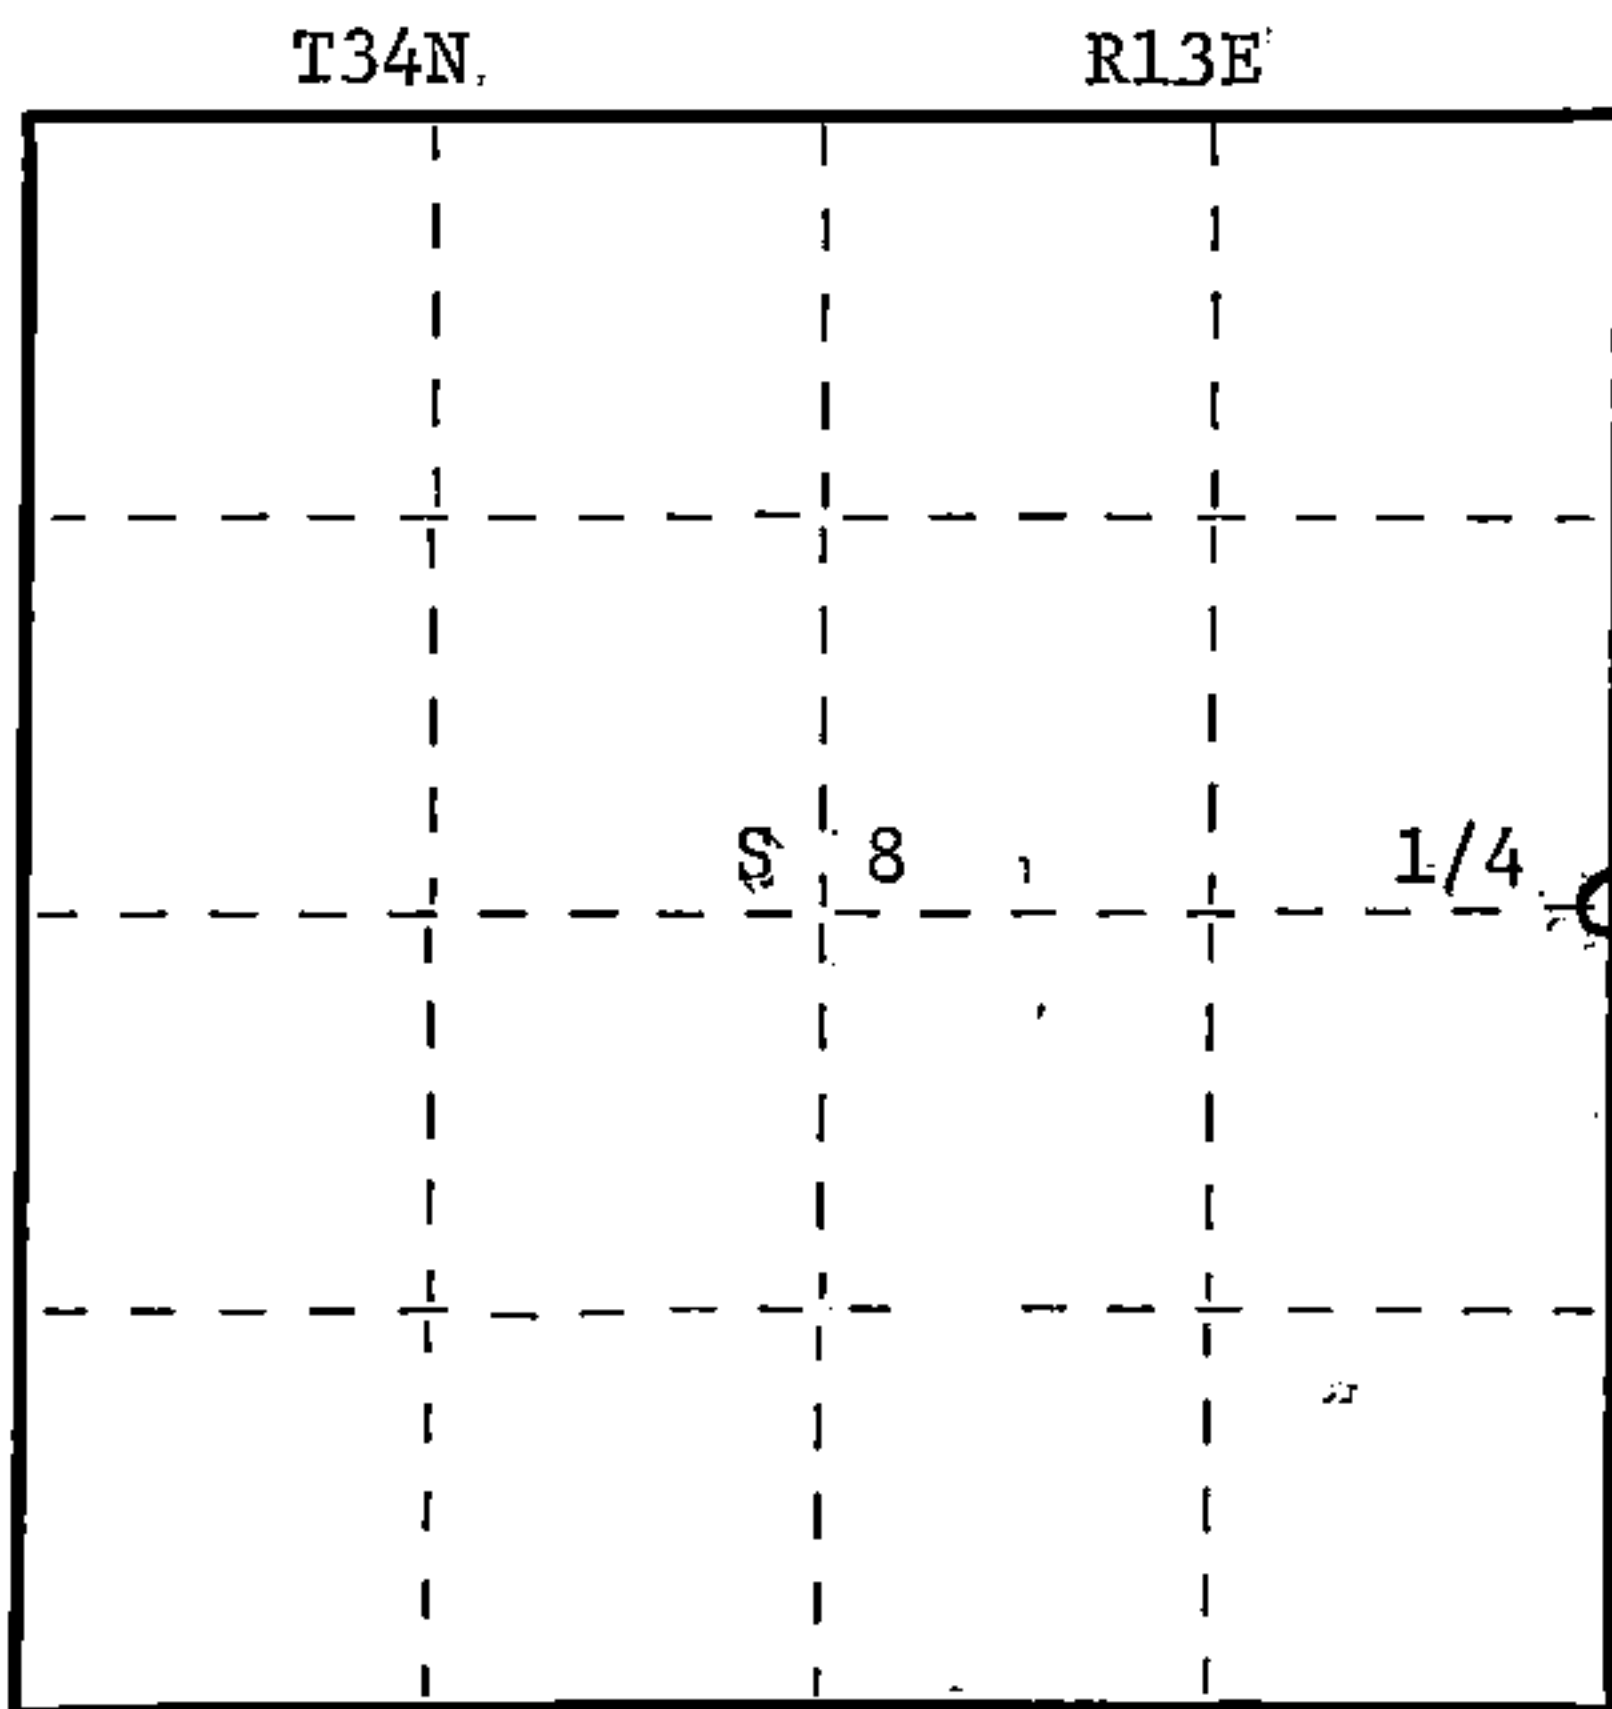

○ = Corner monument restored.

History of original corner establishment:

Original corner established by James L. Nowlin Gov. Deputy Surveyor in 1865 from which sugar 10" bears N69E 20 lks and sugar 20" bears S50W 22 lks.

Description of corner evidence found:

Recovered an old 1 1/2" x 24" iron pipe with rock cairn around it; also a 2"x2" cedar stake beside it.

Recovered o.B.T.

Yellow birch 20" N72E 14.15 ft.
Scribing not legible


Description of monument and accessories I established to perpetuate the original location of this corner.

Replaced iron pipe with a 2 1/2" aluminum pipe with alloy cap stamped:

Monument projects 12" above ground

Marked NBTs

- Sugar 9" N71W 19.0 ft.)
- Sugar 6" S51W 25.45 ft.)
- Sugar 5" S44E 12.20 ft.) - Scribed 1/4 - B.T.

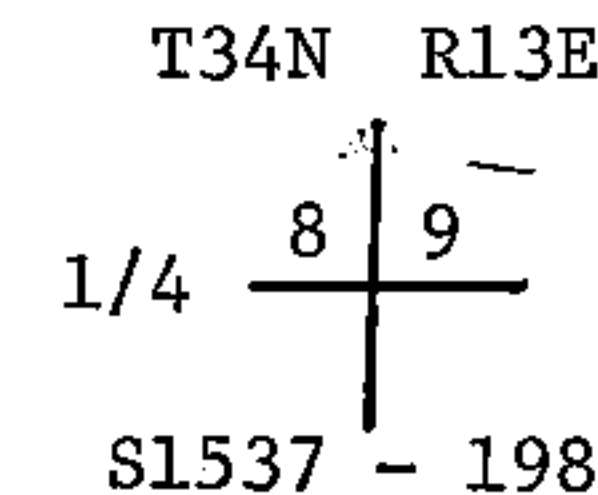

43413082-444

Dated at Rhineland, Wis., this 17 day of September, 1981

Signature Daniel K. Plegger Title Registered Land Surveyor Registration No. 1537
(County Surveyor, Registered Land Surveyor, or other duly authorized official)

Office of Register of Deeds, County of Forest, I hereby certify that the within instrument was filed in this office for record on the 25th day of September, 1981 at 2:00 o'clock P. M.

Eugene Stutzman
(Register of Deeds)
By _____ Deputy

DOCUMENT NO. **120519**