

State of Wisconsin  
County of FOREST

ss. ESTABLISHMENT OF QUARTER - QUARTER SECTION CORNER BETWEEN ORIGINAL GOVERNMENT SURVEY CORNERS.

I NEAL SPERHAKE, do hereby certify that on the TWENTY-NINTH day of OCTOBER, 1963, I established the EAST ONE SIXTEENTH CORNER BETWEEN SECTIONS 10 AND 15, TOWNSHIP 34 NORTH, RANGE 13 EAST, Fourth Principal Meridian, as described hereon.

History: There is no record of this corner having ever been previously established:

Description of monument and accessories I established to perpetuate the location of this corner:


At the point determined for the location of the corner I emplaced a:

GALVANIZED IRON PIPE, THREE FEET LONG, ONE INCH IN DIAMETER, WITH ALUMINUM CAP DENOTED AS, "KIMBERLY CLARK CORP. T34N E 1/16 BTWN. 10 & 15 R13E SPERHAKE RLS 463 10/29/63."

The pipe is witnessed by:

- Maple 5 N 02°E 59 links. (SCRIBED S10 BT).
- Maple 4 S 44°W 30 links. (SCRIBED S15 BT).

Description as to how corner was located: The section corner  $\frac{1}{4}$  mile east and the quarter corner  $\frac{1}{4}$  mile west have been previously established with a distance of 43.16 chains between them. Thus, set the E 1/16 corner 21.58 chains from either corner and on a straight line between them.

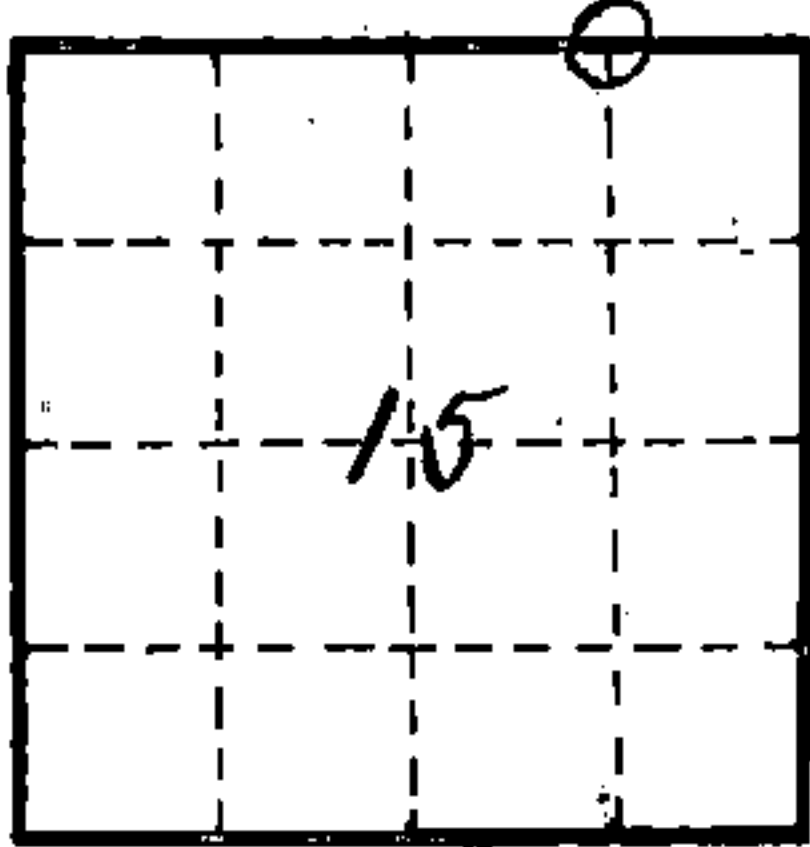

O = Corner monument restored

Subscribed & sworn to before me this 25 day of Aug 1964

Anna Peterson  
NOTARY PUBLIC FOREST CO., WIS  
COM. EXPIRES 10/31/65

88936

Resident witnesses \_\_\_\_\_

Dated at Crandon, Wisconsin, this 25 day of Aug 1964, 1964.

Signature Neal Sperhake

Title Registered Land Surveyor Registration No. 463

Office of Reg. of Deeds County of Forest

I hereby certify that the within instrument was filed in this office, for record, on the 25 day of Aug 1964, and was filed in Book No. \_\_\_\_\_ Page No. \_\_\_\_\_ of County Records.

Surveyor's Seal

Signature Anna Peterson Title Reg. of Deeds

43413160010

Index No. 5-16  
11