


U. S. PUBLIC LAND SURVEY MONUMENT RECORD

INSTRUCTIONS:

This record shall show the location of the corner and shall include all of the following nine elements (a through i).

- (a) Identify the corner by reference to the U.S. public land survey system.
 ○ = Corner monument restored.

Quarter corner common to Sections 7 and 12,
 T.34N., R.13-14E., Forest County, Wisconsin

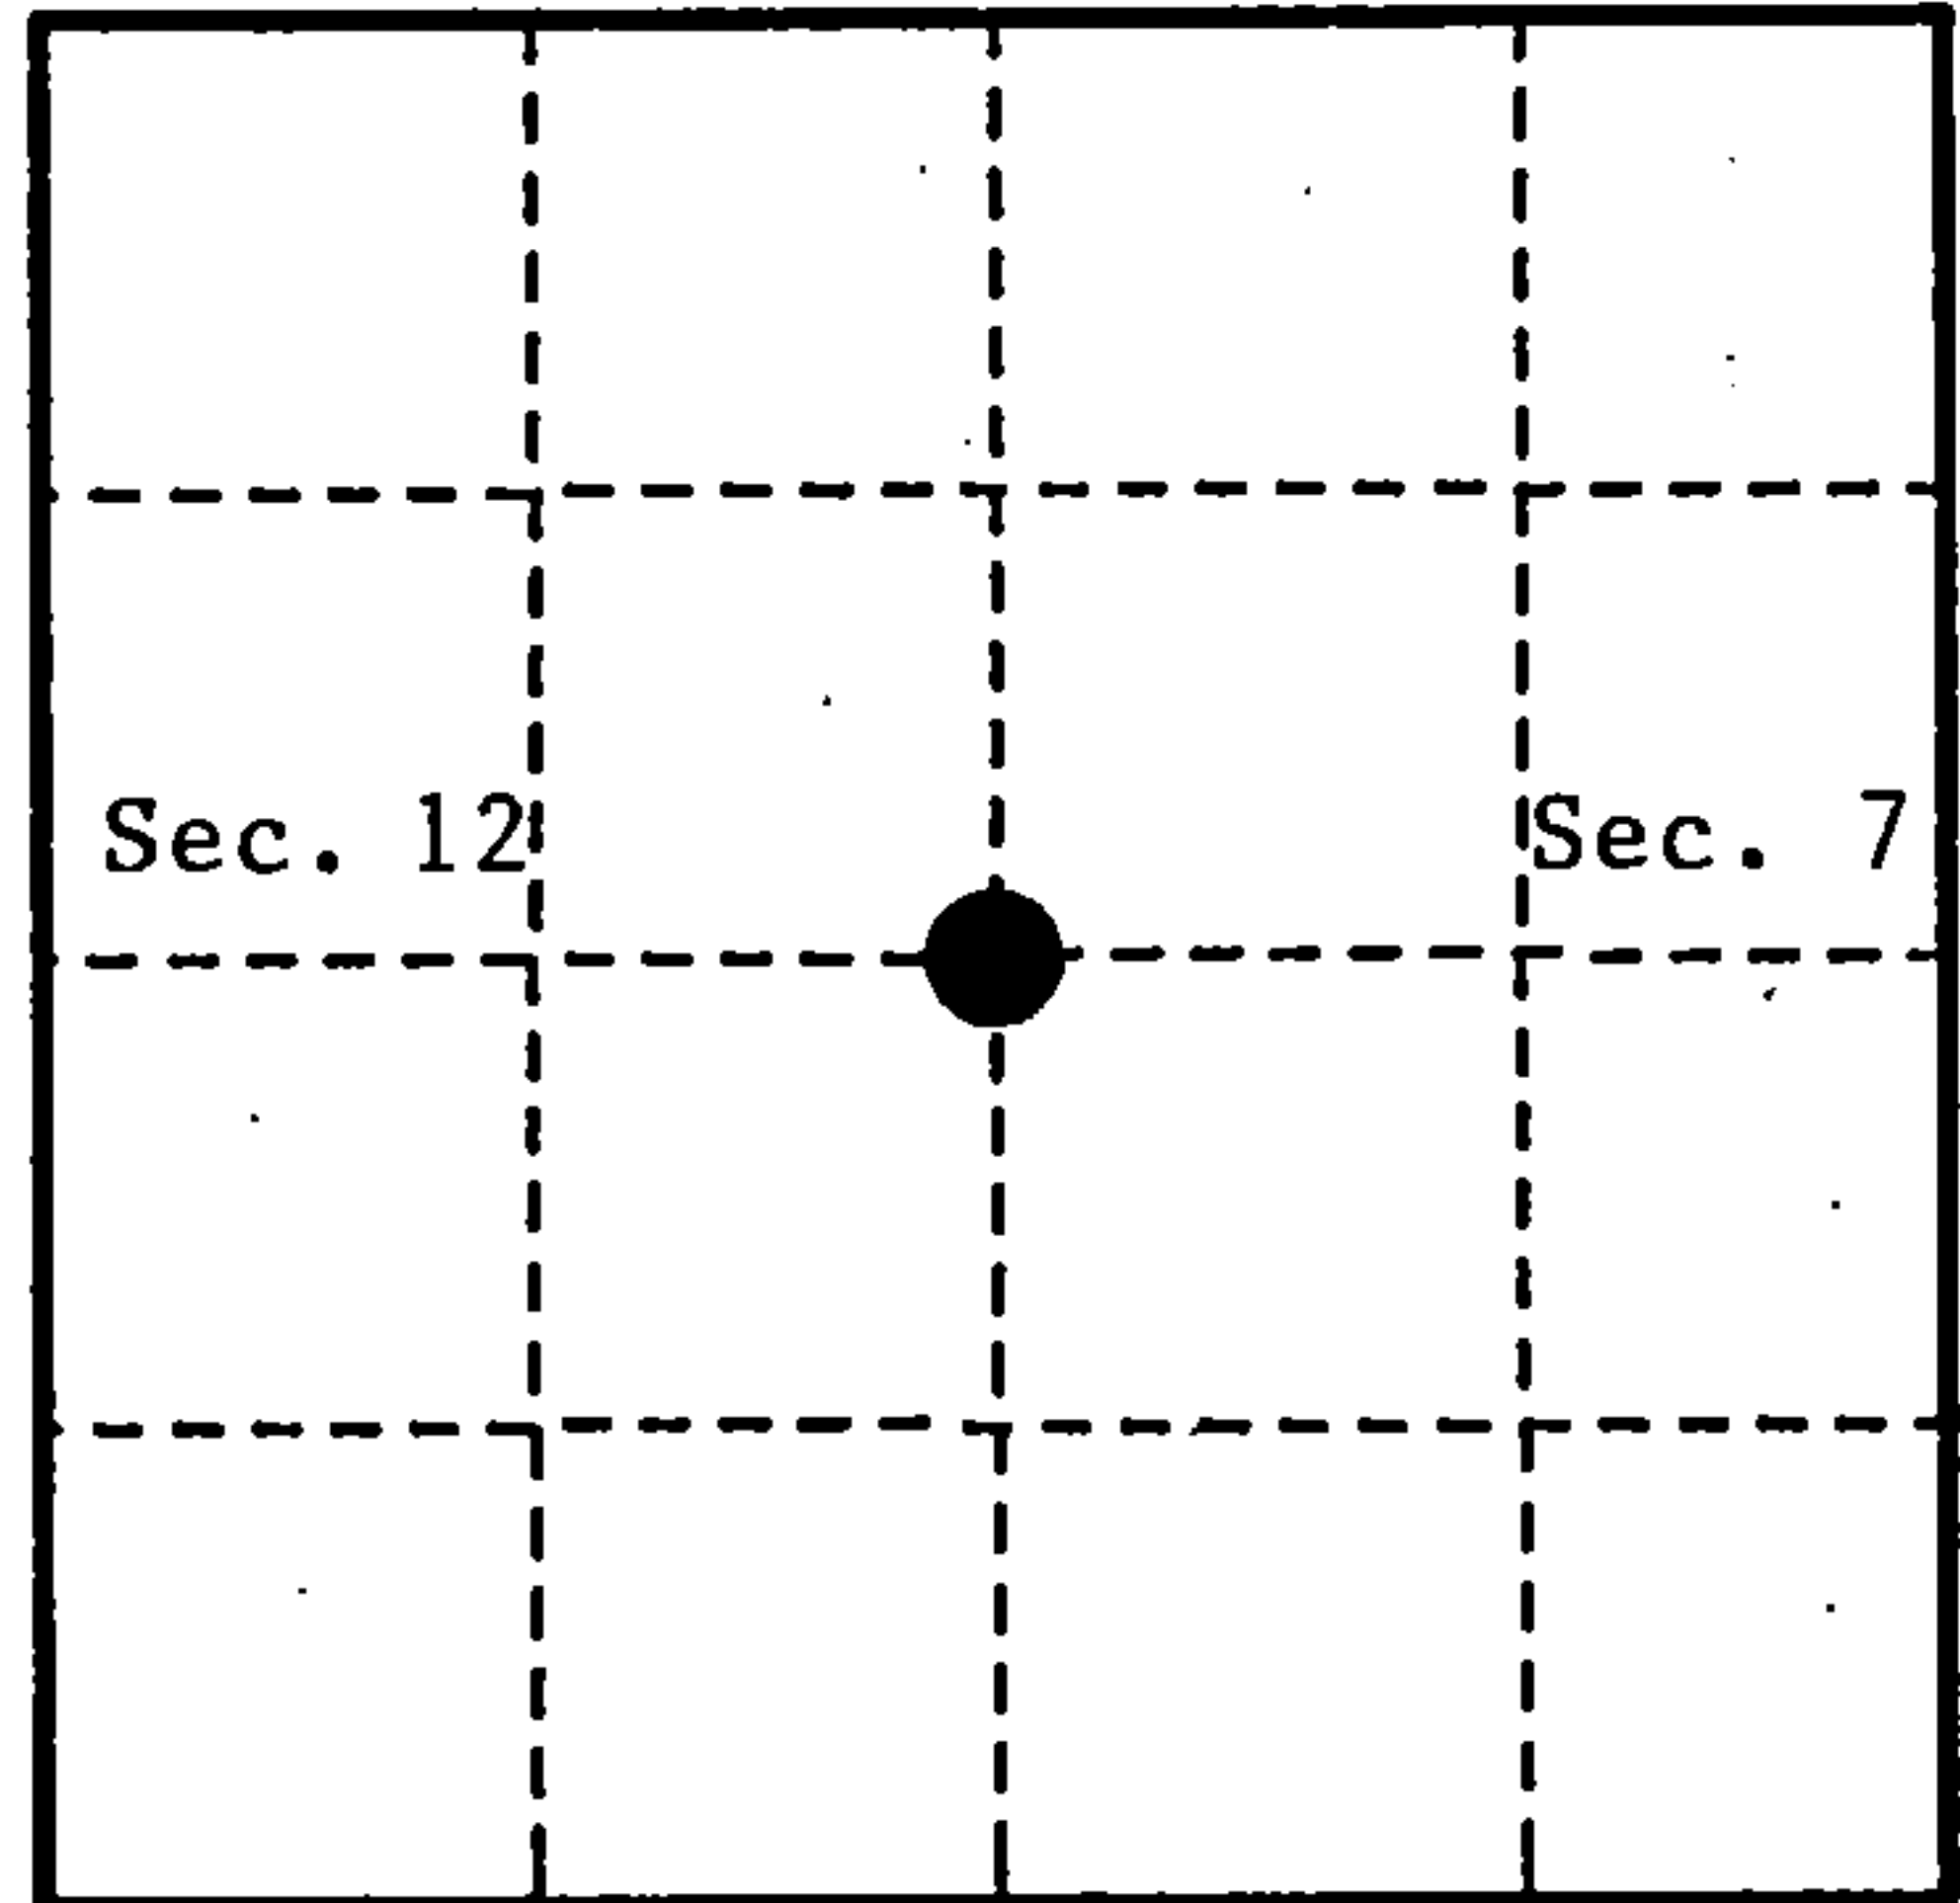

- (b) Describe any record evidence, monument evidence, occupational evidence, testimonial evidence or any other material evidence you considered, and whether the monument was found or placed.

In 1857, A. Millard made a 12" Elm the corner and made the following B.T.'s: W. Birch, 12", N.50°W., 24 links (15.84 feet); Sugar, 18", N.78°E., 20 links (13.20 feet).


In 1961, N. Sperhake, R.L.S., found stump of original corner tree and set a K-C monument and made the following B.T.'s: Basswood, 4", S.07°W., 25 links (16.50 feet); Basswood, 9", N.08°E., 48 links (31.68 feet).

In 1988, A. Harrison found corner as per Sperhake with Northeast Basswood dead. Made new references.

- (c) In the plan view drawing below, provide reference ties to at least 4 witness monuments, or, if the location is within a municipality, to at least 2 witness monuments. (witness monuments shall be made of concrete, natural stone, iron or other equally durable material.)

- (d) Show a plan view drawing depicting the relevant monuments and reference ties which is sufficient in detail to enable accurate relocation of the corner monument if the corner monument is disturbed. Indicate north.

1. Kimberly-Clark monument with cap stamped to identify corner location.
2. Sugar, 4", N.35°E., 47.44 feet.
3. Basswood, 12", S.87°E., 31.80 feet.
4. Basswood, 8", S.07°W., 16.13 feet.
5. Steel sign post, South, 0.62 feet.

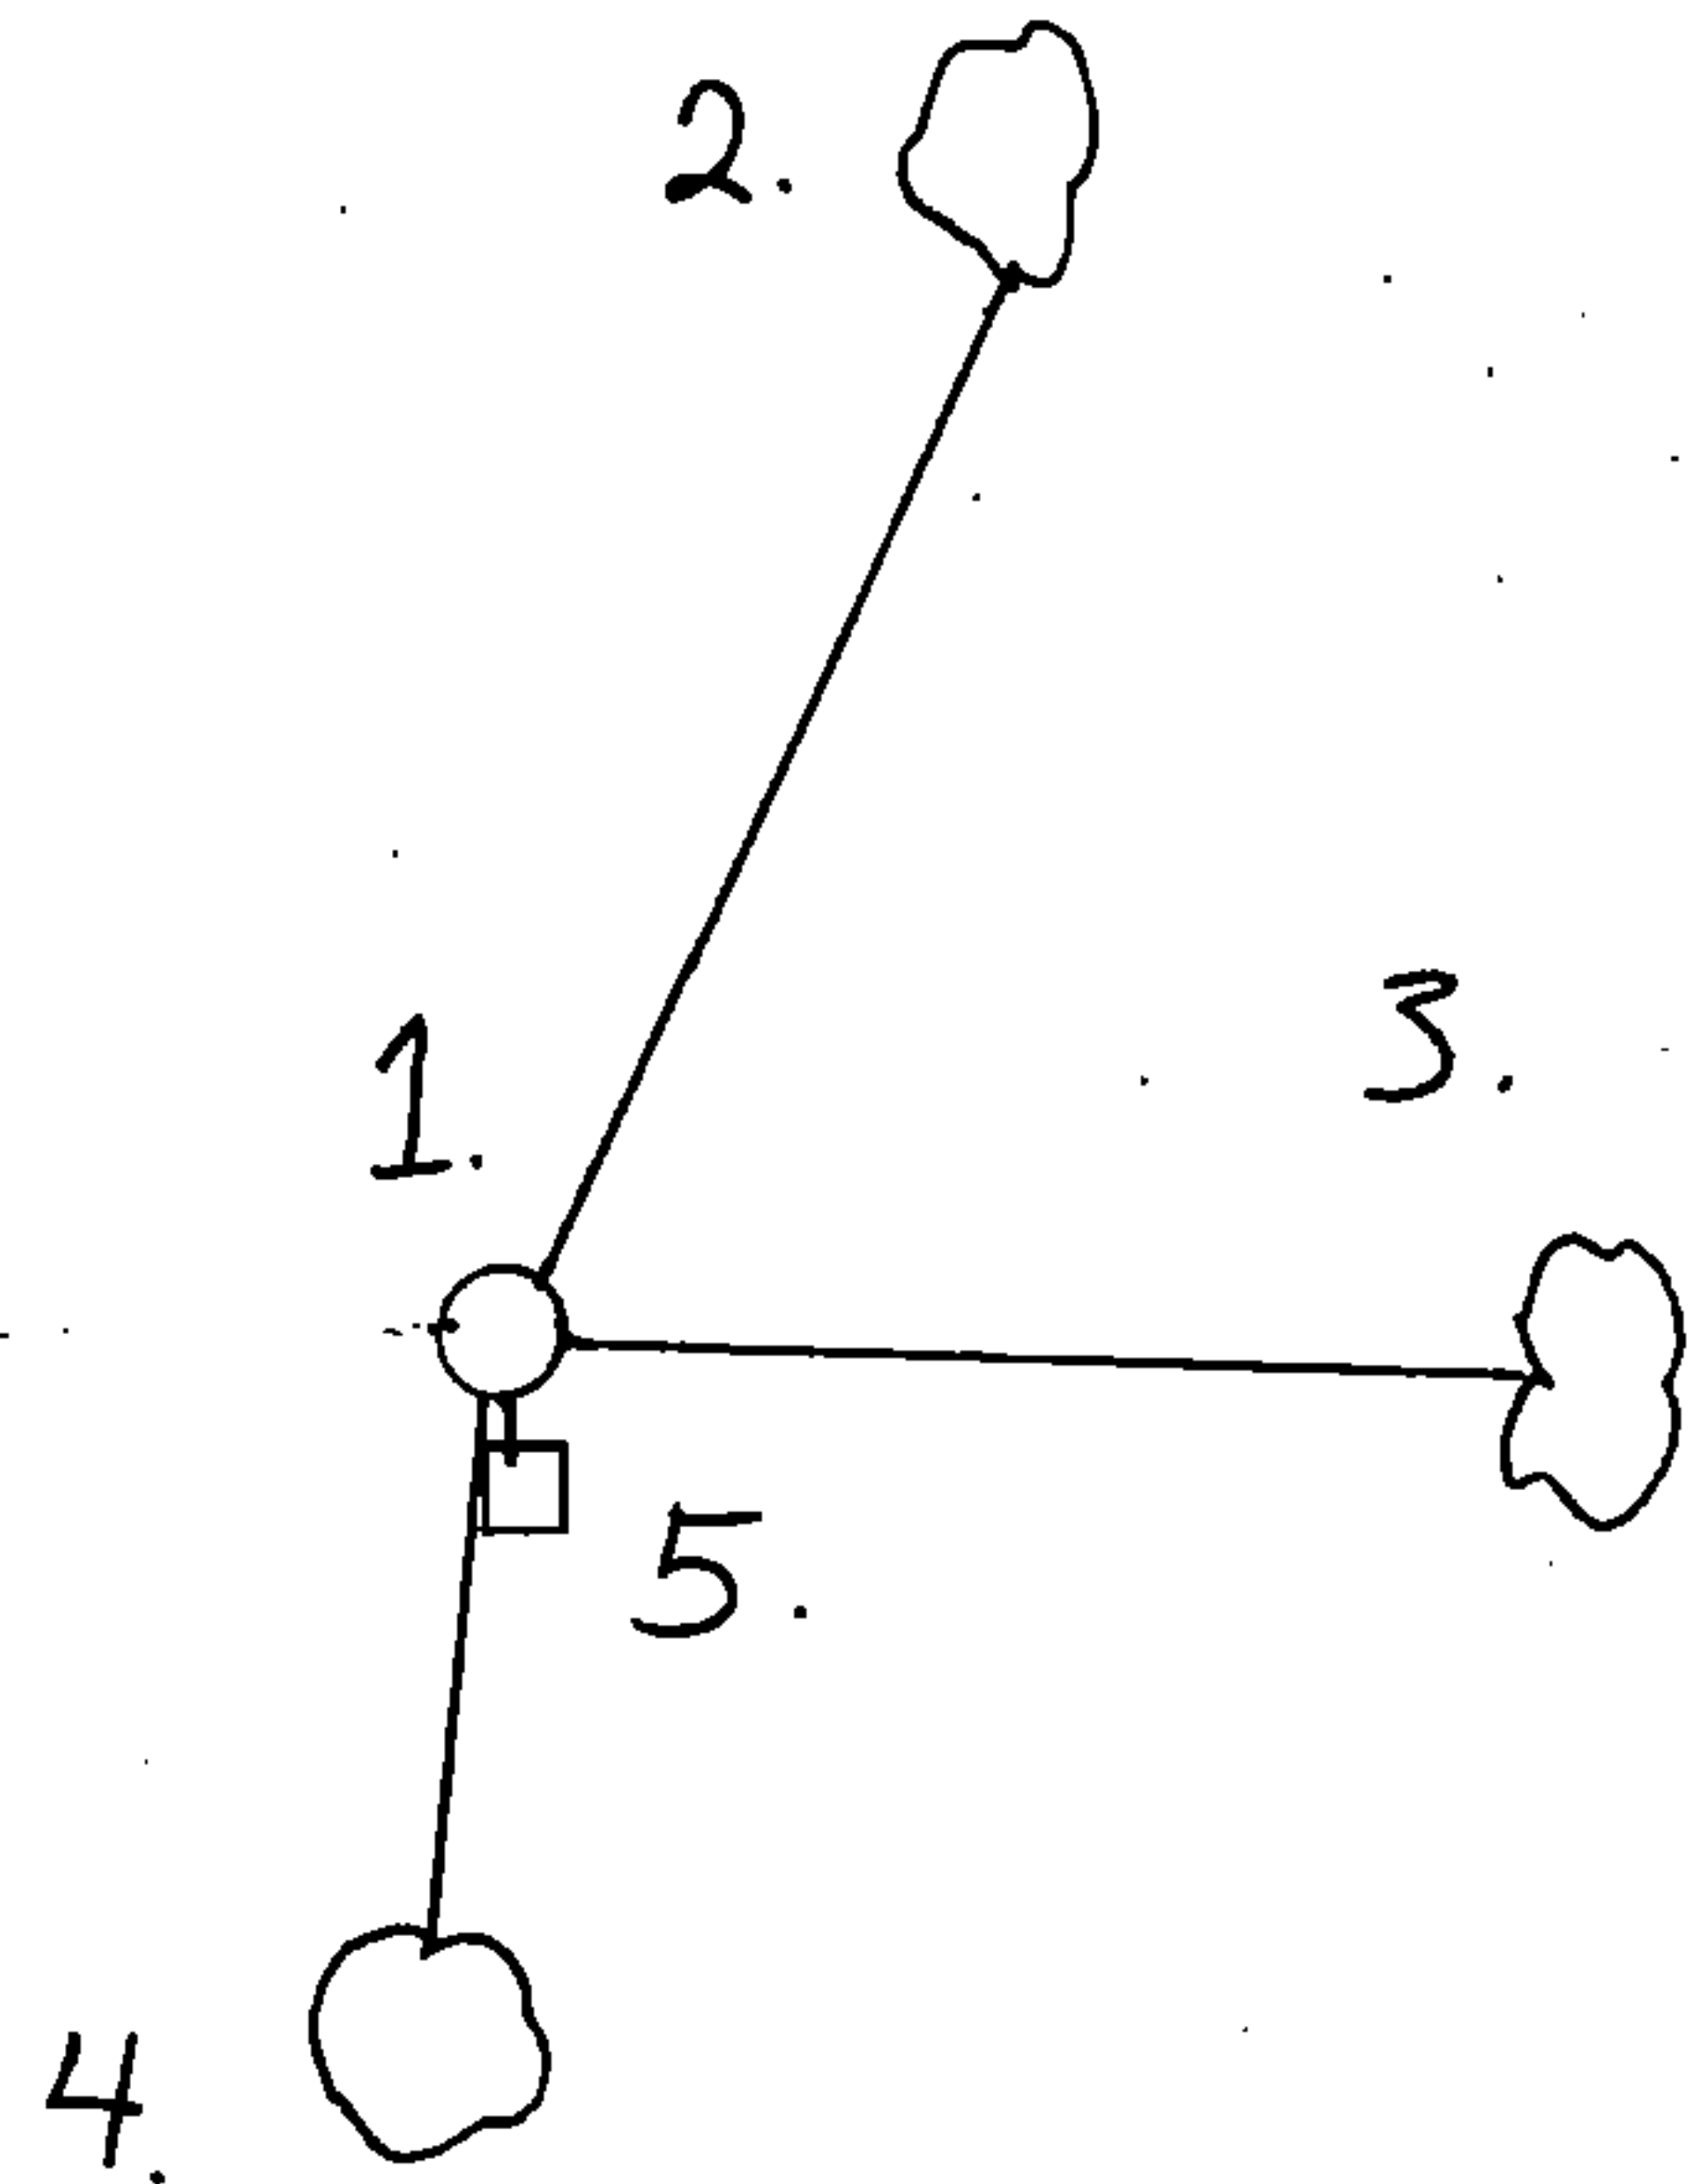

REGISTER'S OFFICE
 Forest County, Wis.

Received for record this 29th day
 of March A.D., 1990 at
10:00 o'clock A.M. and recorded
 in Vol. CORNER RESTORATIONS
 page G-1.

Paul Acklenbrenner
 Register of Deeds

(e) Describe any material discrepancy between the location of the corner as restored or reestablished and the location of that corner as previously restored or reestablished by distance and direction. Show the discrepancy on the plan view drawing under (d), above. Show the distances between the corner as previously restored or reestablished and (1) the corner as restored or reestablished, and (2) to at least 2 of the witness monuments shown on the drawing in (d), above.

None.

(f) Was the corner restored through acceptance of (1) an obliterated evidence location, or, (2) a found perpetuated location?

(2) a found perpetuated location

(g & h) Was the corner reestablished through lost corner proportionate methods? If so, show the method, including the directions and distances to other public land survey corners used as evidence or used for proportioning in determining the corner location?

No.

(1) I, Alan D. Harrison

(type or print name) certify that the corner location shown on this record was determined by me or under my direction and control and that this U.S. Public Land Survey Monument Record is correct and complete to the best of my knowledge and belief.



Signature

Date

CERTIFICATE READY FOR FILING:

Dale Staege
District Ranger

CERTIFIED LAND CORNER RESTORATION

Index No. G-25
G 25

State of Wisconsin }
County of FOREST } ss.


I NEAL SPERHAKE, do hereby certify that on the FOURTEENTH day of NOVEMBER, 19 61, I found evidence of the EAST QUARTER SECTION corner of SECTION 12 Township 34, North, Range 13 EAST, Fourth Principal Meridian, as described hereon; and that from this evidence I established a new monument and accessories as described hereon to perpetuate the original location of this corner.

Resident witnesses:

Les. Hillberg - Grandon

Richard Piontek - Waubeno

David Seaburg - Laona

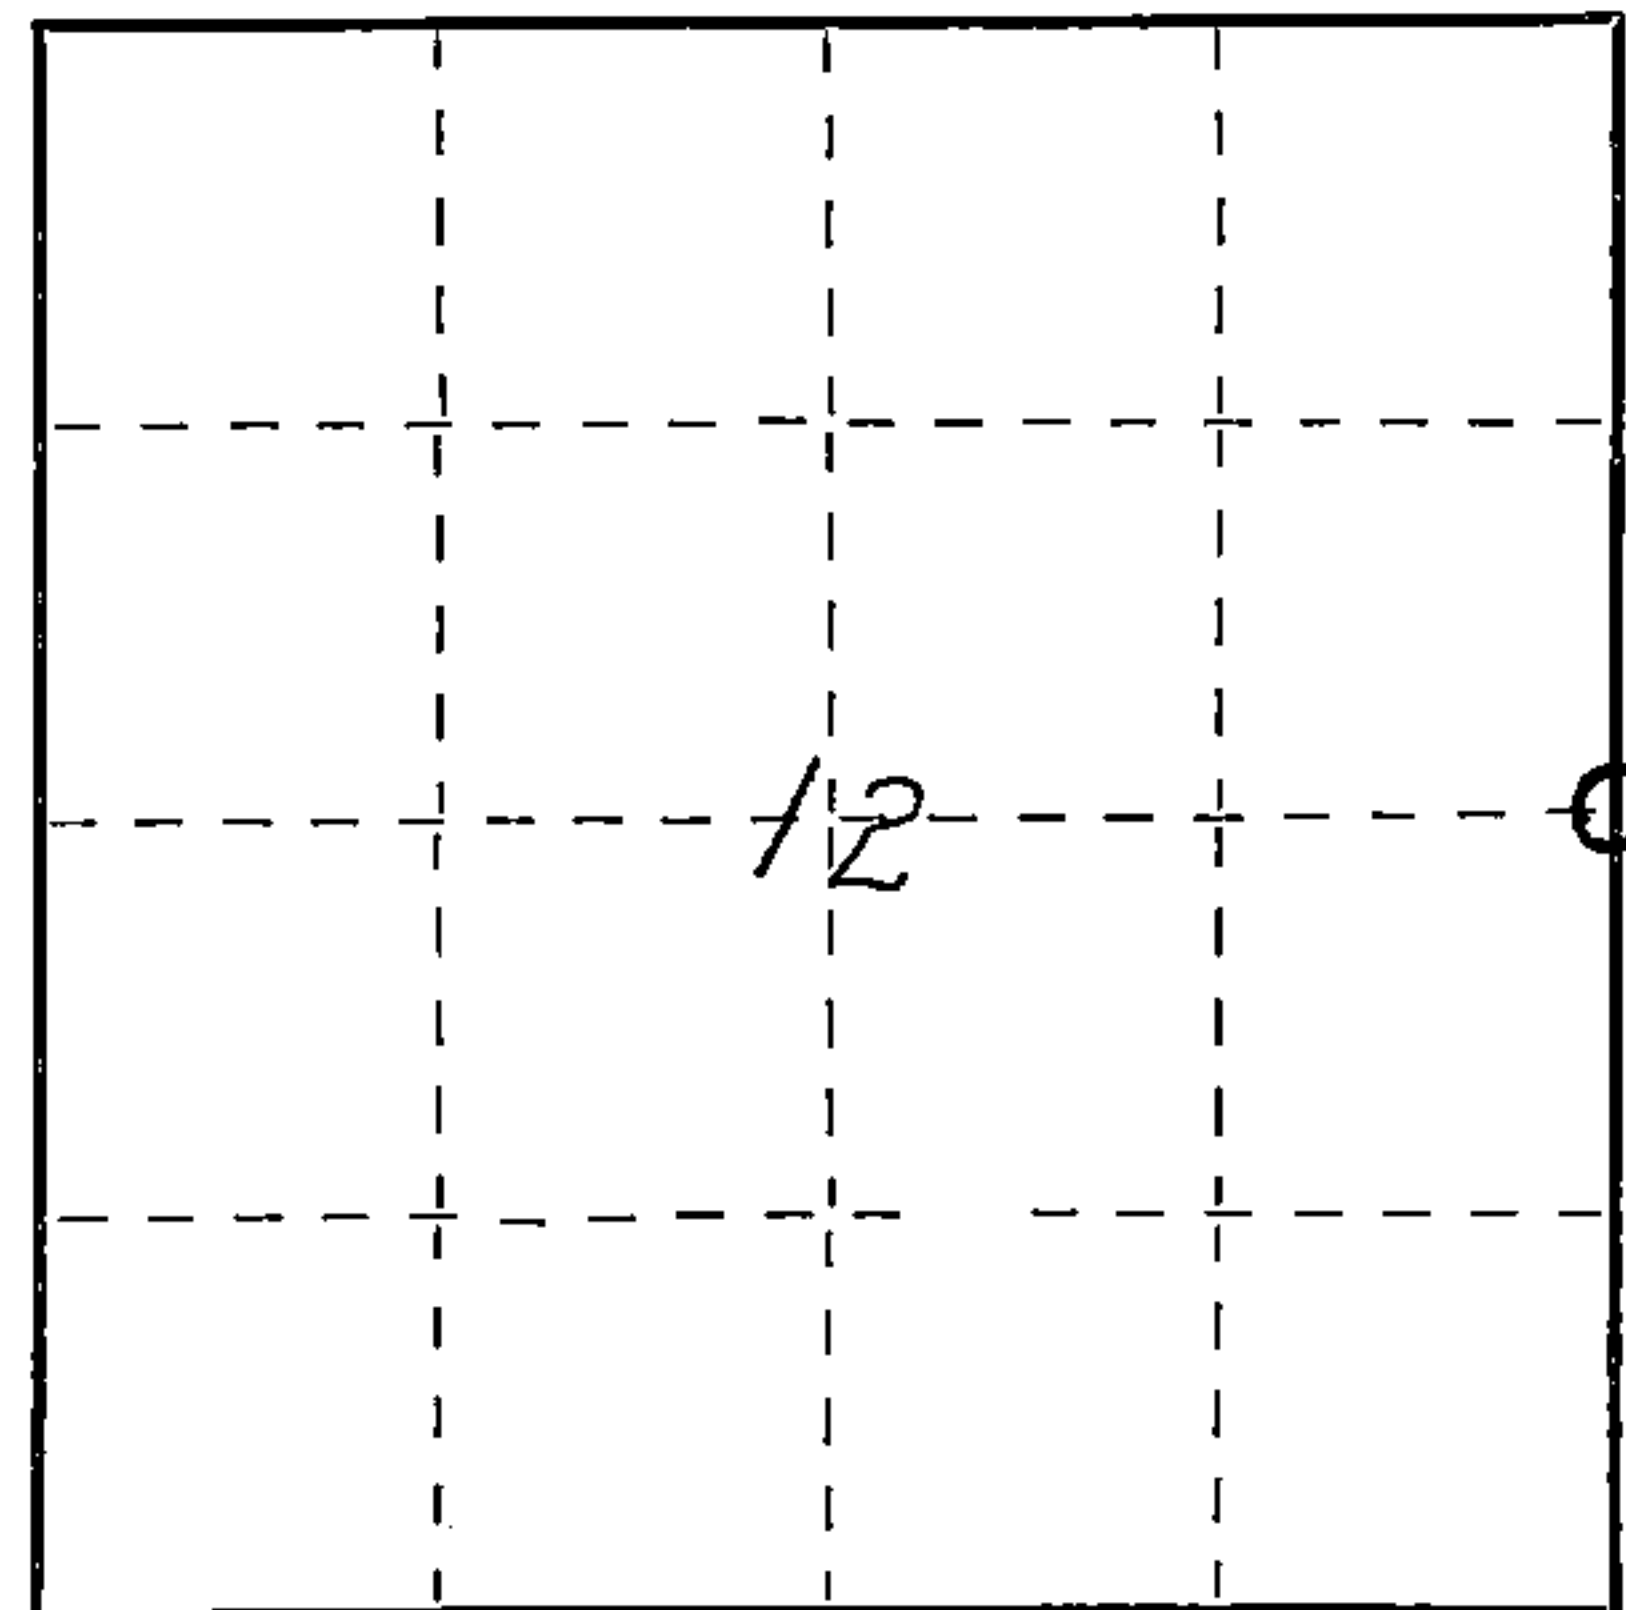

○ = Corner monument restored.

History of original corner establishment:

This corner can also be described as: THE QUARTER SECTION CORNER BETWEEN SECTION 7, T34N-R14E, AND SECTION 12, T34N-R13E, 4TH P.M.

This corner was established during the original survey of this township, as noted in the Original Field Notes for the Original Survey of T34N-R13E, 4th P.M.

Description of corner evidence found:

The stump of the original corner tree, described in the original field notes as, "Elm 12, squared for corner" is still present at this date.

In addition, since both section corners one half mile north and south, respectively, have been previously established, a survey line was run between them. The elm stump was located at the mid-point between the two section corners, and on a straight line between them.

Description of monument and accessories I established to perpetuate the original location of this corner.

Into the center of the above mentioned stump was driven a "GALVANIZED IRON PIPE, THREE FEET LONG, ONE INCH IN DIAMETER, WITH AN ALUMINUM CAP DENOTED AS, 'KIMBERLY-CLARK CORP T34N 1/4 BTWN 7 & 12 R13-14E SPERHAKE RLS 463 11-14-61'".

The pipe is witnessed by:

- Basswood 4 S7°W 25 links. (Scribed S12 NBT).
- Basswood 9 N8°E 48 links. (Scribed S 7 NBT).

Dated at Grandon, Wis. this 11th day of Feb., 19 63

Signature Neal Sperhake Title Registered Land Surveyor Registration No. S-463
(County Surveyor, Registered Land Surveyor, or other duly authorized official)

Office of Register of Deeds, County of Forest, I hereby certify that the within instrument was filed in this office for record on the 11th day of Feb, 19 63 at 10 o'clock A. M. **86838**

Anna Peterson
(Register of Deeds)

SUBSCRIBED & SWORN TO BEFORE ME THIS
11TH DAY OF FEB 1963
Anna Peterson
Notary Public, Forest Co., Wis
Comm. exp. 10/31/65

By _____ Deputy

FORM 985 H. C. MILLER CO., MILWAUKEE

SEE ALSO G-1 34-H

43413122000

Surveyors Seal