

State of Wisconsin

County of FOREST

ss. RESTORATION OF LOST ORIGINAL GOVERNMENT SURVEY CORNER.

I NEAL SPERHAKE, do hereby certify that on the EIGHTEENTH day of NOVEMBER, 1963, I established the NORTH QUARTER SECTION CORNER OF SECTION 23, TOWNSHIP 34 NORTH, RANGE 13 EAST, Fourth Principal Meridian, as described hereon.

History: This corner was established during the original survey of this township, as noted in the original field notes for the original survey of T34N-R13E, 4th. p.m.


Description of monument and accessories I established to perpetuate the location of this corner: At the point determined for the location of the corner I emplaced a:

GALVANIZED IRON PIPE, THREE FEET LONG, ONE INCH IN DIAMETER, WITH ALUMINUM CAP DENOTED AS, "KIMBERLY-CLARK CORP. T34N 1/4 BTWN. 23 & 14 R13E SPERHAKE RLS 463 11/18/63."

The pipe is witnessed by:

- B. Ash 10 N 37°E 45 links. (SCRIBED 1/4S 14 NBT).
- W. Birch 10 S 46°W 29 links. (SCRIBED 1/4S 23 NBT).

Description as to how corner was located: No evidence of original corner present. The east-west position: The section corner 1/2 mile east and the witness corner 1/2 mile west have been previously established with a distance of 78.13 chains between them. Thus, the corner will be set 39.06 1/2 chains from either corner. For the north-south position: A deed for a parcel of land in section 23 was located in the register of deeds office for Forest County. A 1937 entry shows a Charles Swim negotiating for a 108 acre parcel that started at the section corner of 13, 14, 23, 24. This description is impossible to follow exactly, since one call is noted as "Thence south-westerly for 50 rods, thence westerly for 57 rods to a point 45 rods south of the quarter section corner". However, an iron rod was located at a point about 10 1/2 chains south of where the quarter corner would be placed if set on a straight line between the corners of 13, 14, 23, 24 and 14, 15, 22, 23. I feel that since the survey describing the above mentioned parcel is over 30 years old they probably had a good quarter corner between 14 and 23 to work from, which is why they describe the one point as being south of the quarter corner 45 rods (11 1/4 chains). Thus, I set the quarter corner half way between the two section corners, but 45 rods (11 1/4 chains) north of the iron rod noted above.

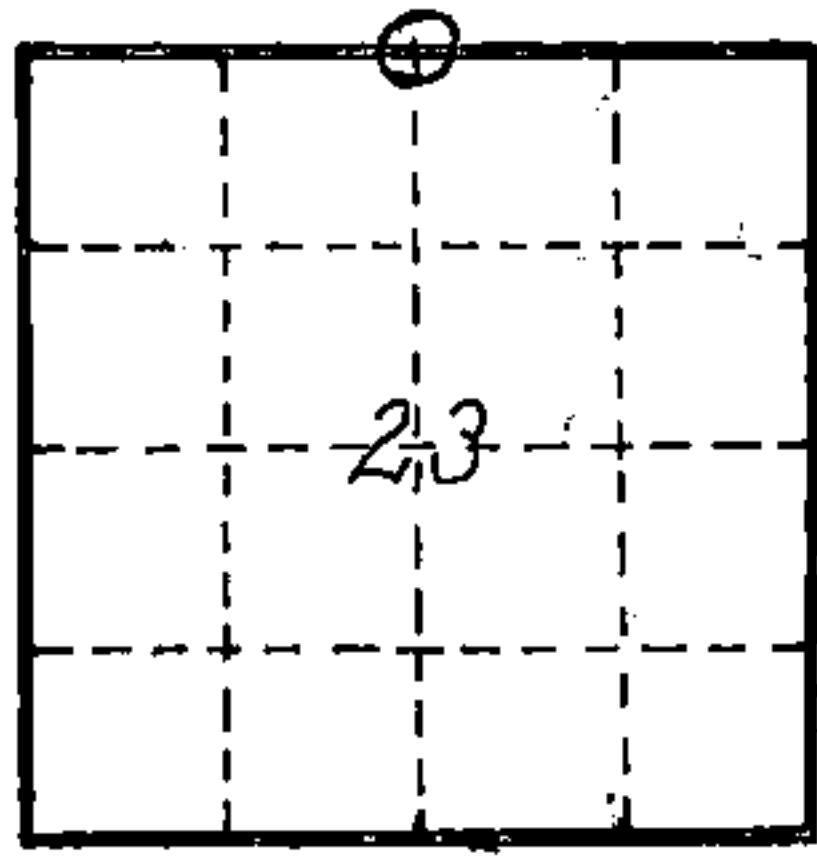

O = Corner monument restored

Subscribed & sworn to before me this 25 day of Aug 1964

Anna Peterson
NOTARY PUBLIC, FOREST CO., WIS
COM. EXPIRES 10/31/65

Resident witnesses _____

Dated at Crandon, Wisconsin, this 25 day of Aug, 1964.

Signature Neal Sperhake

Title Registered Land Surveyor Registration No. 463

Office of Reg. of Deeds County of Forest, I hereby certify that the within instrument was filed in this office for record on the 25 day of Aug. 1964, and was filed in Book No. _____ Page No. _____ of County Records.

Surveyor's Seal

Signature Anna Peterson Title Reg. of Deeds.

43413140020

88975

Index No.

N 119

619