

State of Wisconsin  
County of FOREST

ss. ESTABLISHMENT OF QUARTER - QUARTER SECTION CORNER BETWEEN ORIGINAL GOVERNMENT SURVEY CORNERS.

I NEAL SPERHAKE, do hereby certify that on the EIGHTEENTH day of NOVEMBER, 19 63, I established the SOUTH ONE SIXTEENTH CORNER BETWEEN SECTIONS 13 AND 14, TOWNSHIP 34 NORTH, RANGE 13 EAST, Fourth Principal Meridian, as described hereon.

History: There is no record of this corner having ever been previously established.

Description of monument and accessories I established to perpetuate the location of this corner:


At the point determined for the location of the corner I emplaced a:

GALVANIZED IRON PIPE, THREE FEET LONG, ONE INCH IN DIAMETER, WITH ALUMINUM CAP DENOTED AS, "KIMBERLY CLARK CORP. T34N S 1/16 BTWN. 13 & 14 R13E WC - Corner is East 30 Feet - WC."

The pipe is witnessed by:

Elm 8 S 85°W 51 links. (SCRIBED S14 WC BT).  
B. Cherry 12 N 67°E 122 links. (SCRIBED S13 WC BT).

Description as to how corner was located: The section corner 1/4 mile south and the quarter corner 1/4 mile north have been previously established with a distance of 39.82 chains between them. Thus, set the S 1/16 corner 19.91 chains from either corner and on a straight line between them.

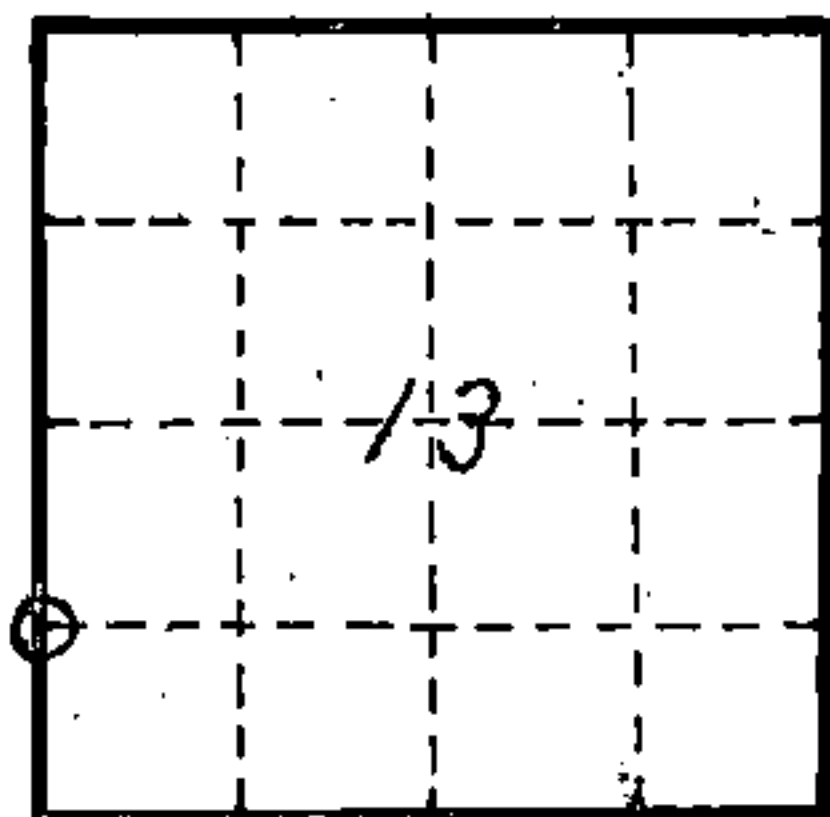

O = Corner monument restored

Subscribed & sworn to before me this 25 day of Aug 1964

Anna Peterson  
NOTARY PUBLIC, FOREST CO., WIS  
COM. EXPIRES 10/31/65

88073

Resident witnesses \_\_\_\_\_

Dated at Crandon, Wisconsin, this 25 day of Aug, 19 64.

Signature Neal Sperhake

Title Registered Land Surveyor Registration No. 463

Office of Reg. of Deeds County of Forest

I hereby certify that the within instrument was filed in this office for record on the 25 day of Aug 19 64, and was filed in Book No. \_\_\_\_\_ Page No. \_\_\_\_\_ of County Records.

Surveyor's Seal

Signature Anna Peterson Title Reg. of Deeds

4341314 1000

Index No.

11-21  
21