

State of Wisconsin
County of FOREST

ss. ESTABLISHMENT OF QUARTER - QUARTER SECTION CORNER BETWEEN ORIGINAL GOVERNMENT SURVEY CORNERS.

I NEAL SPERHAKE, do hereby certify that on the TWENTY-FIRST day of NOVEMBER, 19 63, I established the WEST ONE SIXTEENTH CORNER BETWEEN SECTIONS 22 AND 27, TOWNSHIP 34 NORTH, RANGE 13 EAST, Fourth Principal Meridian, as described hereon.

History: There is no record of this corner having ever been previously established.

Description of monument and accessories I established to perpetuate the location of this corner:


At the point determined for the location of the corner I emplaced a:

GALVANIZED IRON PIPE, THREE FEET LONG, ONE INCH IN DIAMETER, WITH ALUMINUM CAP DENOTED AS, "KIMBERLY CLARK CORP. T34N W 1/16 BTWN. 22 & 27 R13E SPERHAKE RLS 463 11/21/63."

The pipe is witnessed by:

- Hemlock 7 S 56°W 23 links. (SCRIBED S27 BT).
- Hemlock 8 N 12°W 17 links. (SCRIBED S22 BT).

Description as to how corner was located: The section corner 1/4 mile west and the quarter corner 1/4 mile east have been previously established with a distance of 40.76 1/2 chains between them. Thus, set the W 1/16 corner 20.38 1/4 chains from either corner and on a straight line between them.

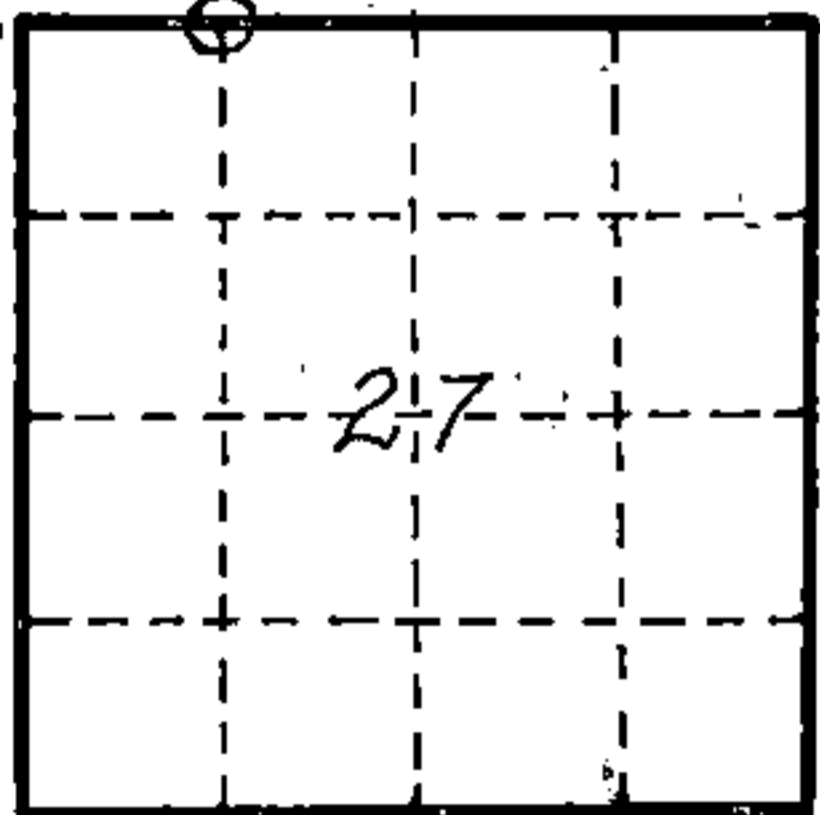

O = Corner monument restored

Subscribed & sworn to before me this 25 day of Aug 1964

Anna Peterson
NOTARY PUBLIC, FOREST CO., WIS
COM. EXPIRES 4/31/65

88992

Resident witnesses _____

Dated at Crandon, Wisconsin, this 25 day of Aug, 19 64.

Signature *Neal Sperhake*

Title Registered Land Surveyor Registration No. 463

Office of Reg. of Deeds _____ County of Forest

I hereby certify that the within instrument was filed in this office for record on the 25 day of August 19 64, and was filed in Book No. _____ Page No. _____ of County Records.

Surveyor's Seal

Signature *Anna Peterson* Title Reg. of Deeds

43413220030

Index No. R-114
R14