

State of Wisconsin

County of FOREST

} ss. RESTORATION OF LOST ORIGINAL GOVERNMENT SURVEY CORNER.

I NEAL SPERHAKE, do hereby certify that on the FIRST day of NOVEMBER, 1963, I established the NORTH QUARTER SECTION CORNER OF SECTION 26, TOWNSHIP 34 NORTH, RANGE 13 EAST, Fourth Principal Meridian, as described hereon.

History: This corner was established during the original survey of this township, as noted in the original field notes for the original survey of T34N-R13E, 4th.p.m.

Description of monument and accessories I established to perpetuate the location of this corner:


At the point determined for the location of the corner I emplaced a:

GALVANIZED IRON PIPE, THREE FEET LONG, ONE INCH IN DIAMETER, WITH ALUMINUM CAP DENOTED AS, "KIMBERLY-CLARK CORP. T34N 1/4 BTWN. 23 & 26 R13E SPERHAKE RLS 463 11/1/63."

The pipe is witnessed by:

- Balsam 8 S 14°E 25 links. (SCRIBED 1/4 S 26 NBT).
- Spruce 6 N 22°W 27 links. (SCRIBED 1/4 S 23 NBT).

Description as to how corner was located: Set the corner at the site of an old post put in by a surveyor in 1908. The surveyor was working for Mr. C. E. Jones of Antigo, Wisconsin, who owned the land adjoining this corner. Mr. Jones claims he was personally there when the surveyor chopped out the wood that had over grown the scribing on one of the original bearing trees, from which they set the wooden post. A hemlock stump is still there in the proper place for the original bearing tree noted as "Hemlock 14 N 40°W 22 links."

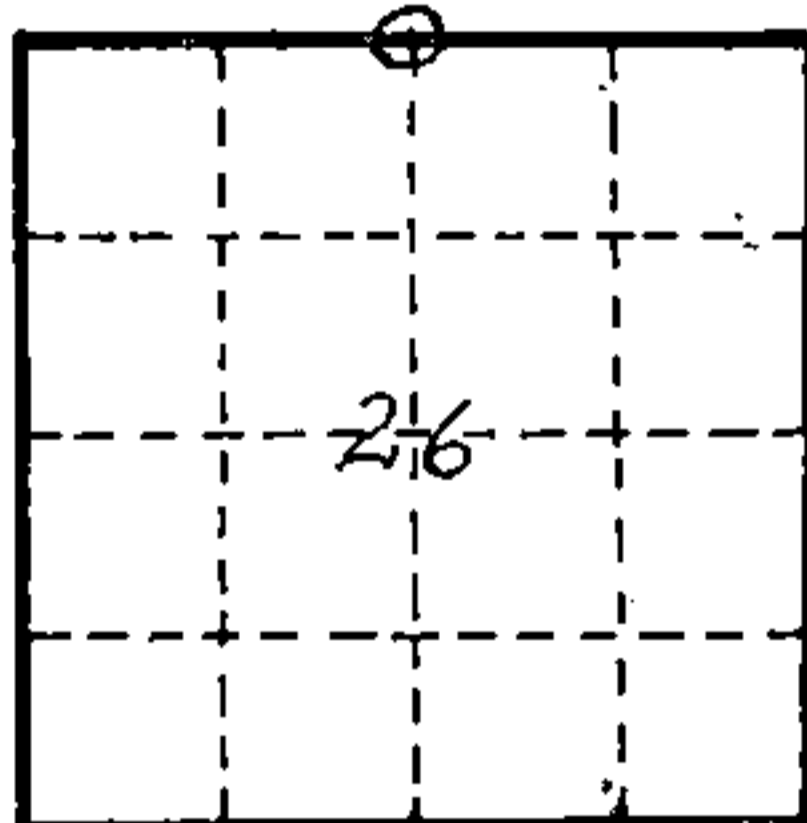

O = Corner monument restored

Subscribed & sworn to before me this 25 day of Aug 1964

Anna Peterson
Notary Public, Forest Co. Wis.
Com. expires 10/31/65

88988

Resident witnesses _____

Dated at Crandon, Wisconsin, this 25 day of Aug, 1964.

Signature Neal Sperhake

Title Registered Land Surveyor Registration No. 463

Office of Reg. of Deeds County of Forest

I hereby certify that the within instrument was filed in this office for record on the 25 day of Aug 1964, and was filed in Book No. _____ Page No. _____ of County Records.

Surveyor's Seal

Signature Anna Peterson Title Reg. of Deeds

43413230020

Index No. R-119